


MUSKINGUM COUNTY
COUNTY ROAD NO. 8

SARAH E. BRAILER ET AL


LICKING TWP.
QR. TP. 3 T. 21 N. R. 9 W.

JOHN L. JR & GERALDINE
ESHELMAN

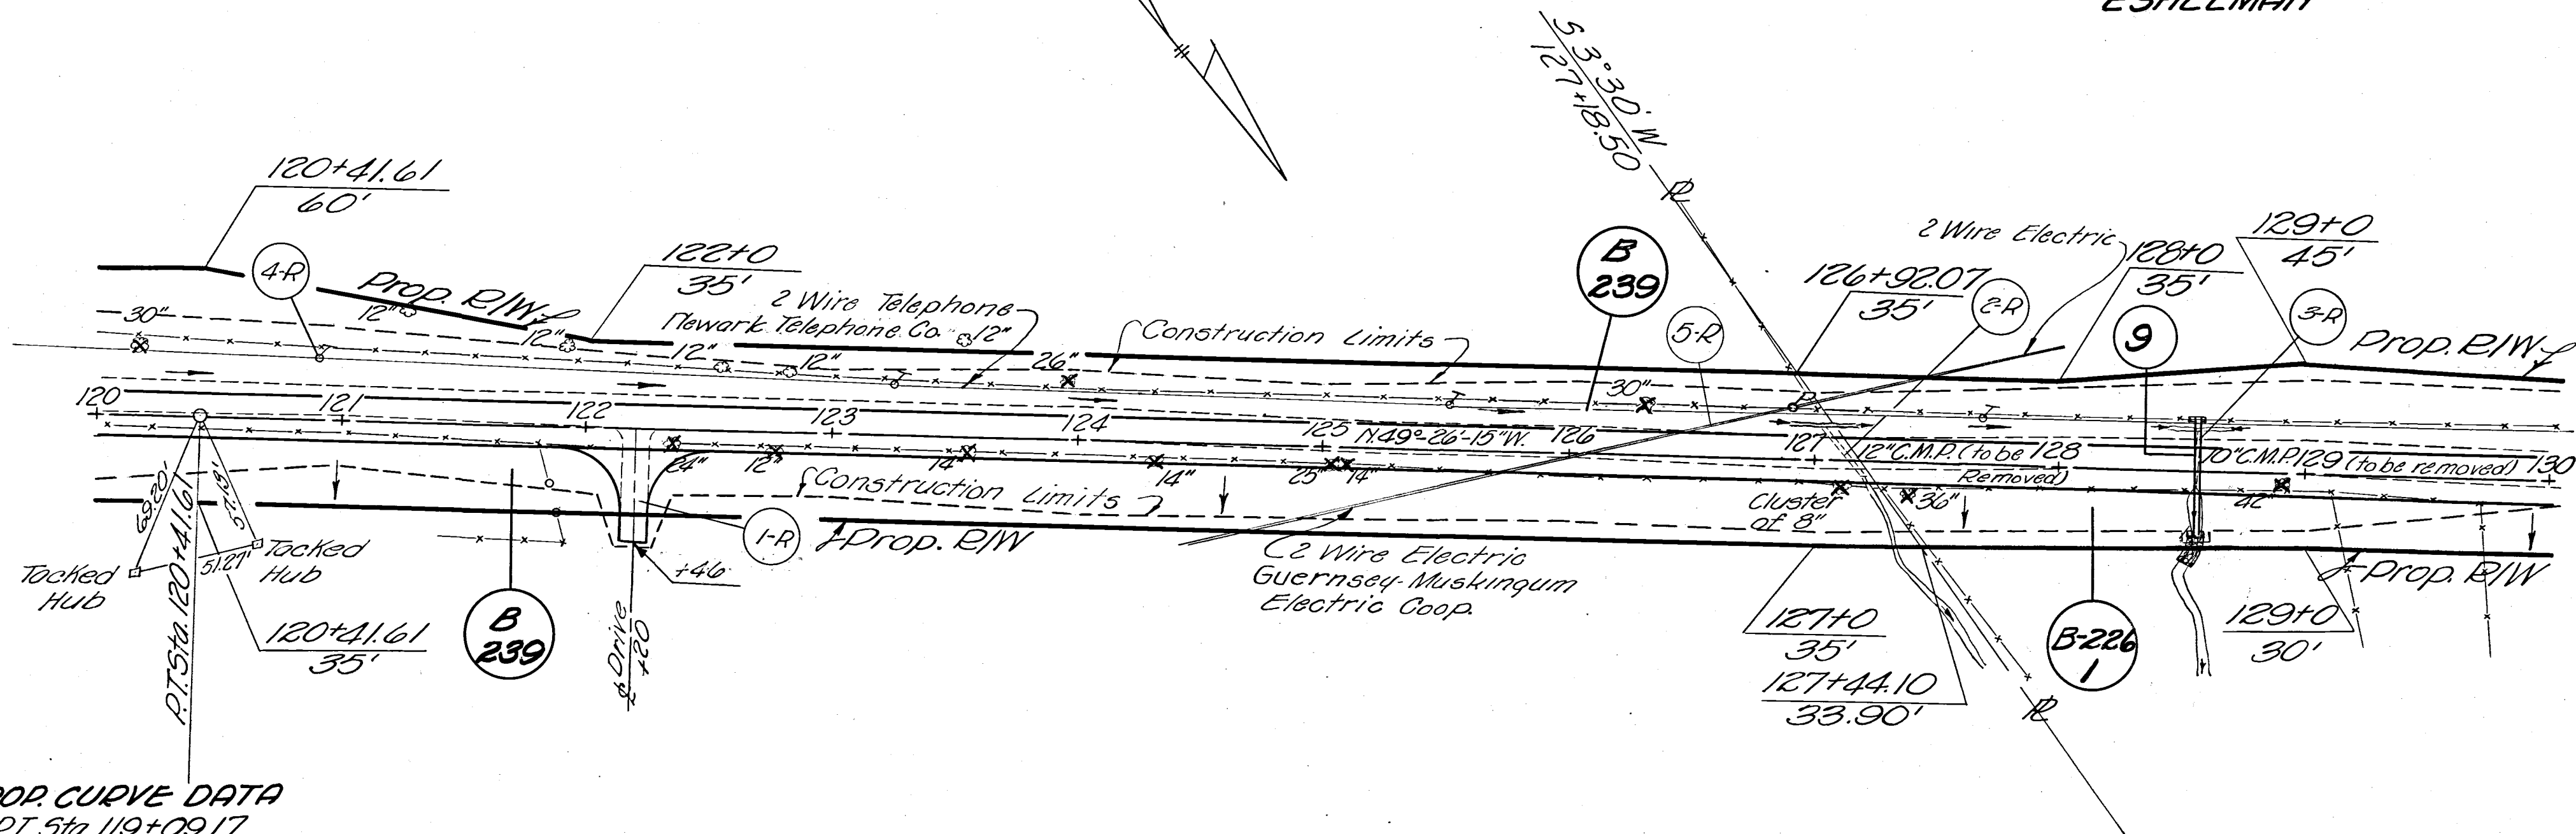

PROP. CURVE DATA
P.I. Sta 119+09.17
 $\Delta = 10^{\circ} 37' 30''$ D.T.
D.C. = 4' 00"
P = 1432.39'
T = 133.19'
L = 265.63'
E = 6.18'

BENCH MARK
Spike in 5" Elm
69' Pt. & Sta 127+72
Elev. 812.95

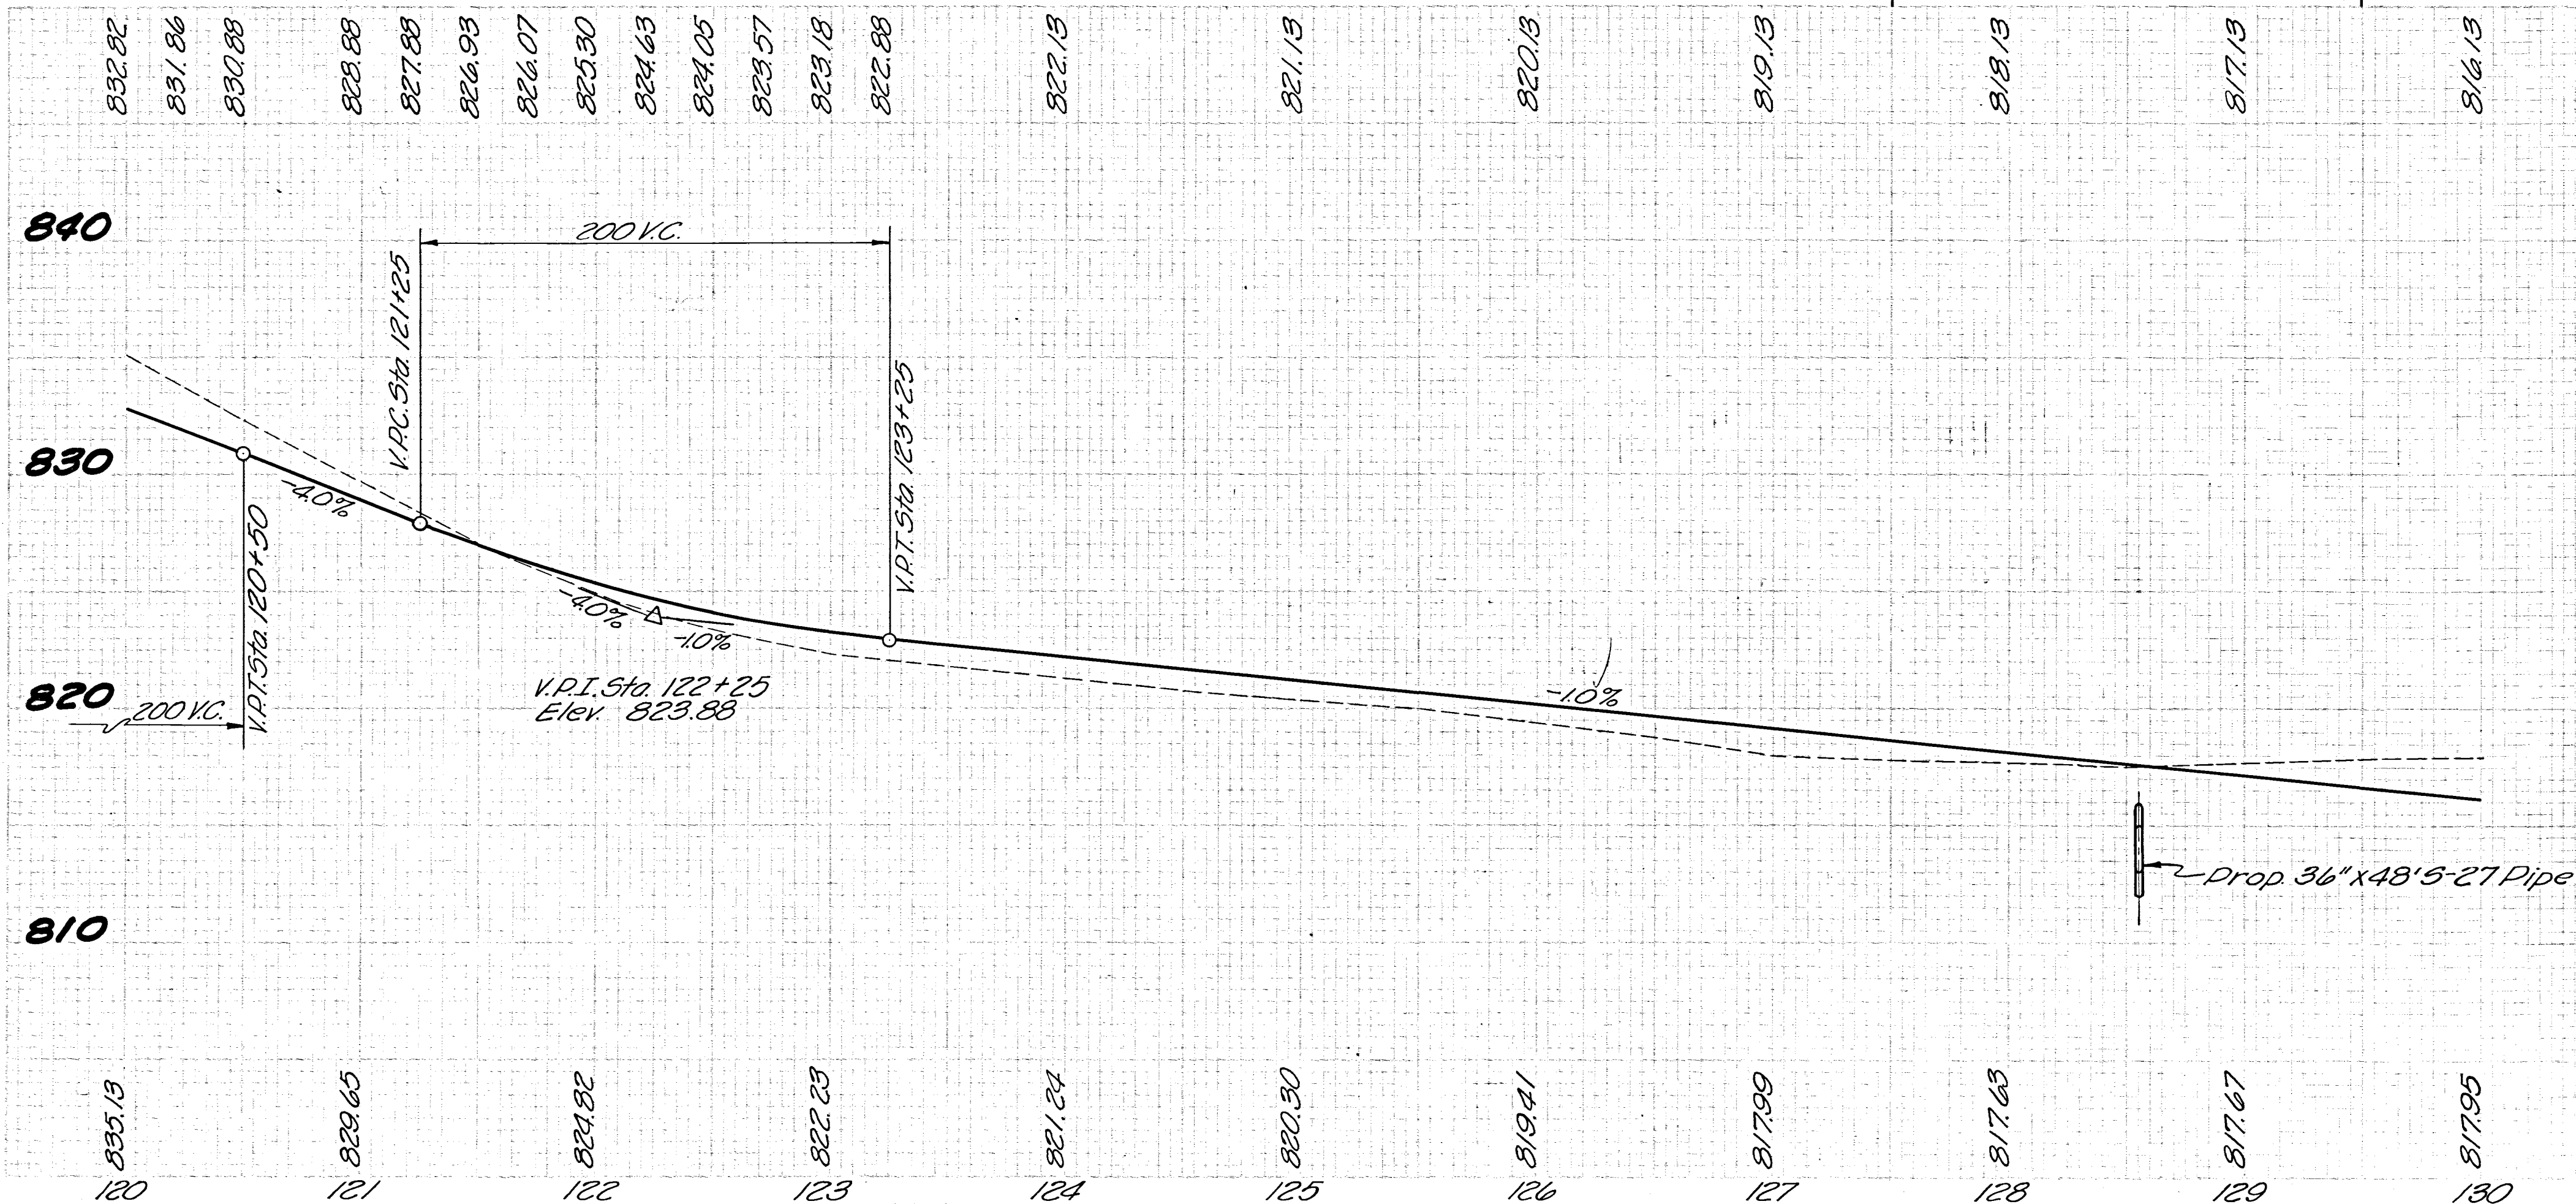

QUANTITIES

Reference Number	Station to Station	Side	E-12	I-18	Special	Special		
			Pipe Removed	Stabilized Crushed Aggregate for Surface & Approaches	Relocating Existing Telephone Lines	Relocating Existing Power Line		
1-R	122+20	Rt.	10" 12" Lin. Ft.	6" Cu. Yd.	Lump	Lump		
2-R	127+15	Rt.	25	11.81				
3-R	128+56	Rt.	22					
4-R	120+00 to 130+00	Lt.			Lump			
5-R	126+03	Rt.				Lump		
9	See Sheet No. 68							
TOTALS			22 25	11.81	Lump	Lump		

REVISION	DATE	AS CONSTRUCTED	DESCRIPTION	H.F.K. BY
	3/23/62			
U. S. ARMY ENGINEER DISTRICT, HUNTINGTON CORPS OF ENGINEERS HUNTINGTON, W. VA.				
DRAWN BY: WIC		LICKING RIVER DILLON RESERVOIR PROJECT		
CHECKED BY: F.H.S.		RELOCATION OF MUSKINGUM COUNTY ROAD NO. 8 MC-8-4 & MT- 408-1 MC-8-1 & MC- 408-1		
SUBMITTED BY: Elmer S. Barrett Associates		APPROVED: Steven Malench DATE: NOVEMBER 1959		
RECOMMENDED: Elmer S. Barrett Associates		COL. C.E., DISTRICT ENGINEER		
CHIEF ENG. DIV.		ELMER S. BARRETT ASSOCIATES CONSULTING ENGINEERS CHILLICOTHE, OHIO		
		SCALE: HORIZ. 1"=30' VERT. 1"=5' SPEC. NO. DRAWING NUMBER 027f- UD 14-68/ 16 SHEET 16 OF 83		