



MUSKINGUM COUNTY COUNTY ROAD NO. 8

QUANTITIES

Reference Number	Station to Station	Side	I-15 Woven Wire Type (12 Gauge) or Wire Cable Type (12 Gauge)	Special Oil Tanks Pipes, Fittings, Accessories, Relocated or Removed	Special Pipe for 8" Encasement
1-R	150+00 to 160+00	Lt.	1000	Lump	160
2-R	150+00 to 160+00	Rt.	1000	Lump	160
3-R	158+24	Lt.		Lump	160
TOTALS			2000	Lump	160

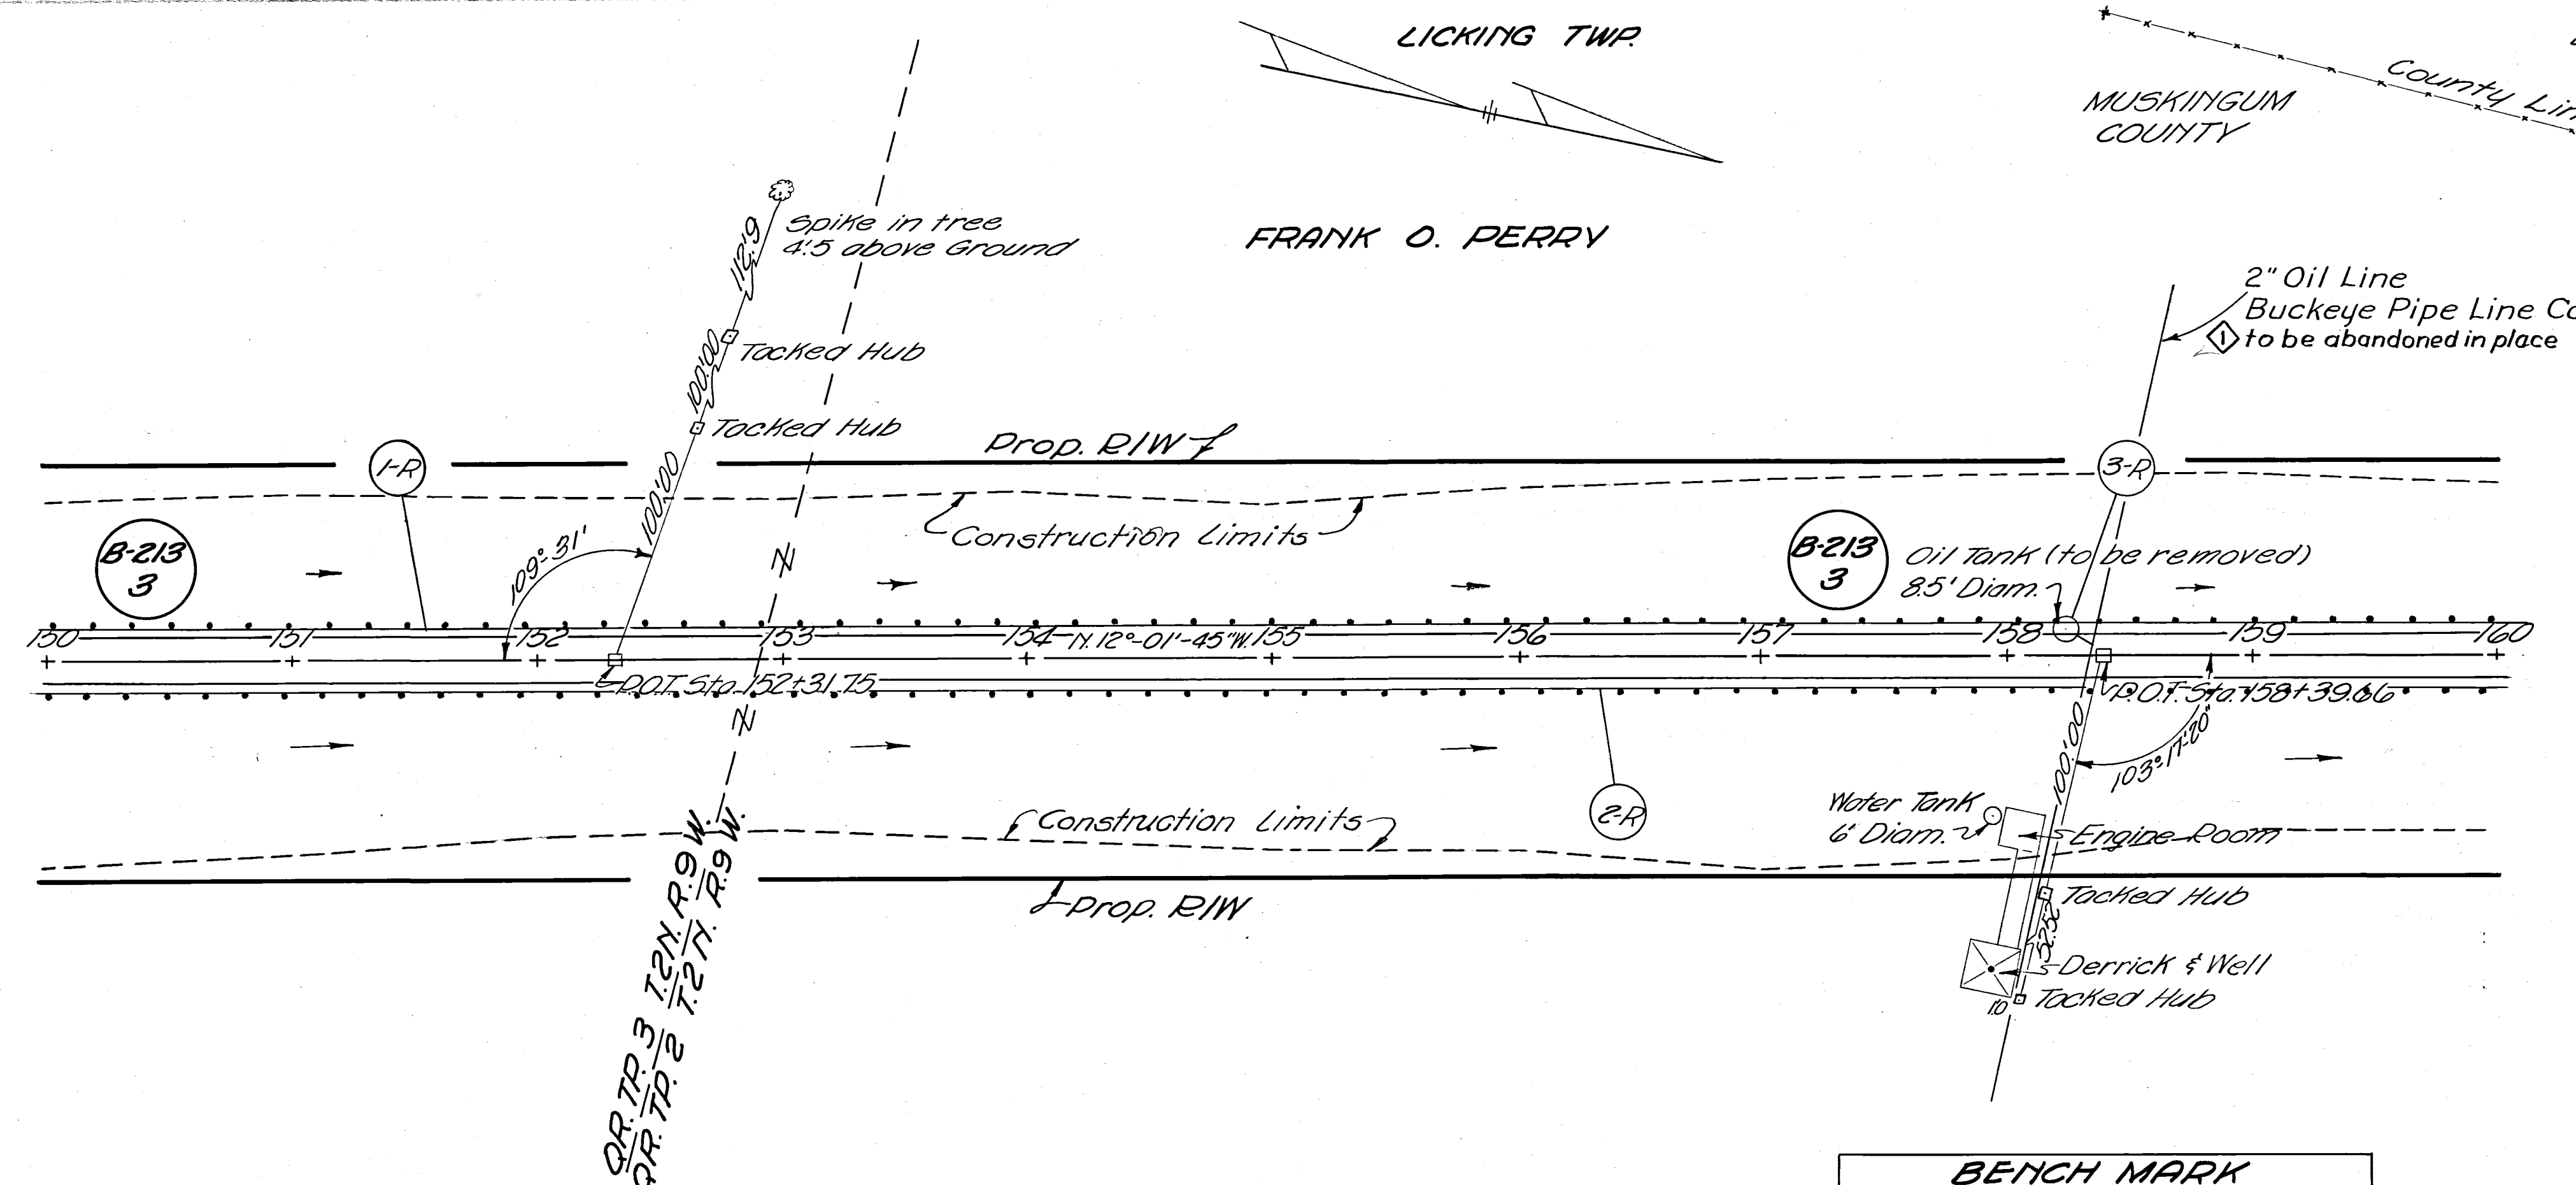

BENCH MARK
a on Concrete Pillar S.E.
Corner Oil Well Platform
140' Rt. & Sta. 158+00
Elev. 758.46

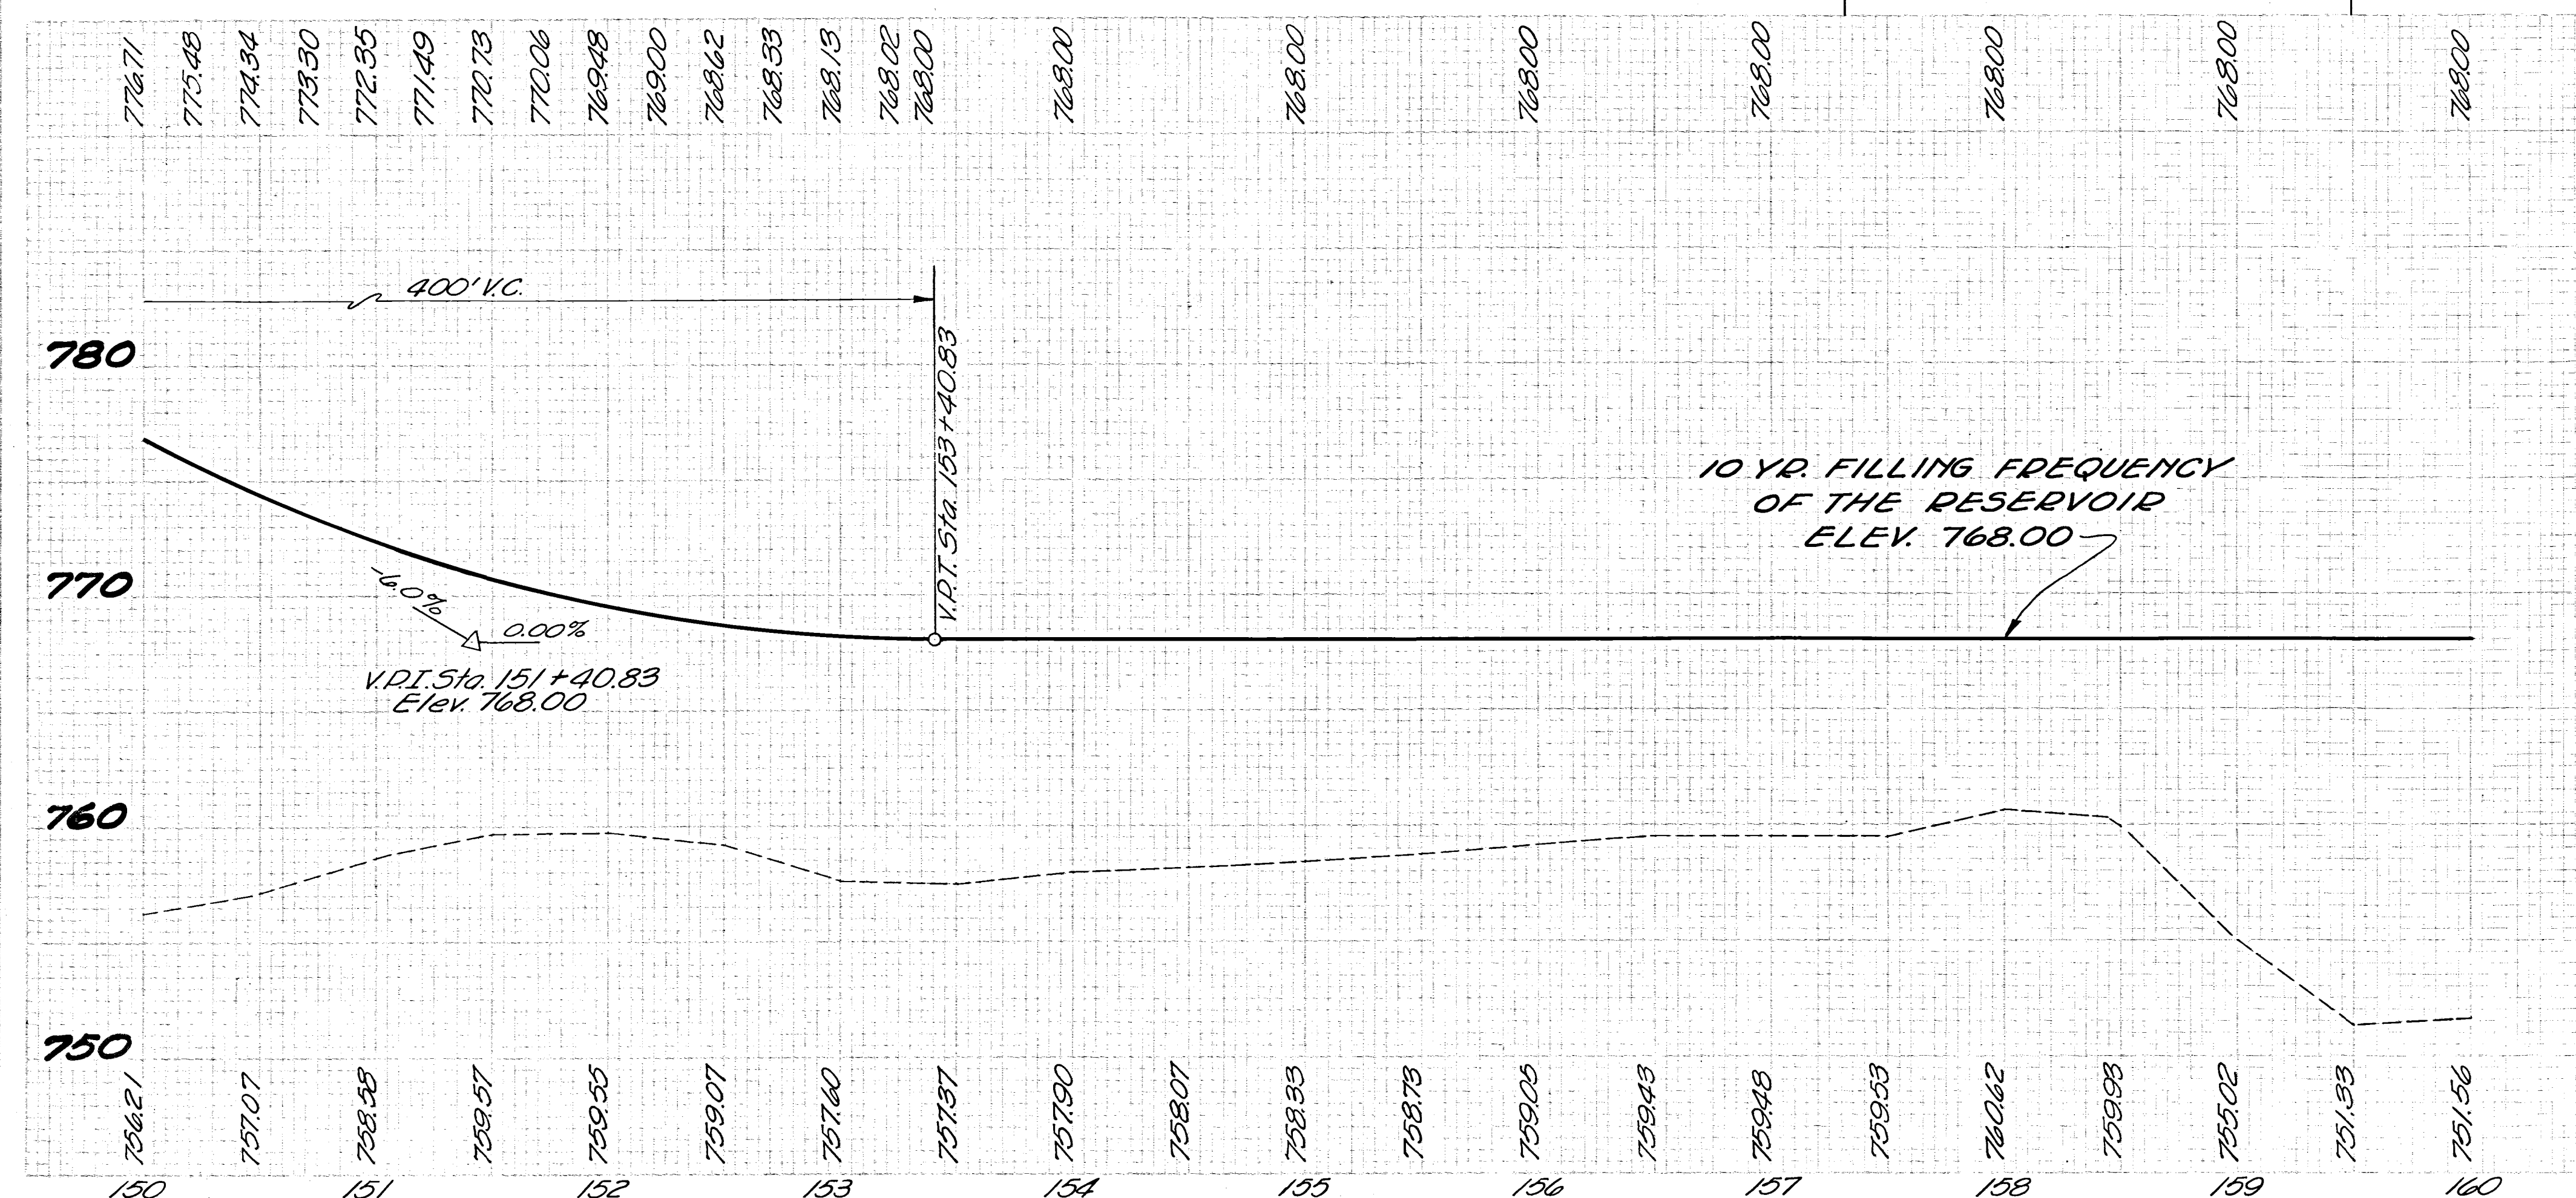

3/23/62	AS CONSTRUCTED	H.F.K.
1-13-60	REVISED IN ACCORDANCE WITH ADDENDUM NO. 4	D.C.J.
REVISION	DATE	DESCRIPTION
U. S. ARMY ENGINEER DISTRICT, HUNTINGTON CORPS OF ENGINEERS HUNTINGTON, W. VA.		
DRAWN BY: EER		
TRACED BY:		
CHECKED BY: F.H.S.		
SUBMITTED BY: Elmer S. Barrett		
ELMER S. BARRETT ASSOCIATES		
RECOMMENDED: James J. Sumner		
CHIEF ENG. DIV.		
APPROVED: Steven Malen		
DATE: NOVEMBER 1959		
ELMER S. BARRETT ASSOCIATES CONSULTING ENGINEERS CHILLICOTHE, OHIO		
SCALE: HORIZ. 1"=50' VERT. 1"=5'		
SPEC. NO.		
DRAWING NUMBER		
027f-UD14-68/19		
SHEET 19 OF 83		