
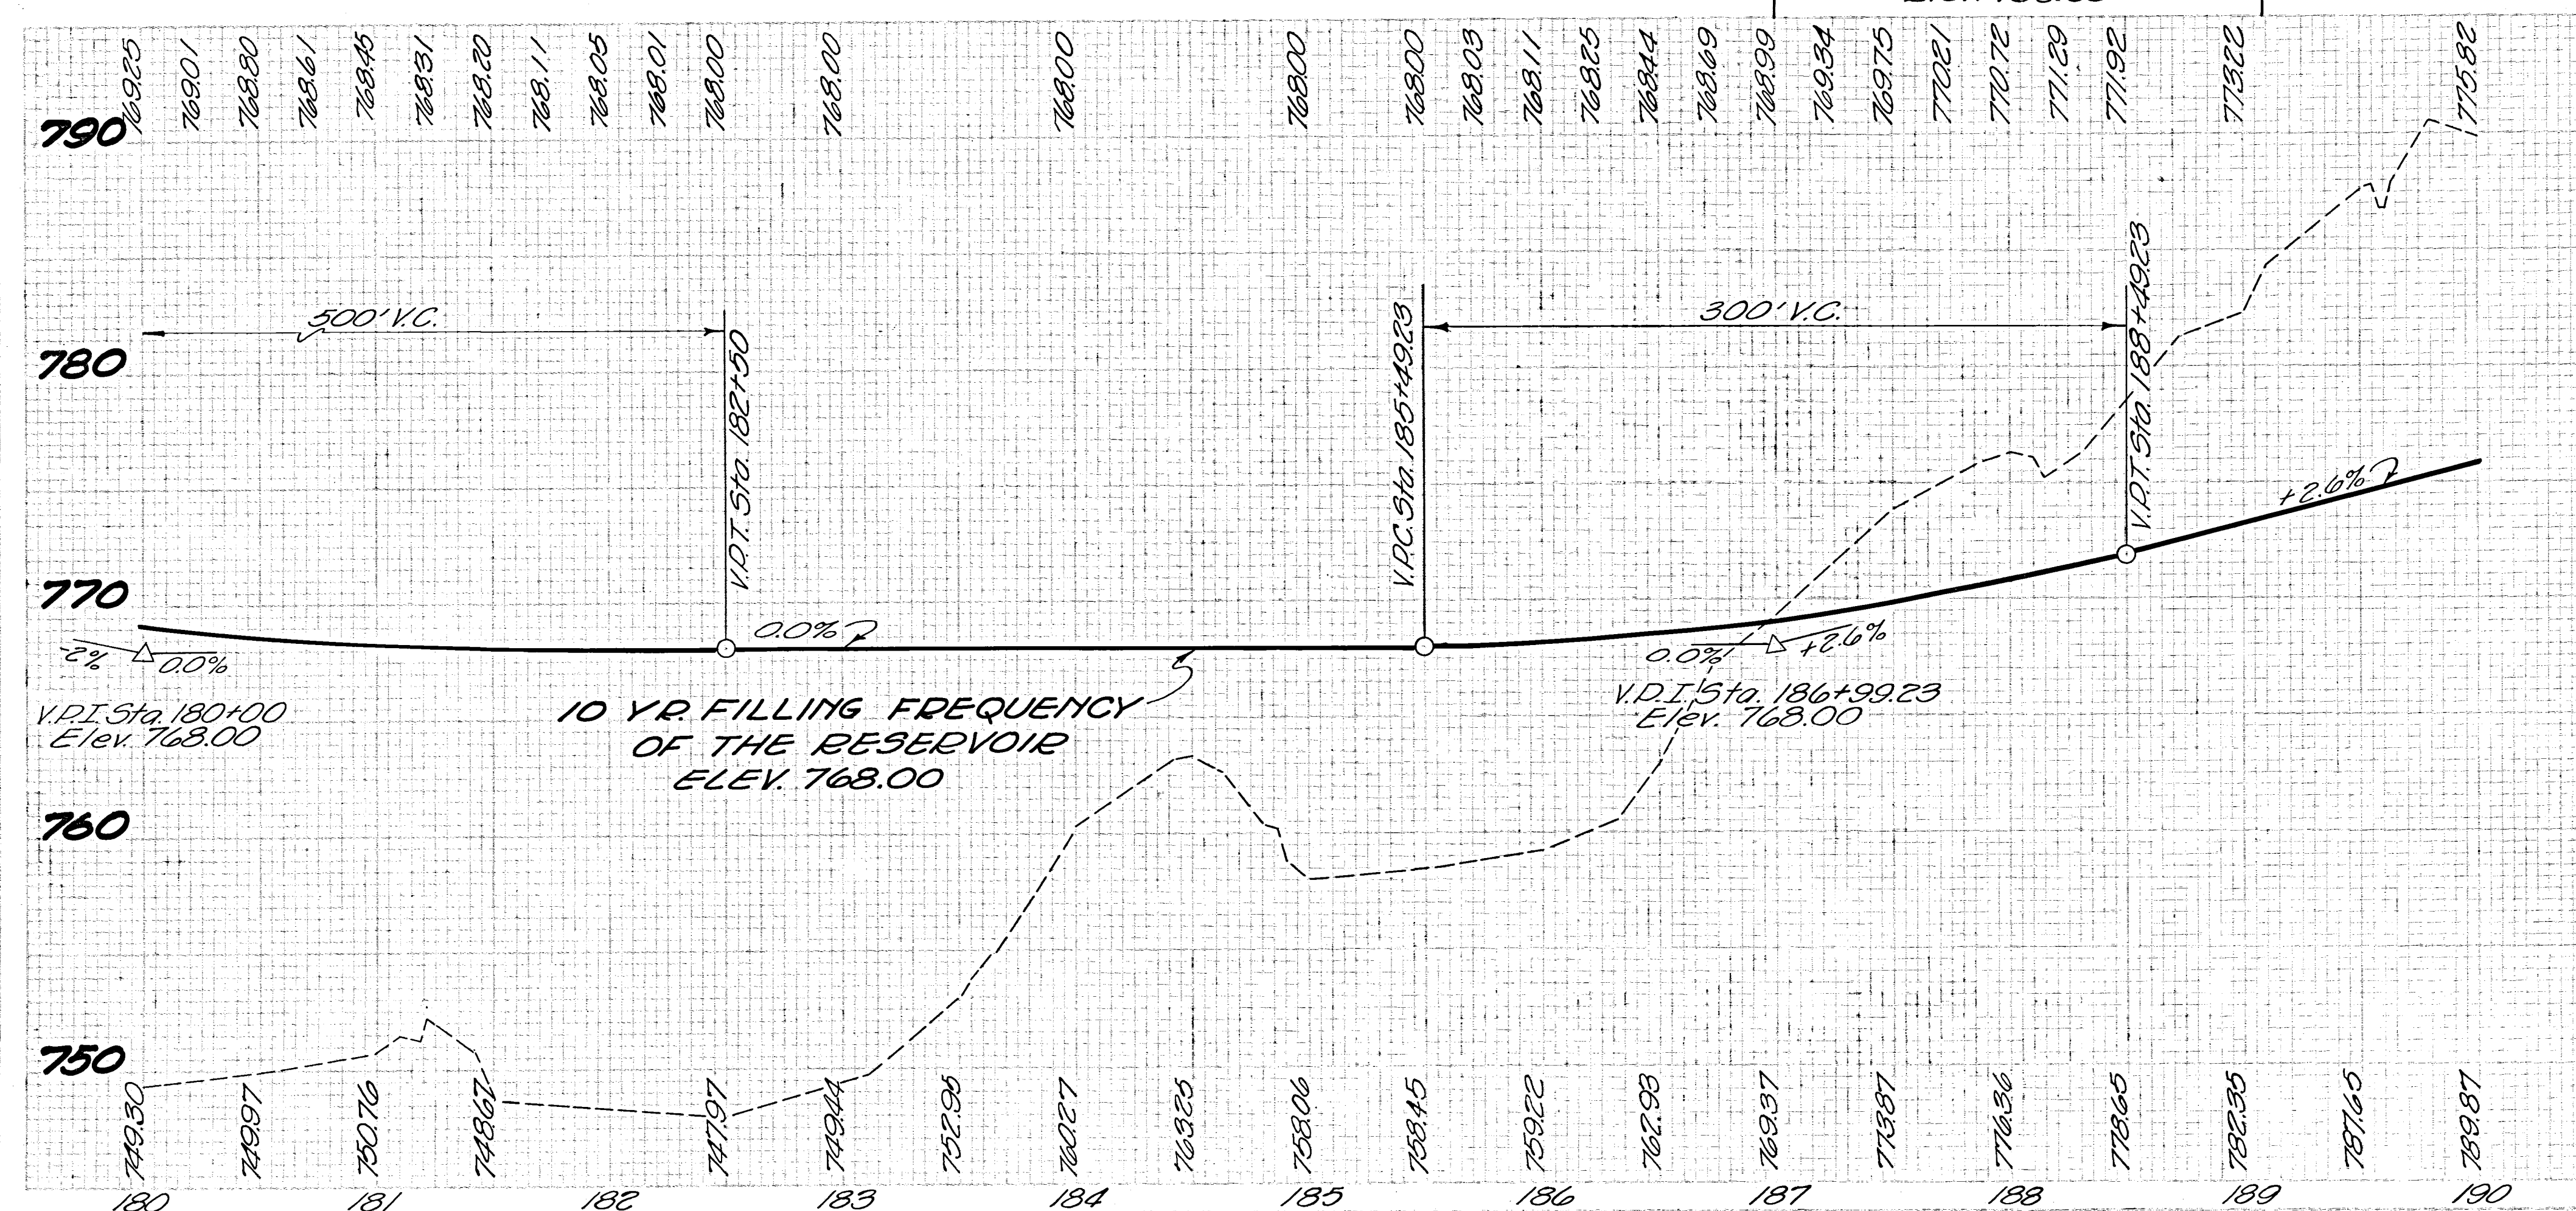


MUSKINGUM COUNTY
COUNTY ROAD NO. 8

QUANTITIES

Reference Number	Station to Station	Side	Notes	Special	Special	Special	Special
1-R	180+00 to 185+61.86	Lt.	56300				
2-R	180+00 to 188+64.83	Rt.	84232				
3-R	181+87	Rt.		Lump	110		
4-R	181+26	Rt.				Lump	
TOTALS			142532	Lump	110	Lump	

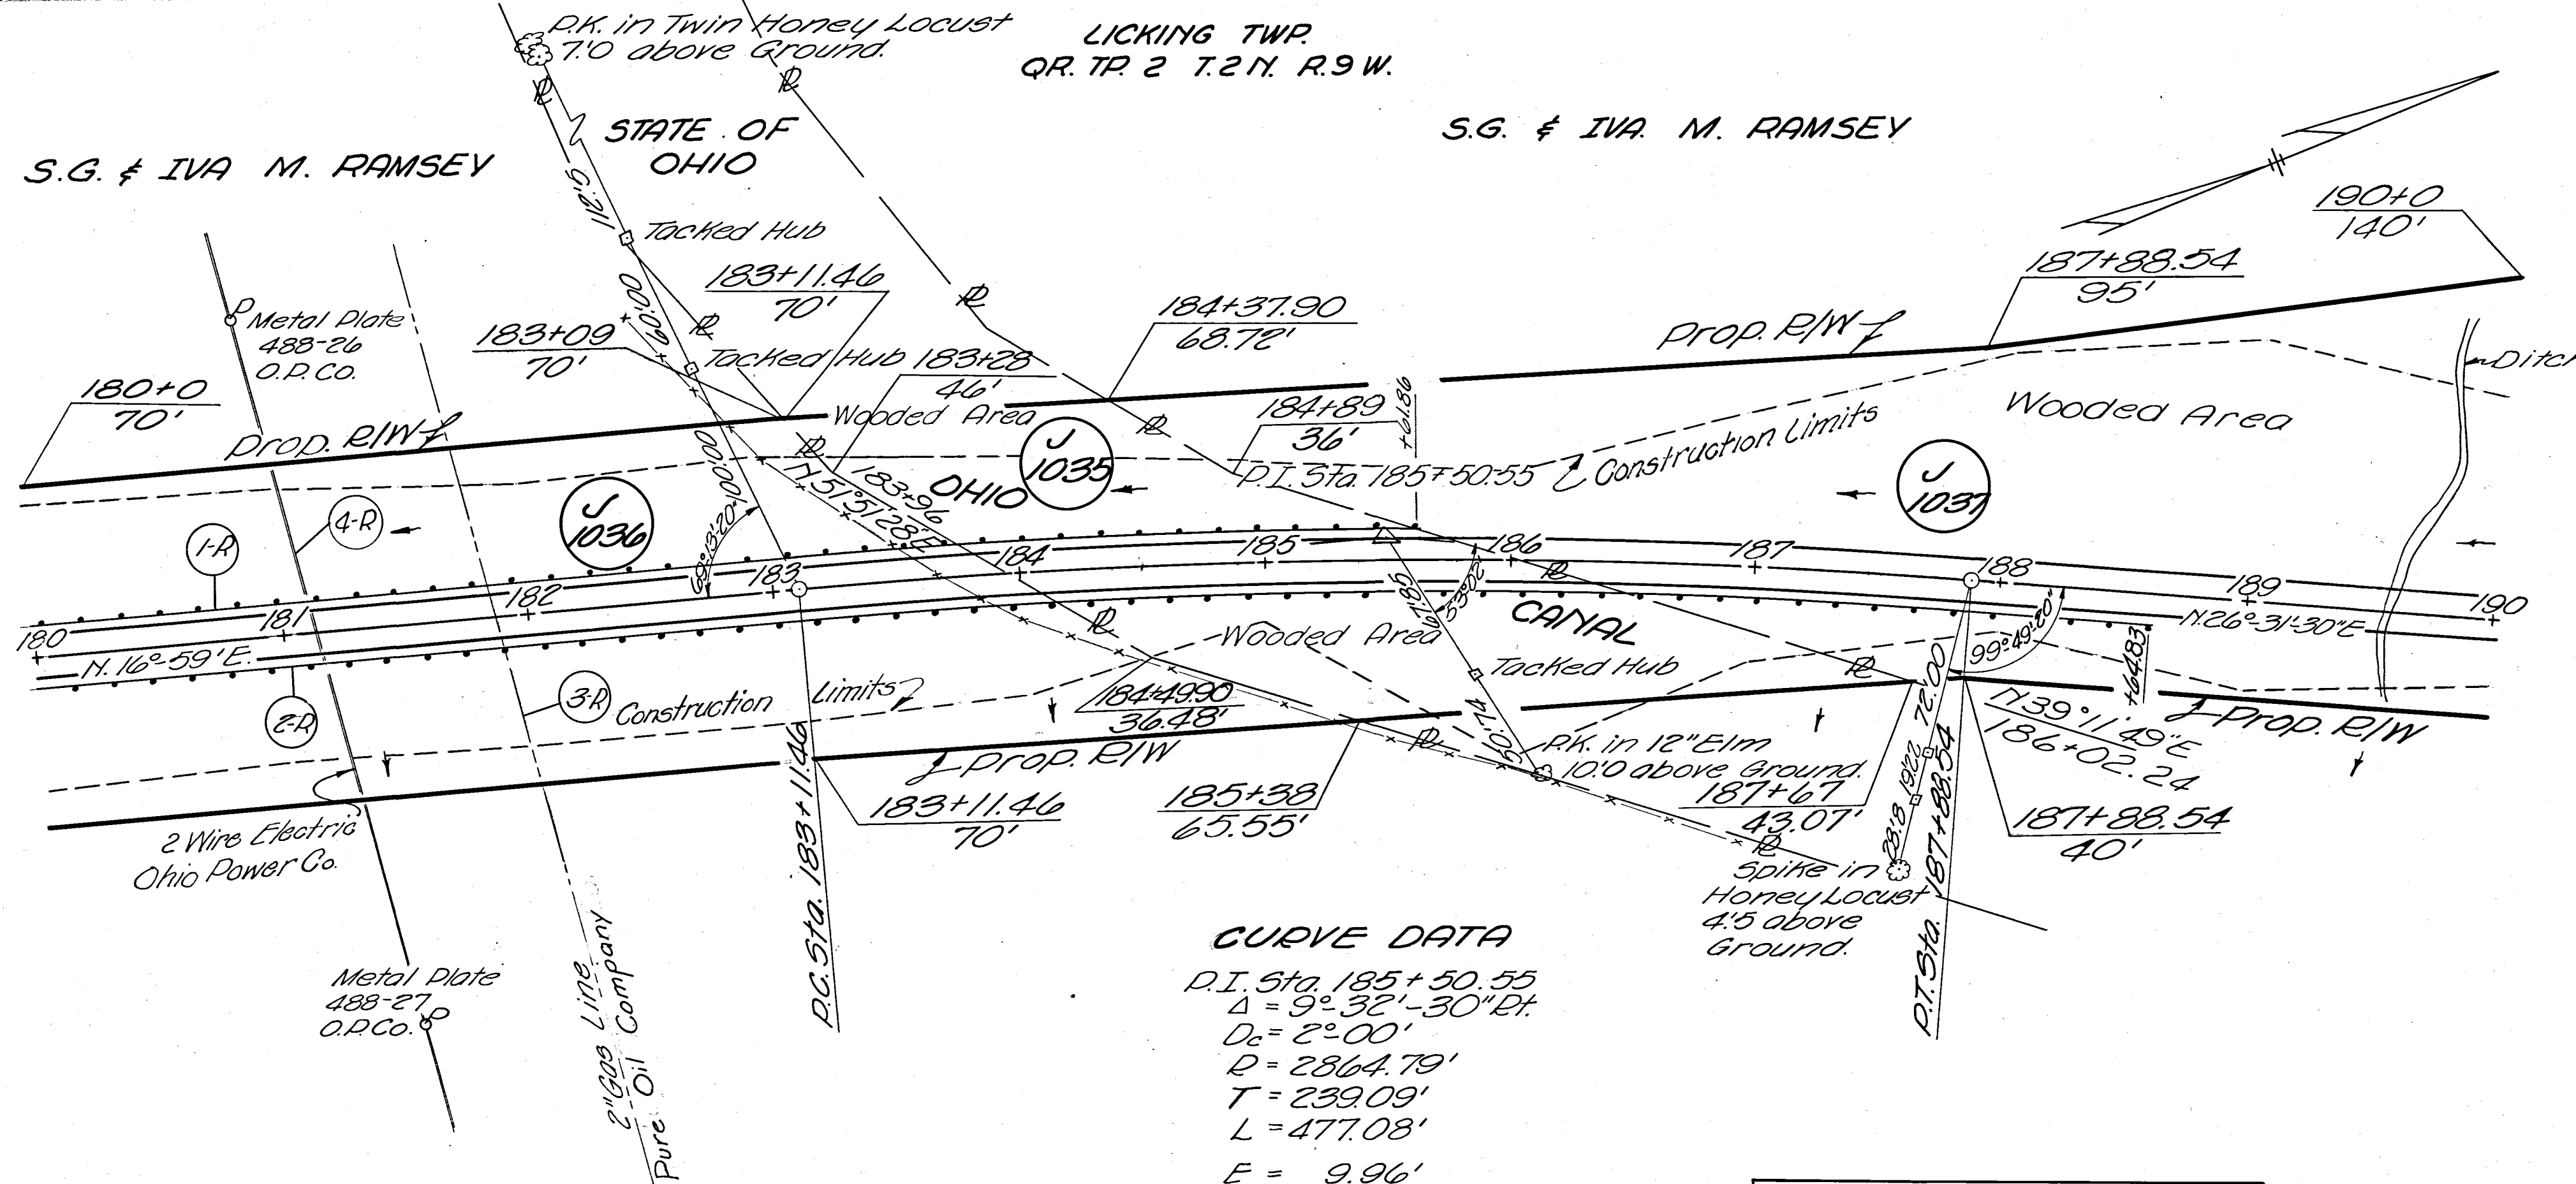

3/23/62 AS CONSTRUCTED H.F.K.

REVISION DATE DESCRIPTION BY

U. S. ARMY ENGINEER DISTRICT, HUNTINGTON
CORPS OF ENGINEERS
HUNTINGTON, W. VA.

DRAWN BY: EER
 TRACED BY:
 CHECKED BY: *Phil*
 SUBMITTED BY: *Elmer S. Barrett*
 ELMER S. BARRETT ASSOCIATES
 RECOMMENDED: *James J. Barrett*
 CHIEF ENG. DIV.

APPROVED: *Steven Malench*
 COL. G. E. DISTRICT ENGINEER
 DATE: NOVEMBER 1959

LICKING RIVER
DILLON RESERVOIR PROJECT
 RELOCATION OF MUSKINGUM COUNTY ROAD NO. 8
 MC-8-4 8MT-408-1
 MC-8-1 & MC-408-1

ELMER S. BARRETT ASSOCIATES
CONSULTING ENGINEERS
CHILLICOTHE, OHIO

SCALE: 1"=50' SPEC. NO.
 DRAWING NUMBER
 027f-UD14-68/22
 SHEET 22 OF 83