


Seeding	End Sq. Width Yds.
59	678
63	524
59	448
52	600
56	606
53	600
55	528
40	428
37	406
36	394
35	

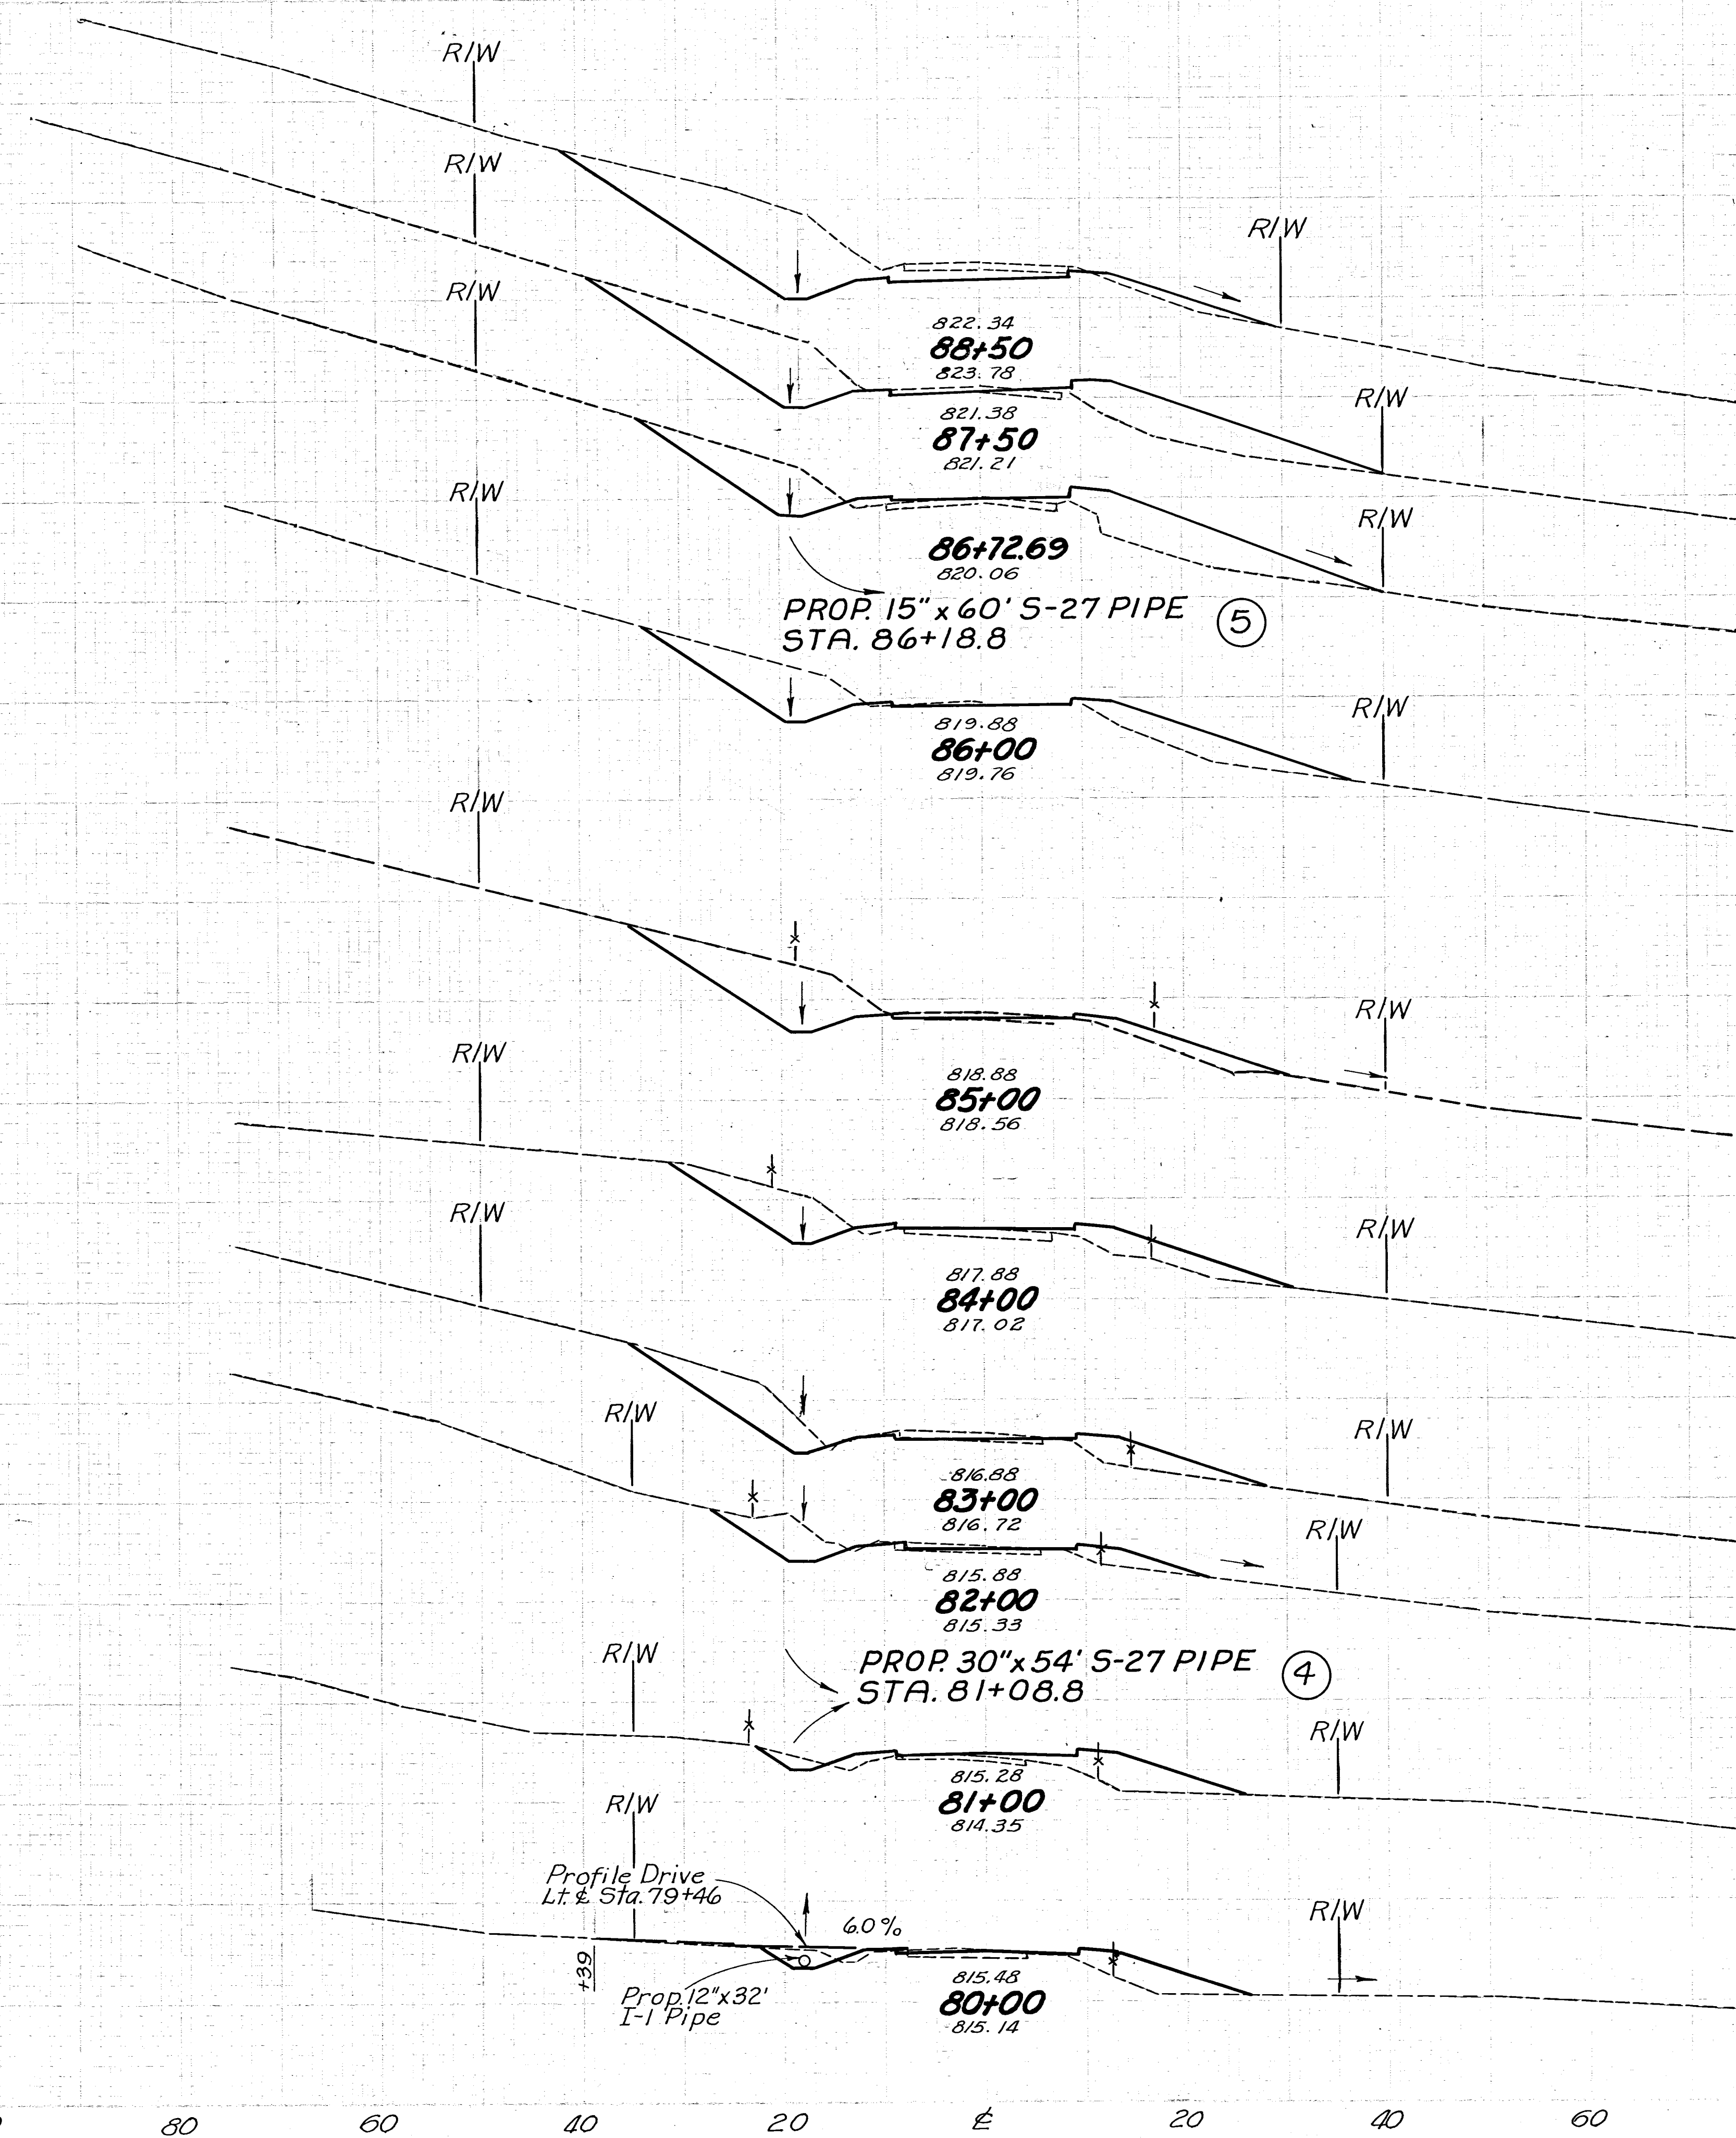

Drive Lt. & Sta. 79+46
Sta. 79+00

End Area		Volume	
Cut	Fill	Cut	Fill
188	13	550	141
109	63	246	209
63	83	178	141
69	22	307	83
97	23	283	111
56	37	219	126
62	31	181	93
36	19	93	130
14	51	46	159
11	35	10	128
10	34		

3/23/62	AS CONSTRUCTED	H.F.K.
REVISION	DATE	DESCRIPTION
U. S. ARMY ENGINEER DISTRICT, HUNTINGTON CORPS OF ENGINEERS HUNTINGTON, W. VA.		
DRAWN BY: WIC TRACED BY: CHECKED BY: J.H.B. SUBMITTED BY: Elmer S. Barrett Associates RECOMMENDED BY: James J. Barrett CHIEF ENG. DIV.		
LICKING RIVER DILLON RESERVOIR PROJECT RELOCATION OF MUSKINGUM COUNTY ROAD NO. 8 MC-8-4 & MT-408-1 MC-8-1 & MC-408-1 APPROVED: Steven Malenich COL. C. E. DISTRICT ENGINEER DATE: NOVEMBER 1959		
SCALE: 1"=10' SPEC. NO. DRAWING NUMBER 027f-UD 14-68/28 SHEET 28 OF 83		