


Seeding	
End	Sq.
Width	Yds.

REC. PD. DIVISION	STATE	PROJECT	
2	OHIO		

34

83

**MUSKINGUM COUNTY
COUNTY ROAD NO. 8**

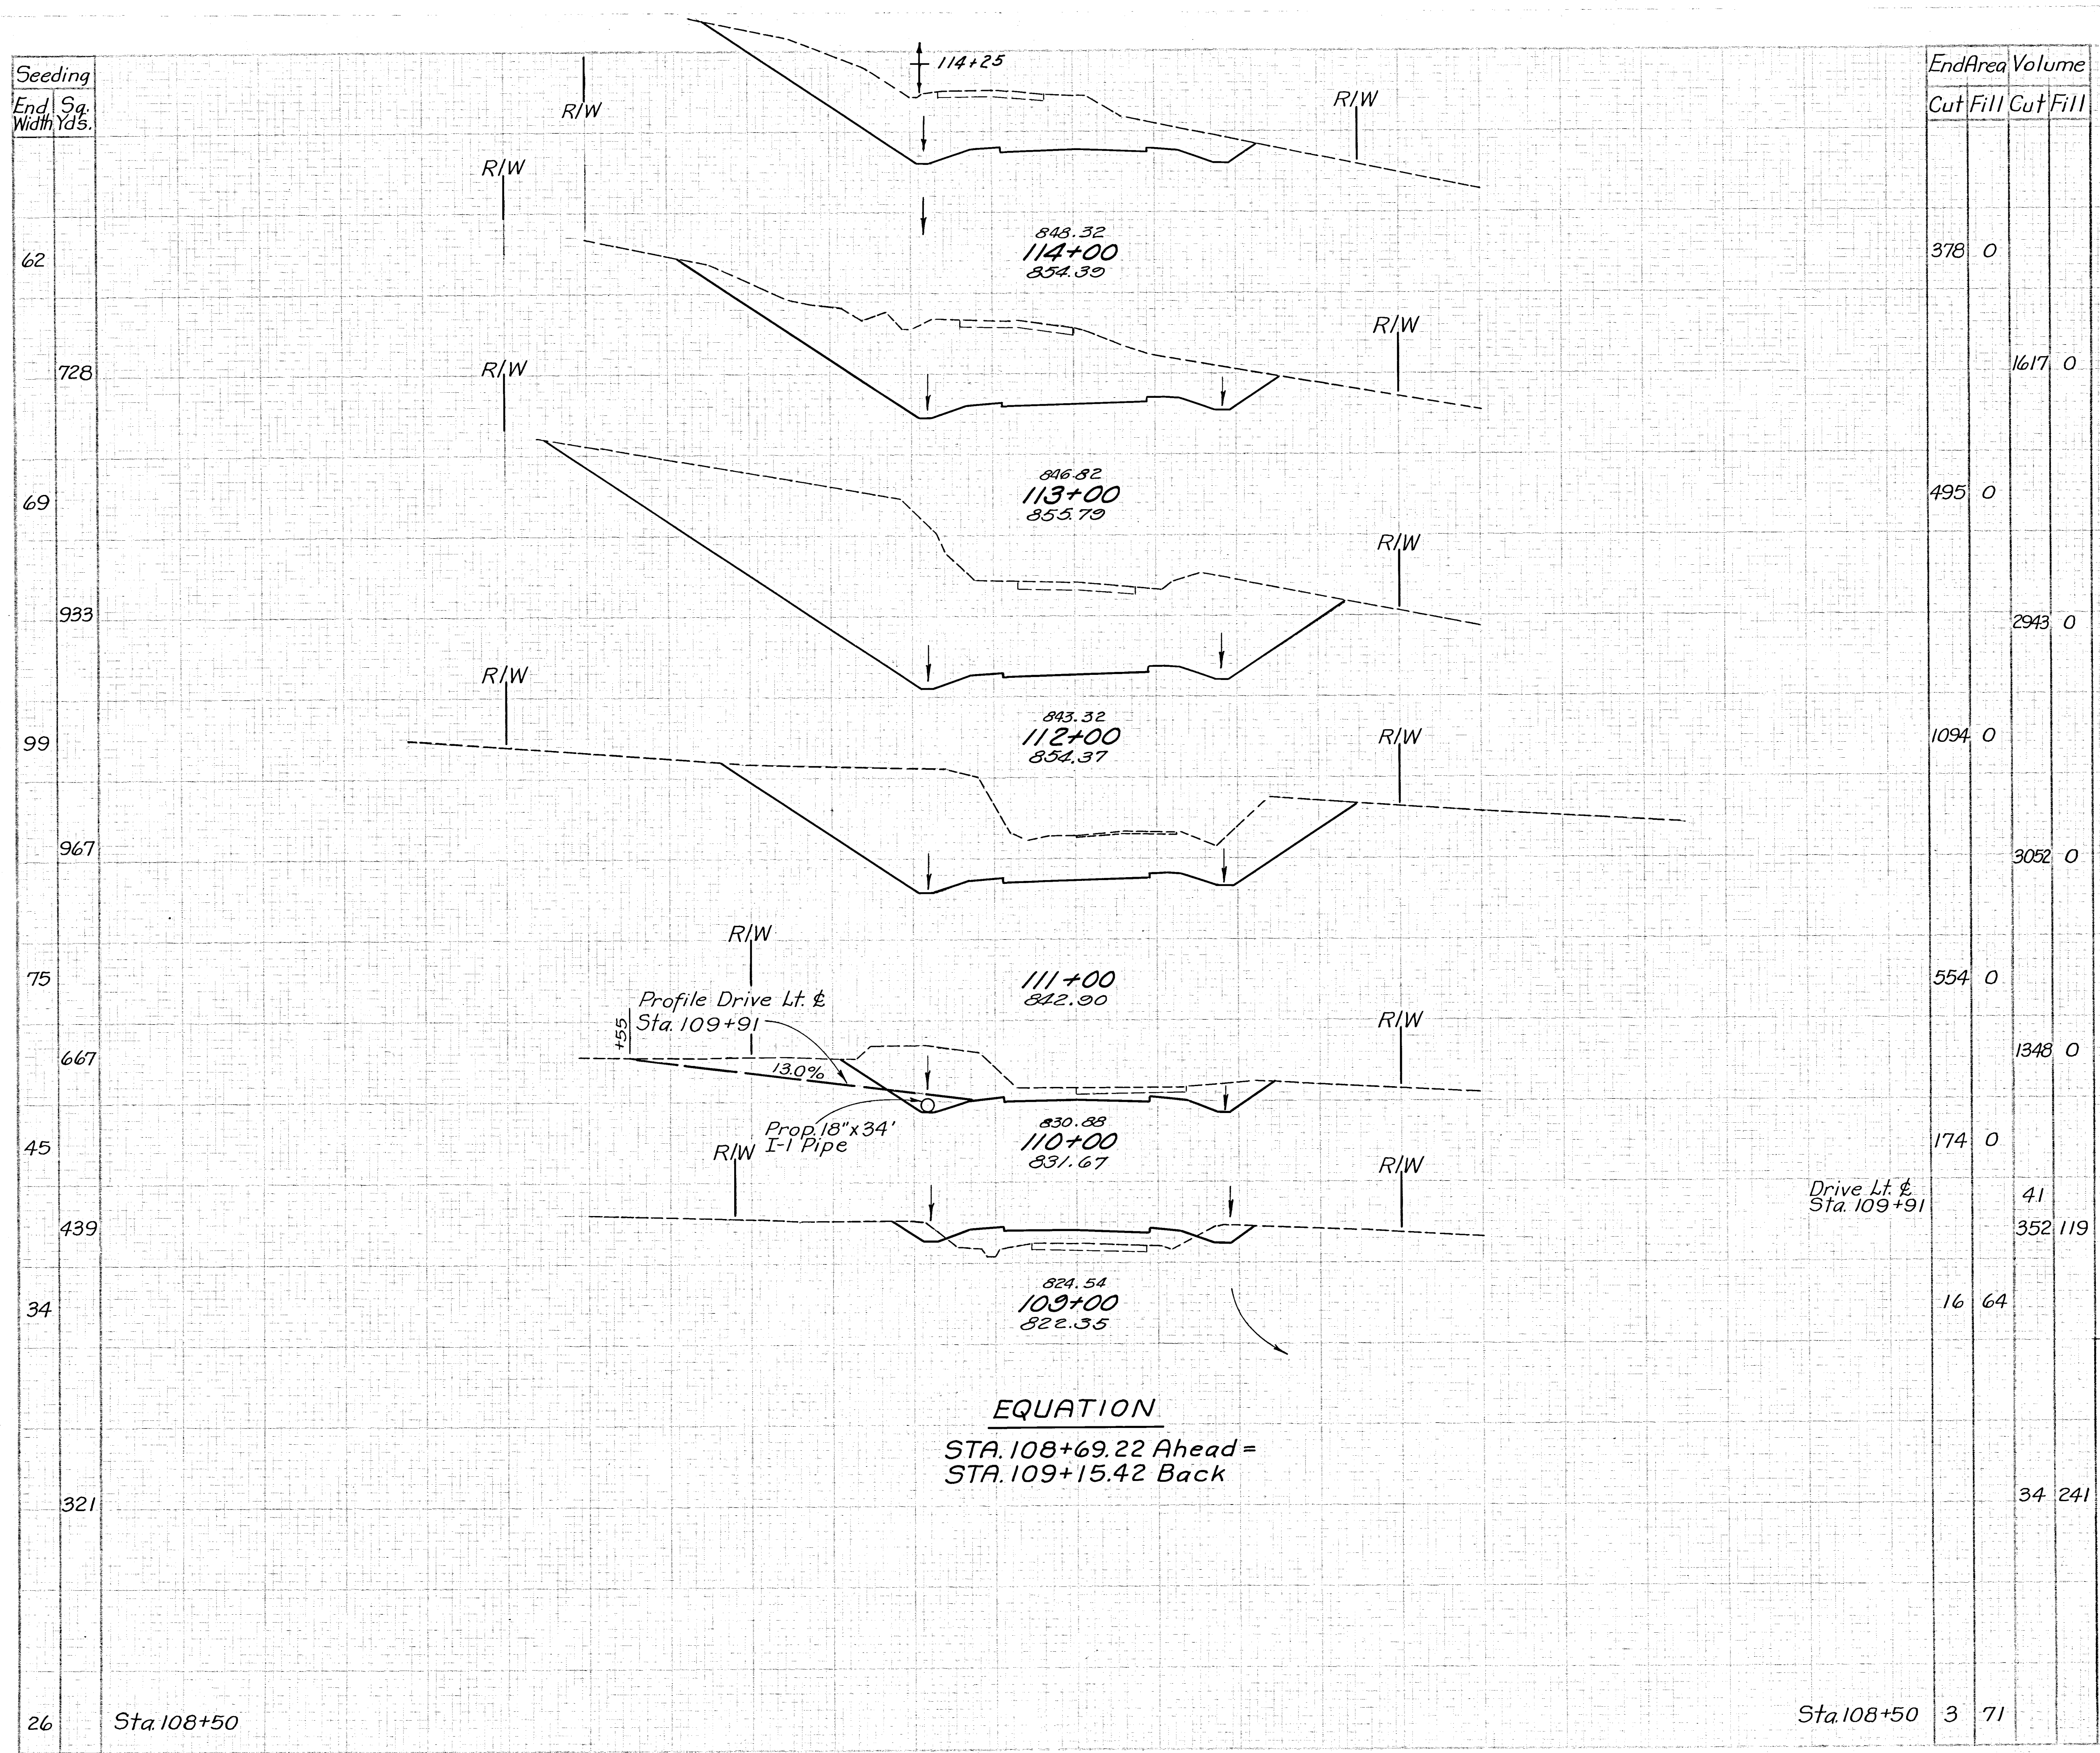

End Area		Volume	
Cut	Fill	Cut	Fill
378	0		
		1617	0
495	0		
		2943	0
1094	0		
		3052	0
554	0		
		1348	0
174	0		
891		41	
		352	119
16	64		
		34	241
0	371		

EQUATION
STA. 108+69.22 Ahead =
STA. 109+15.42 Back

3/23/62 AS CONSTRUCTED		H.F.K.
REVISION	DATE	DESCRIPTION
		BY
U. S. ARMY ENGINEER DISTRICT, HUNTINGTON CORPS OF ENGINEERS HUNTINGTON, W. VA.		
DRAWN BY: <i>WIC</i> TRACED BY: CHECKED BY: <i>File</i> SUBMITTED BY: <i>Elmer S. Barrett</i> ELMER S. BARRETT ASSOCIATES RECOMMENDED: CHIEF ENG. DIV.		LICKING RIVER DILLON RESERVOIR PROJECT RELOCATION OF MUSKUMING COUNTY ROAD NO 8 MC-8-4 & MT-408-1 M-8-1 & MC-408-1 APPROVED: <i>Steven Malachuk</i> COL. C. E. DISTRICT ENGINEER DATE: NOVEMBER 1959
ELMER S. BARRETT ASSOCIATES CONSULTING ENGINEERS CHILLICOTHE, OHIO		SCALE: 1"=10' DRAWING NUMBER 027-UD 14-68/34 SHEET 34 OF 83

STA. 109+00 To STA. 114+00