


Seeding	
End Width	Sq. Yds.
43	
433	
35	
444	
45	
556	
55	
622	
57	
650	
60	
578	
44	
489	
44	
628	
69	
717	
60	
678	
62	

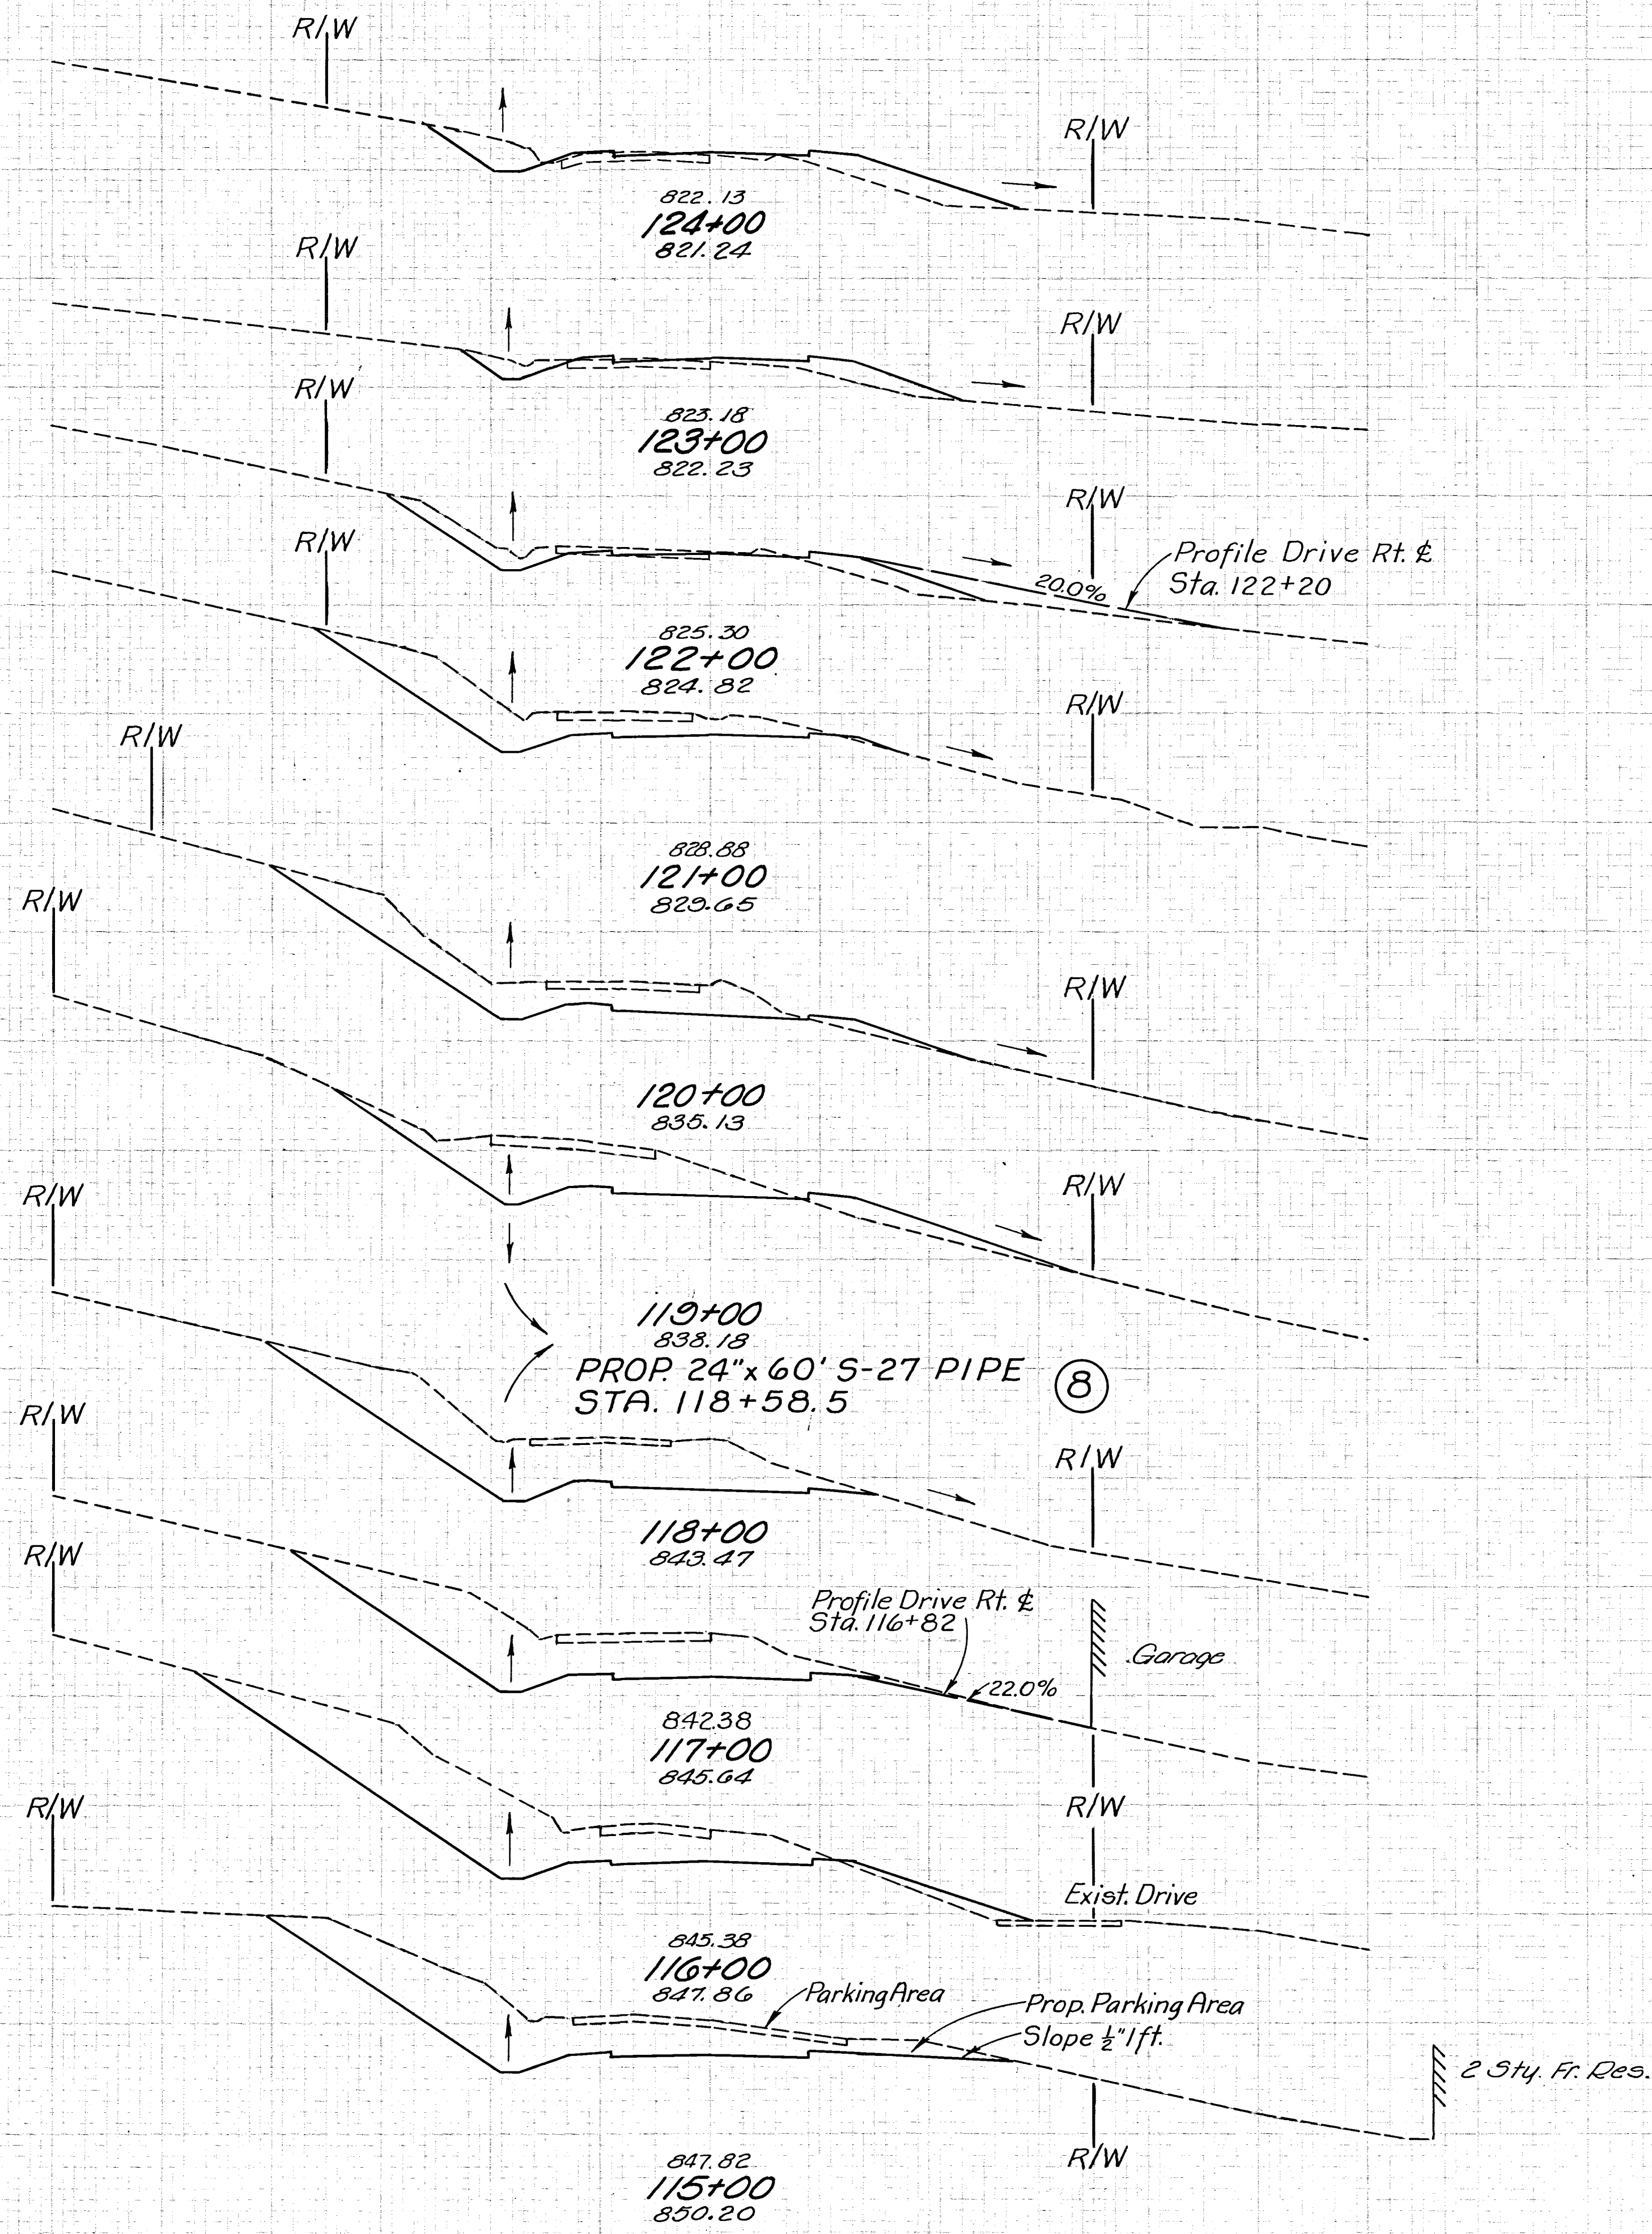

End Area		Volume	
Cut	Fill	Cut	Fill
19	34		
		52	113
9	27		
		74	87
		18	
31	20		
		452	39
113	1		
		450	17
130	8		
		474	61
126	25		
		626	46
212	0		
		781	0
210	0		
		2	
		854	22
251	12		
		867	22
217	0		
		1102	0
378	0		

3/23/62	AS CONSTRUCTED	H.F.K.
REVISION	DATE	DESCRIPTION
		U. S. ARMY ENGINEER DISTRICT, HUNTINGTON CORPS OF ENGINEERS HUNTINGTON, W. VA.
DRAWN BY: WIC	LICKING RIVER DILLON RESERVOIR PROJECT	
CHECKED BY: JLL	RELOCATION OF MUSKINGUM COUNTY ROAD NO. 8	
SUBMITTED BY: Elmer S. Barrett Associates	MC-8-4 8 MT- 408-1 MC-8-1 8 MC- 408-1	
RECOMMENDED BY: [Signature] CHIEF ENG. DIV.	APPROVED: Steven Malench COL. C. E. DISTRICT ENGINEER	DATE: NOVEMBER 1959
ELMER S. BARRETT ASSOCIATES CONSULTING ENGINEERS CHILLICOTHE, OHIO		SCALE: 1"=10' DRAWING NUMBER 0271-UD 14-68/35 SHEET 35 of 83

WORK AS CONSTRUCTED **STA. 115+00 TO STA. 124+00**