


Seeding	End Width	Sq. Yds.
33		
339		
28		
261		
19		
160		
32		
162		
35		
367		
31		
450		
50		
522		
44		
483		
43		
472		
42		
450		
39		
456		
43		

Sta. 124+00

60 40 20 20 40 60

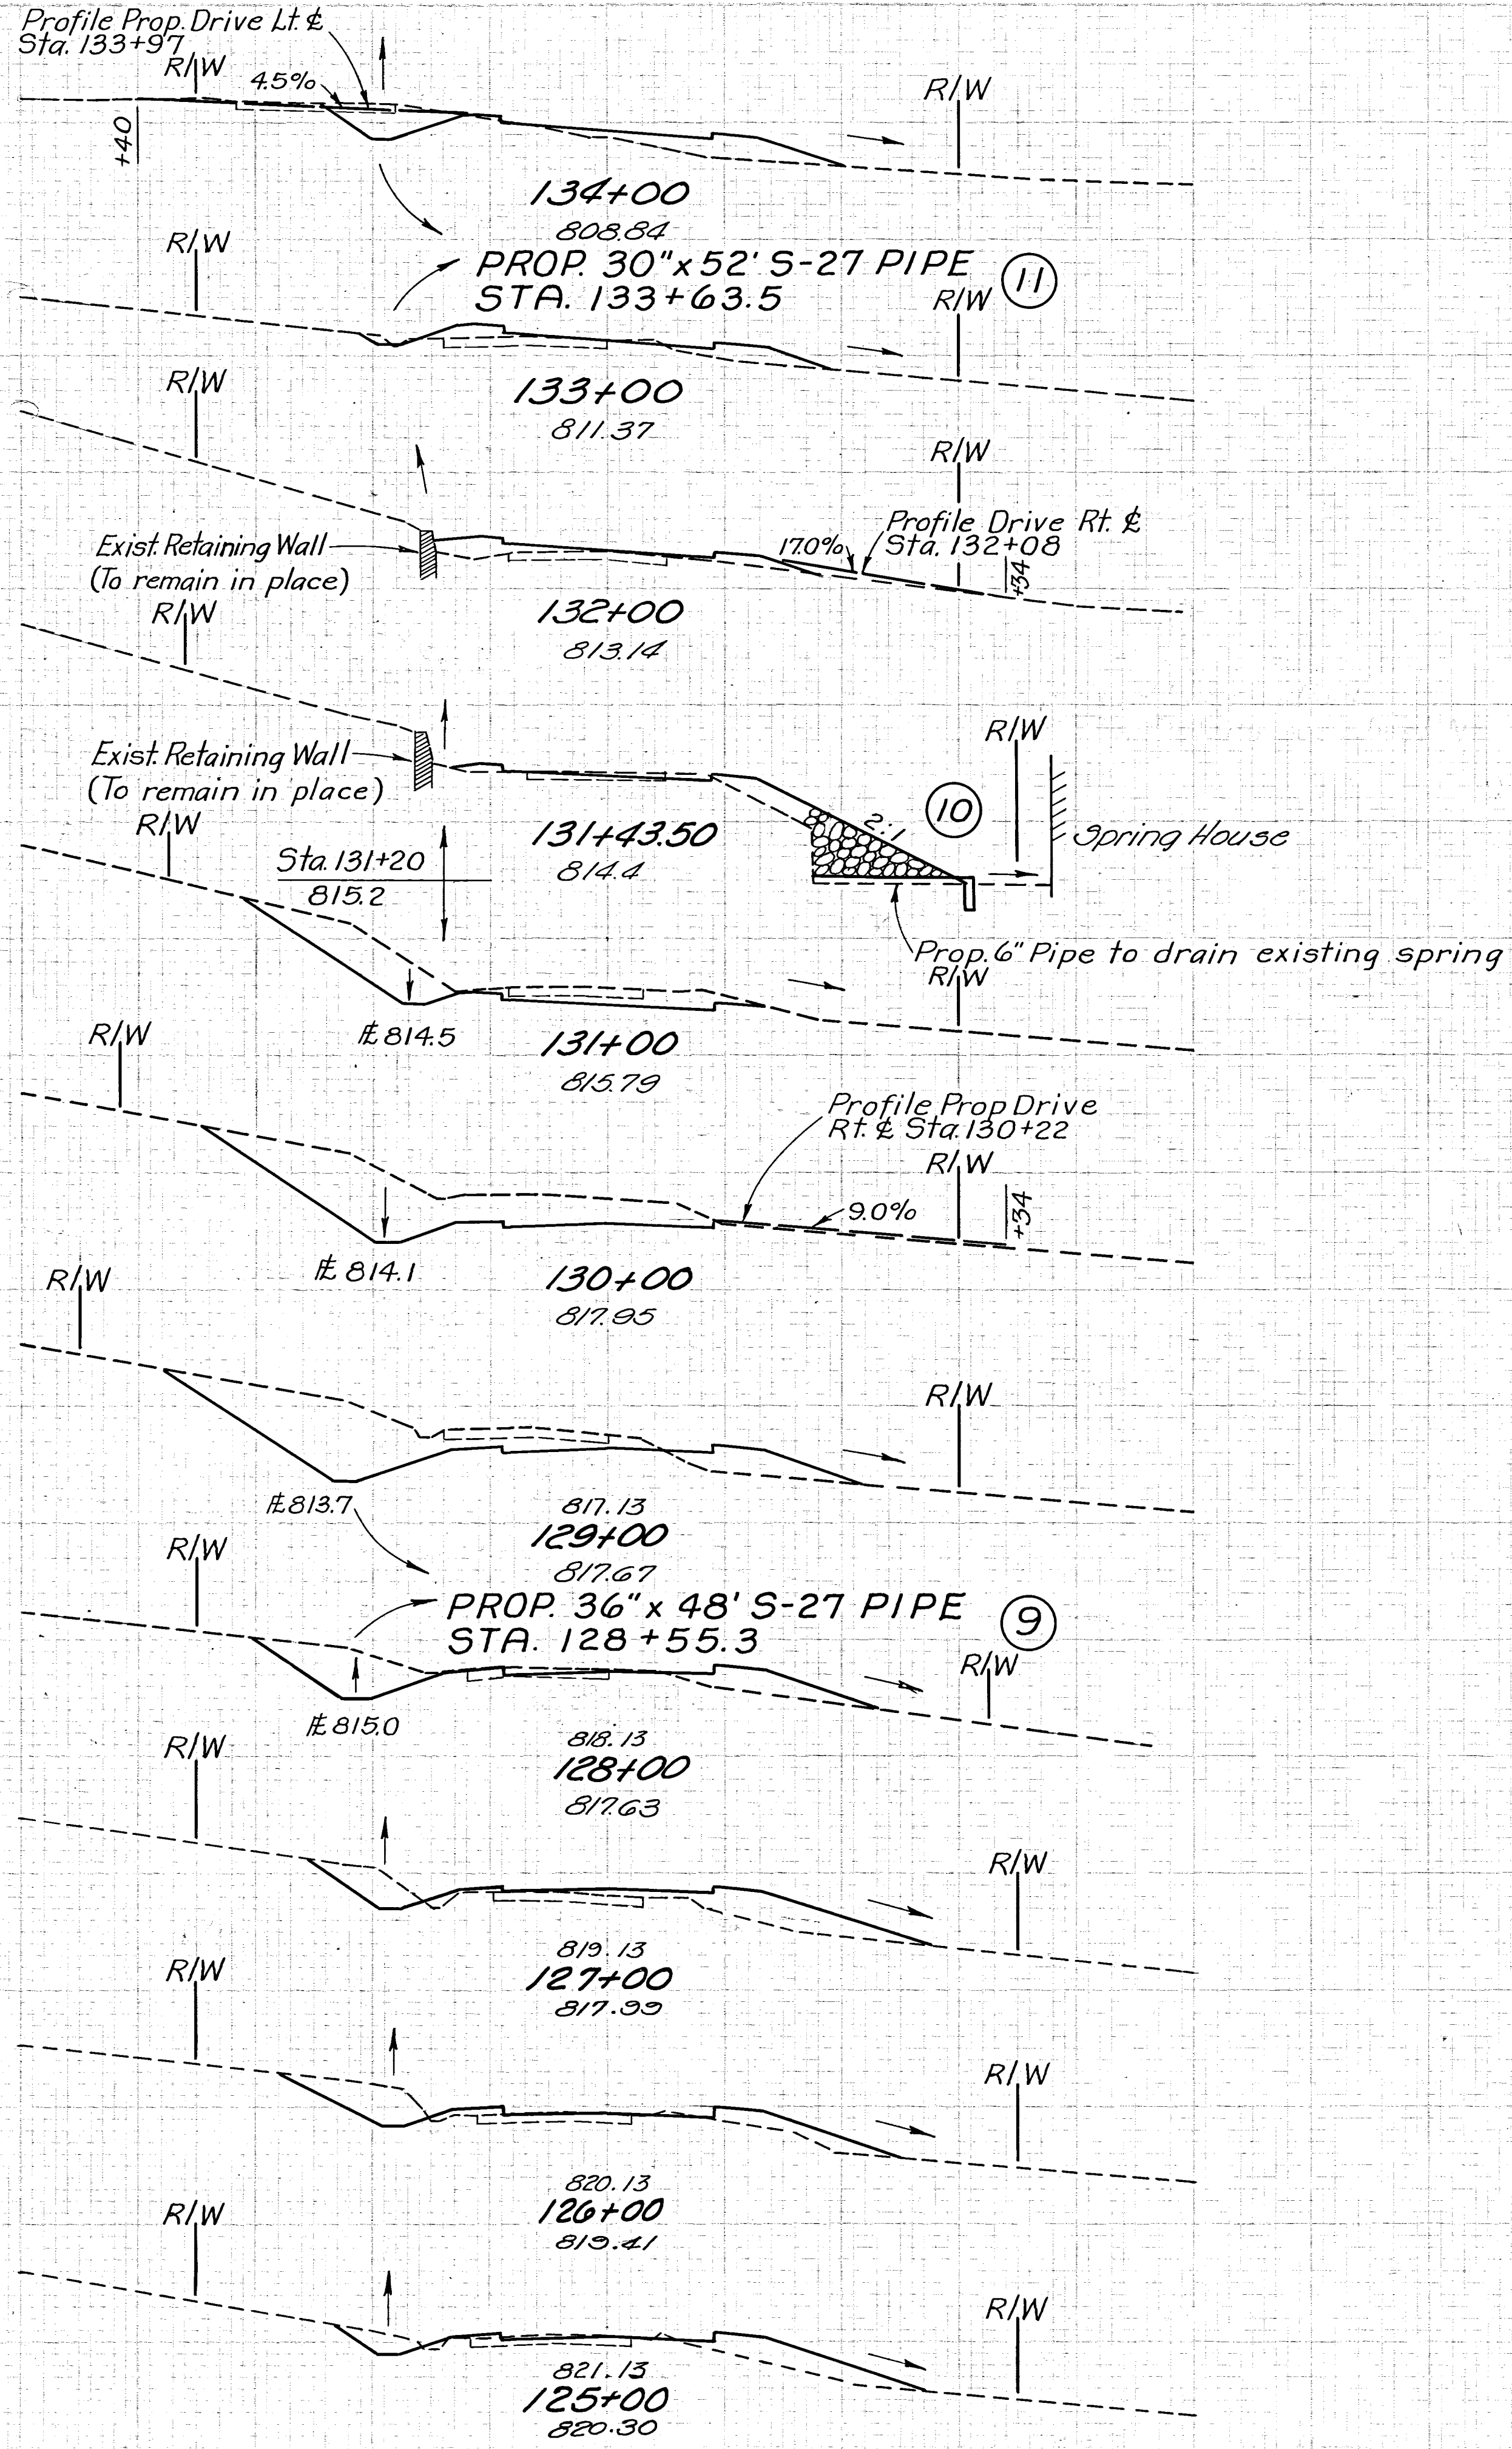

Drive Lt. & Sta. 133+97

Drive Rt. & Sta. 132+08

Drive Rt. & Sta. 130+22

Sta. 124+00

End Area	Volume
Cut	Fill
26	31
	54 106
	12
3	26
	67 67
	10
33	10
	42 21
	10
7	10
	64 8
	0
73	0
	10
	389 0
137	0
	496 39
131	21
	319 78
41	21
	104 133
15	51
	76 135
26	22
	67 96
10	30
	54 119
19	34

WORK AS CONSTRUCTED STA 125+00 To STA. 134+00

3/23/62	AS CONSTRUCTED	H.F.K.
REVISION	DATE	DESCRIPTION
U. S. ARMY ENGINEER DISTRICT, HUNTINGTON CORPS OF ENGINEERS HUNTINGTON, W. VA.		
DRAWN BY: WIC		
CHECKED BY: J.H.S.		
SUBMITTED BY: Elmer S. Barrett		
ELMER S. BARRETT ASSOCIATES		
RECOMMENDED: J. S. Barrett		
APPROVED: Steven Malenchuk		
DATE: NOVEMBER 1959		
SCALE: 1"=10'		
SPEC. NO. 027-UD 14-68/36		
SHEET 36 OF 83		