


Seeding
End Sq.
Width Yds.

84
622
28
411
46
467
38
400
34
378
34
378
34

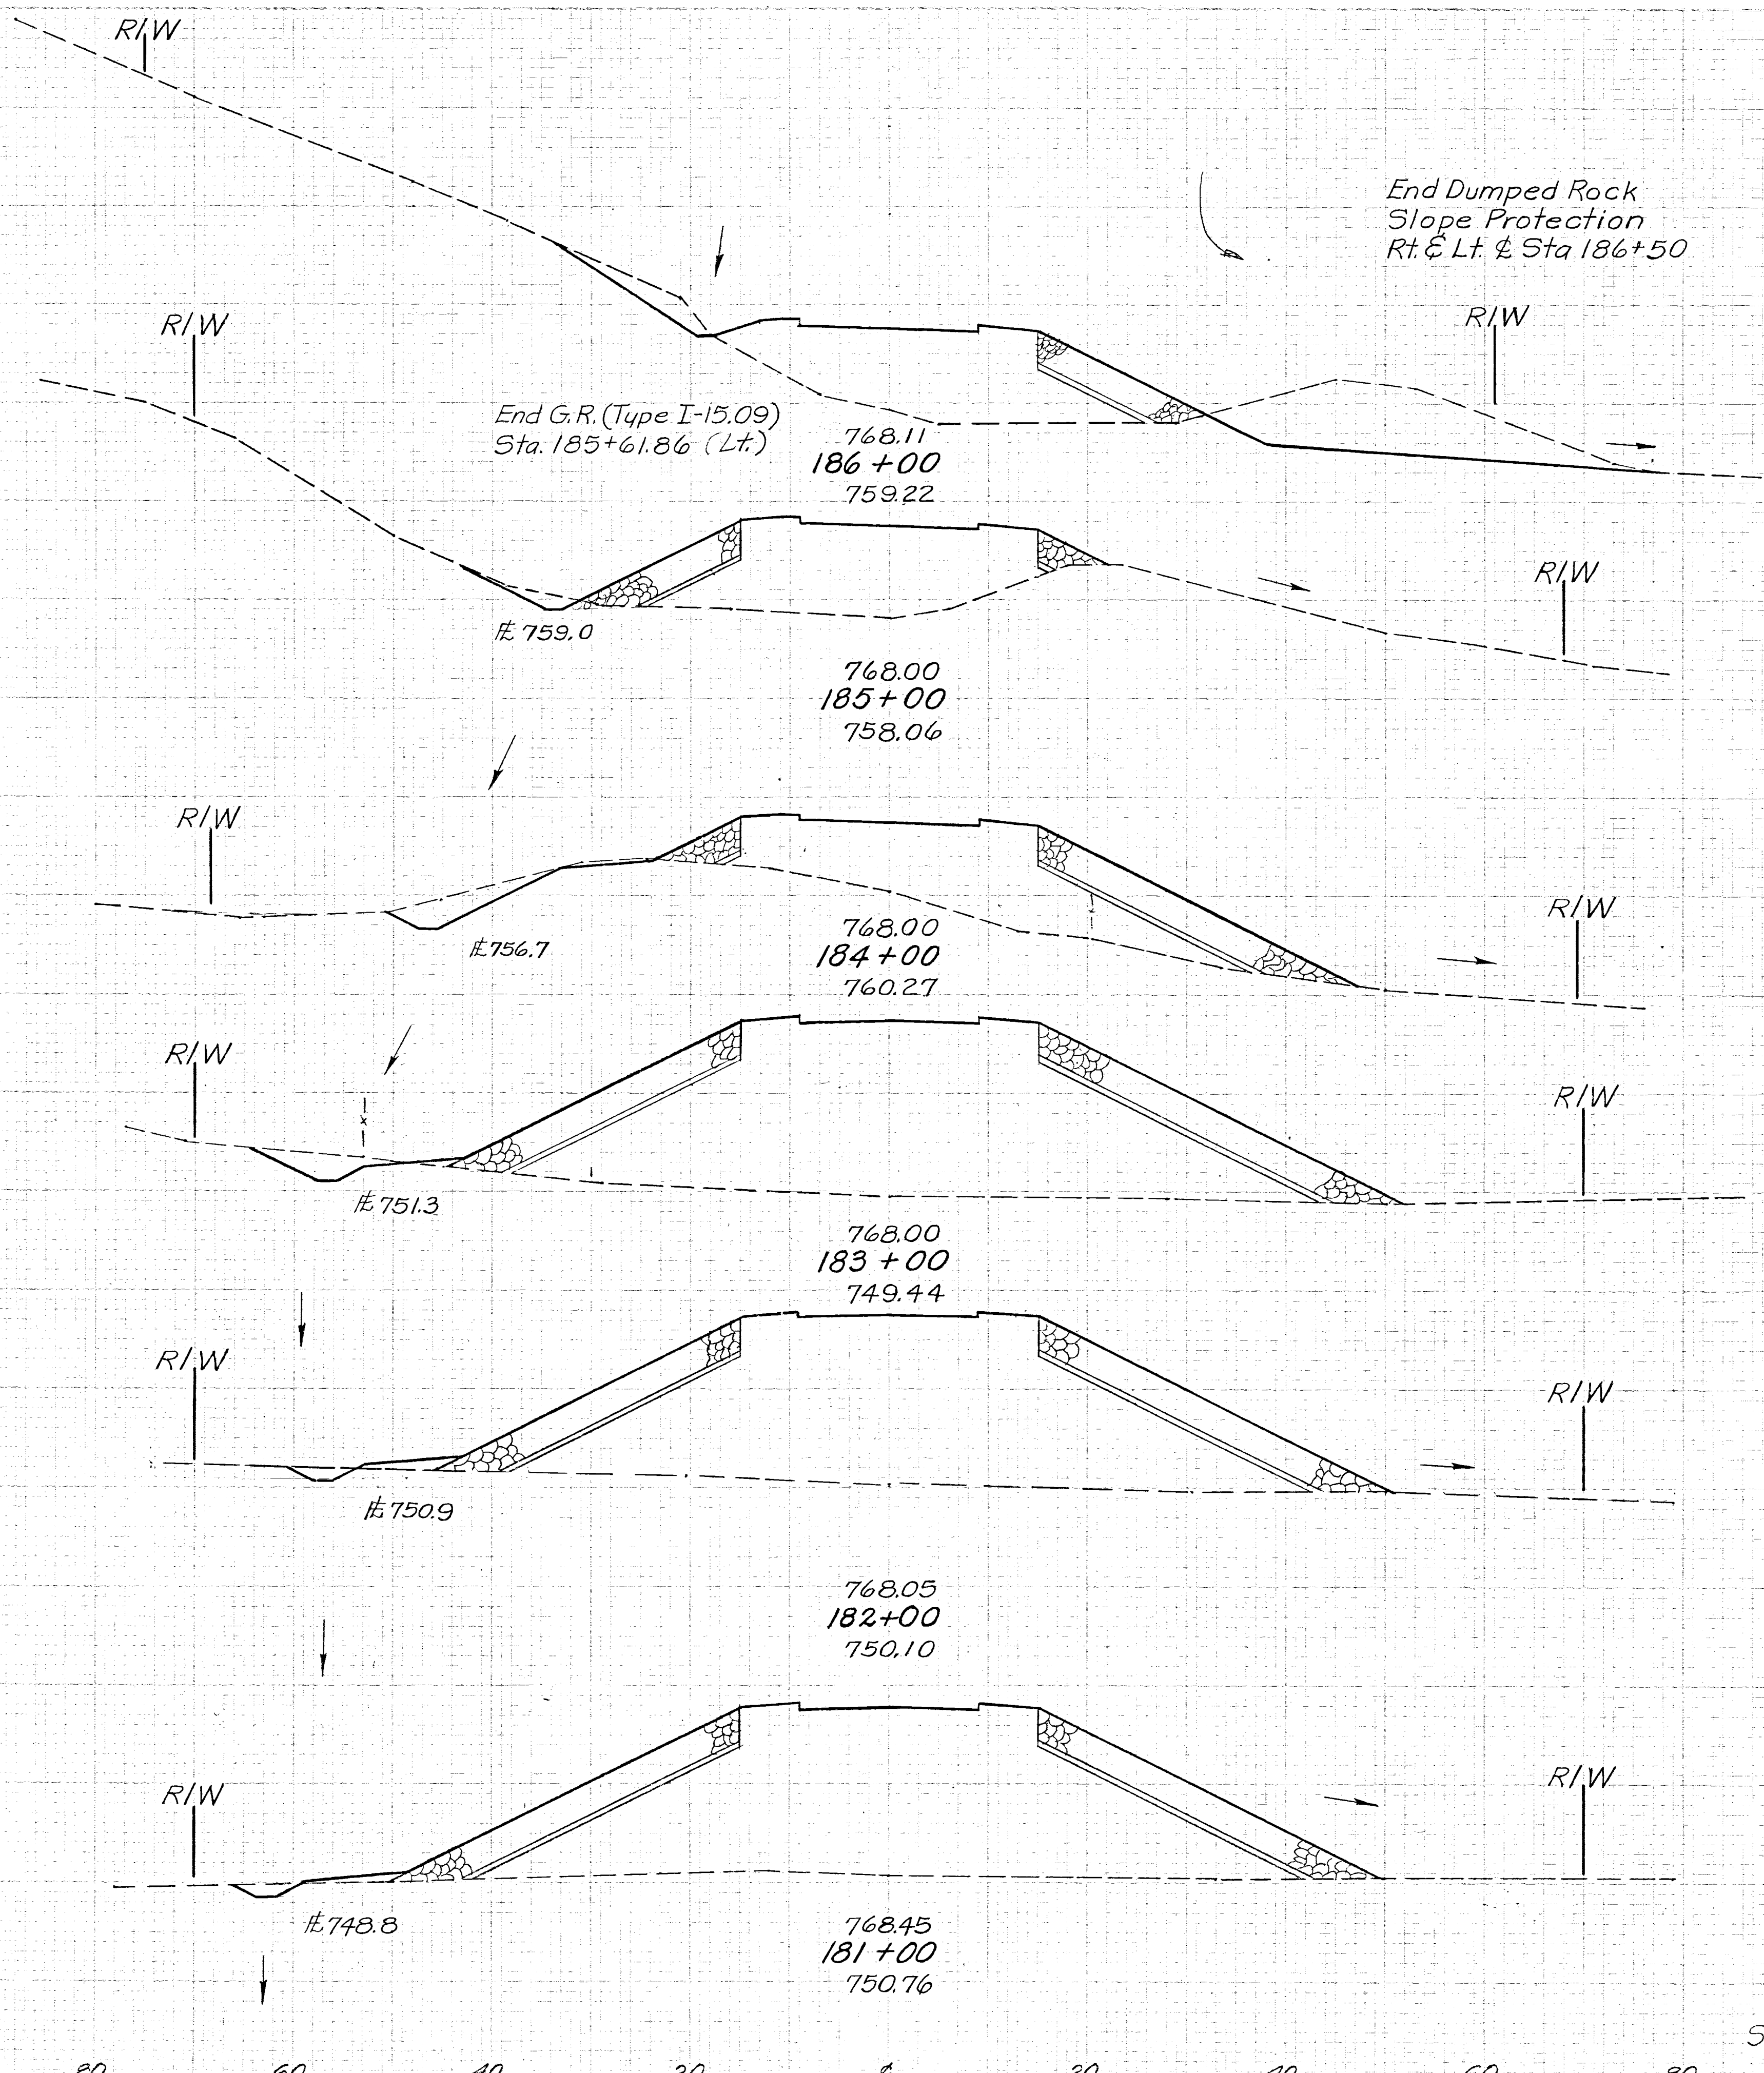

End Area		Volume	
Cut	Fill	Cut	Fill
208	264		
	400	989	
8	270		
	70	1033	
30	288		
	94	2169	
21	883		
	50	3180	
6	834		
	24	3119	
7	850		
31	3504		
	10	1042	

46
83

**MUSKINGUM COUNTY
COUNTY ROAD NO. 8**

	ROCK		I-22	
	End Area	Volume	End Area	Volume
Sta. 186+50	0	0	0	0
		44	6	
Sta. 186+00	48	6		
		200	24	
Sta. 185+00	60	7		
		320	39	
Sta. 184+00	113	14		
		581	81	
Sta. 183+00	201	30		
		743	109	
Sta. 182+00	200	29		
		769	111	
Sta. 181+00	215	31		
		824	120	
Sta. 180+00	230	34		

3/23/62		AS CONSTRUCTED		H.F.K.
REVISION	DATE	DESCRIPTION		BY
U. S. ARMY ENGINEER DISTRICT, HUNTINGTON CORPS OF ENGINEERS HUNTINGTON, W. VA.				
DRAWN BY: EER		LICKING RIVER DILLON RESERVOIR PROJECT RELOCATION OF MUSKINGUM COUNTY ROAD NO. 8 MC-8-4 & MT-408-1 MC-8-1 & MC-408-1		
CHECKED BY: FHS				
SUBMITTED BY: Elmer S. Barrett				
RECOMMENDED BY: Elmer S. Barrett Associates				
APPROVED: Steven Malenich		DATE: NOVEMBER 1959		
ELMER S. BARRETT ASSOCIATES CONSULTING ENGINEERS CHILLICOTHE, OHIO		SCALE: 1"=10' DRAWING NUMBER 0 27f-UD 14-68/46 SHEET 46 OF 83		

WORK AS CONSTRUCTED **STA. 181+00 To STA. 186+00**