



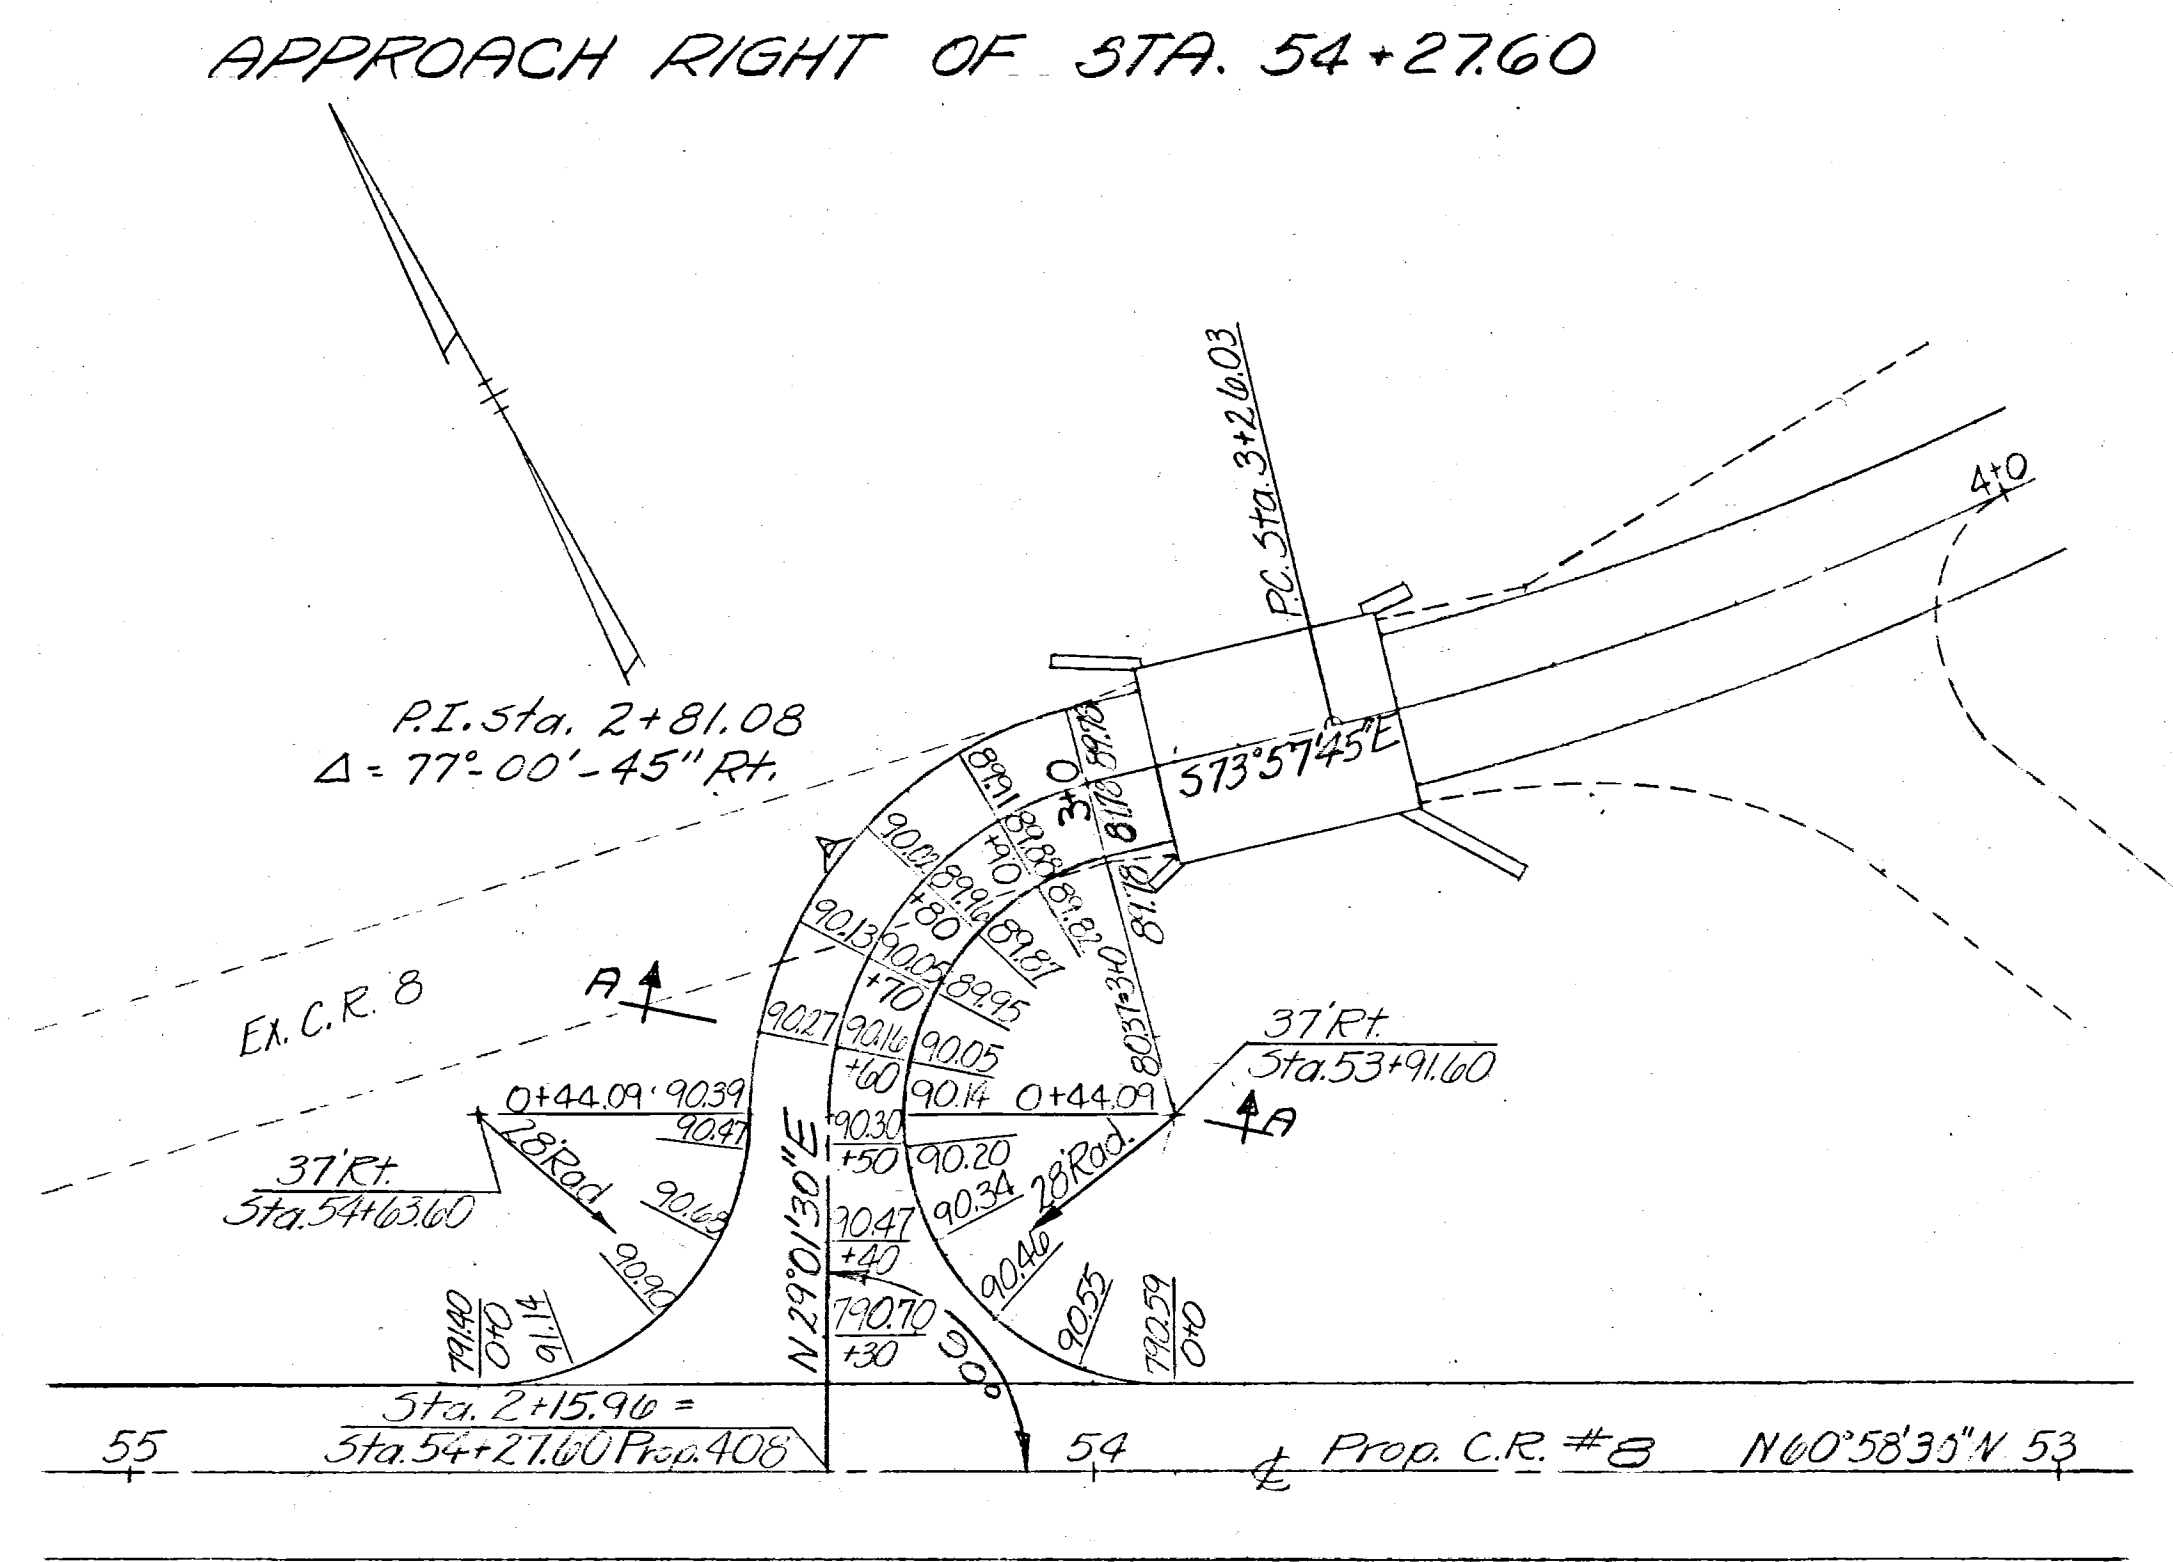


PLAN

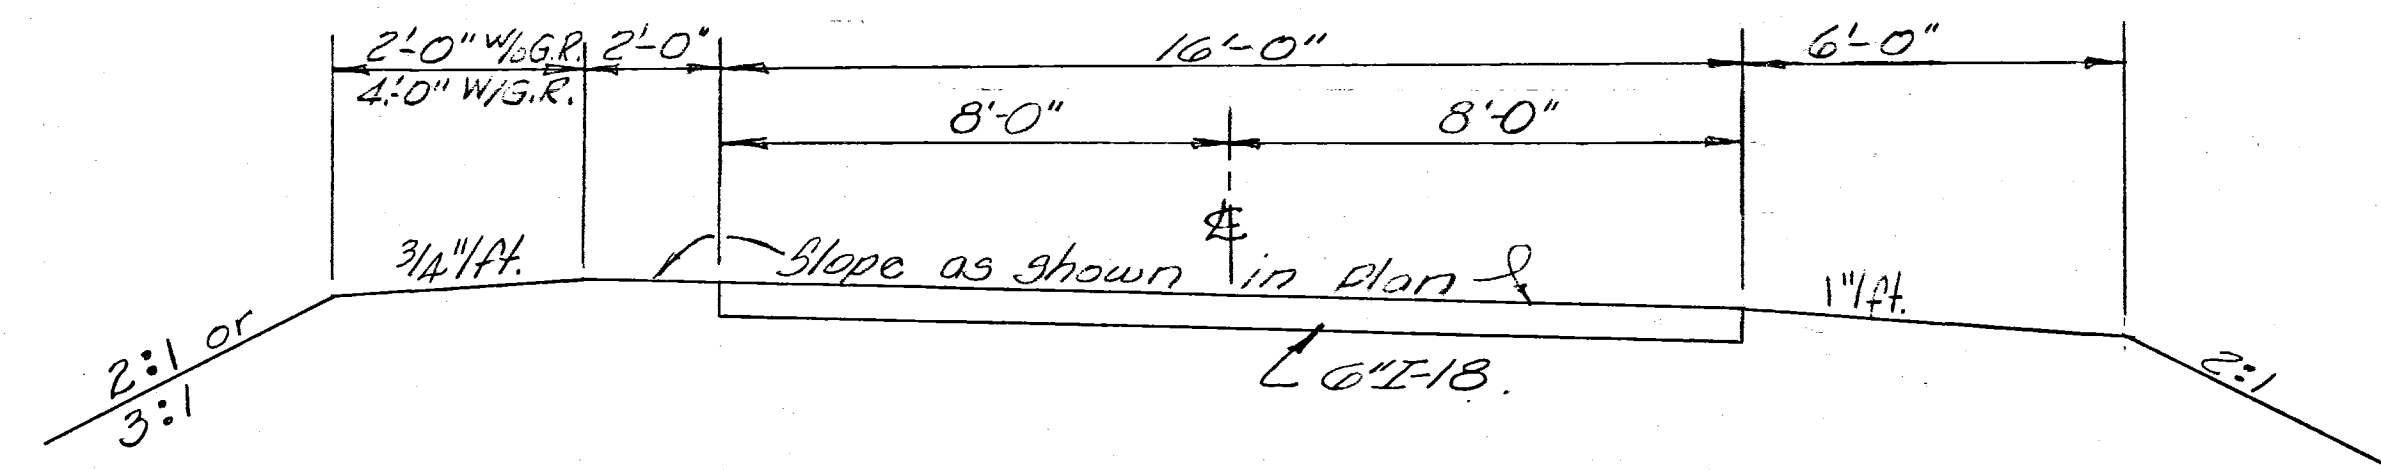


SECTION A-A

APPROACH LEFT OF STA. 55+62.76

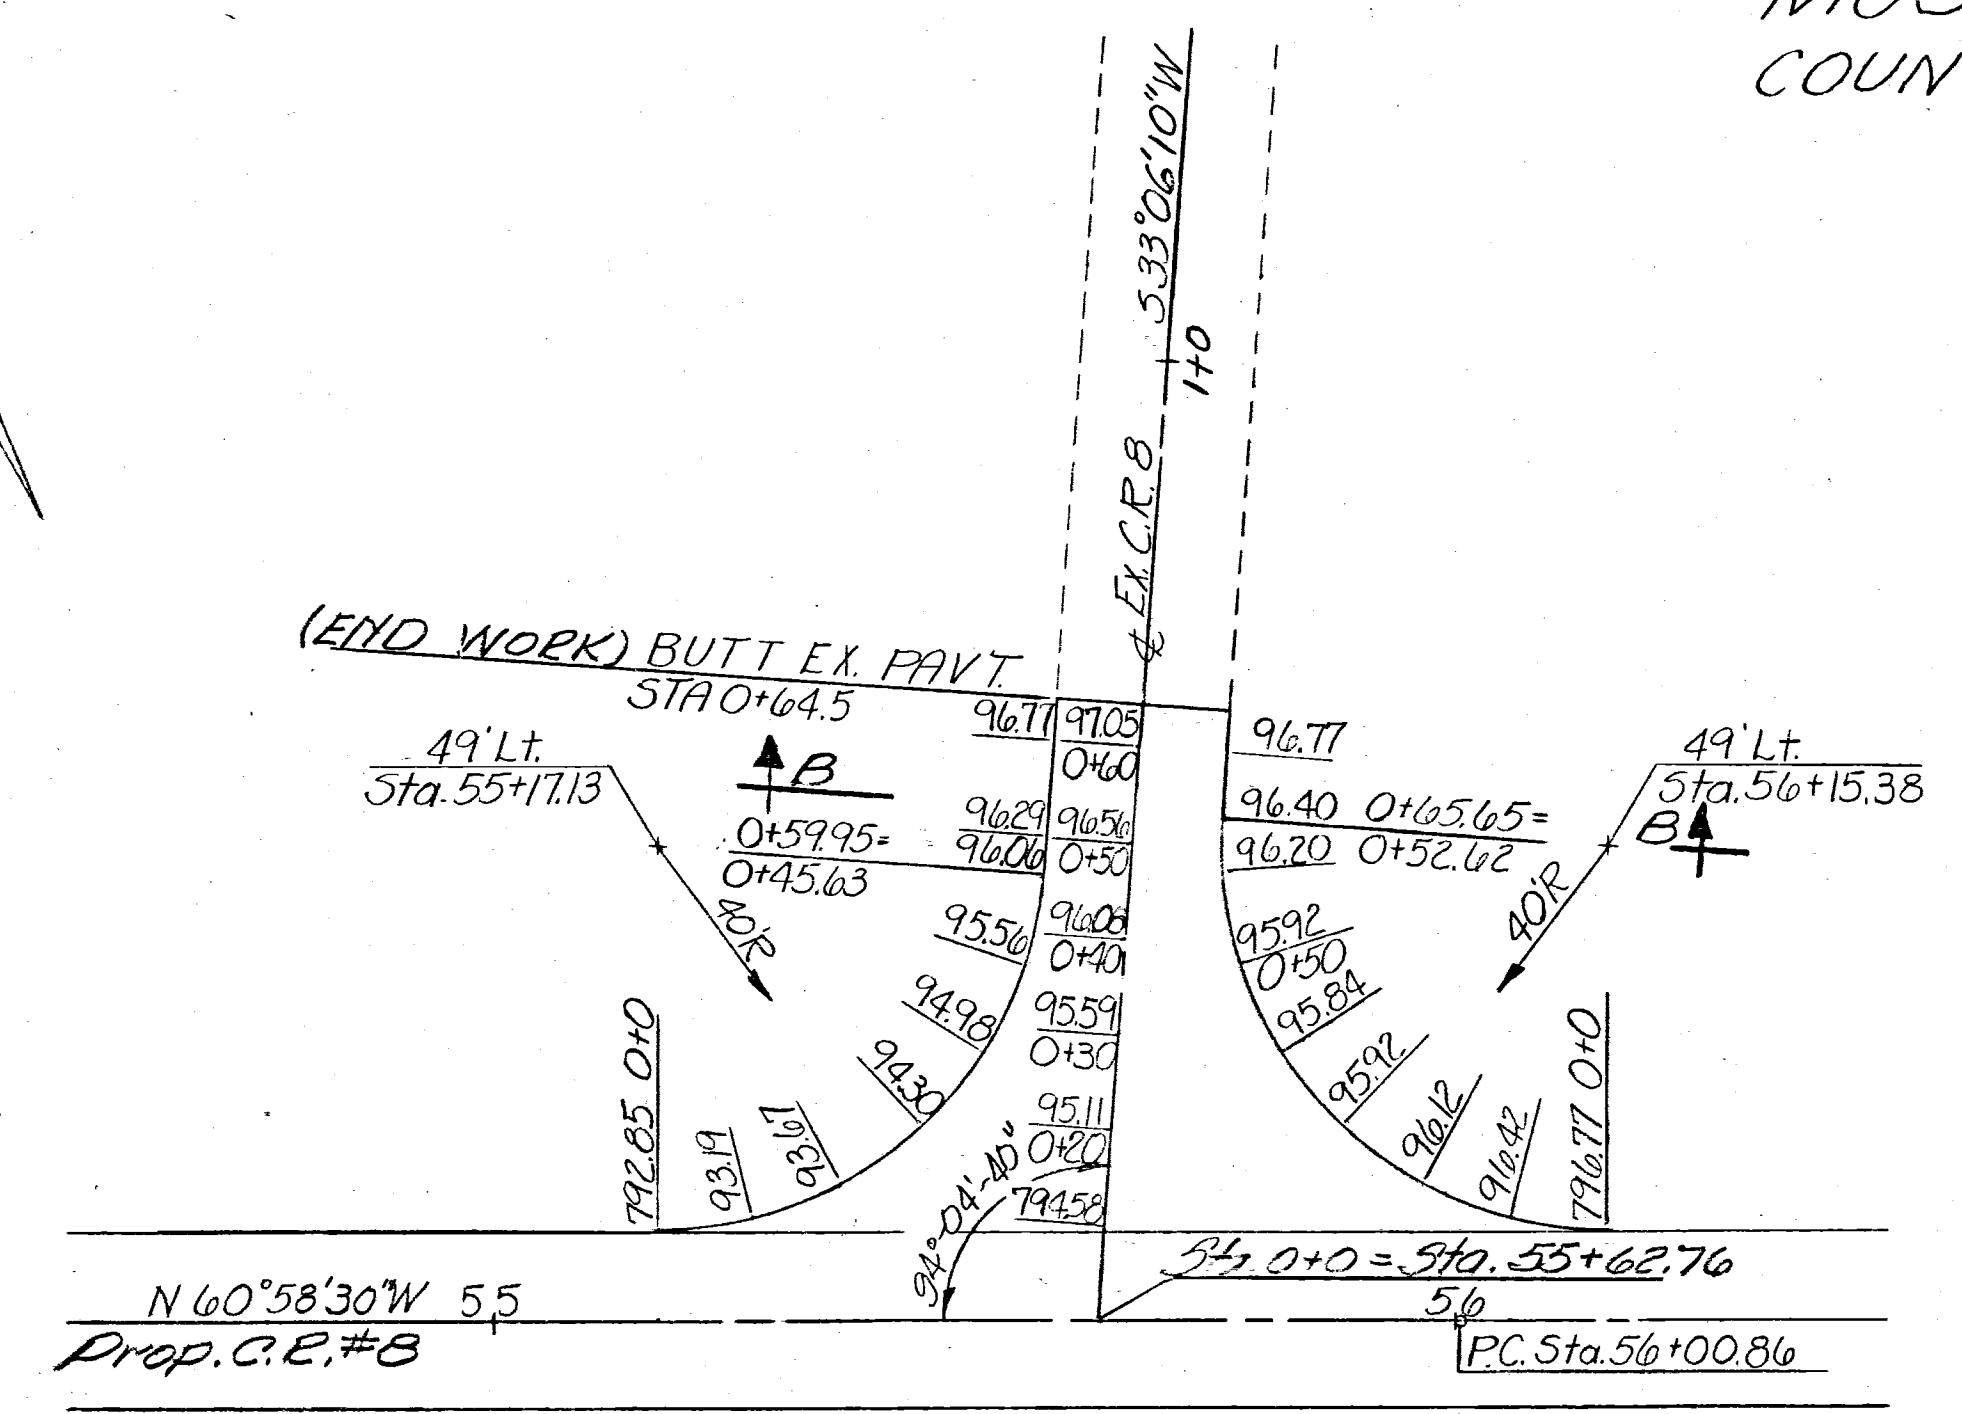

PLAN

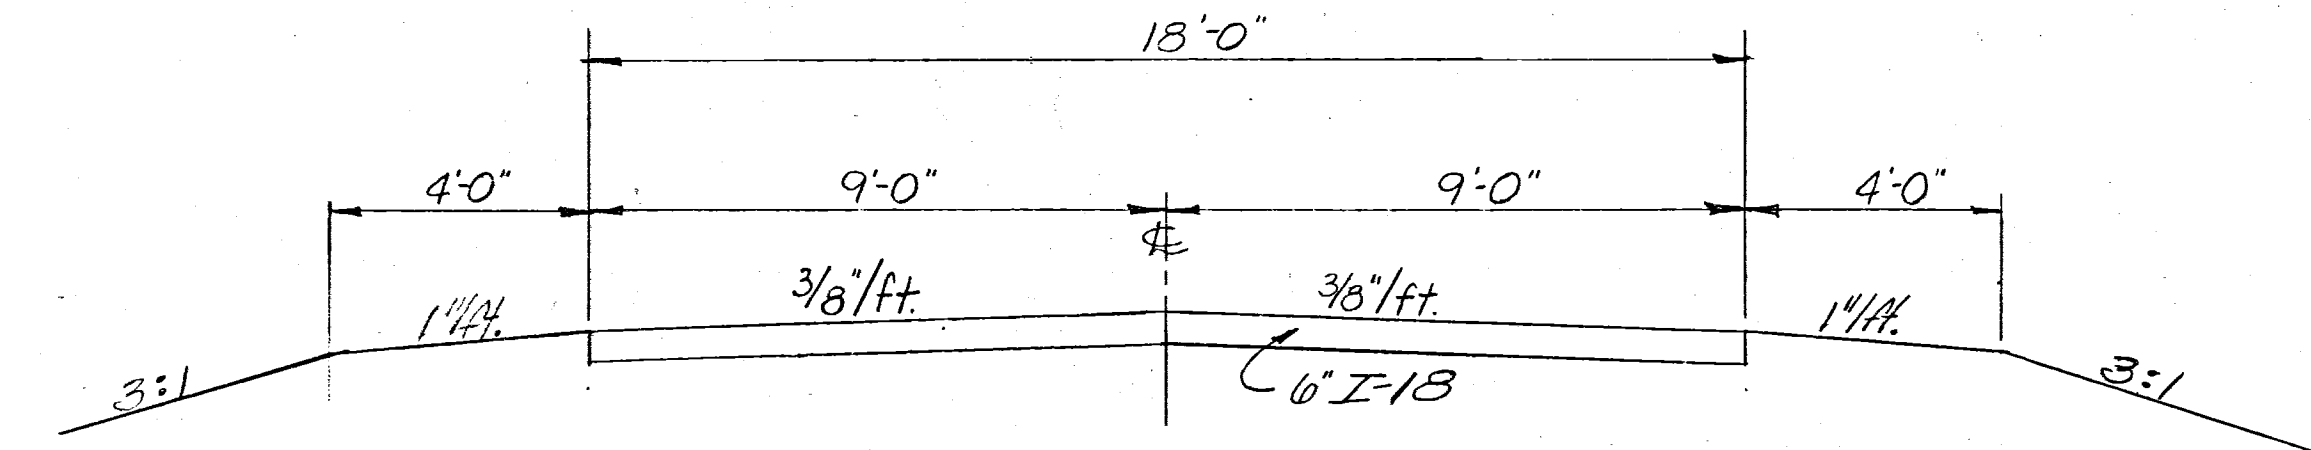

SECTION B-B

REVISION	DATE	DESCRIPTION	BY
	3/23/62	AS CONSTRUCTED	H.F.K.
U. S. ARMY ENGINEER DISTRICT, HUNTINGTON CORPS OF ENGINEERS HUNTINGTON, W. VA.			
DRAWN BY: D.C.		LICKING RIVER DILLON RESERVOIR PROJECT	
CHECKED BY: F.H.S.		RELOCATION OF MUSKINGUM COUNTY ROAD NO. 8	
SUBMITTED BY: Elmer S. Barrett		MC-8-4 & MT-408-1	
ELMER S. BARRETT ASSOCIATES		MC-8-1 & MC-408-1	
RECOMMENDED:		APPROVED: Steven Malevich	DATE: NOVEMBER 1959
CHIEF ENG. DIV.		COL. C.E. DISTRICT ENGINEER	
ELMER S. BARRETT ASSOCIATES CONSULTING ENGINEERS CHILLICOTHE, OHIO		SCALE: 1"=20'	SPEC. NO.
		DRAWING NUMBER	
		027f-UD 14-68/56	
		SHEET 56 OF 83	