


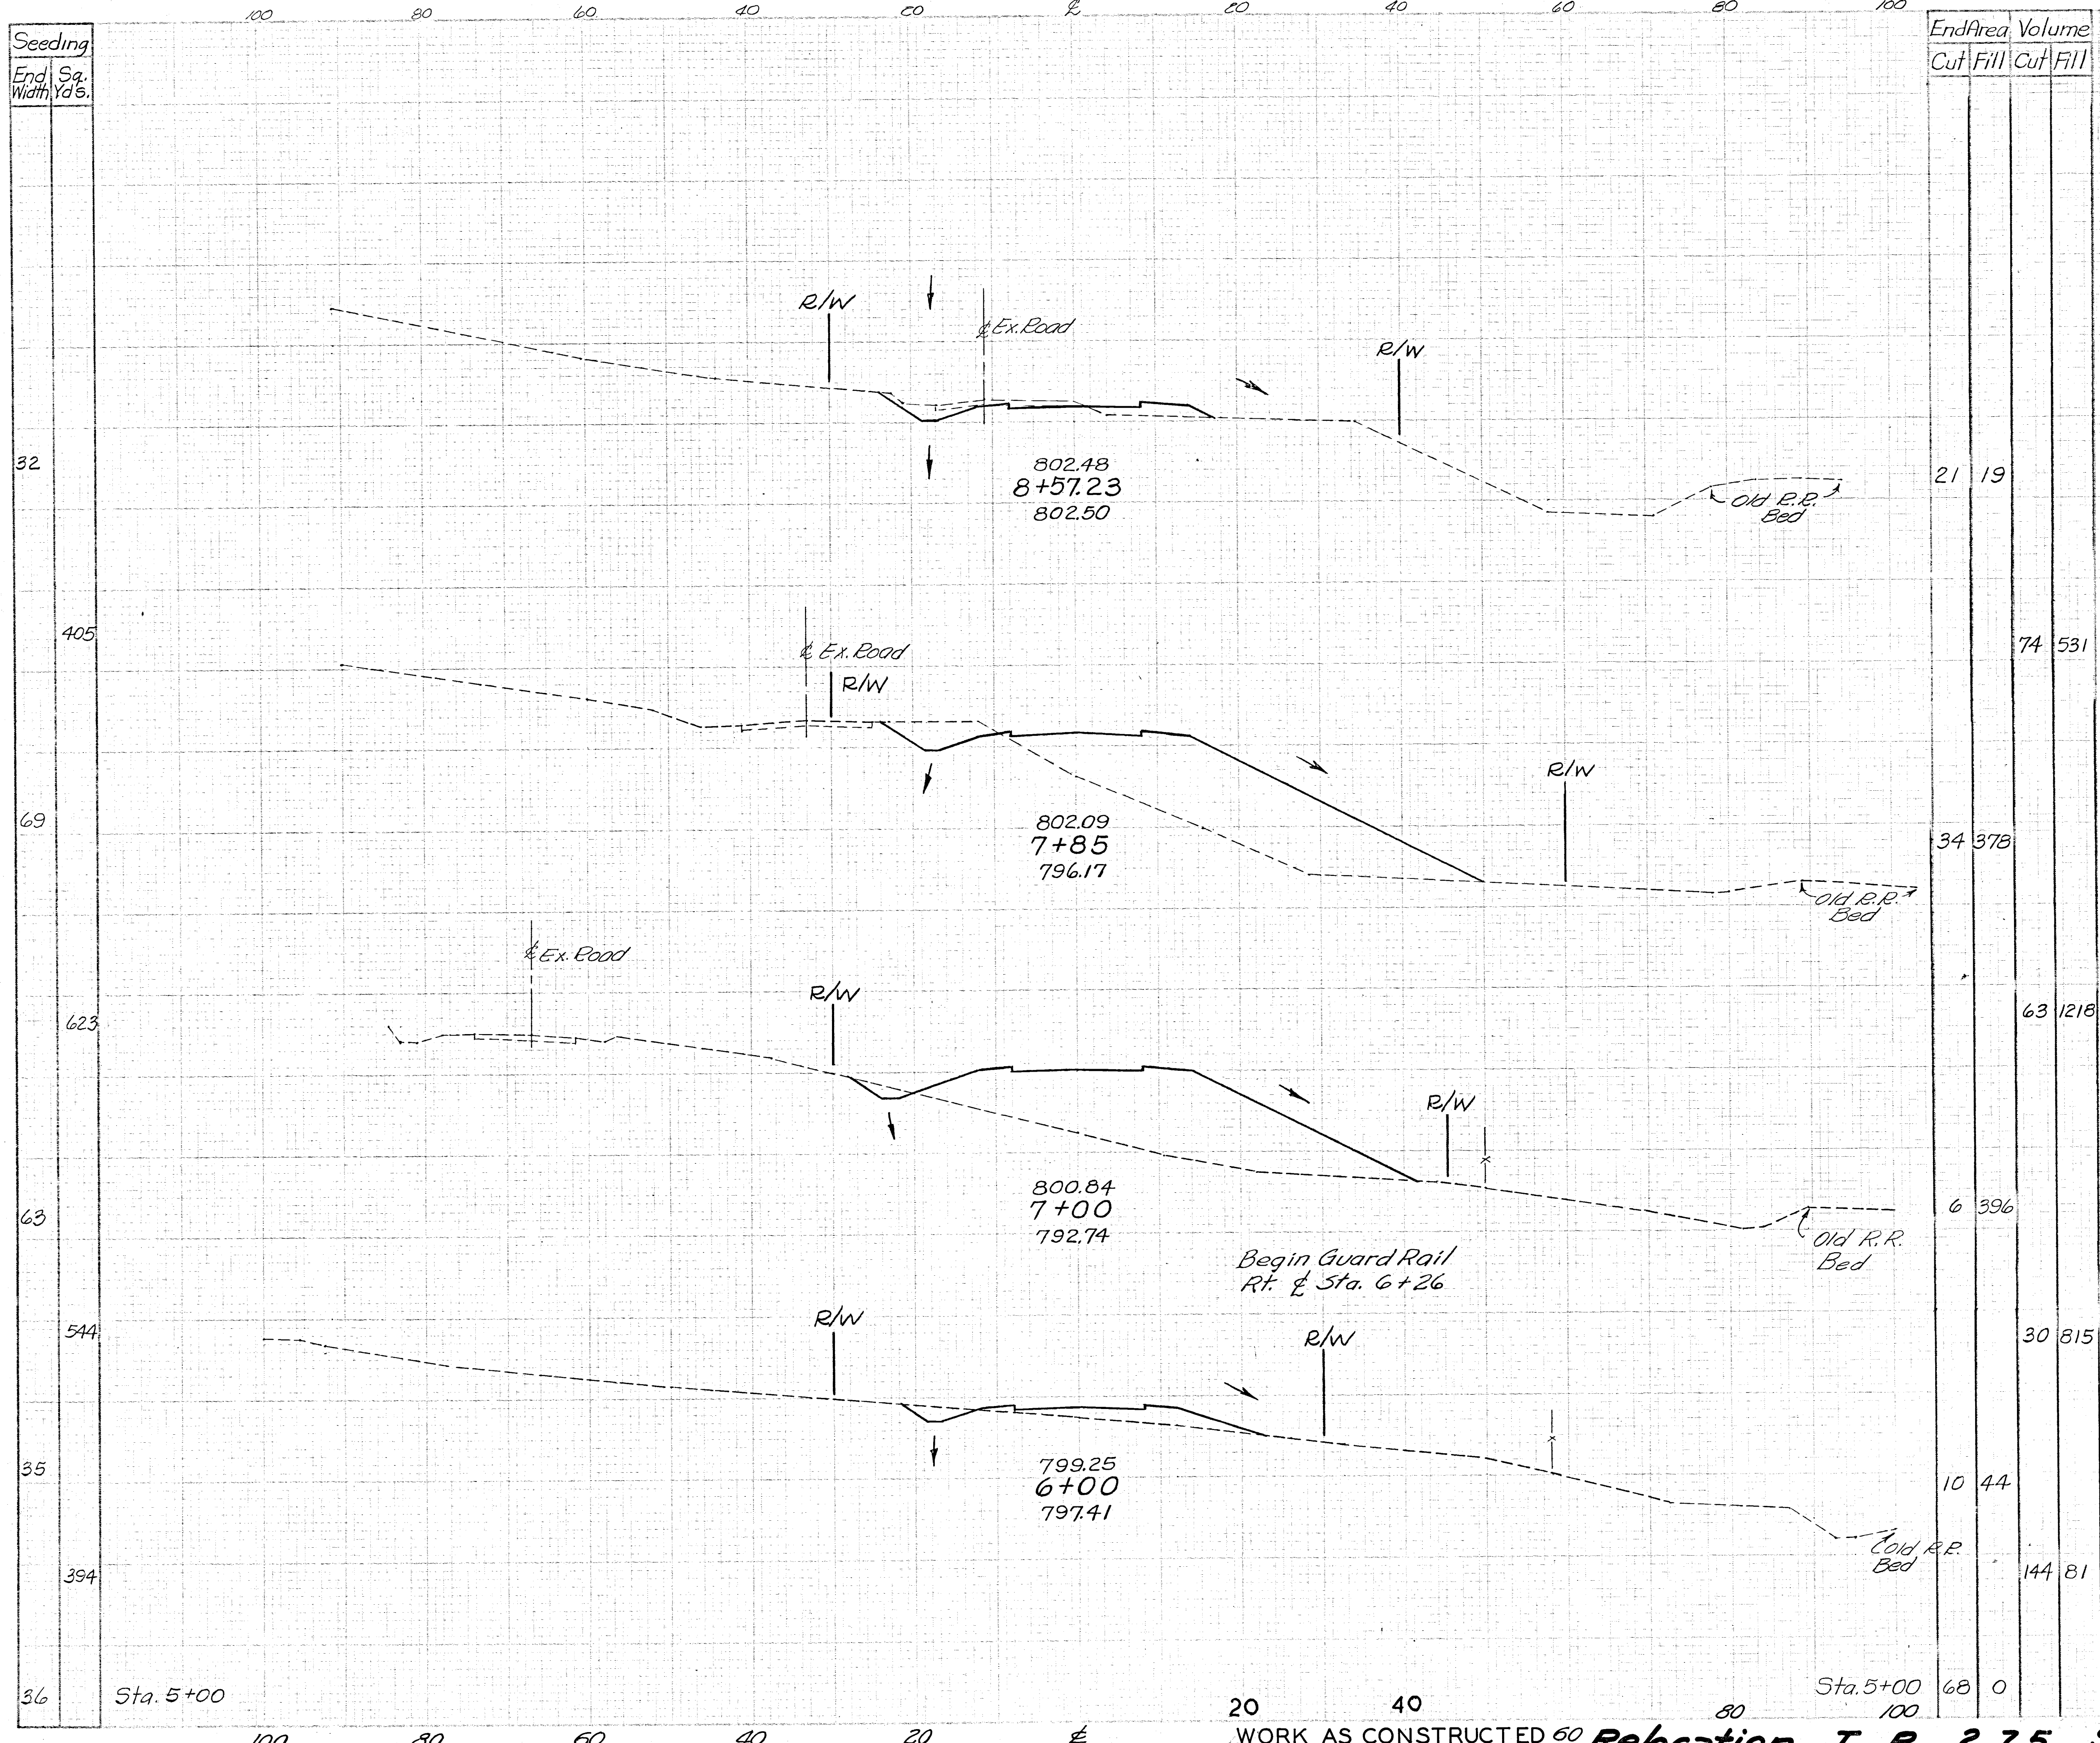

End Area		Volume	
Cut	Fill	Cut	Fill
21	19	74	531
34	378	63	1218
6	396	30	815
10	44	144	81
68	0		

3/23/62		AS CONSTRUCTED		H.F.K.
REVISION	DATE	DESCRIPTION		BY
U. S. ARMY ENGINEER DISTRICT, HUNTINGTON CORPS OF ENGINEERS HUNTINGTON, W. VA.				
DRAWN BY: WIC		LICKING RIVER DILLON RESERVOIR PROJECT		
CHECKED BY: F.H.S.		RELOCATION OF MUSKINGUM COUNTY ROAD NO. 8		
SUBMITTED BY: Elmer S. Barrett		MC-8-4 & MT-408-1		
ELMER S. BARRETT ASSOCIATES		MC-8-1 & MC-408-1		
RECOMMENDED BY: Jimmy James		APPROVED: Steven Malovich		DATE: NOVEMBER 1959
CHIEF ENG. DIV.		COL. G. E. DISTRICT ENGINEER		
ELMER S. BARRETT ASSOCIATES CONSULTING ENGINEERS CHILLICOTHE, OHIO		SCALE: 1" = 10'		SPEC. NO.
		DRAWING NUMBER		
		027f-UD 14-68/59		
		SHEET 59 OF 83		