

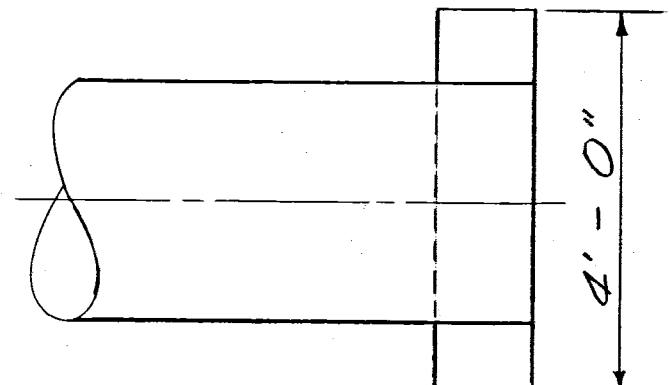
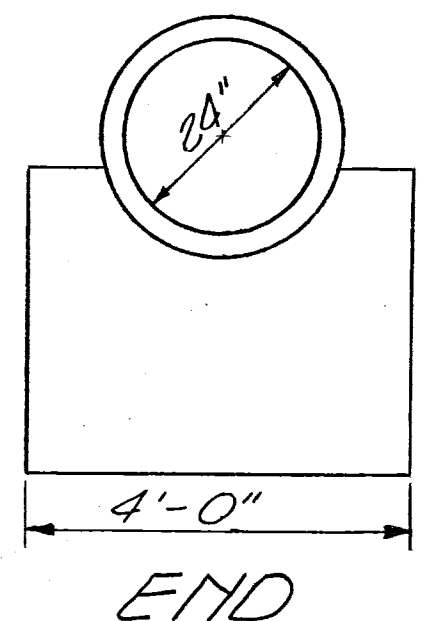
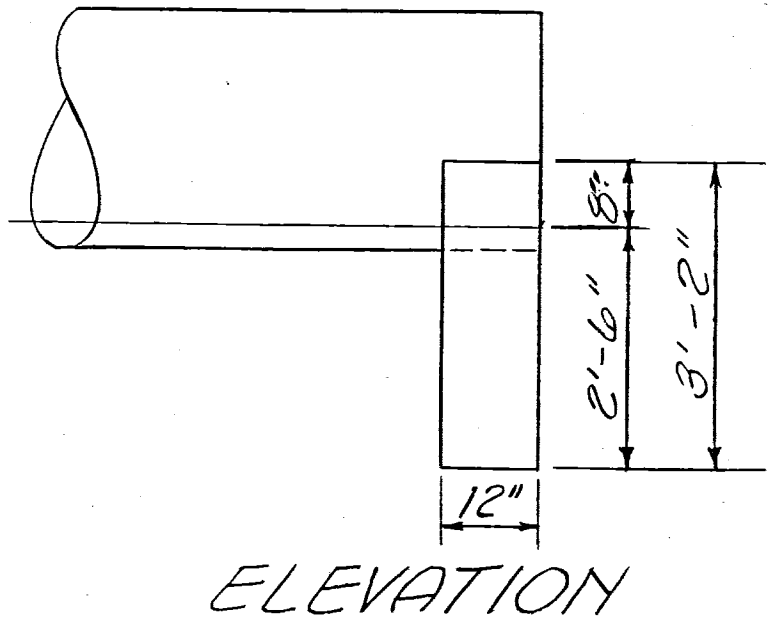
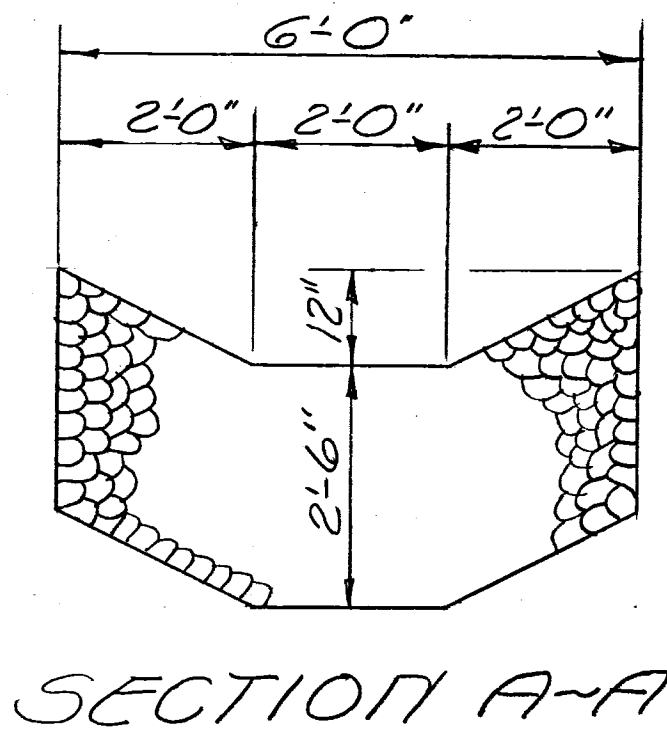


MUSKINGUM COUNTY
COUNTY ROAD NO. 8

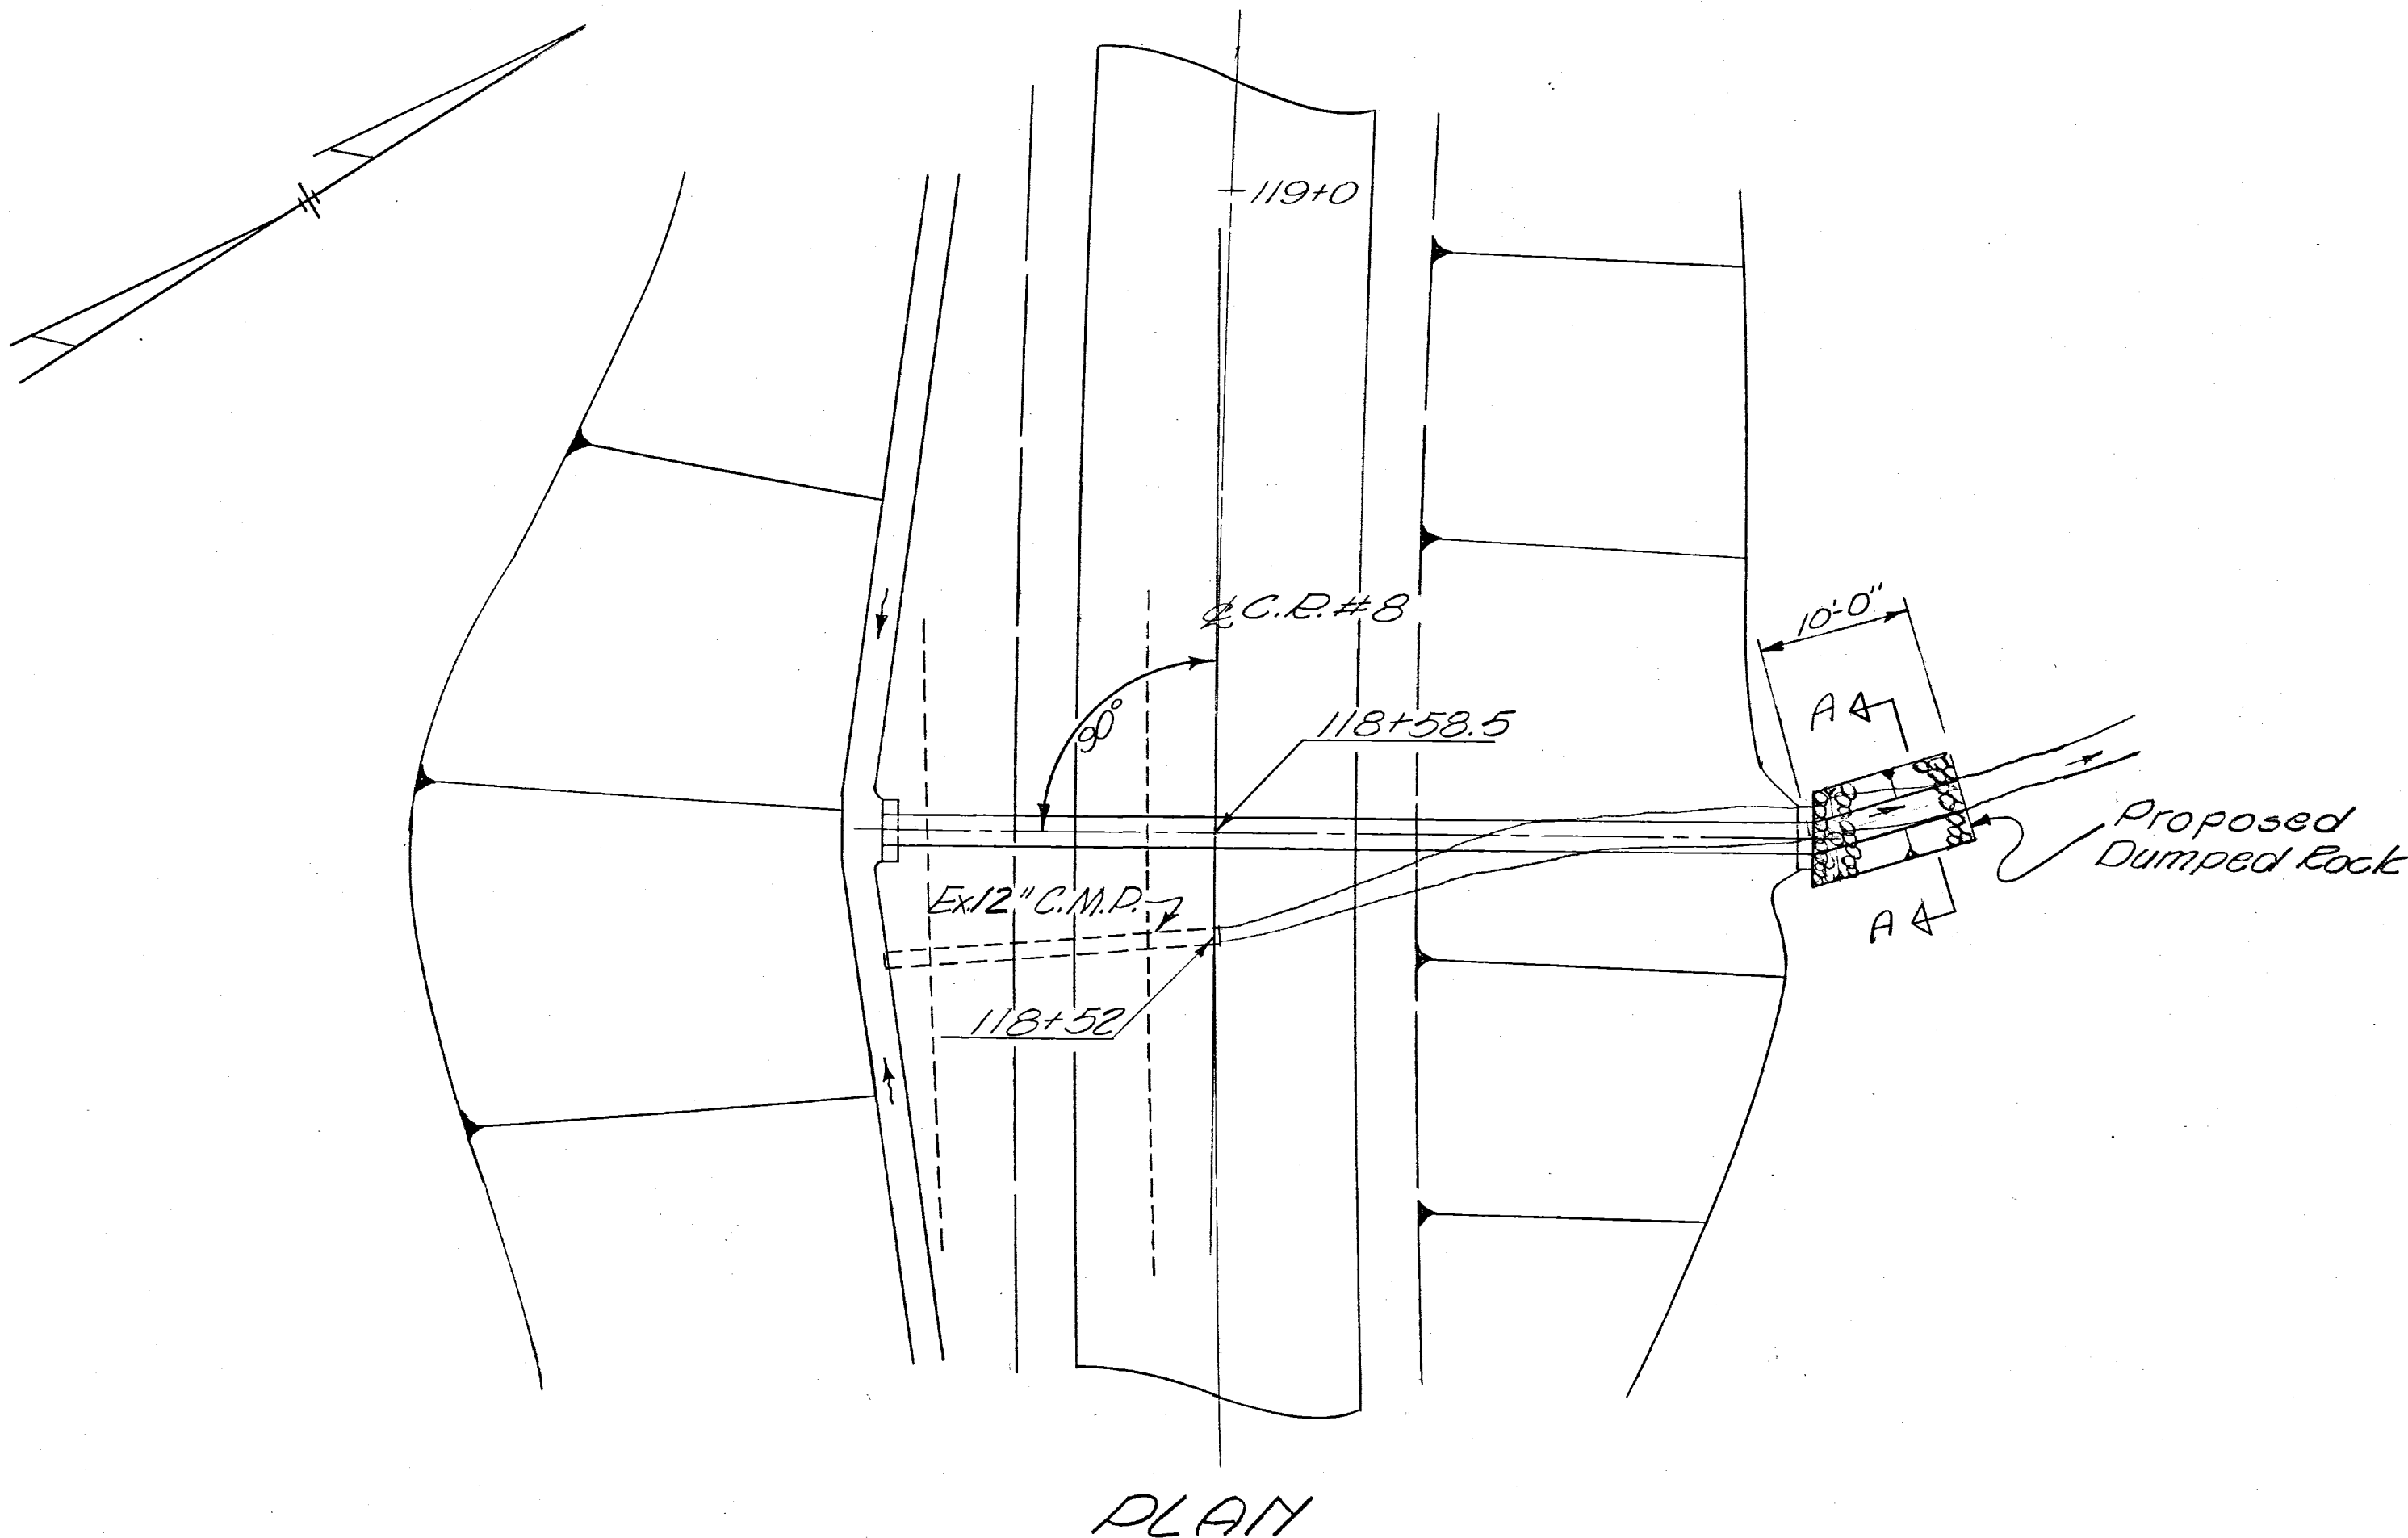

ENDWALL DETAILS

Drainage Area = 5.7 Ac.
Q₁₀ = 12.5 cfs

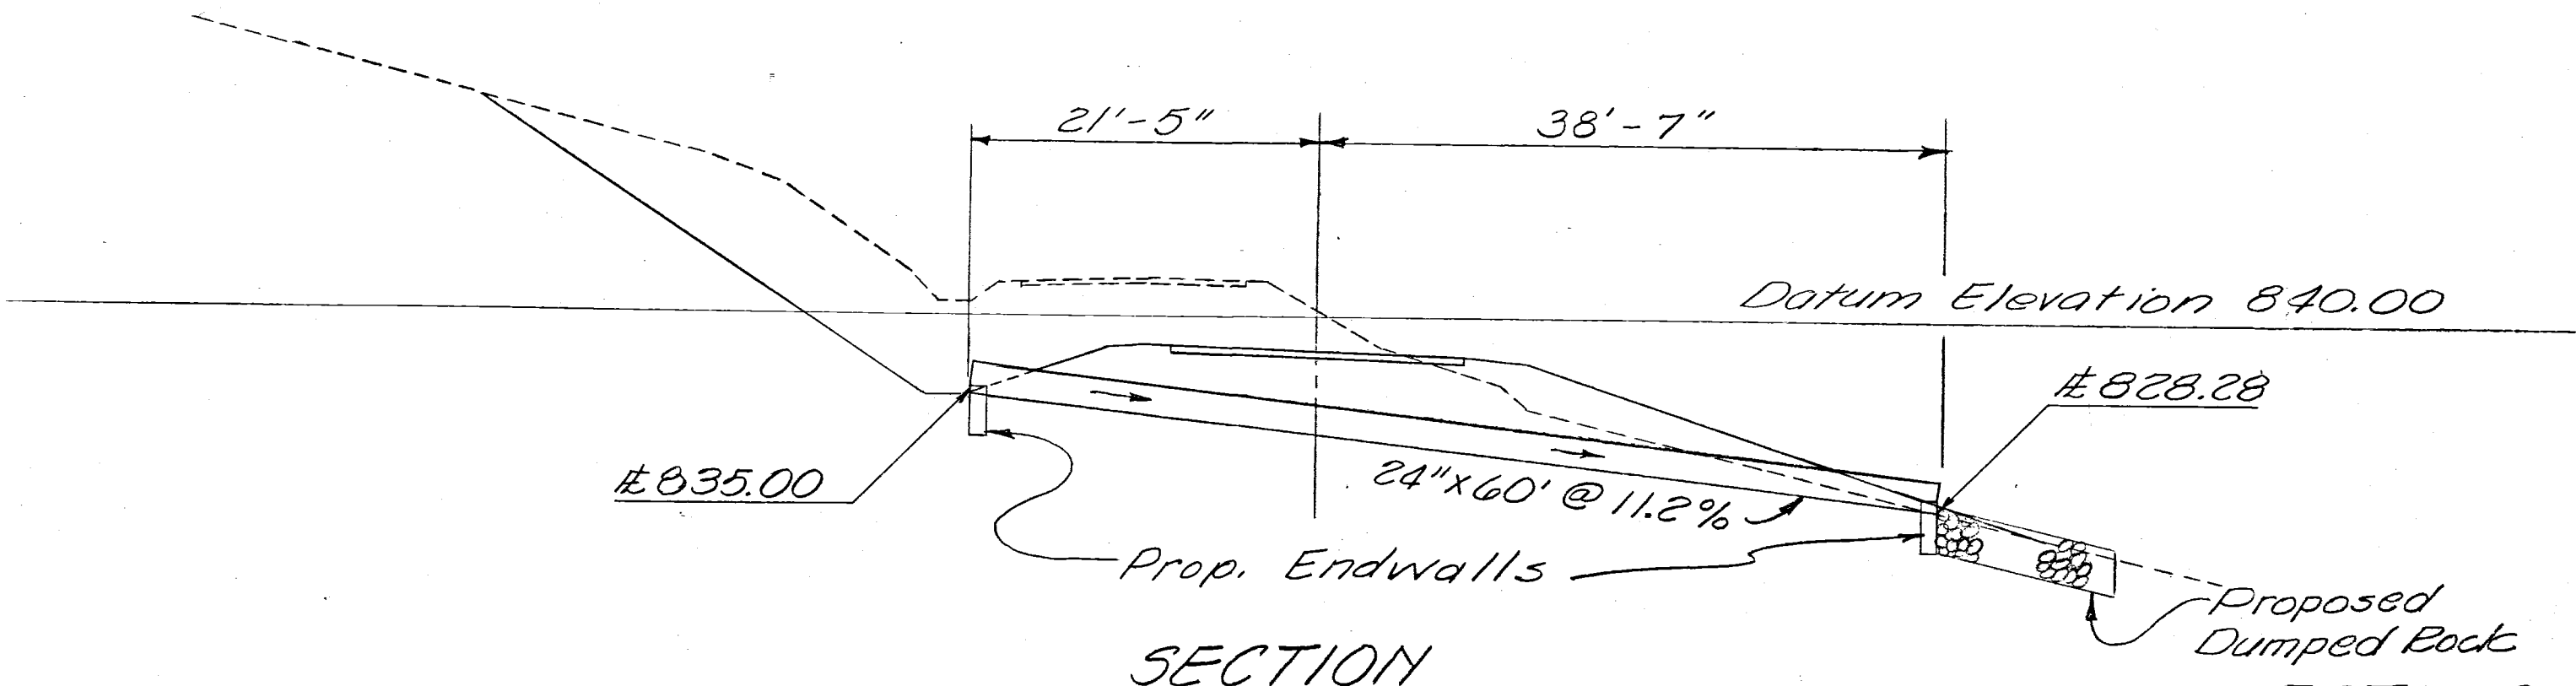

ESTIMATED QUANTITIES

- E-2 Excavation for Structures, Unclassified 30 cu yd.
- S-1 Concrete for Structures, Class E 0.82 cu yd.
- S-27 24" Pipe for Roadway Culverts 60 Lin. Ft.
- Sec. M-6.8(b), M-6.6(b), or M-6.4(d) 14 Gage
- I-10 Dumped Rock Channel Protection 5.56 cu yds

3/23/62		AS CONSTRUCTED	H.F.K.
REVISION	DATE	DESCRIPTION	BY
U. S. ARMY ENGINEER DISTRICT, HUNTINGTON CORPS OF ENGINEERS HUNTINGTON, W. VA.			
DRAWN BY: WIC		LICKING RIVER DILLON RESERVOIR PROJECT	
CHECKED BY: F.H.B.		RELOCATION OF MUSKINGUM COUNTY ROAD NO. 8 MC-8-4 & MT-408-1 MC-8-1 & MC-408-1	
SUBMITTED BY: Elmer S. Barrett Associates		DATE: NOVEMBER 1959	
RECOMMENDED BY: Steven M. Leitch		APPROVED: Steven M. Leitch COL. C.E., DISTRICT ENGINEER	
ELMER S. BARRETT ASSOCIATES CONSULTING ENGINEERS CHILLICOTHE, OHIO		SCALE: 1" = 10' DRAWING NUMBER 027-UD 14-68/67 SHEET 67 OF 83	

WORK AS CONSTRUCTED

CULVERT DETAIL

(8)