



FED. RD. DIVISION	STATE	PROJECT	
2	OHIO		

68
83

MUSKINGUM COUNTY COUNTY ROAD NO. 8

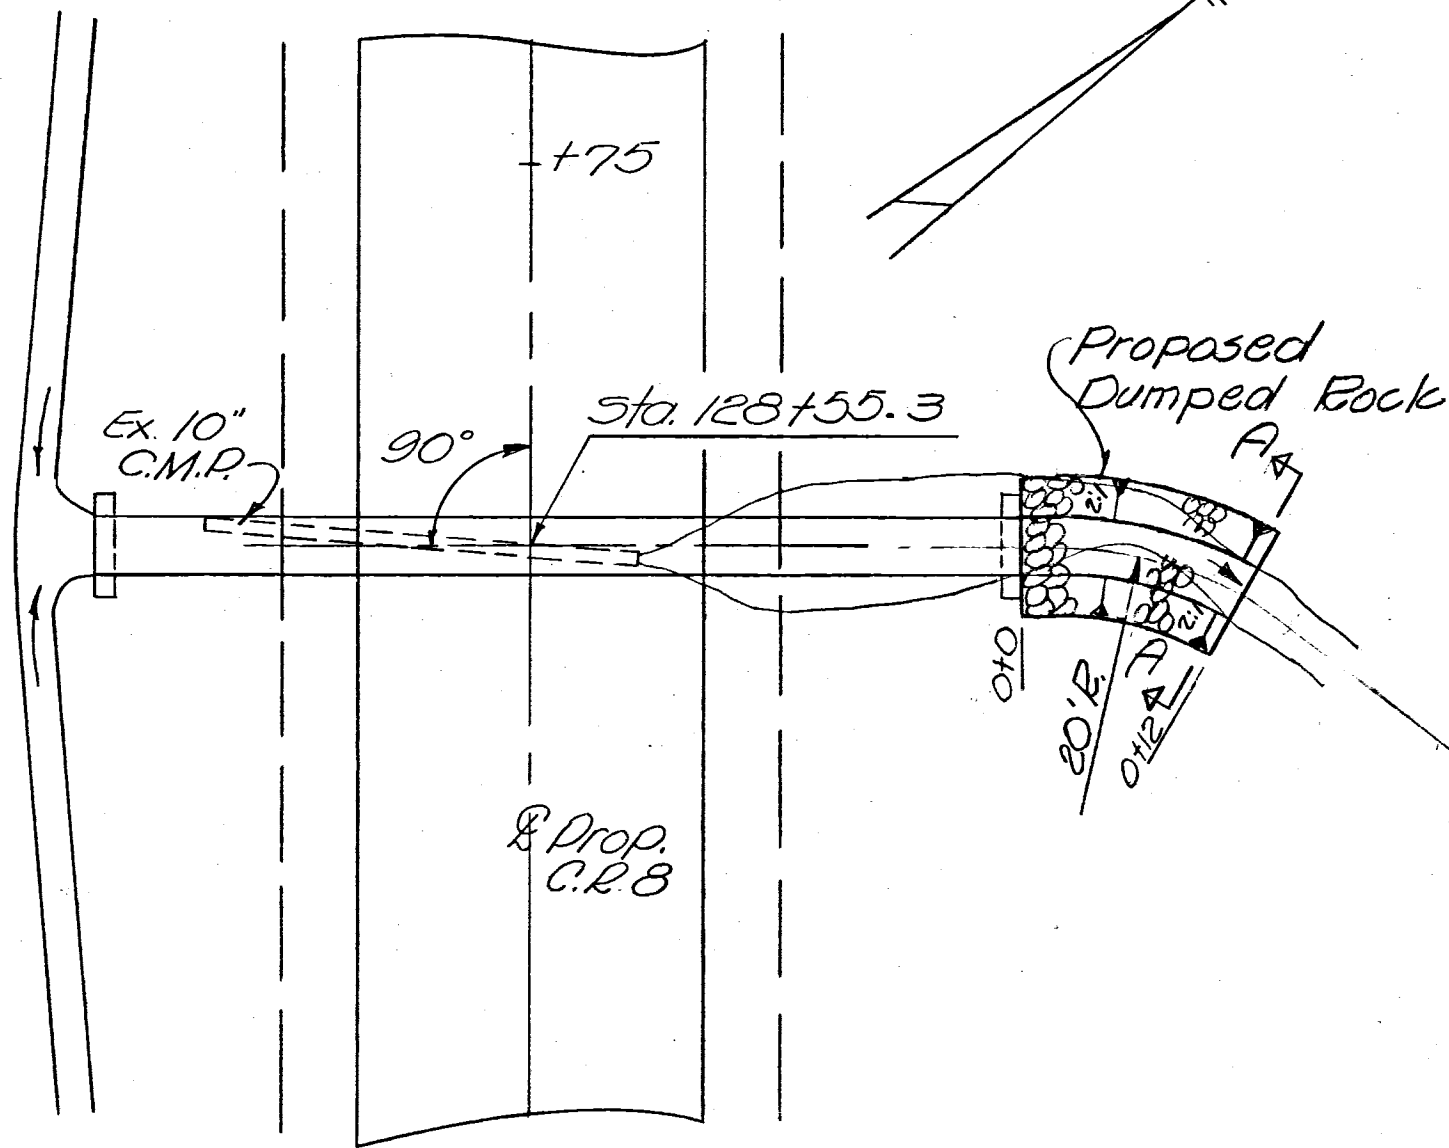


PLAN

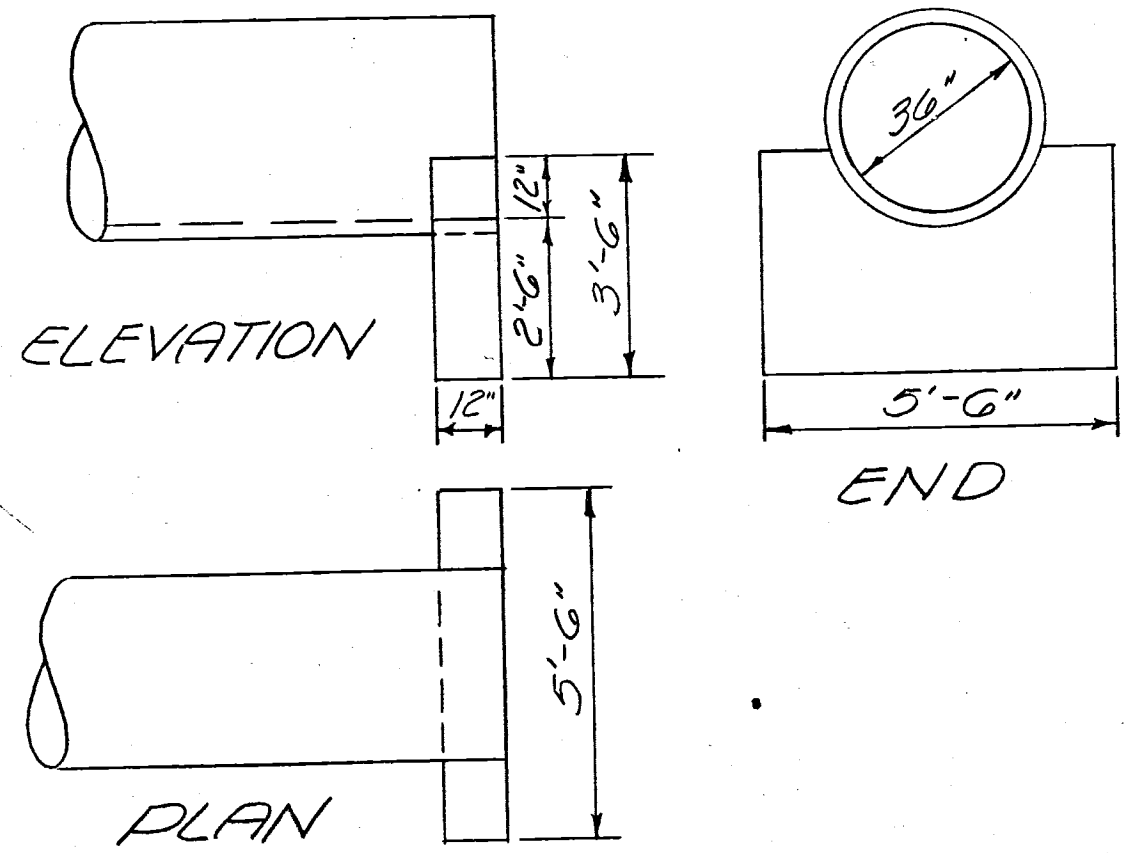


END WALL DETAILS

Drainage Area = 208 Ac.
Q₁₀ = 31 c.f.s.

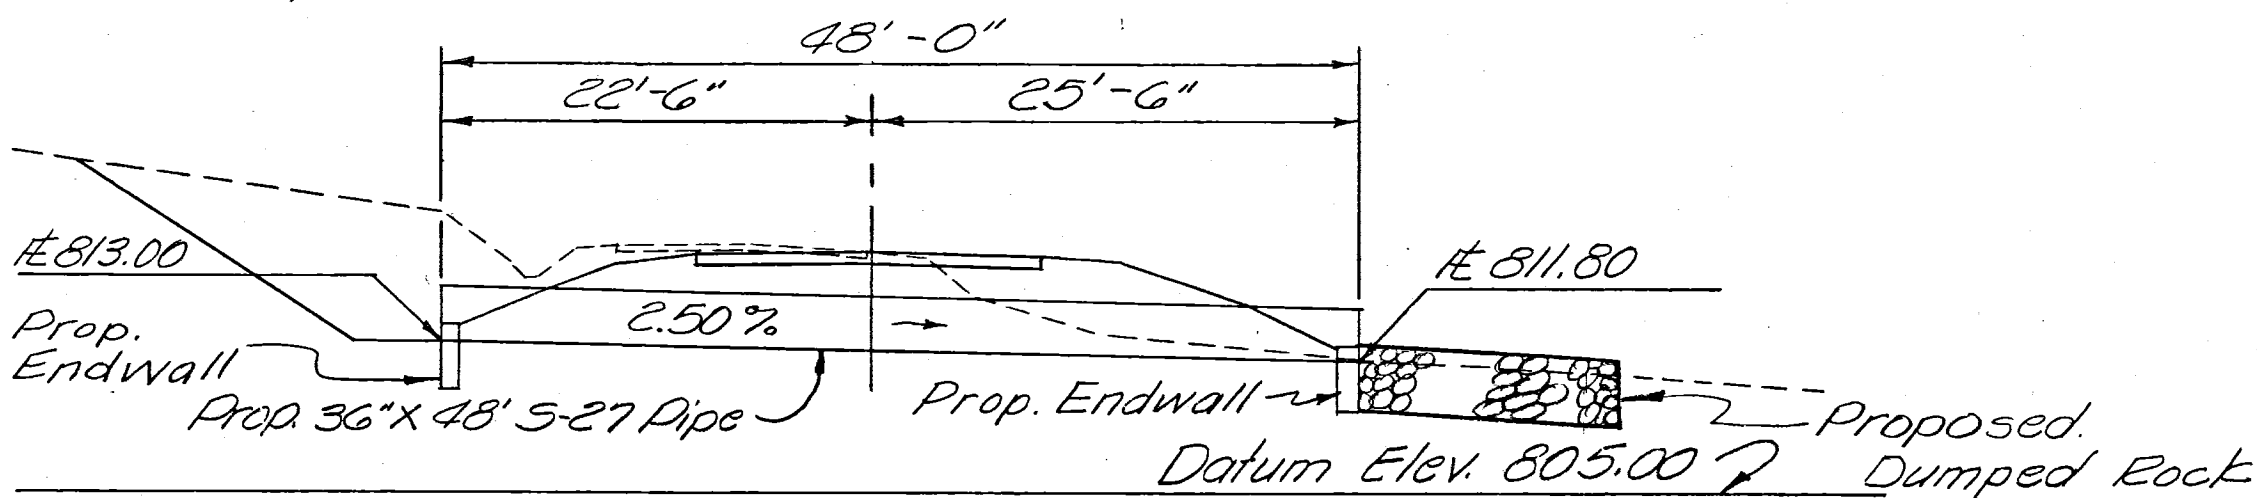

SECTION

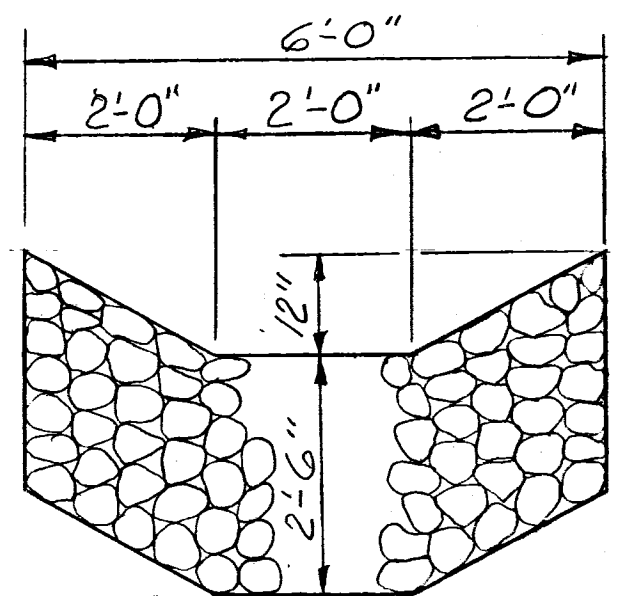

SECTION A-A

ESTIMATED QUANTITIES

- E-2 Excavation for Structures, Unclassified 35 Cu. Yd.
- B-1 Concrete for Structures, Class E 1.18 Cu. Yd.
- B-27 36" Pipe for Roadway Culvert 48 Lin. Ft.
- Sec. M-6.8(b), M-6.6(b) or M-6.4(d) 12 Gage
- I-10 Dumped Rock Channel Protection 6.67 Cu. Yds.

REVISION	DATE	DESCRIPTION	BY
	3/23/62	AS CONSTRUCTED	H.F.K.
U. S. ARMY ENGINEER DISTRICT, HUNTINGTON CORPS OF ENGINEERS HUNTINGTON, W. VA.			
DRAWN BY: WIC		LICKING RIVER DILLON RESERVOIR PROJECT	
TRACED BY:		RELOCATION OF MUSKINGUM COUNTY ROAD NO. 8 MC-8-4 & MT-408-1 MC-8-1 & MC-408-1	
CHECKED BY: F.H.S.		APPROVED: <i>Steven Malenich</i> COL. C.E., DISTRICT ENGINEER	
SUBMITTED BY: <i>Elmer S. Barrett</i> ELMER S. BARRETT ASSOCIATES		DATE: NOVEMBER 1959	
RECOMMENDED BY: <i>James J. Barnes</i> CHIEF ENG. DIV.		SCALE: 1" = 10'	
ELMER S. BARRETT ASSOCIATES CONSULTING ENGINEERS CHILLICOTHE, OHIO		SPEC. NO. DRAWING NUMBER 027f-UD 14-68/ 68 SHEET 68 OF 83	

WORK AS CONSTRUCTED

CULVERT DETAIL

9