


FED. RD. DIVISION	STATE	PROJECT	
2	OHIO		

2
3

**MUSKINGUM COUNTY
COUNTY ROAD NO. 8**

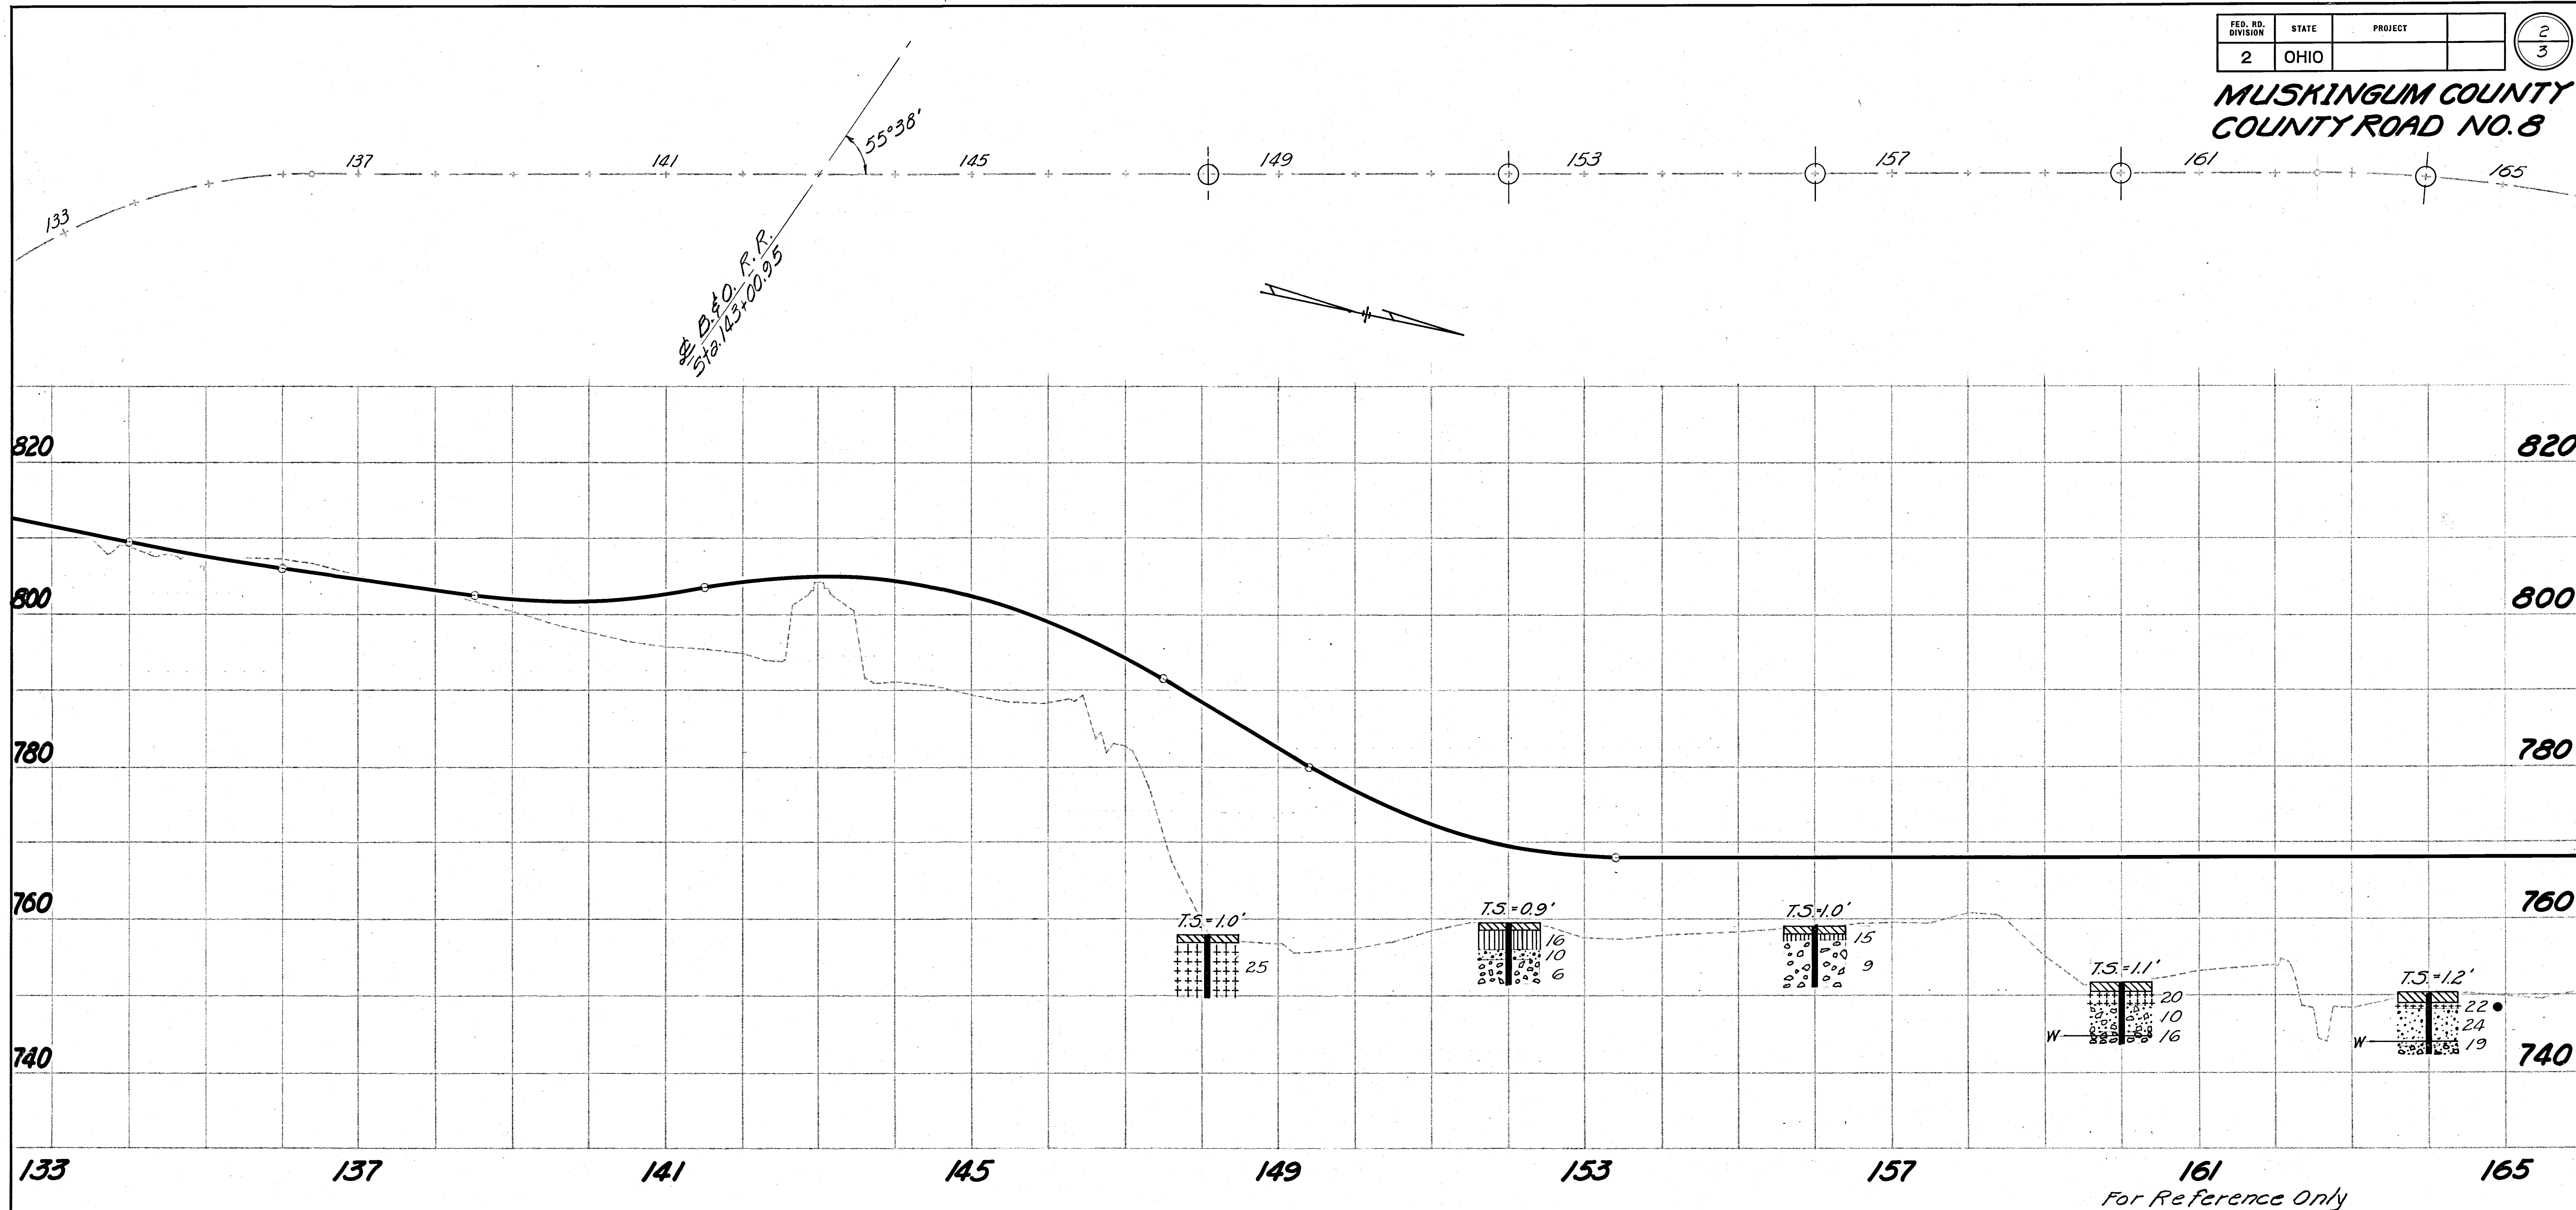

For Reference Only

REVISION	DATE	DESCRIPTION	BY
	3/23/62	AS CONSTRUCTED	H.F.K.

U. S. ARMY ENGINEER DISTRICT, HUNTINGTON
CORPS OF ENGINEERS
HUNTINGTON, W. VA.

DRAWN BY: *AWP*

TRACED BY:

CHECKED BY: *FHS*

SUBMITTED BY: *Elmer S. Barrett*

ELMER S. BARRETT ASSOCIATES

RECOMMENDED BY: *James J. Turner*

CHIEF ENG. DIV.

APPROVED: *Steven Malerich*

COL. C.E. DISTRICT ENGINEER

DATE: NOVEMBER 1959

LICKING RIVER
DILLON RESERVOIR PROJECT

RELOCATION OF MUSKINGUM COUNTY ROAD NO. 8
MC-8-4 & MT-408-1
MC-8-1 & MC-408-1

ELMER S. BARRETT ASSOCIATES
CONSULTING ENGINEERS
CHILLICOTHE, OHIO

SCALE: 1" = 100' H & V

DRAWING NUMBER
027f-UD 14-68/

SHEET 2 OF 3