


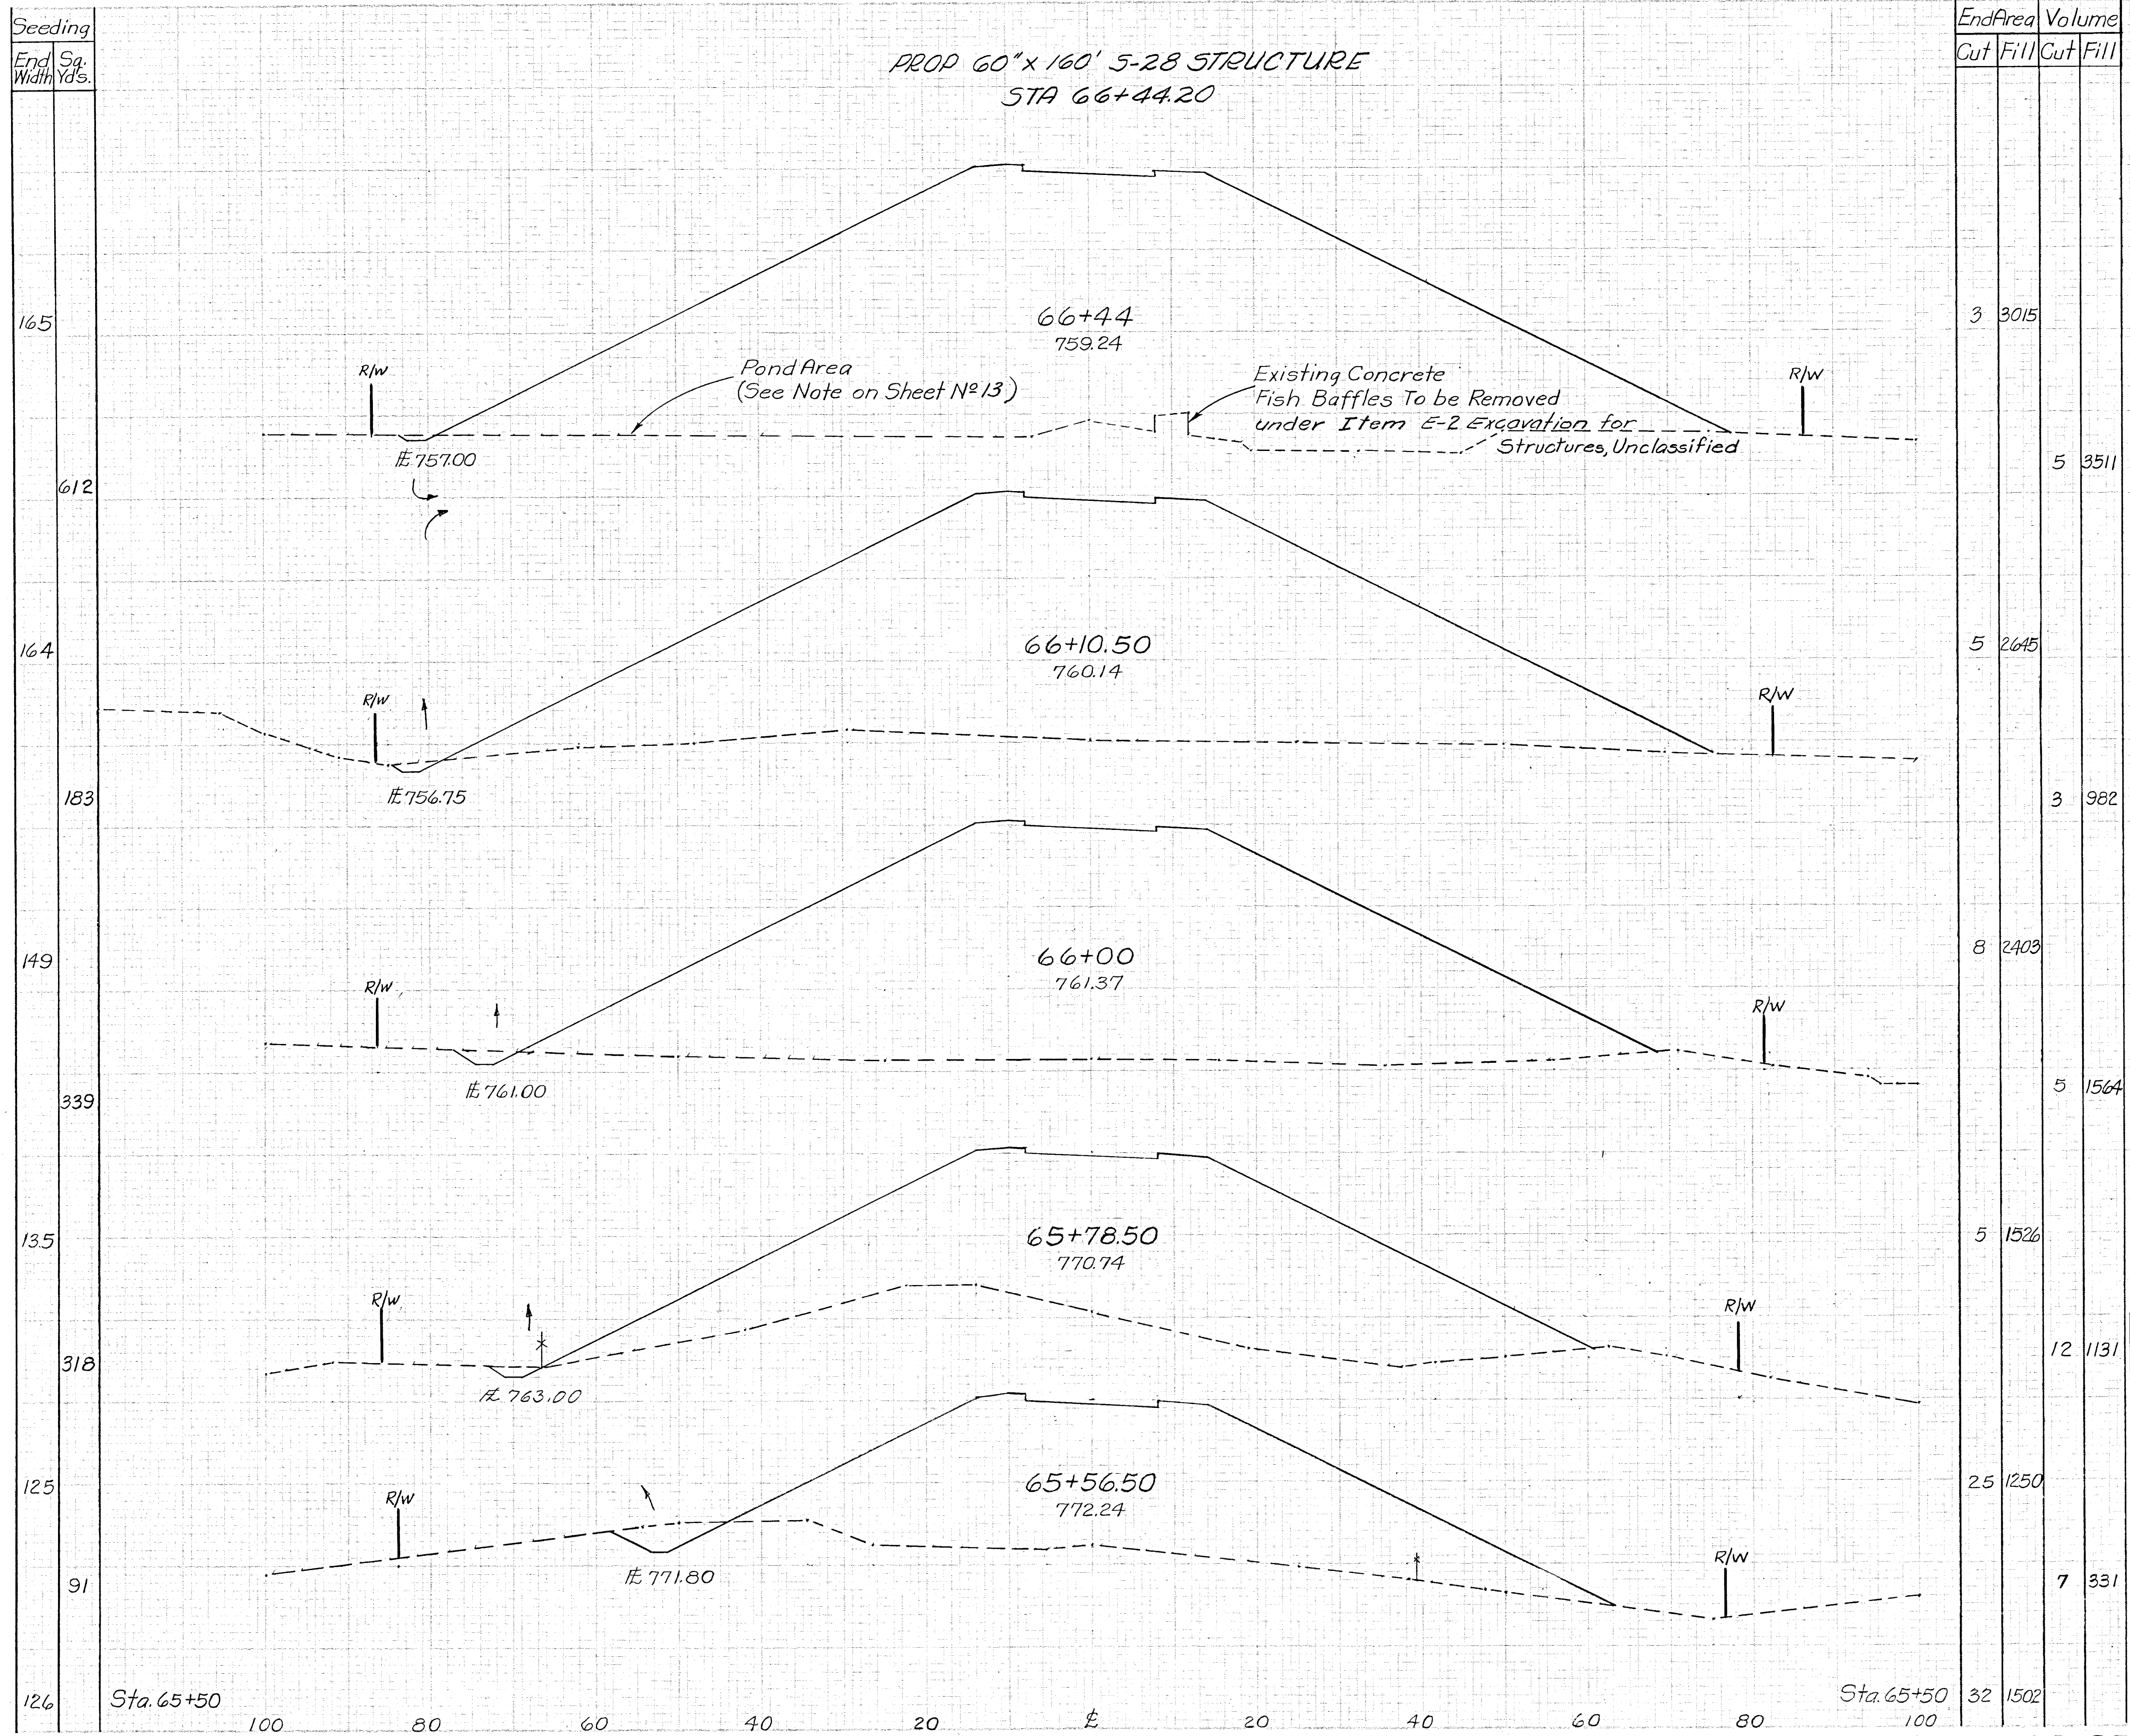

End Area		Volume	
Cut	Fill	Cut	Fill
3	3015		
		5	3511
5	2645		
		3	982
8	2403		
		5	1564
		5	1526
		12	1131
25	1250		
		7	331
32	1502		

REVISION	DATE	DESCRIPTION	BY
	3/20/62	AS CONSTRUCTED	H.F.K.
U. S. ARMY ENGINEER DISTRICT, HUNTINGTON CORPS OF ENGINEERS HUNTINGTON, W. VA.			
DRAWN BY:		LICKING RIVER DILLON RESERVOIR PROJECT RELOCATION OF TOWNSHIP ROAD NO. 409 (MT-409-2)	
CHECKED BY: <i>SEW</i>		DATE: AUGUST 1959	
SUBMITTED BY: <i>Elmer S. Barrett</i>		APPROVED: <i>[Signature]</i> COL. C.E., DISTRICT ENGINEER	
RECOMMENDED BY: <i>[Signature]</i> CHIEF ENG. DIV.		ELMER S. BARRETT ASSOCIATES CONSULTING ENGINEERS CHILLICOTHE, OHIO	
SCALE: 1" = 10'		SPEC. NO. DRAWING NUMBER 027f-UD15-68/22 SHEET 22 OF 27	

WORK AS CONSTRUCTED CROSS SECTIONS STA. 65+56.50 TO STA. 66+44