


Seeding	
End Width	Sq. Yds.
99	
911	
65	
347	
60	
356	
68	
531	
123	
758	
150	
365	
163	
638	
165	

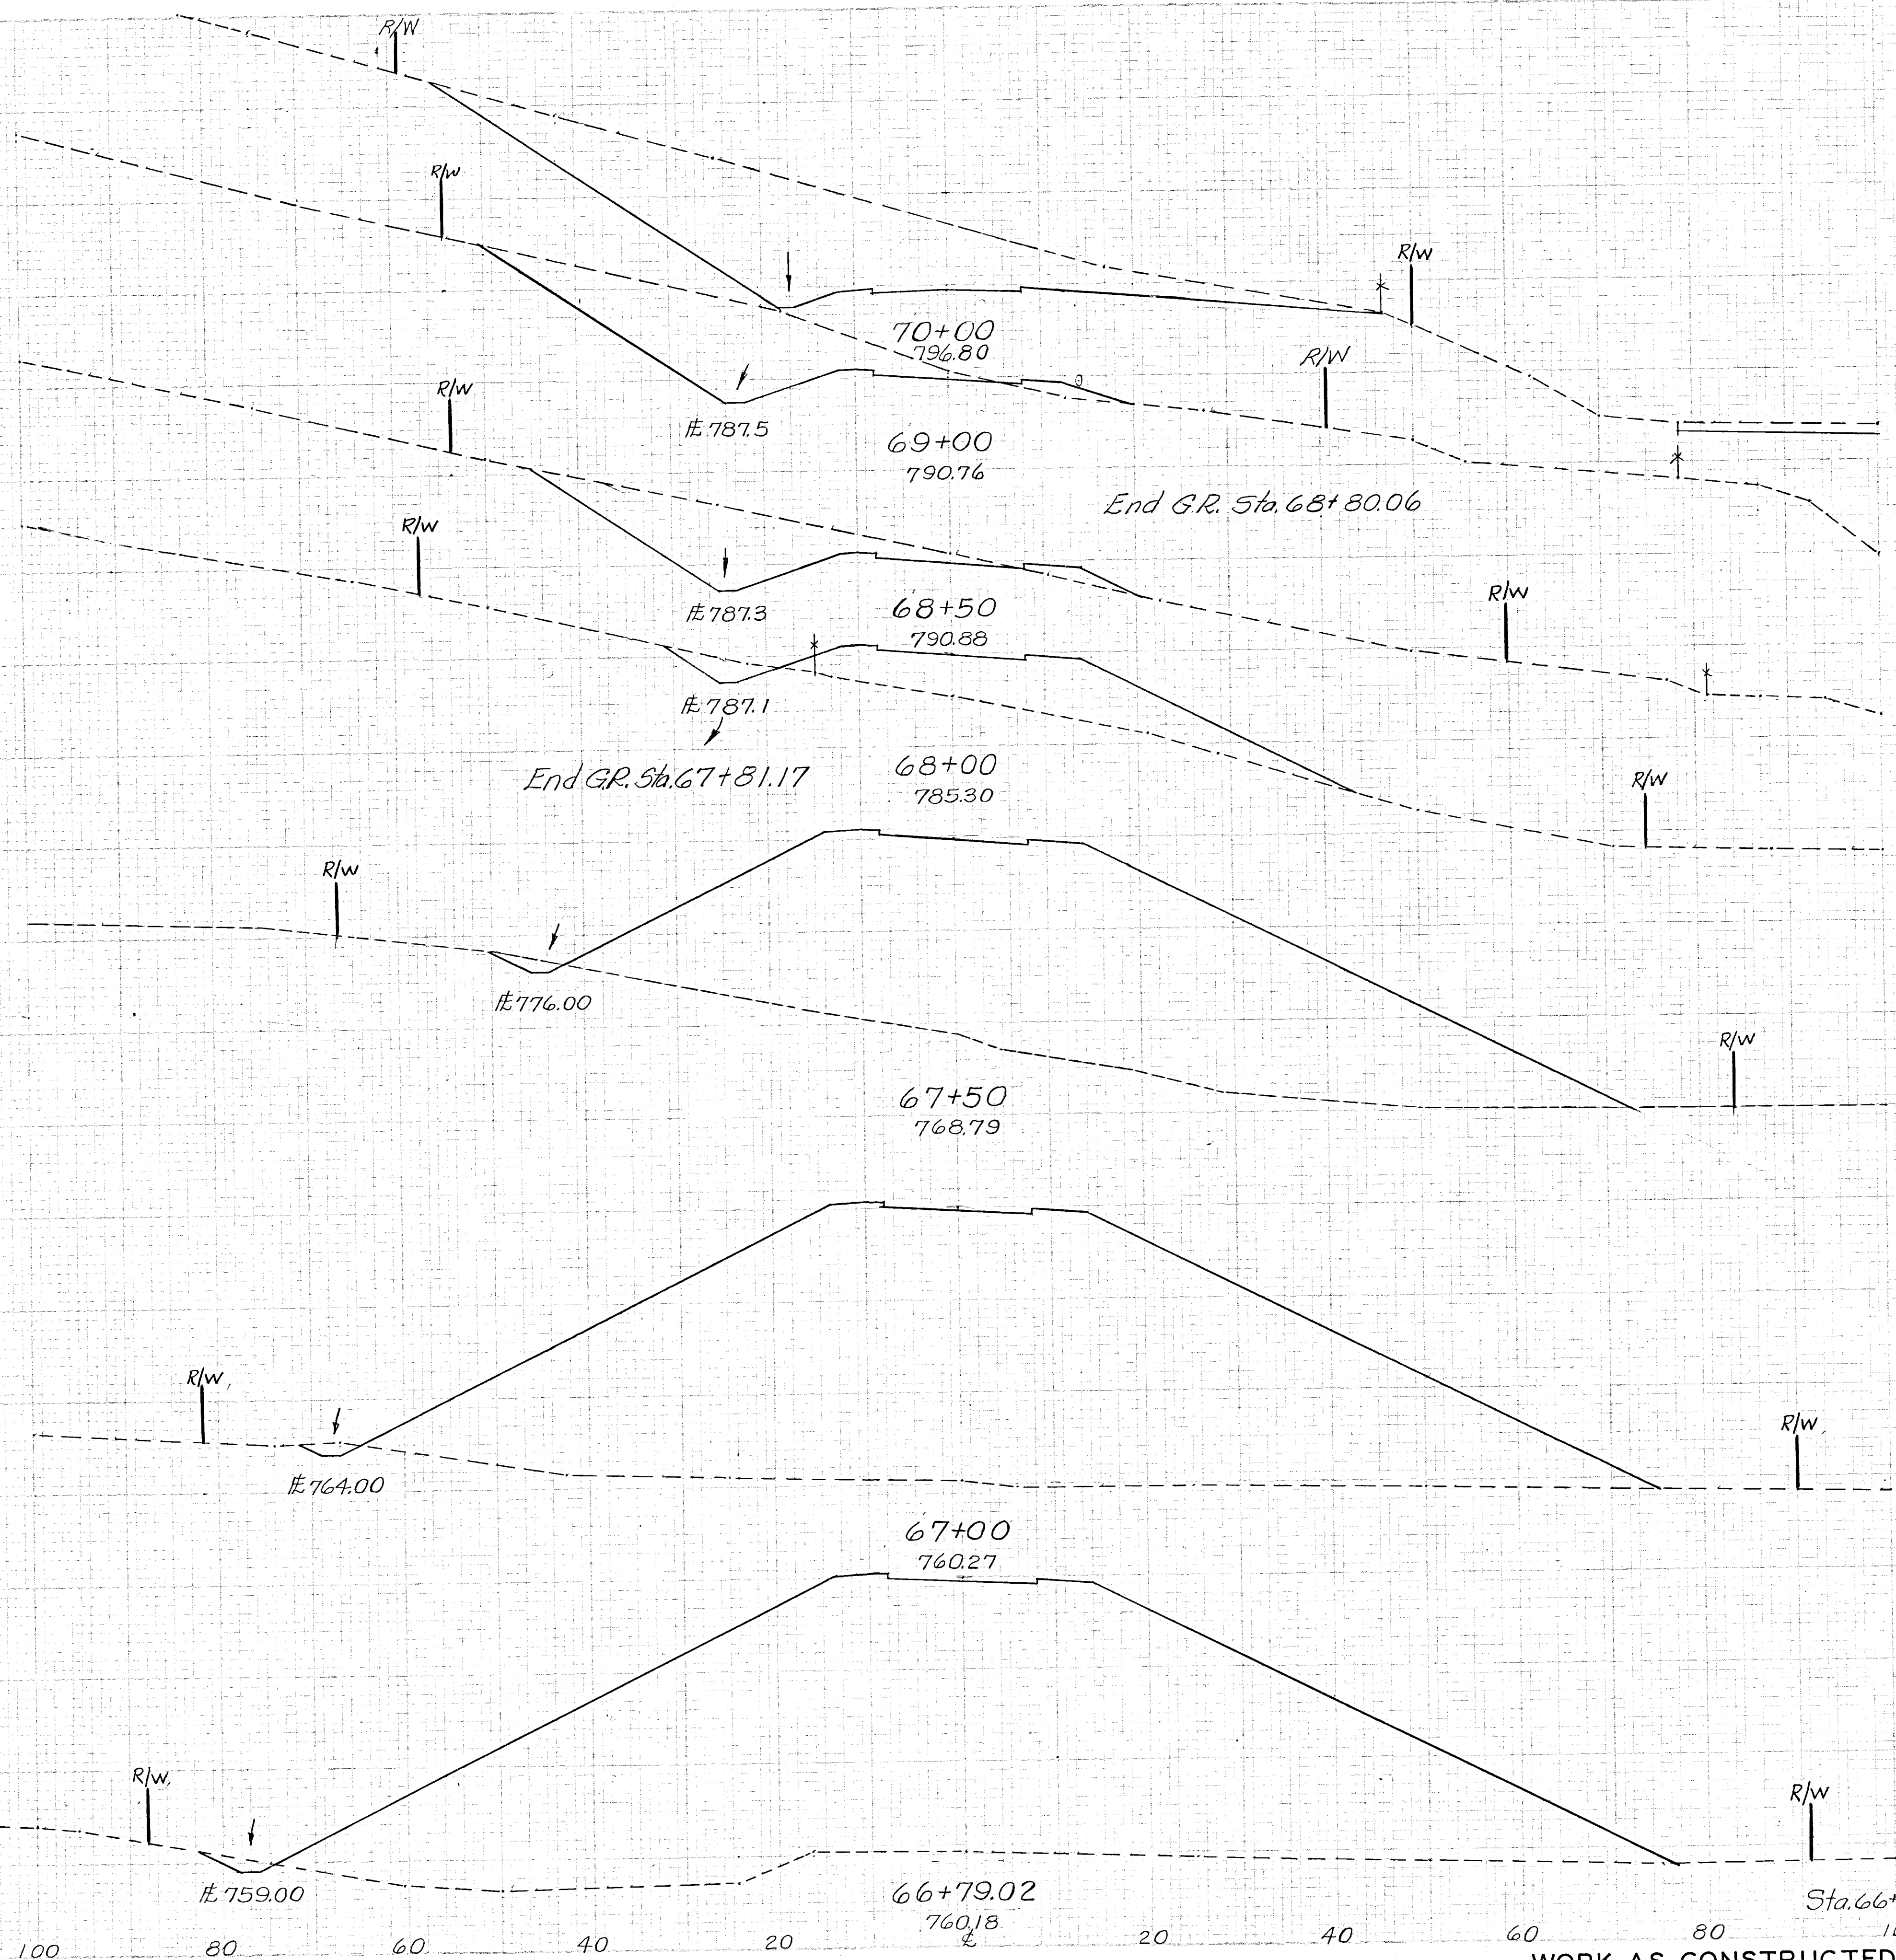

End Area		Volume	
Cut	Fill	Cut	Fill
604	0		
295	15	1665	28
		453	24
194	11	198	228
20	235		
		25	1695
7	1596		
		13	3833
7	2544		
		6	2090
8	2835		
		7	3794
3	3015		

MUSKINGUM COUNTY
TOWNSHIP ROAD NO. 409

23
27

REVISION	DATE	DESCRIPTION	BY
	3/20/62	AS CONSTRUCTED	H.F.K.
U. S. ARMY ENGINEER DISTRICT, HUNTINGTON CORPS OF ENGINEERS HUNTINGTON, W. VA.			
DRAWN BY:		LICKING RIVER DILLON RESERVOIR PROJECT	
CHECKED BY: <i>SEW</i>		RELOCATION OF TOWNSHIP ROAD NO. 409 (MT-409-2)	
SUBMITTED BY: <i>Elmer S. Barrett</i>		DATE: AUGUST 1959	
RECOMMENDED: <i>Elmer S. Barrett</i>		APPROVED: <i>A. J. [Signature]</i> COL. C.E., DISTRICT ENGINEER	
ELMER S. BARRETT ASSOCIATES CONSULTING ENGINEERS CHILlicothe, OHIO		SCALE: 1"=10' SHEET 23 OF 27	

WORK AS CONSTRUCTED CROSS SECTIONS STA. 66+79.02 TO STA. 70+00