
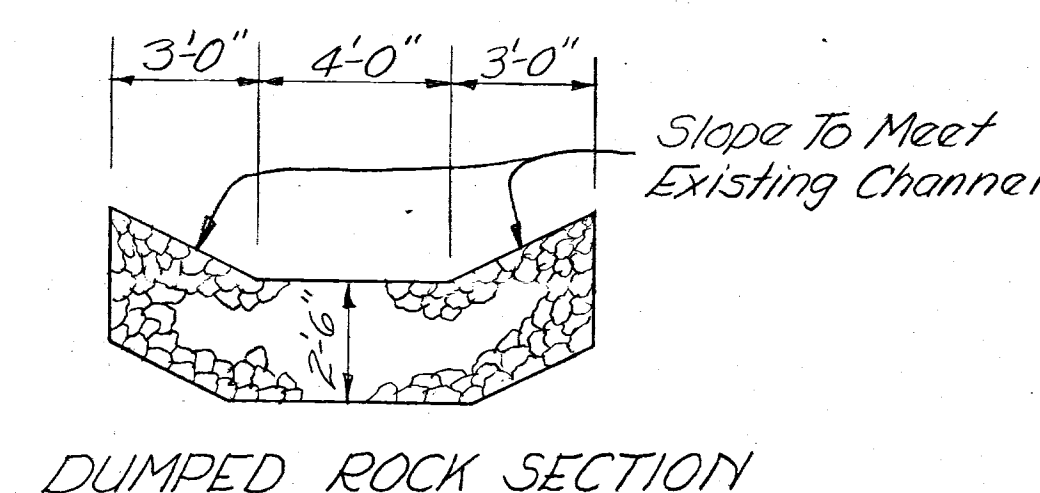
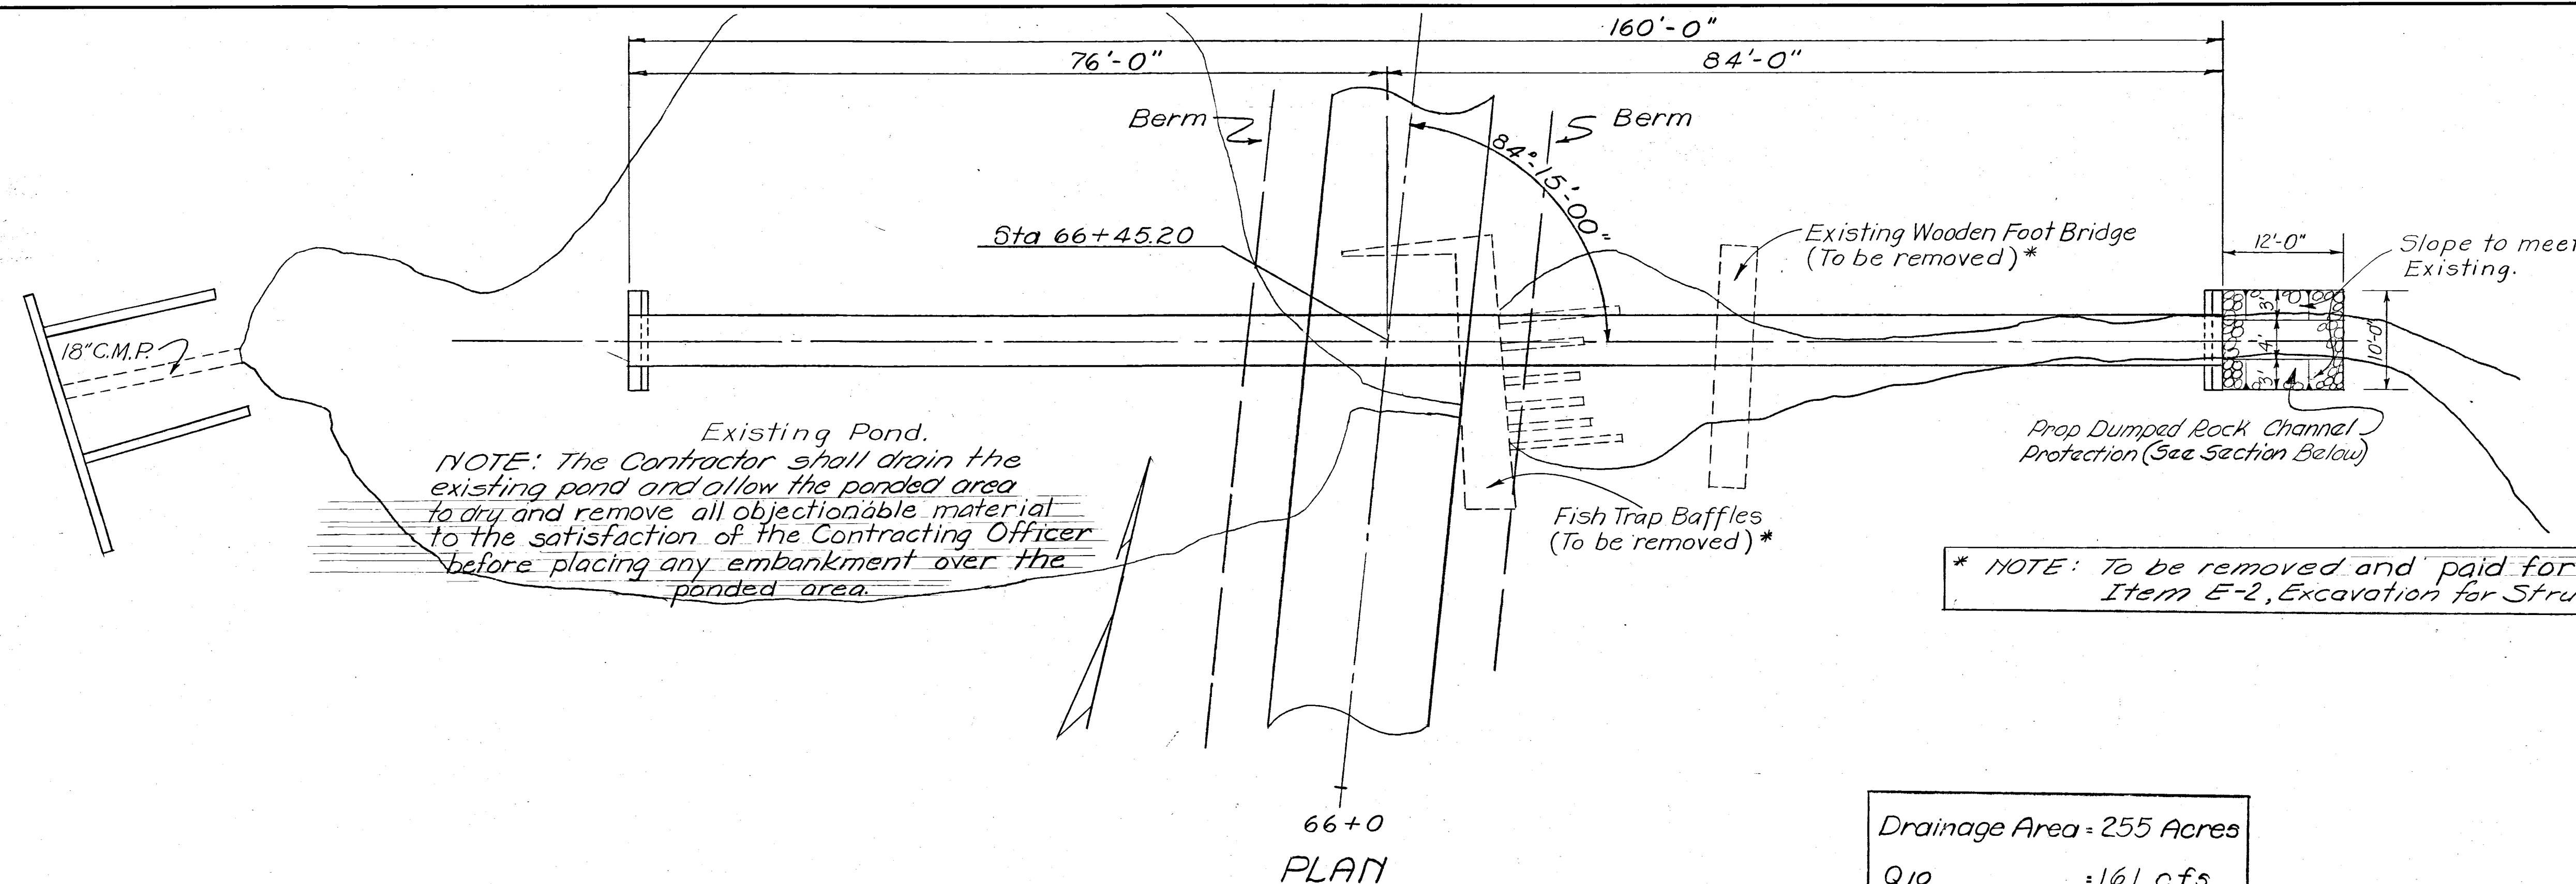
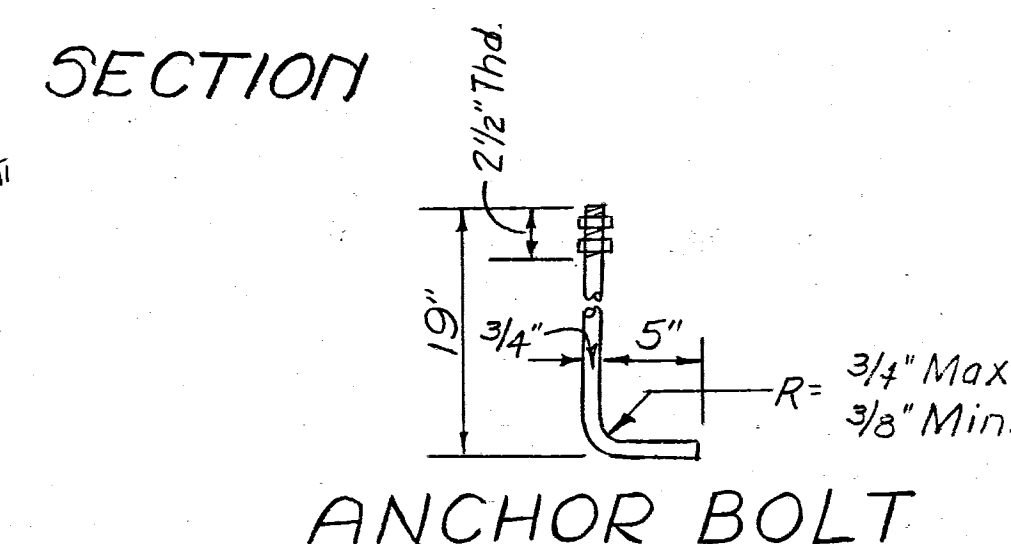
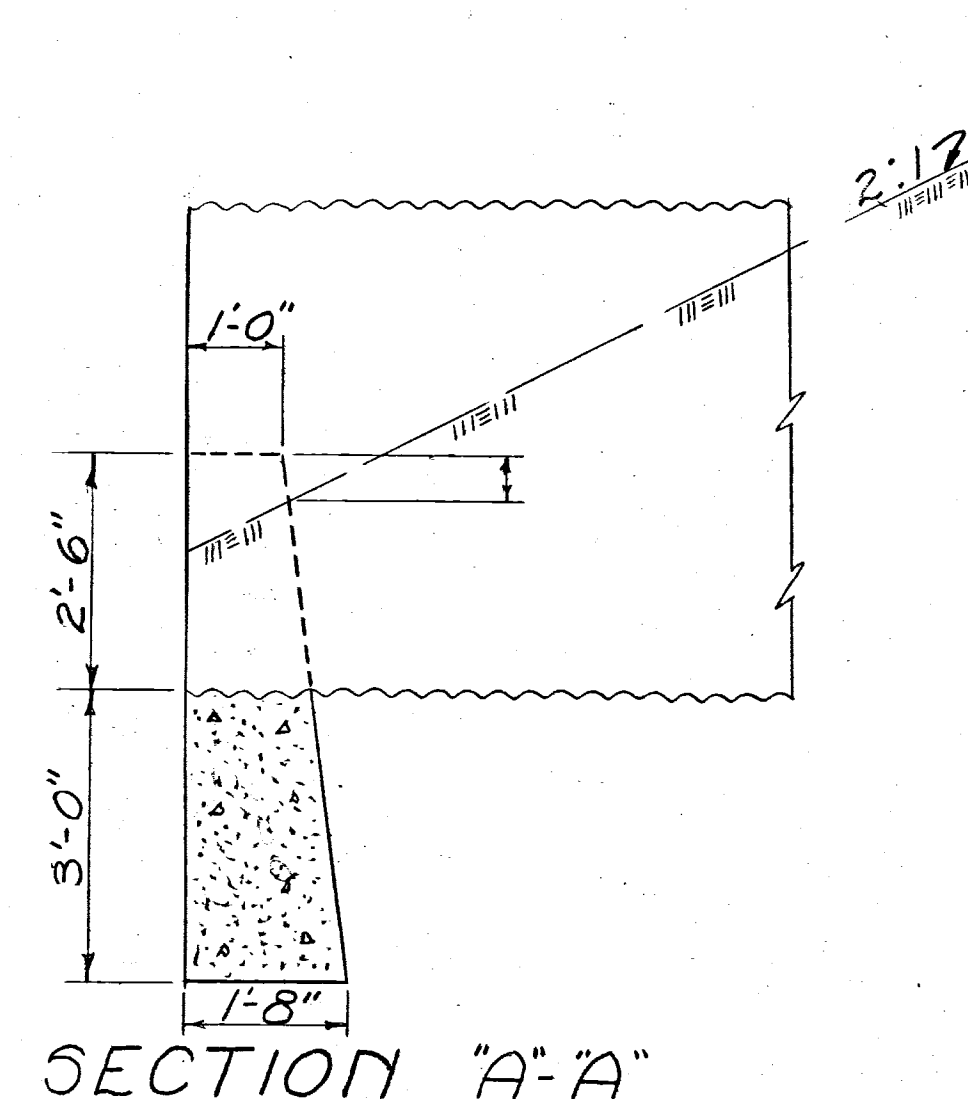


3

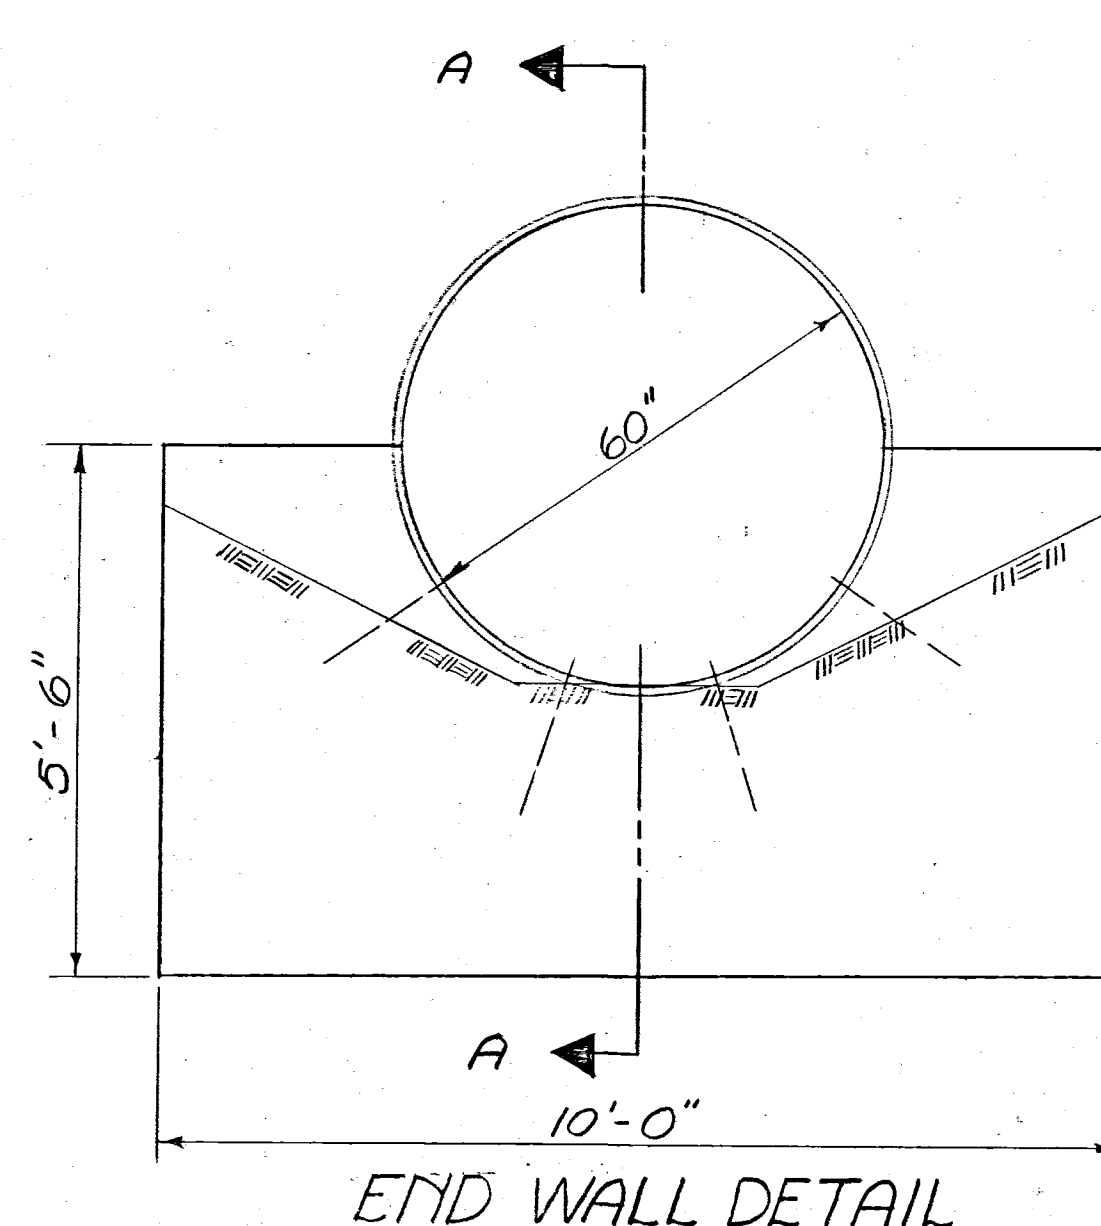

NOTE: Anchor bolts shall be provided at the inlet end and at 1'-6" centers. Bolts and nuts shall be hot dipped galvanized with threads chased to give class 2 fit. Included with corrugated plate culvert for payment.

Concrete for Endwalls shall be Class "E"

ESTIMATED QUANTITIES

E-2 Excavation for Structures, Unclassified	700.0 Yd.
S-1 Concrete for Structures	4.93 Cu. Yd.
S-28 60 Inch Sectional Corrugated Metal Structure	160 L.F.
I-10 Dumped Rock Channel Protection	11 Cu. Yd.

REVISION	DATE	DESCRIPTION	BY
	3/20/62	AS CONSTRUCTED	H.F.K.
U. S. ARMY ENGINEER DISTRICT, HUNTINGTON CORPS OF ENGINEERS HUNTINGTON, W. VA.			
DRAWN BY: EAP		LICKING RIVER DILLON RESERVOIR PROJECT	
CHECKED BY: ESW		RELOCATION OF TOWNSHIP ROAD NO. 409 (MT-409-2)	
SUBMITTED BY: Elmer S. Barrett Associates		DATE: AUGUST 1959	
RECOMMENDED: Elmer S. Barrett Associates		APPROVED: [Signature]	
CHIEF ENG. DIV.		COL. C.E. DISTRICT ENGINEER	
ELMER S. BARRETT ASSOCIATES CONSULTING ENGINEERS CHILLICOTHE, OHIO		SCALE: 1"=10' DRAWING NUMBER 027f-UD15-68/26 SHEET 26 OF 27	