


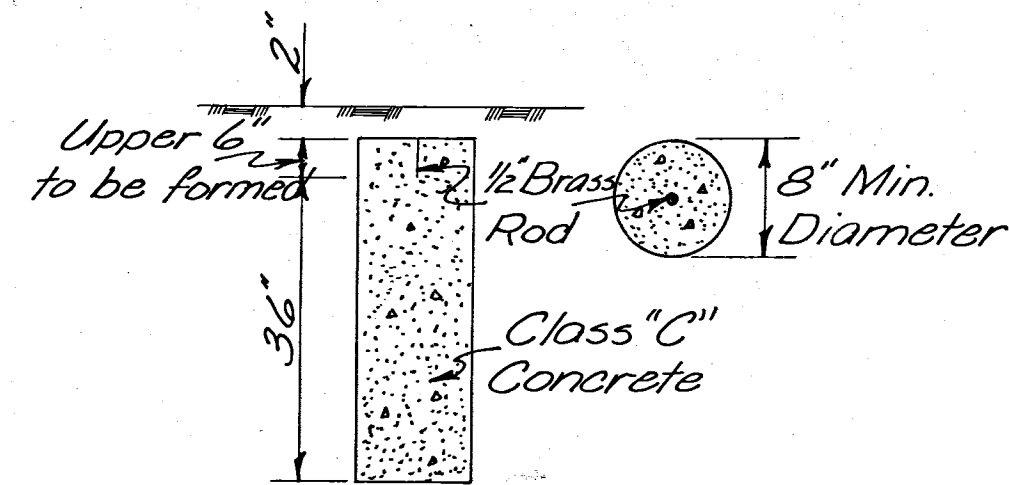



DETAIL OF MONUMENT
Monuments shall be constructed of Class "C" concrete cast-in-place in a circular hole eight (8") inches in diameter and forty-four (44") inches in depth. The top of concrete shall be finished at a depth of two (2") inches below ground level and the upper six (6") inch portion of the concrete shall be formed. One-half (1/2") inch brass rods, six (6") inches long, shall be embedded in the wet concrete as directed by the Contracting Officer to mark the centerline and station.

LOCATION PLAN

MUSKINGUM COUNTY

FALLS TOWNSHIP ROAD NO. 409

0 200 400 600 800
SCALE IN FEET

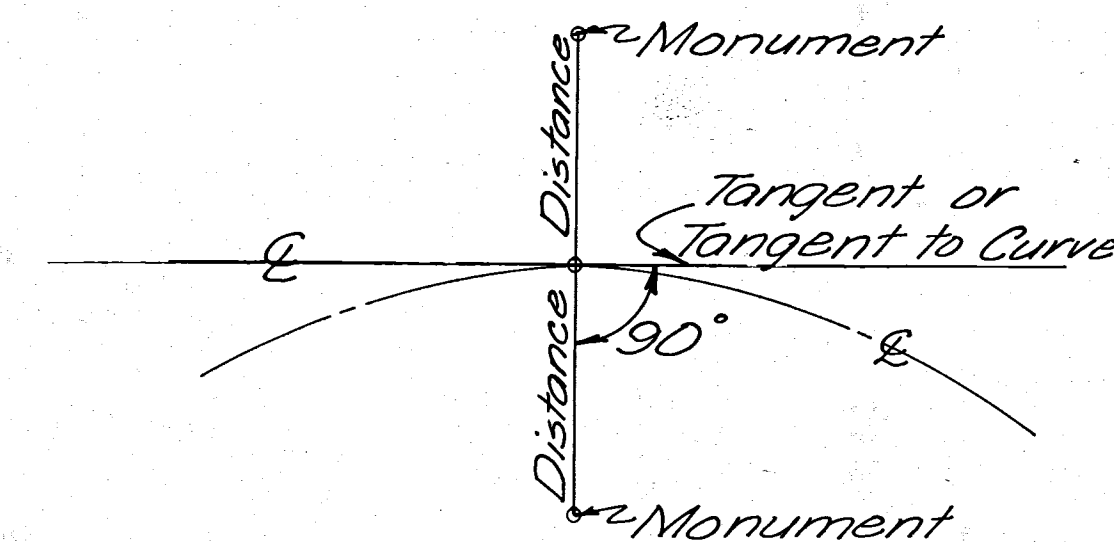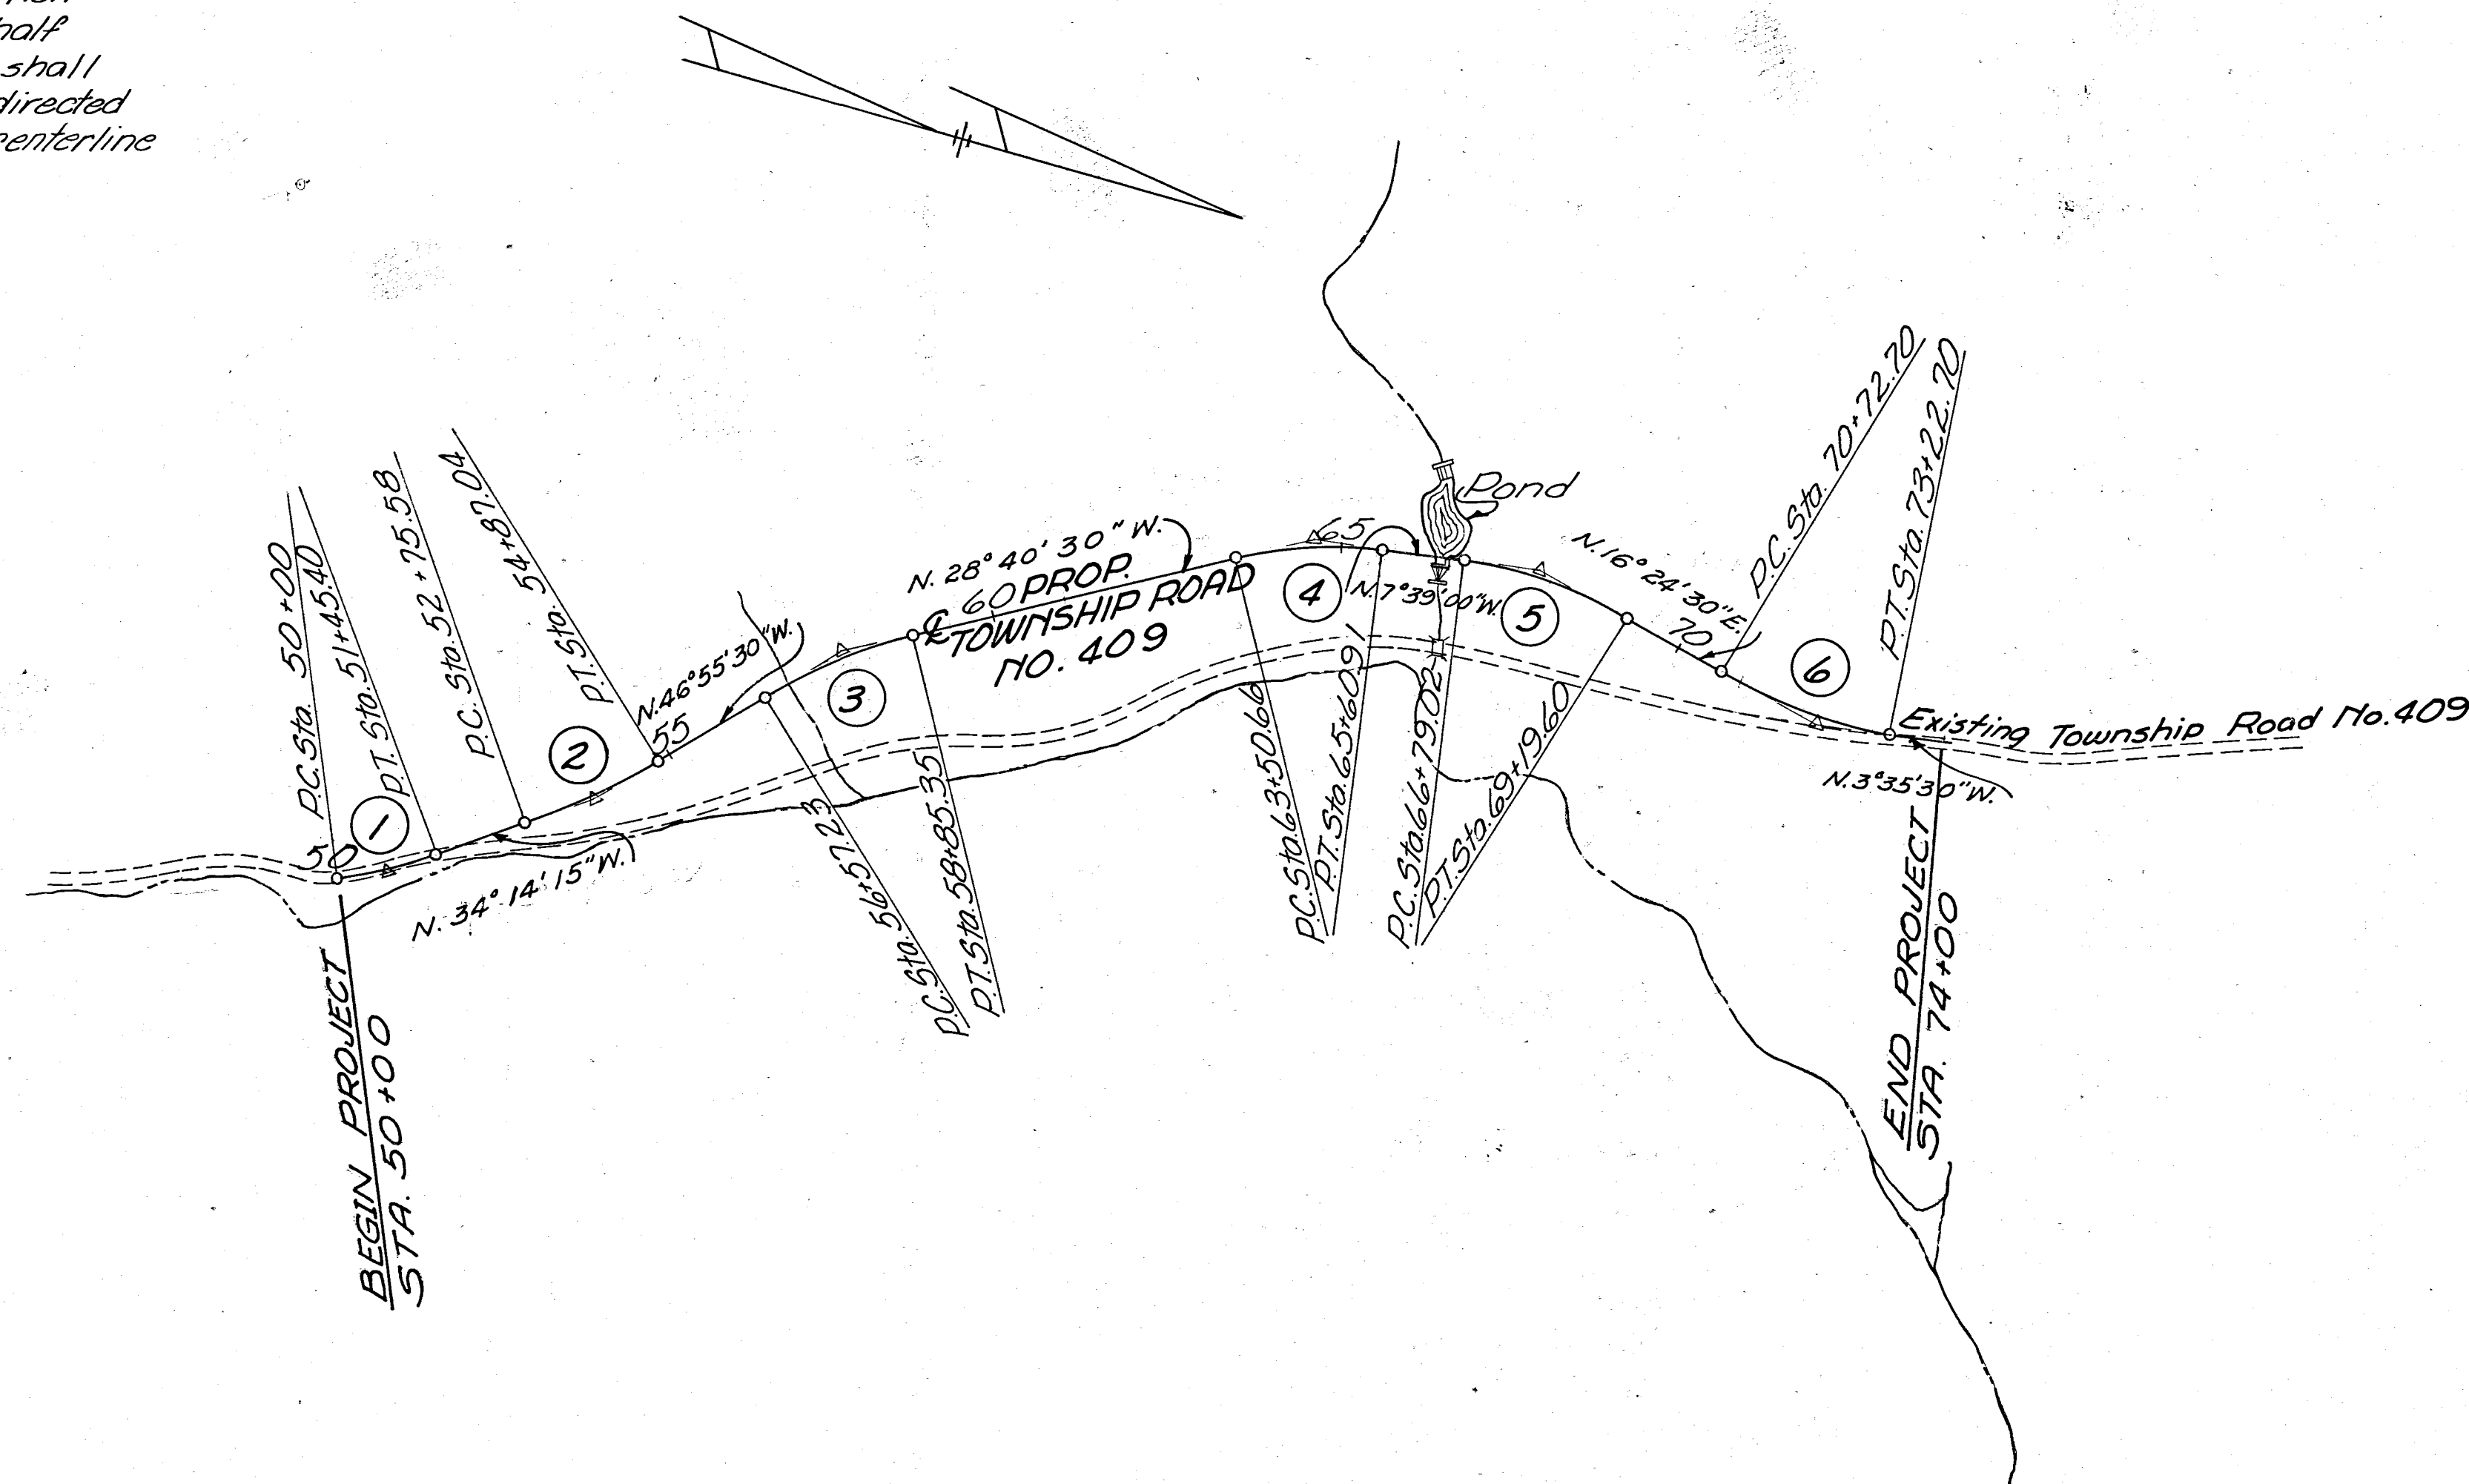

**DETAIL FOR SETTING
REFERENCE MONUMENTS**

MONUMENTS TO BE PLACED AFTER CONSTRUCTION

Station	Dist	Dist	Station	Dist	Dist	Station	Dist	Dist
	Lt	Rt		Lt	Rt		Lt	Rt
50+00	12'	12'	63+50.66	12'	12'	73+22.70	12'	12'
51+45.40	12'	12'	65+60.91	12'	12'	74+00	12'	12'
54+87.04	12'	12'	66+79.02	12'	12'			
56+57.23	12'	12'	69+19.60	12'	12'			
58+85.35	12'	12'	70+72.70	12'	12'			

PROPOSED CURVE DATA

No.	P.I. Station	Δ	Dc	R	L	T	E
1	50+73.02	13°05'10" Lt	9'00"	636.62	145.40	73.02	4.17
2	53+81.74	12°41'15" Lt	6'00"	954.93	211.46	106.16	5.88
3	57+72.27	18°15'00" Rt	8'00"	716.20	228.12	115.04	9.18
4	64+56.98	21°01'30" Rt	10'00"	572.96	210.25	106.32	9.78
5	68+01.11	24°03'30" Rt	10'00"	572.96	240.58	122.09	12.86
6	71+98.99	20°00'00" Lt	8'00"	716.20	250.00	126.29	11.05

I hereby certify that this plan is a true delineation of a survey made in 1959 for the U.S. Army, Corps of Engineers, Huntington District and Muskingum County by Elmer S. Barrett Associates.

Elmer S. Barrett Date: 8-10-59
ELMER S. BARRETT P.E. #6937, Registered Surveyor # 2890

This plan is recorded in the Muskingum County Record of Plats, Book: _____ Page: _____
Date: _____

REVISION	DATE	DESCRIPTION	BY
	3/20/62	AS CONSTRUCTED	H.F.K.
U. S. ARMY ENGINEER DISTRICT, HUNTINGTON CORPS OF ENGINEERS HUNTINGTON, W. VA.			
DRAWN BY: <u>REV</u>		LICKING RIVER DILLON RESERVOIR PROJECT	
CHECKED BY: <u>LLF</u>		RELOCATION OF TOWNSHIP ROAD NO. 409 (MT-409-2)	
SUBMITTED BY: <u>Elmer S. Barrett</u>		APPROVED: <u>[Signature]</u> DATE: AUGUST 1959	
RECOMMENDED BY: <u>[Signature]</u>		COL. C.E. DISTRICT ENGINEER	
ELMER S. BARRETT ASSOCIATES CONSULTING ENGINEERS CHILLICOTHE, OHIO		SCALE: 1"=200' DRAWING NUMBER 027f-UD15-68/27 SHEET 27 OF 27	

QUANTITIES
Item I-8 Monument Assemblies, 24 Each

WORK AS CONSTRUCTED LOCATION PLAN