


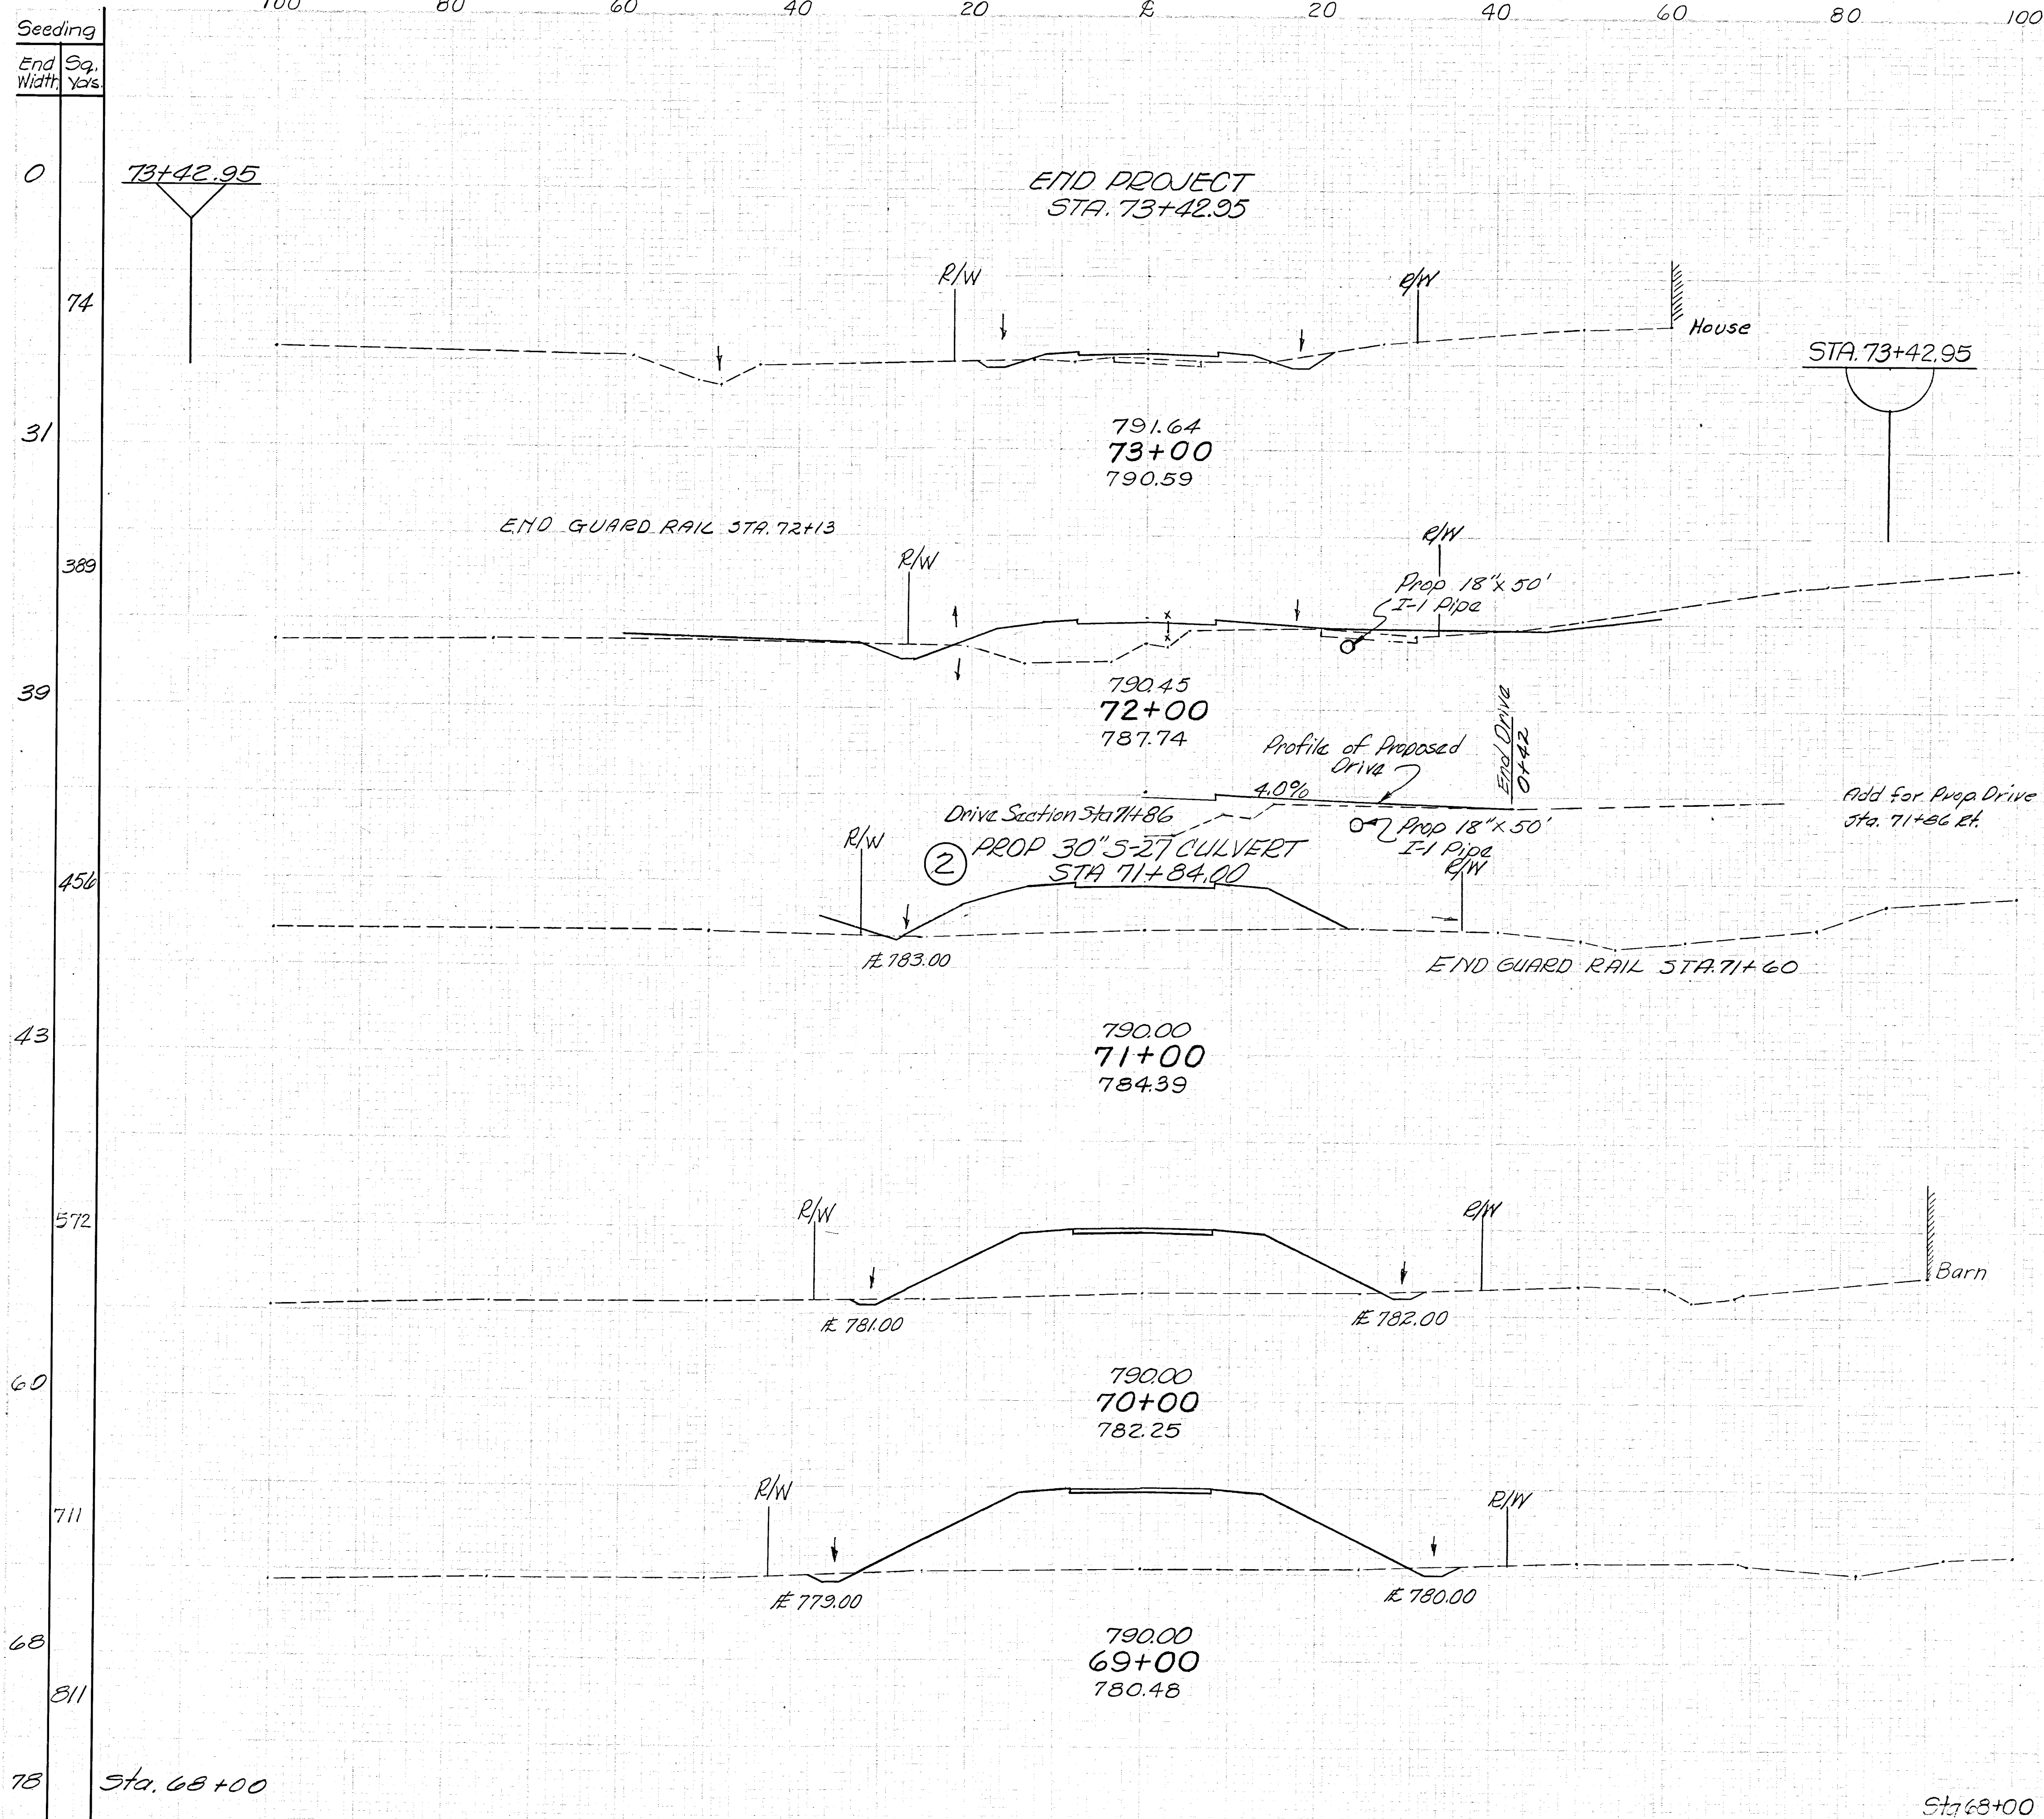

End Area		Volume	
Cut	Fill	Cut	Fill
0	0	7	16
9	20	57	209
22	93	0	6
44	544	2	201
15	928	6	300
30	1346	10	427
35	1393	9	595

MUSKINGUM COUNTY
TOWNSHIP ROADS NO. 47 & 60

17
26

REVISION		DATE	DESCRIPTION	BY
U. S. ARMY ENGINEER DISTRICT, HUNTINGTON CORPS OF ENGINEERS HUNTINGTON, W. VA.				
DRAWN BY:		LICKING RIVER DILLON RESERVOIR PROJECT RELOCATION OF TOWNSHIP ROAD NO. 47 SECTION I (MT-47-1) READJUSTMENT OF TOWNSHIP ROAD NO. 60 SECTION I (MT-60-1)		
CHECKED BY: <i>SW</i>		DATE: AUGUST 1959		
SUBMITTED BY: <i>Elmer S. Barrett</i>		APPROVED: <i>A. J. [Signature]</i>		
ELMER S. BARRETT ASSOCIATES CHILLICOTHE, OHIO		SCALE: 1" = 10' DRAWING NUMBER 027f-UD10-68/17 SHEET 17 OF 26		

WORK AS CONSTRUCTED CROSS SECTIONS - TOWNSHIP ROAD NO. 47-STA. 69+00 TO STA. 73+00