


Seeding	
End Width	Sq. Yds.
0	87
39	133
21	

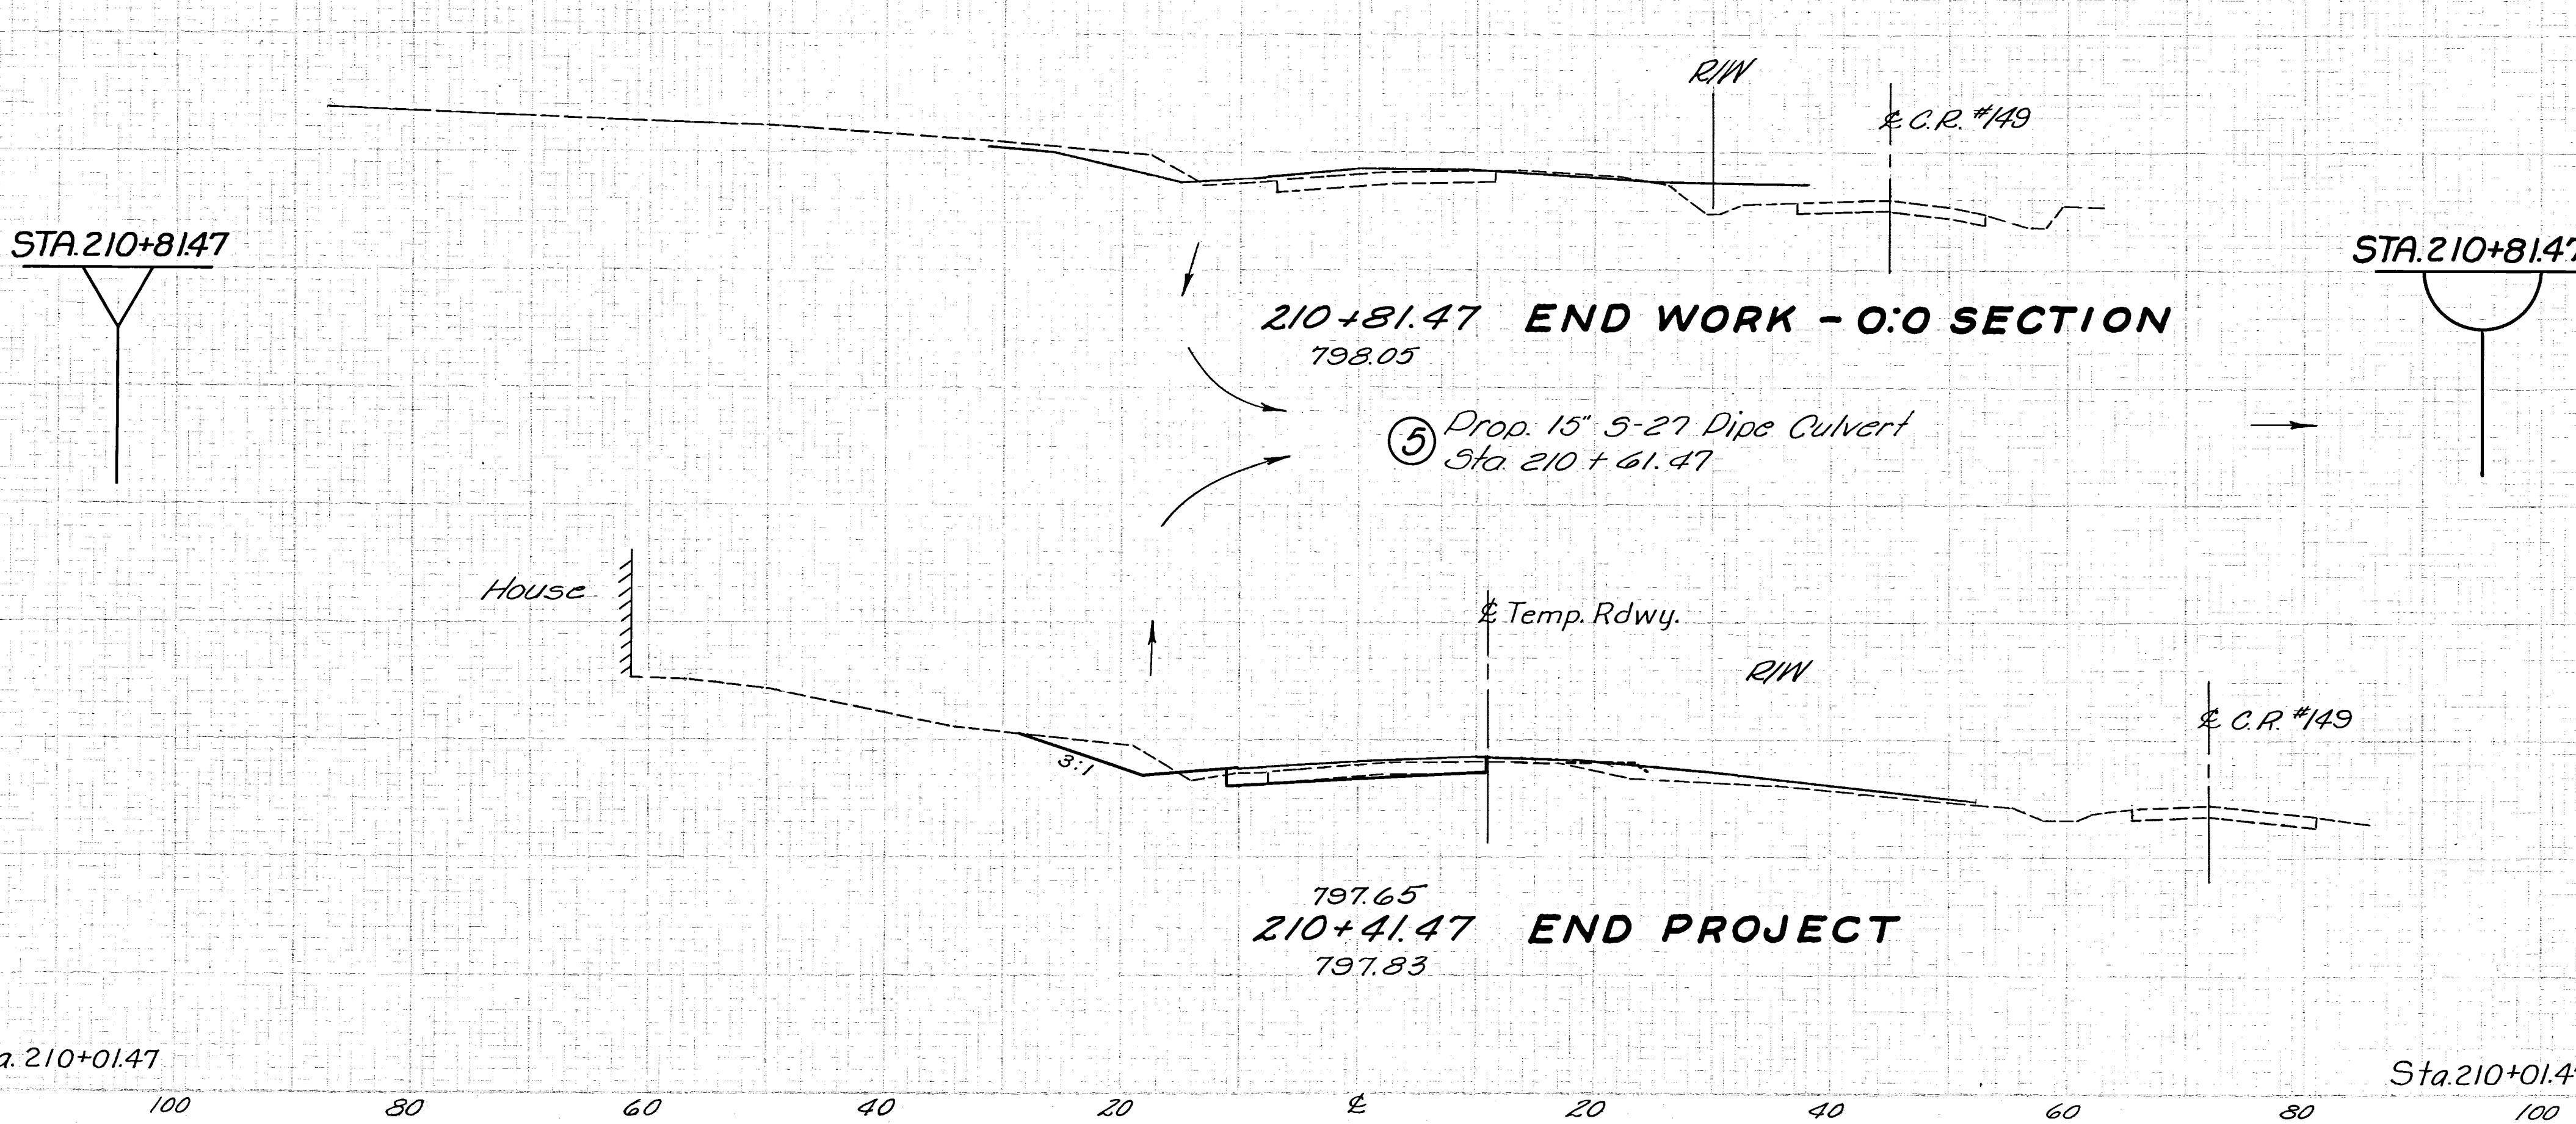

	<i>End Area</i>		<i>Volume</i>	
	<i>Cut</i>	<i>Fill</i>	<i>Cut</i>	<i>Fill</i>
7	0	0	28	7
	38	10	44	18
7	22	14		

MUSKINGUM COUNTY
MUS-156-2.85

*PARTICIPATION BY THE UNITED STATES
OF AMERICA*

Stations	Earthwork			
	End Area		Volume	
	Cut	Fill	Cut	Fill
Sta 210+81.47	0	0		
			0	2
Sta 210+41.47	0	3		
			0	4
Sta 210+01.47	0	3		

REVISION	DATE	DESCRIPTION			BY
U. S. ARMY ENGINEER DISTRICT, HUNTINGTON CORPS OF ENGINEERS HUNTINGTON, W. VA.					
DRAWN BY: <i>EER</i>		LICKING RIVER DILLON RESERVOIR PROJECT RELOCATION OF OHIO STATE ROUTE NO. 156 (Section 3&4)			
TRACED BY:					
CHECKED BY: <i>SW</i>					
SUBMITTED BY: <i>Elmer S. Barrett</i>					
ELMER S. BARRETT ASSOCIATES					
RECOMMENDED: <i>James J. Barner</i>		APPROVED: <i>James J. Barner</i>	DATE: JULY 1959		
CHIEF ENG. DIV.		COL. C.E., DISTRICT ENGINEER			
ELMER S. BARRETT ASSOCIATES CONSULTING ENGINEERS CHILLICOTHE, OHIO			SCALE: 1" = 1000' DRAWING NUMBER 027f-UD6-68/37 37-62		

60 WORK AS CONSTRUCTED 80 100 X SECTIONS- STA. 210+41.47 TO STA. 210+81.47