


Seeding
End Width Sq. Yds.

End Area Volume
Cut Fill Cut Fill

MUSKINGUM COUNTY
MUS-156-2.85

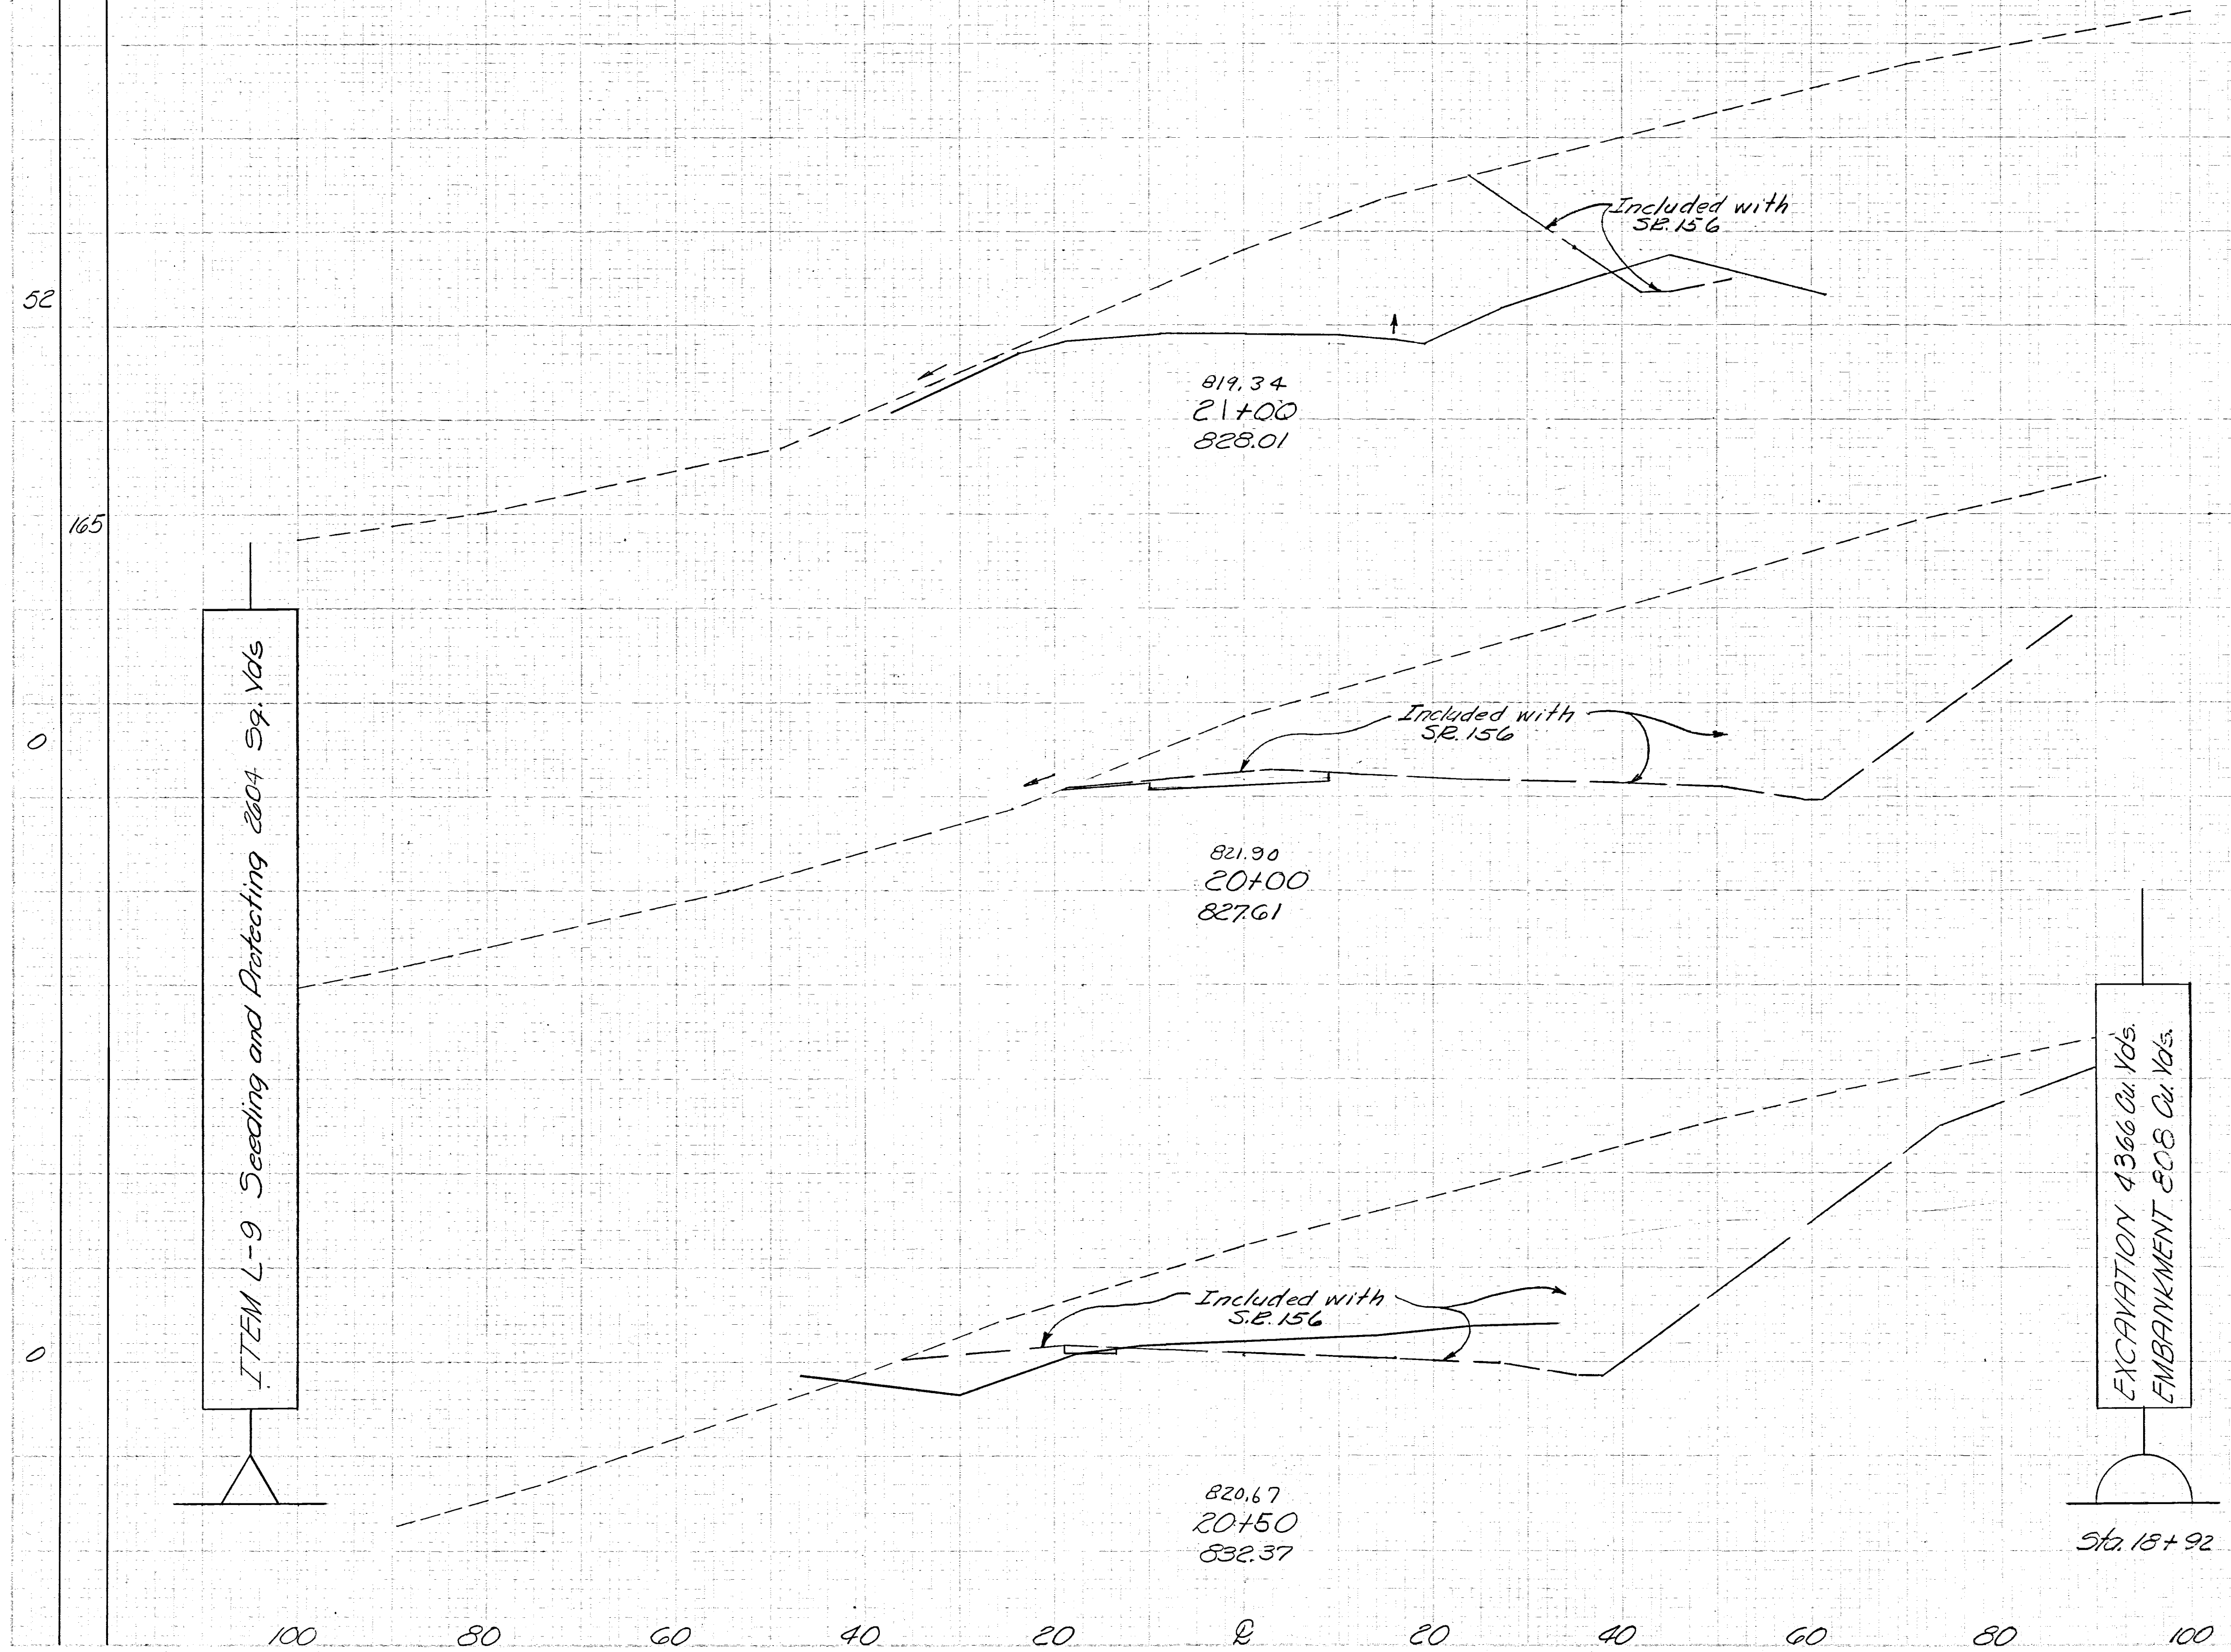

End Area	Volume
Cut	Fill
577	
630	0
20	0
11	0
4	0
0	0
0	0
0	0

REVISION	DATE	DESCRIPTION	BY
U. S. ARMY ENGINEER DISTRICT, HUNTINGTON CORPS OF ENGINEERS HUNTINGTON, W. VA.			
DRAWN BY: EER		LICKING RIVER DILLON RESERVOIR PROJECT RELOCATION OF OHIO STATE ROUTE NO. 156 (Section 3 & 4)	
CHECKED BY: EER		DATE: JULY 1959	
SUBMITTED BY: Elmer S. Barrett		APPROVED: [Signature]	
ELMER S. BARRETT ASSOCIATES		JOL. C.E. DISTRICT ENGINEER	
RECOMMENDED: [Signature]		SCALE: 1" = 10' - 0"	
CHIEF ENG. DIV.		SPEC. NO.	
ELMER S. BARRETT ASSOCIATES CONSULTING ENGINEERS CHILLICOTHE, OHIO		DRAWING NUMBER 0 2 7 1 - U D 6 - 6 8 / 4 0	
		SHEET 40 OF 62	

WORK AS CONSTRUCTED CONNECTION - STA. 20+00 TO STA. 20+82