


**MUSKINGUM COUNTY
TOWNSHIP HIGHWAY NO. 59
COUNTY HIGHWAY NO. 97 (P.H.)
LINE CHANGE**


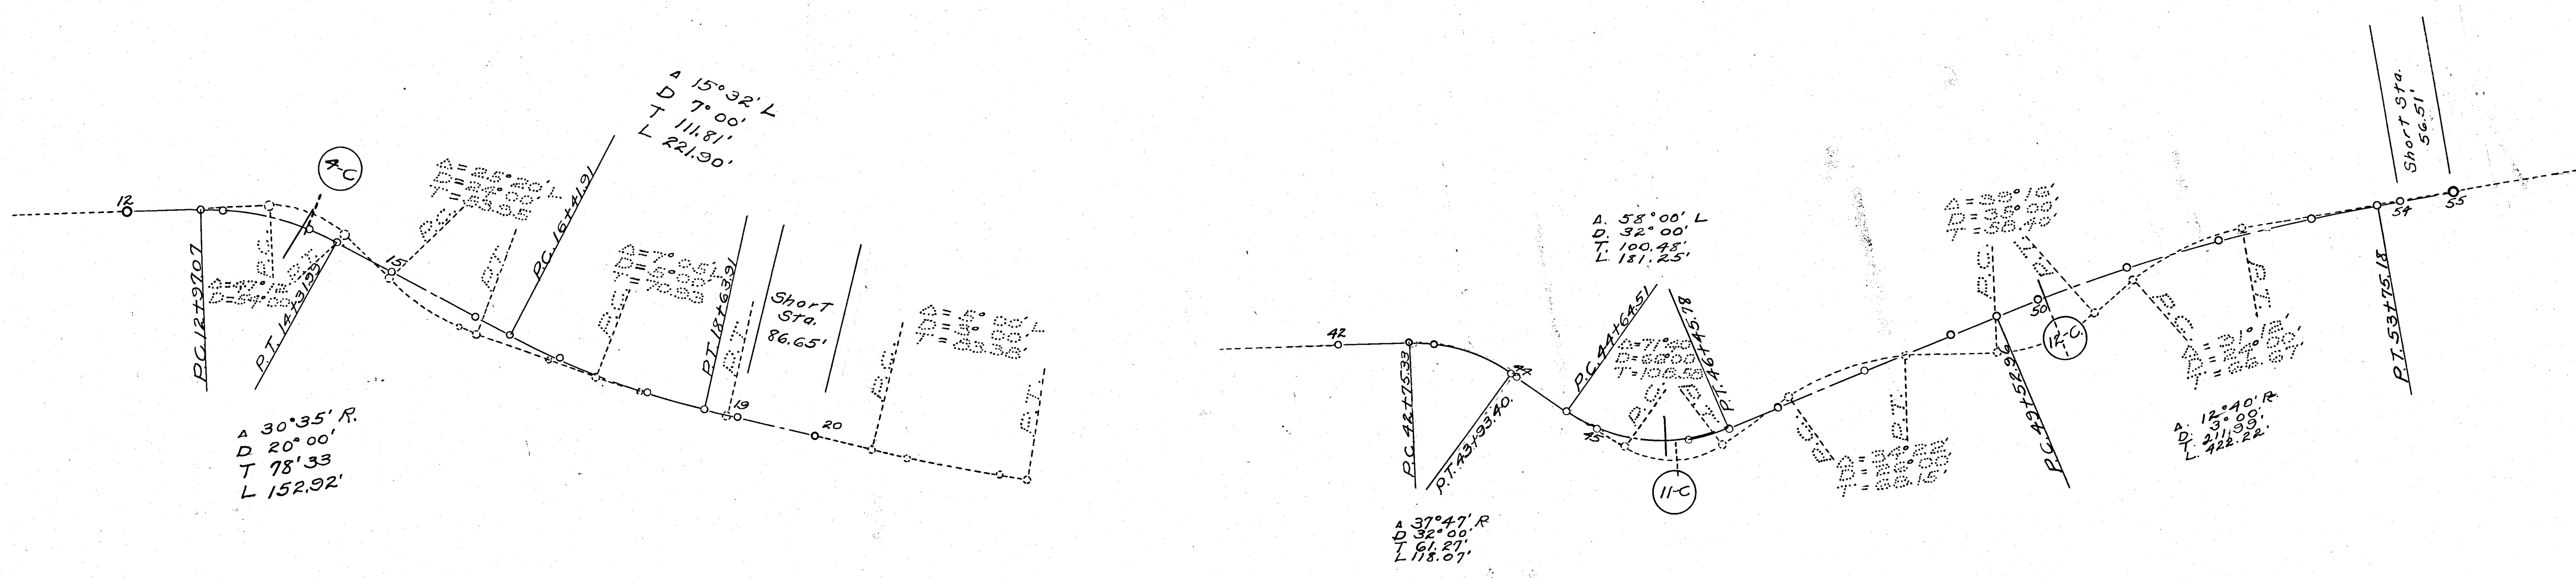


LEGEND
 As Planned
 As Constructed

CHANGE QUANTITIES				
Item		Unit	Add	Deduct
E-201	Excavation (unclass)	Cu. Yds.	1499	
T-110	Traffic compacted surface	" "		14
S-27	15" C.M.P.	Lin. Ft.	26	
S-27	30" C.M.P.	" "	10	

Change from Sta. 12+00 to Sta. 19+00

Change from Sta. 44+00 to 54+00

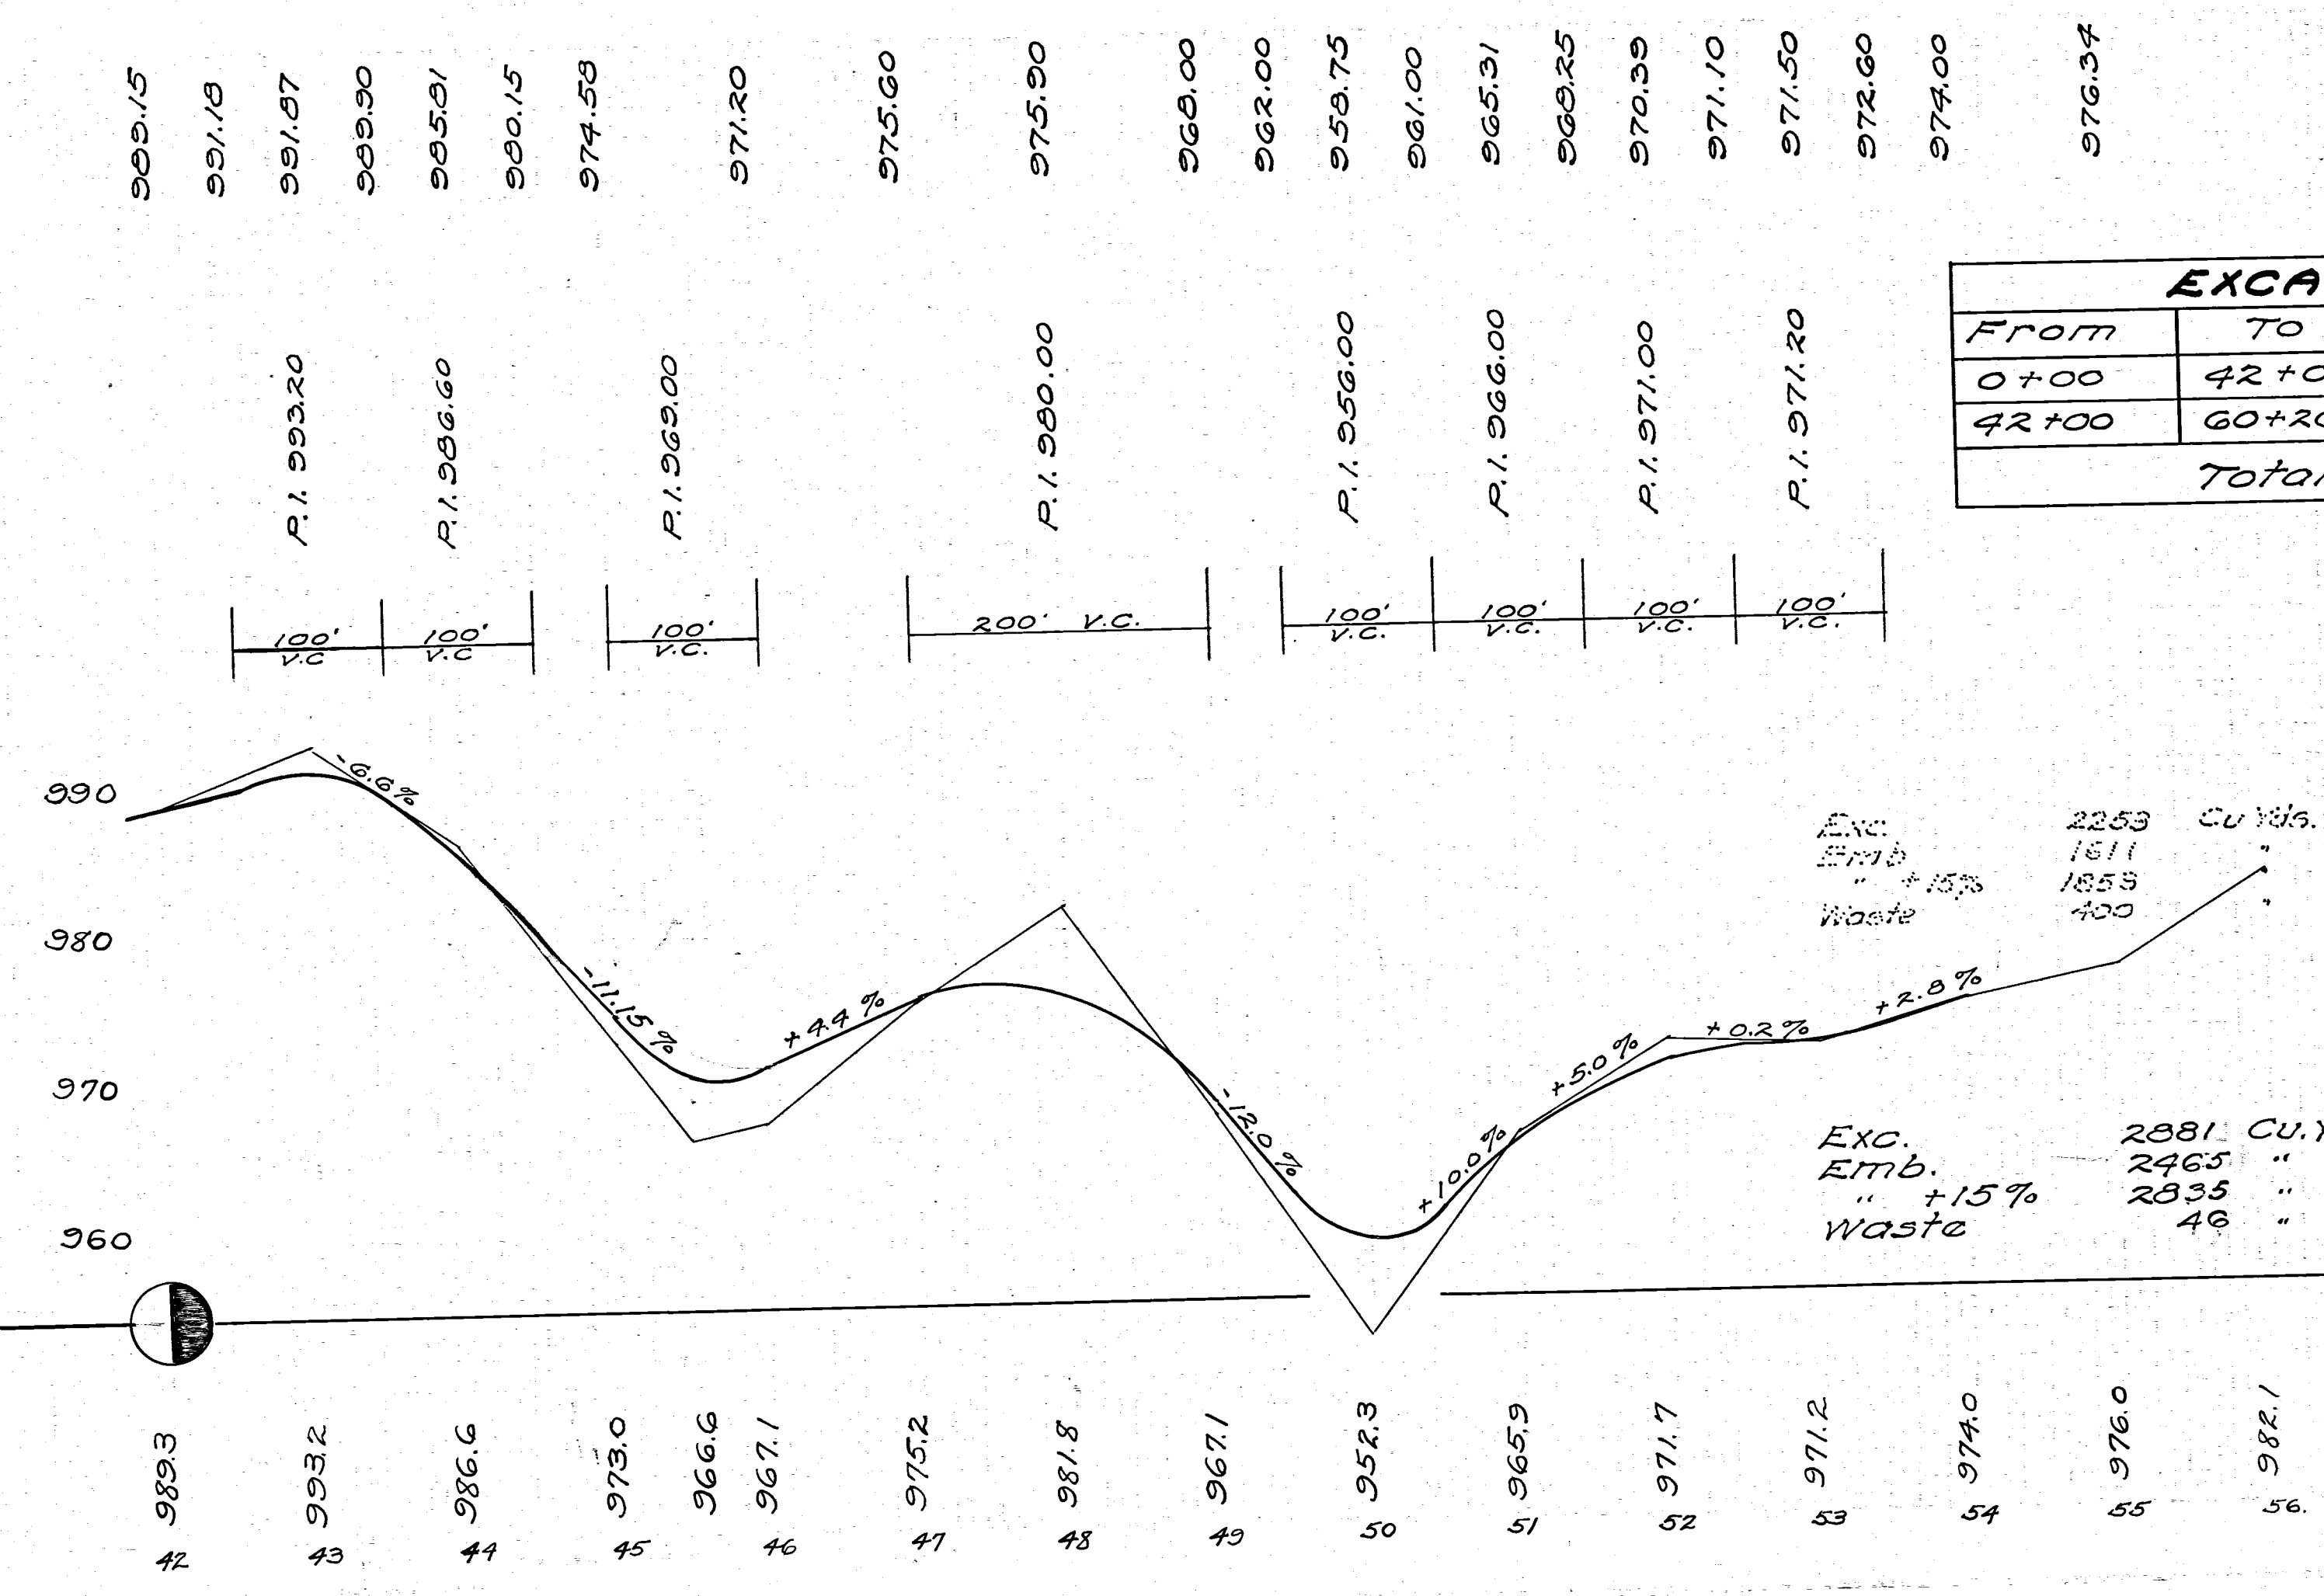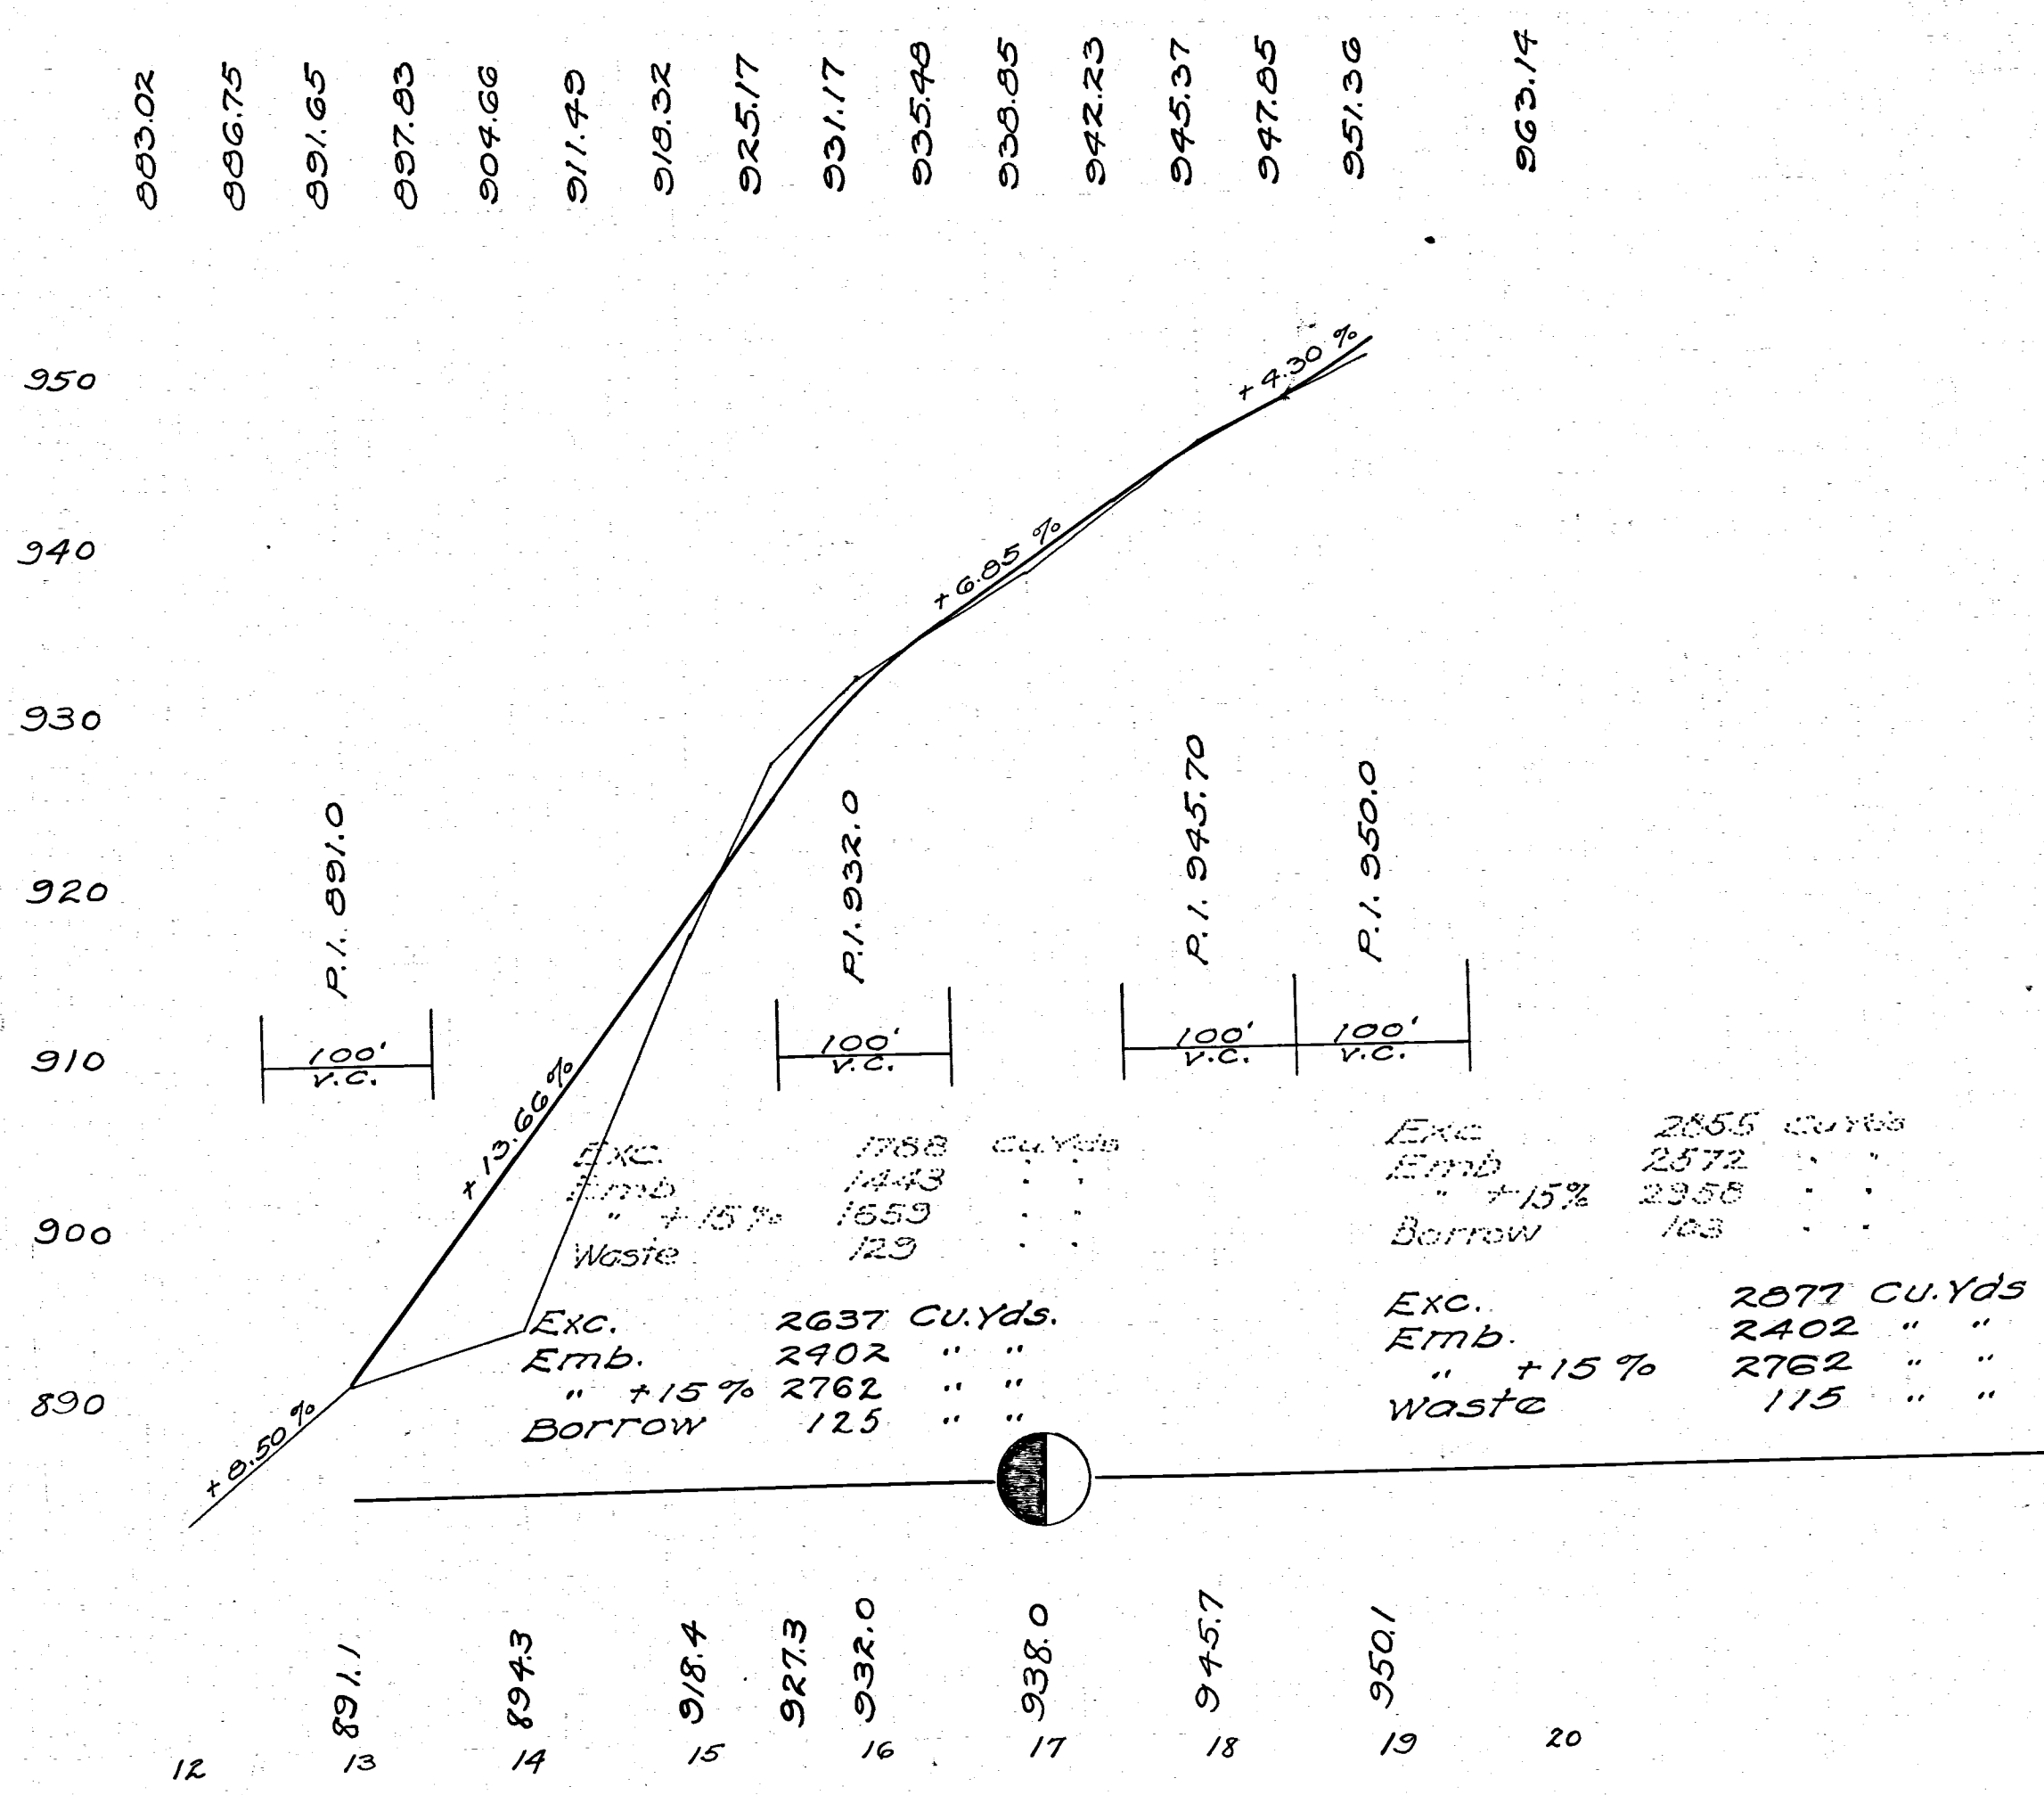

EXCAVATION			
From	To	Plans	Change
0+00	42+00	4643 Cu. Yds.	5514 Cu. Yds.
42+00	60+26.47	2253 " "	2881. " "
Total		6896 " "	8395 " "

Sta. 60+26.47