


MUSKINGUM COUNTY
TWP. HIGHWAY N° 59
CO. HIGHWAY N° 97 (PI)

Exc.
1855 Cu. Yds.
As planned
As constructed
Addition
2726 Cu. Yds.
871 Cu. Yds.

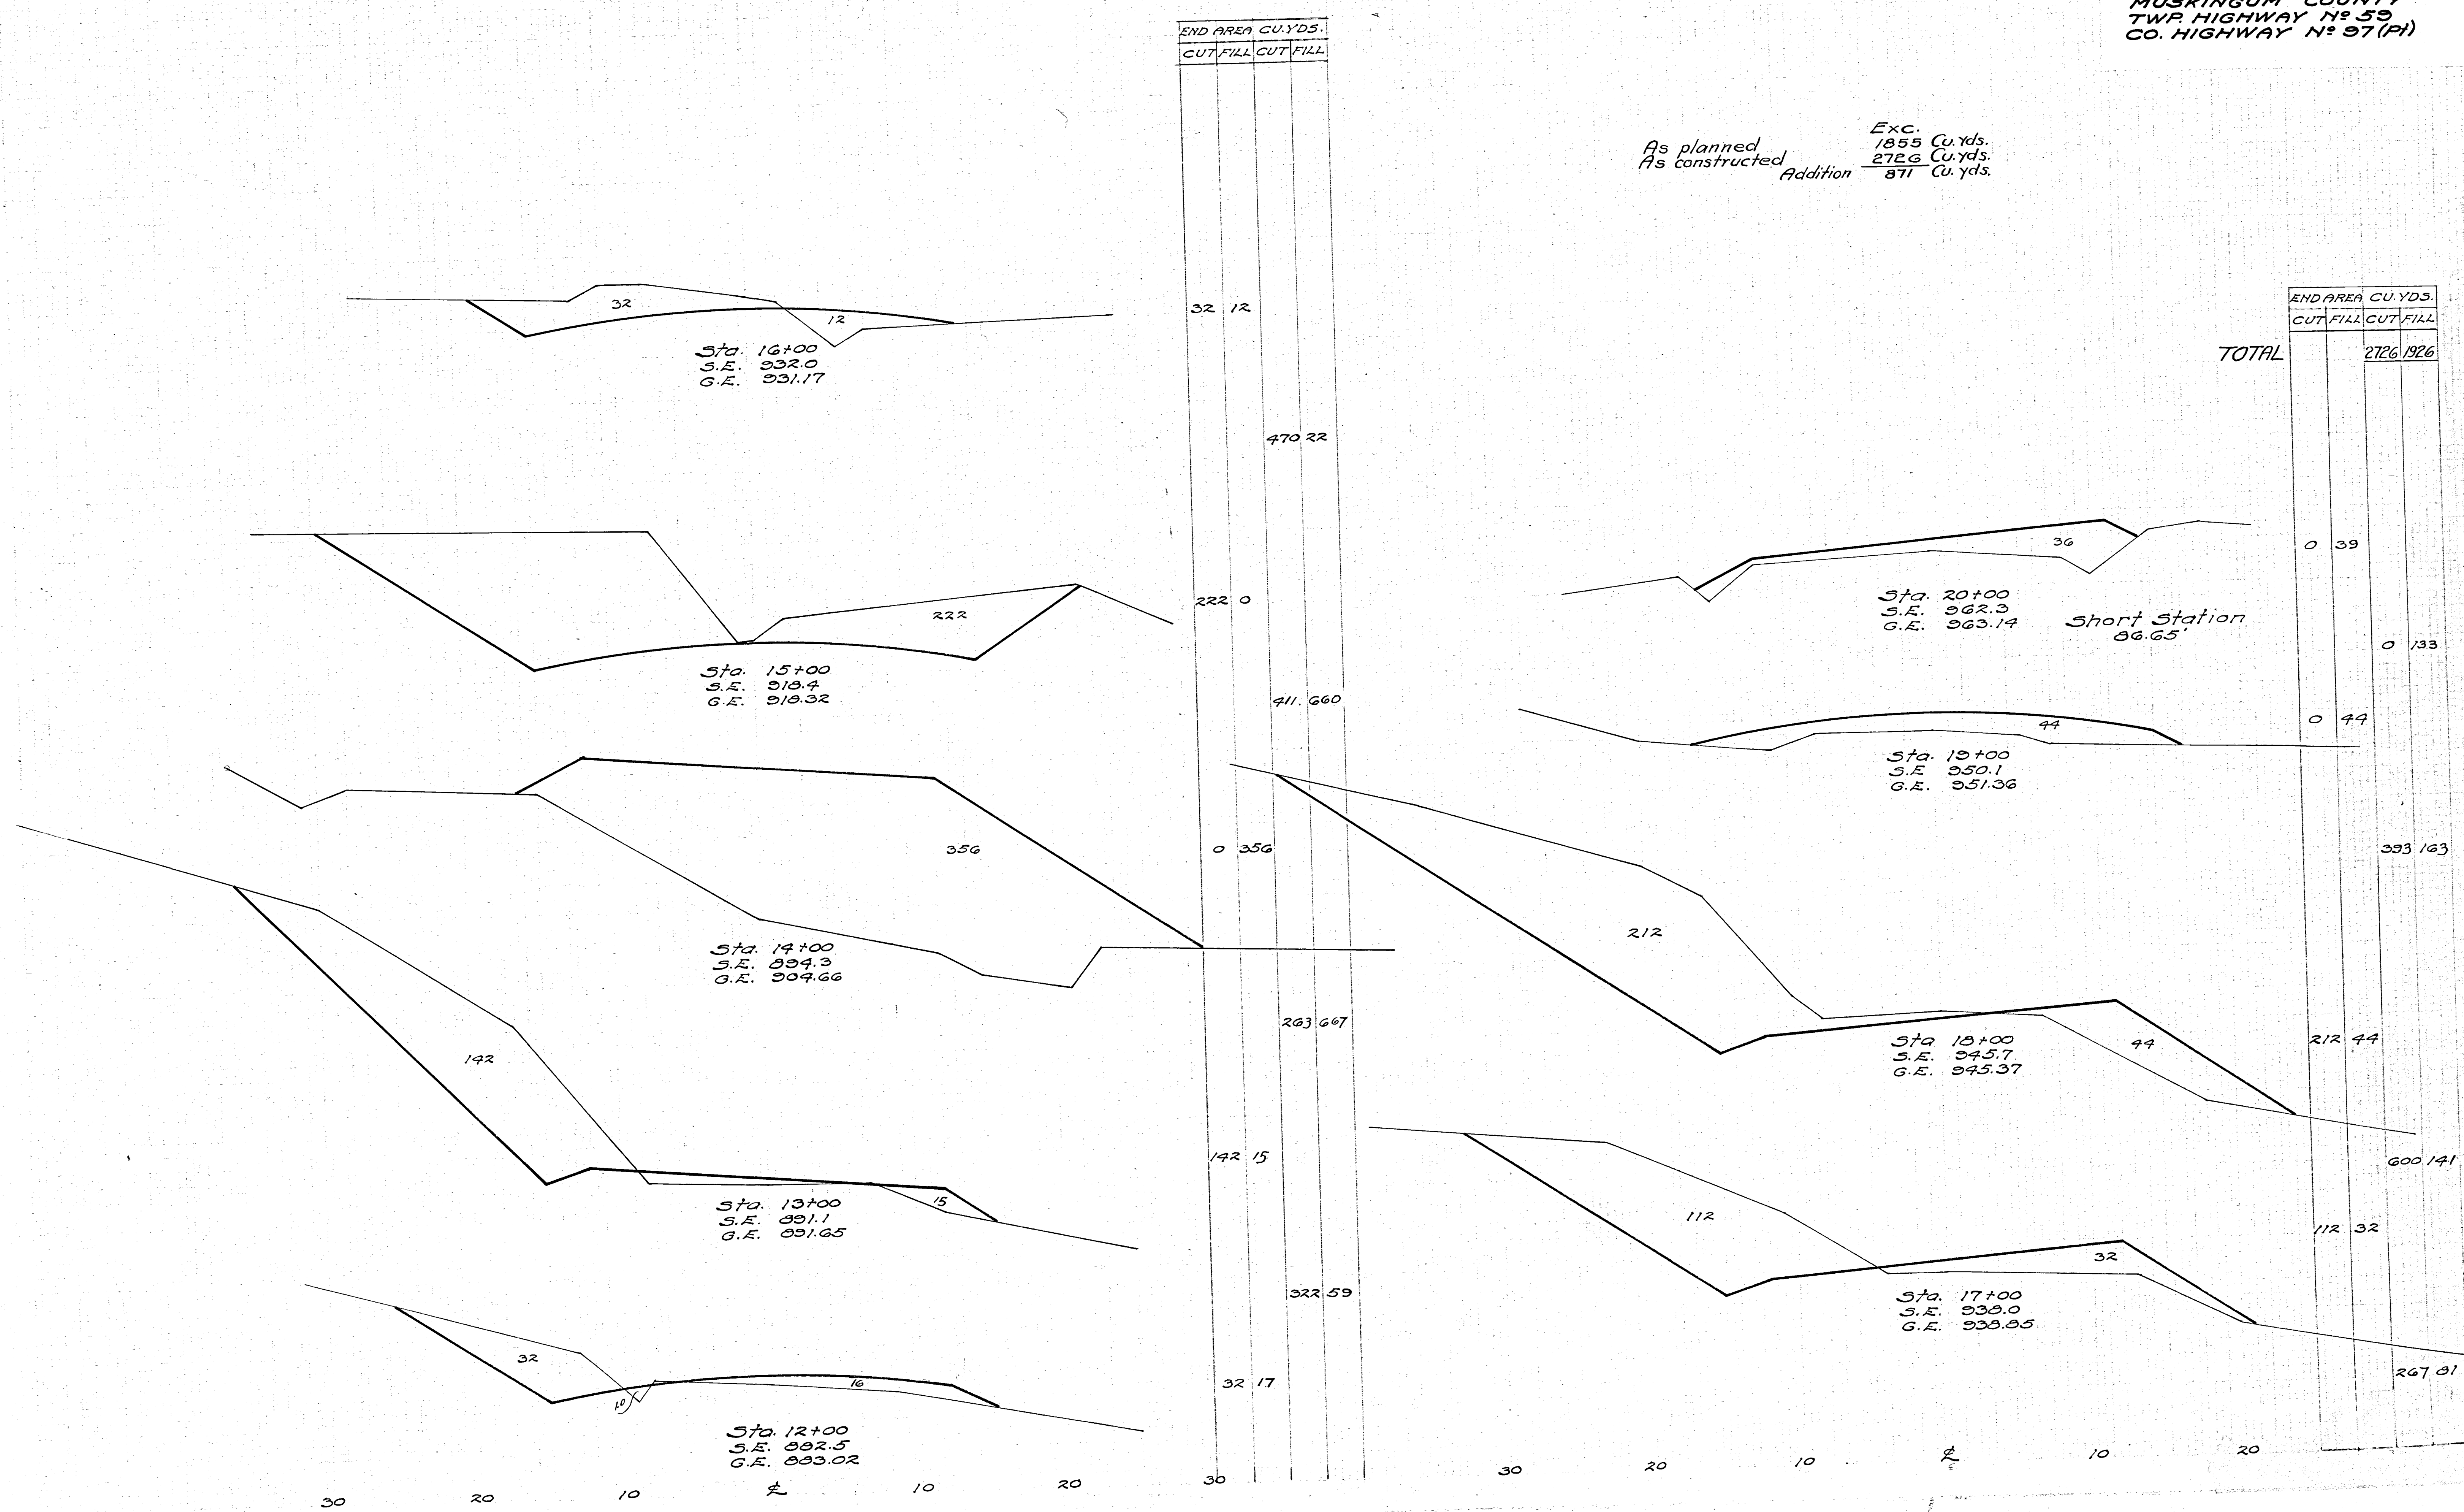

END AREA CU. YDS.	
CUT	FILL
TOTAL	
	2726 1926
0	39
0	133
0	44
393	163
212	44
600	141
112	32
267	81