

Seeding
End
Width
Sq. Yds.

43

450

38


444

42

58

Sta. 14+75

Item L-9 Seeding and Protecting
14,622 Sq. Yds.
Item L-9 Commercial Fertilizer applied
at the rate of 20 lbs/1000 Sq. Ft.
1,52 Tons

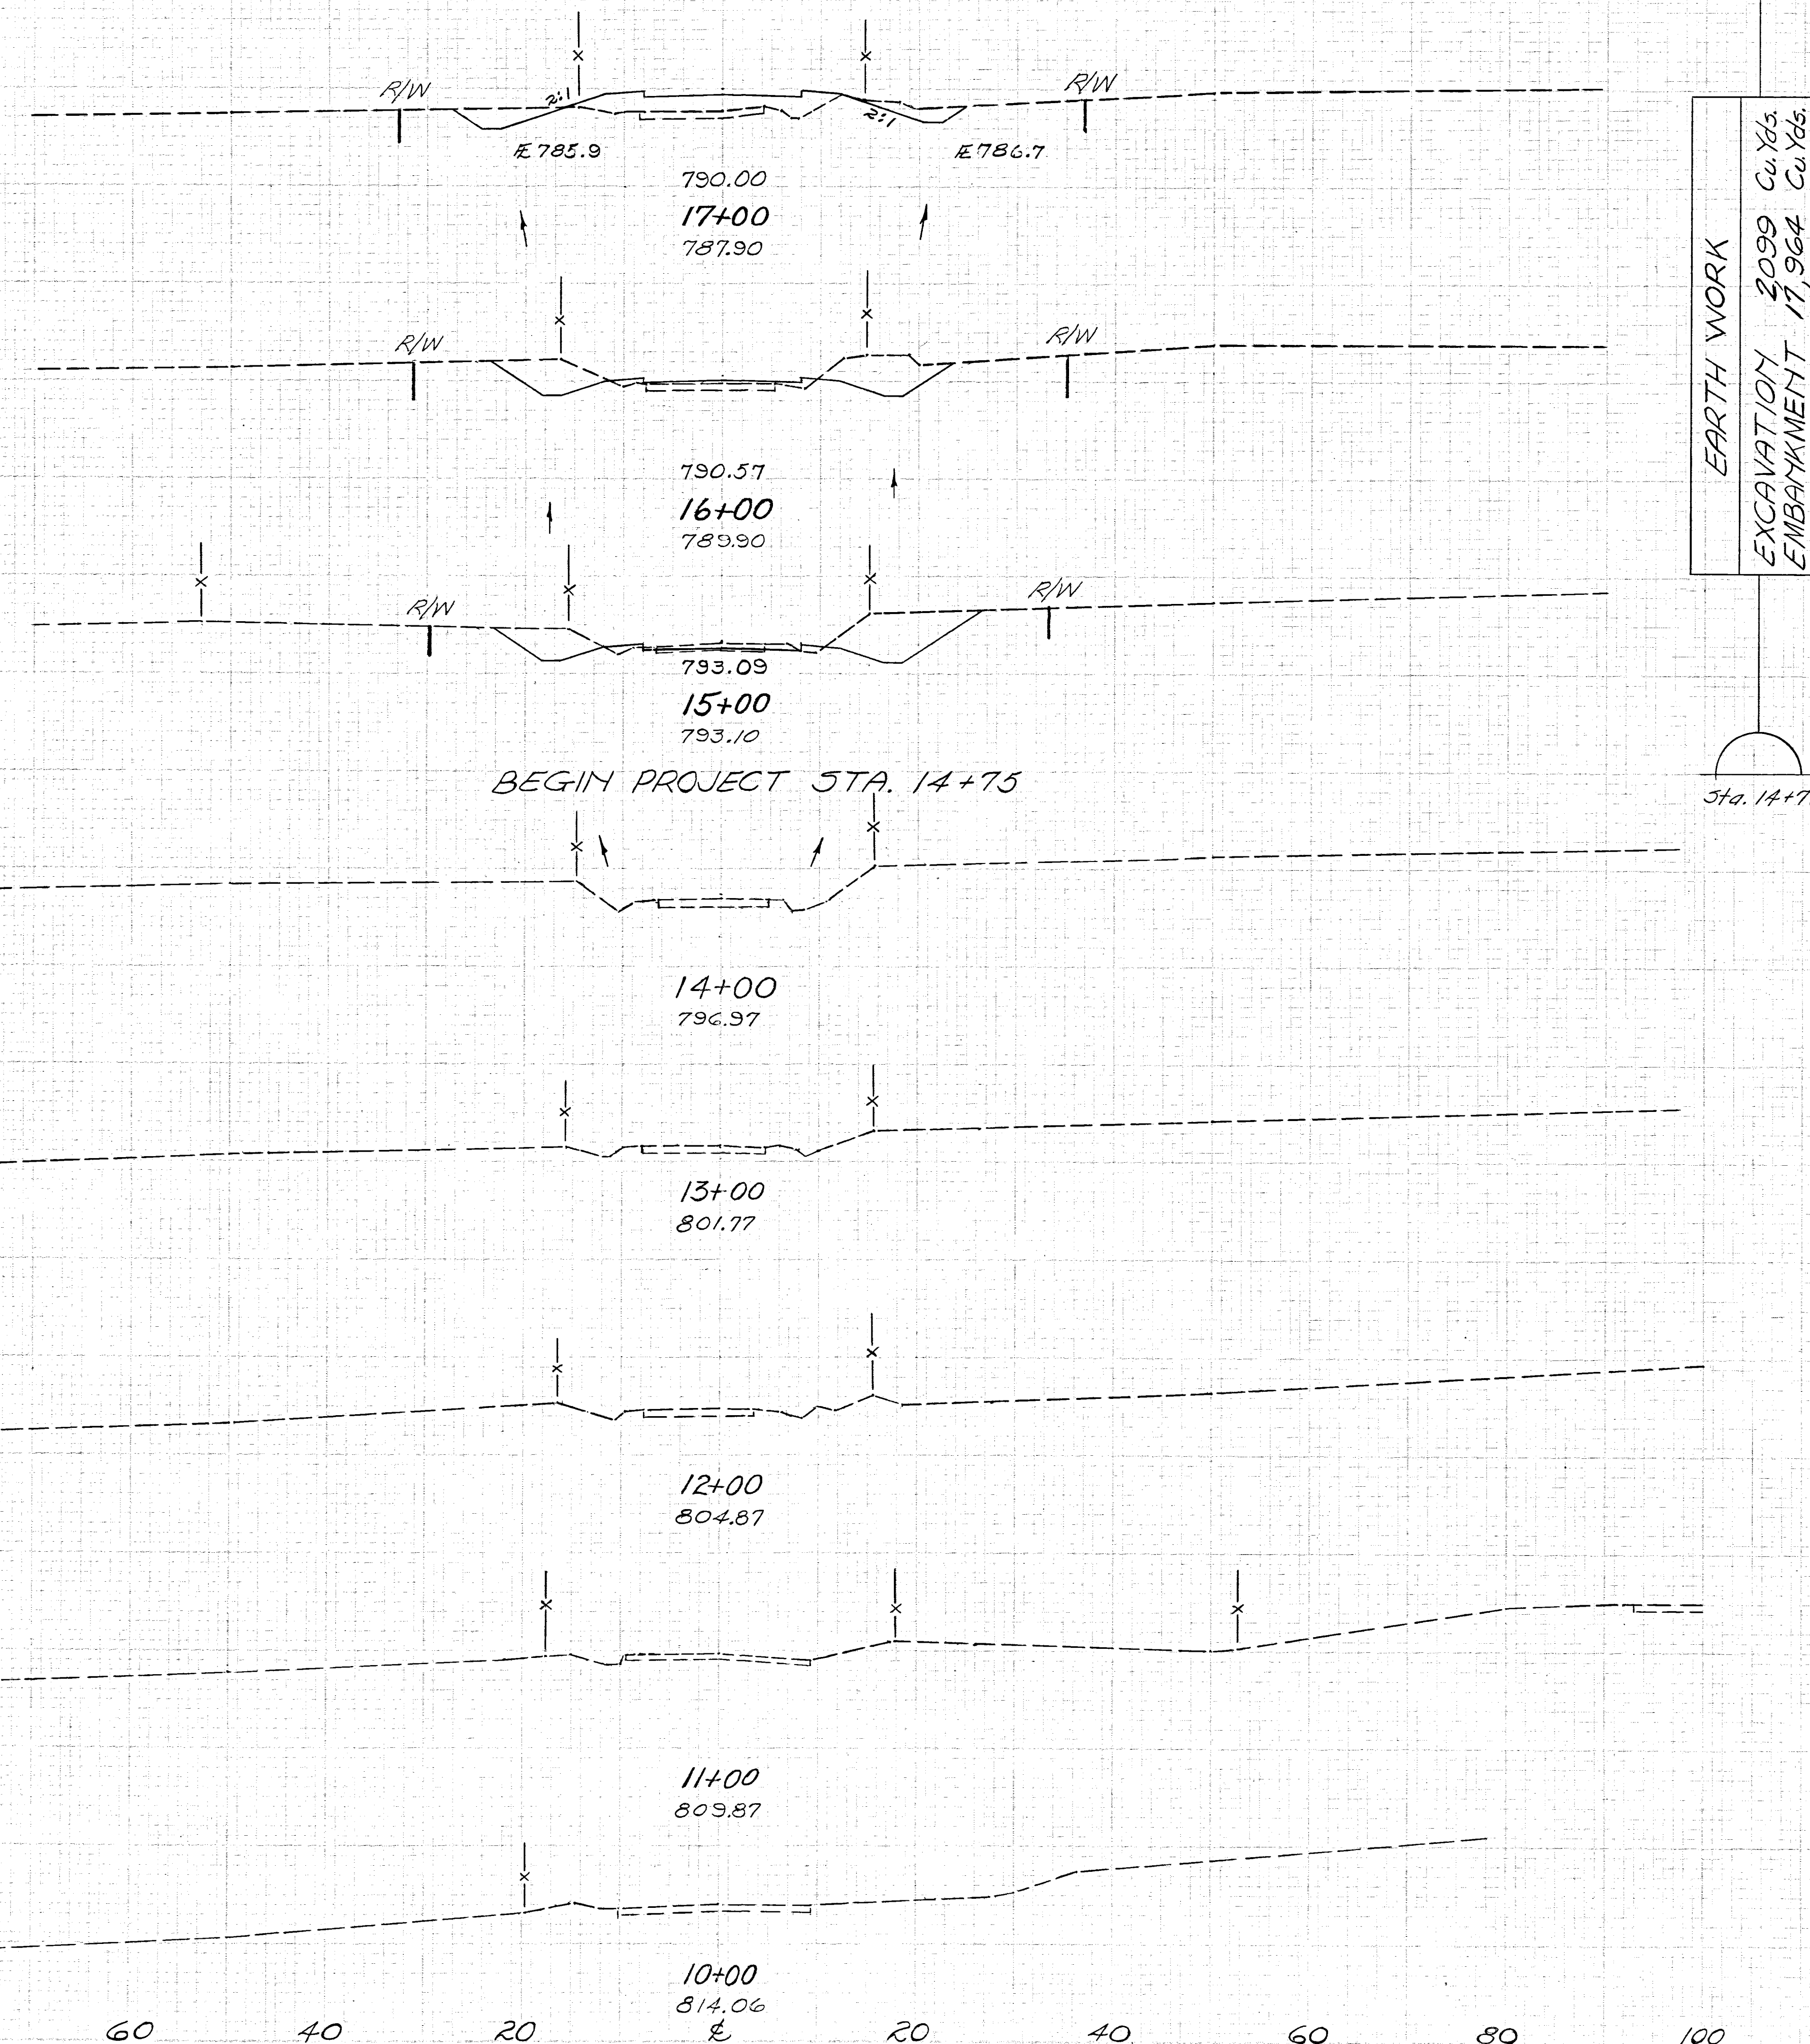

EARTH WORK
EXCAVATION 2099 Cu. Yds.
EMBANKMENT 17,964 Cu. Yds.

Sta. 14+75

End Area		Volume	
Cut	Fill	Cut	Fill
23	43		
		157	98
62	10		
		265	26
81	4		
		38	2
0	0		

MUSKINGUM COUNTY
TOWNSHIP ROAD NO. 607

REVISION	DATE	DESCRIPTION	BY
	3/23/62	A5 CONSTRUCTED	H.F.K.
U. S. ARMY ENGINEER DISTRICT, HUNTINGTON CORPS OF ENGINEERS HUNTINGTON, W. VA.			
DRAWN BY: H.I.Z.		LICKING RIVER DILLON RESERVOIR PROJECT	
TRACED BY:		READJUSTMENT OF TOWNSHIP ROAD NO. 607 (MT-607-1)	
CHECKED BY: J.E.W.		DATE: AUGUST 1959	
SUBMITTED BY: Elmer S. Barrett Associates		APPROVED: J. J. Seidman COL. C. E. DISTRICT ENGINEER	
RECOMMENDED: James J. Barrett CHIEF ENG. DIV.		ELMER S. BARRETT ASSOCIATES CONSULTING ENGINEERS CHILLICOTHE, OHIO	
SCALE: 1" = 10'		SPEC. NO. DRAWING NUMBER 027f-UD9-68//	
SHEET 11 OF 16			

WORK AS CONSTRUCTED CROSS SECTIONS ~ STA. 10+00 TO STA. 17+00