


Seeding	
End Width	Sq. Yds.
0	
175	
42	
483	
45	
511	
47	
572	
56	
644	
60	
678	
62	
66	
711	

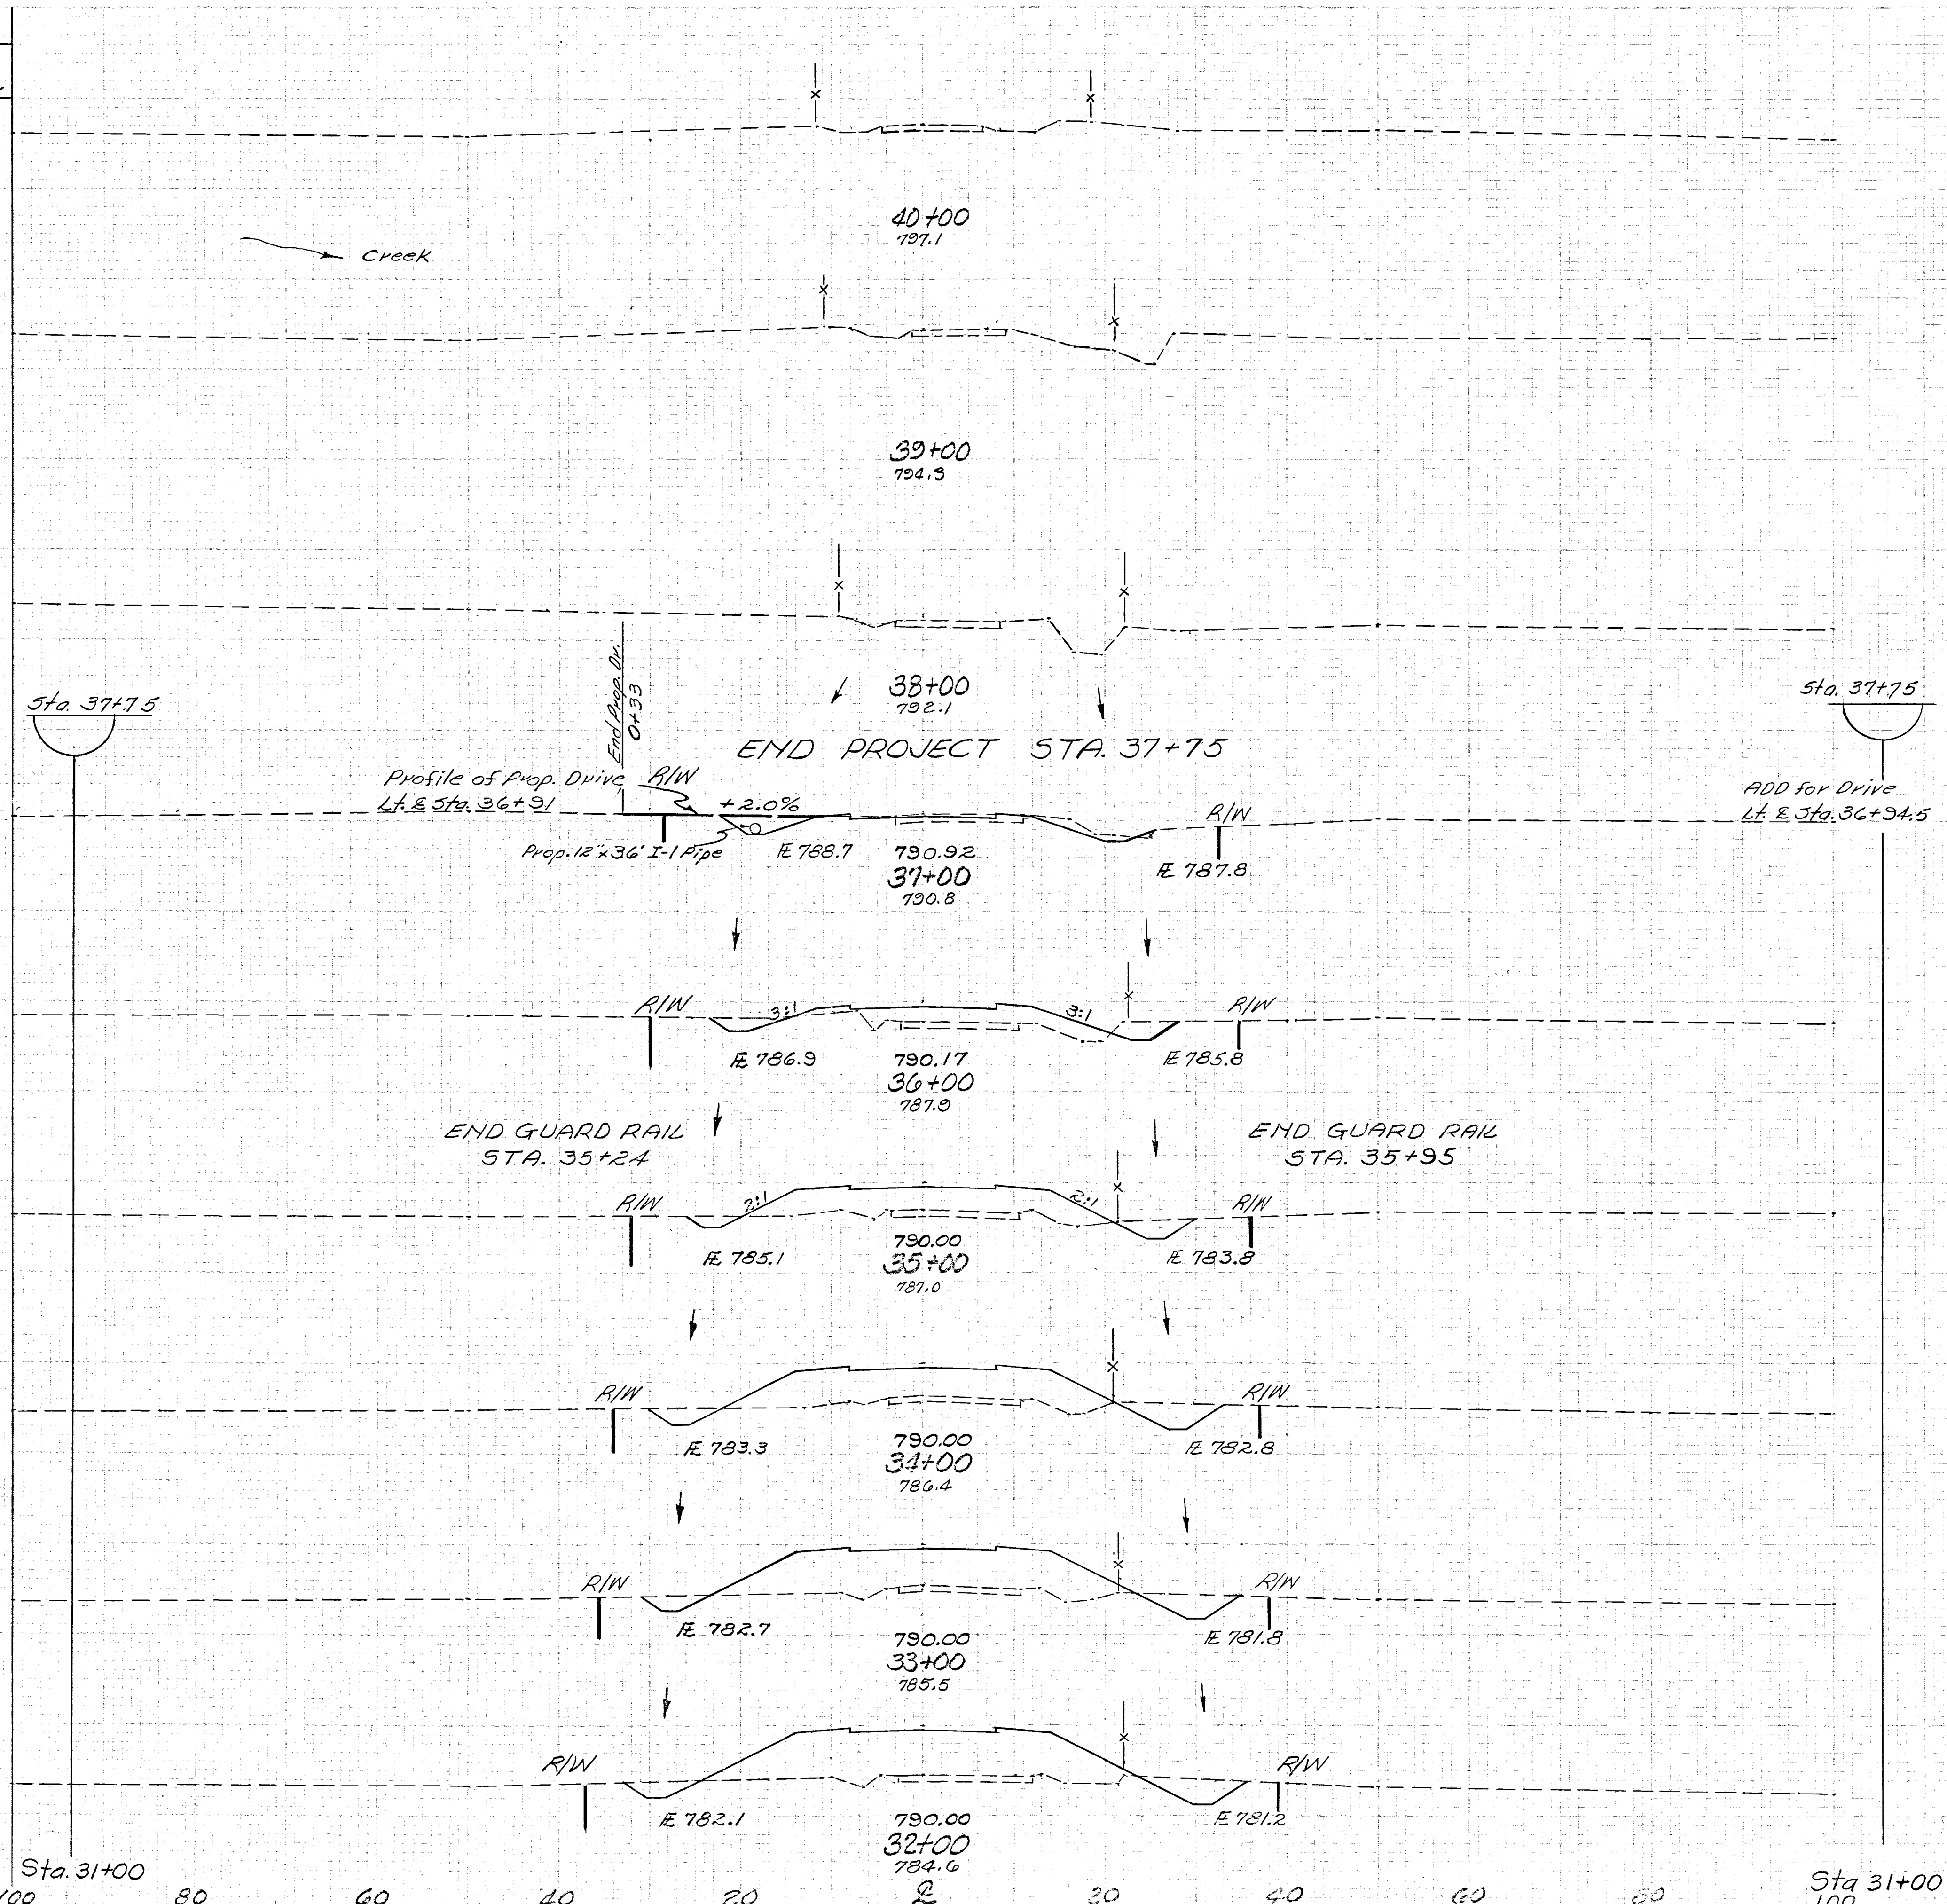

End Area		Volume	
Cut	Fill	Cut	Fill
0	0		
		38	0
27	0	0	
		95	94
24	51		
		78	281
18	101		
		93	450
32	142		
		107	583
26	173		
		104	715
30	213		
27	248	106	854

MUSKINGUM COUNTY
TOWNSHIP ROAD NO. 607

REVISION	DATE	DESCRIPTION	BY
3/23/62		AS CONSTRUCTED	H.F.K.
U. S. ARMY ENGINEER DISTRICT, HUNTINGTON CORPS OF ENGINEERS HUNTINGTON, W. VA.			
DRAWN BY: H.I.Z.		LICKING RIVER DILLON RESERVOIR PROJECT	
CHECKED BY: [Signature]		READJUSTMENT OF TOWNSHIP ROAD NO. 607	
SUBMITTED BY: [Signature]		(MT-607-1)	
RECOMMENDED: [Signature]		DATE: AUGUST 1959	
APPROVED: [Signature]		COL. C.E. DISTRICT ENGINEER	
ELMER S. BARRETT ASSOCIATES CONSULTING ENGINEERS CHILLICOTHE, OHIO		SCALE: 1" = 10' DRAWING NUMBER 0271-UD9-68/14 SHEET 14 of 16	

WORK AS CONSTRUCTED CROSS SECTIONS - STA. 32+00 TO STA. 40+00