

Survey of Crooked Creek Cemetery

Being a part of land located in the State of Ohio, Muskingum County, Union Township, part of the southwest quarter of Section 10, part of the northeast quarter of Section 9, part of the southeast quarter of Section 9, Township 1 North, Range 5 West, United States Military District.

Being all of the lands conveyed to the Trustees of the Crooked Creek Cemetery Association, in Deed Record "F", page 53 and Deed Record 132, page 366, bounded and described as follows:

Beginning at an iron pipe found at the southeast corner of the northeast quarter of Section 9, Township 1 North, Range 5 West, being the southwest corner of Roger L. Hayes and William D. Hayes (DR 922-334);

thence along the south line of Roger L. Hayes and William D. Hayes (DR 922-334), also being the north line of the southwest quarter of Section 10 and a line of the Crooked Creek Cemetery (DR 132-366) South 87 degrees 58 minutes 43 seconds East 132.00 feet to an iron pin set;

thence leaving the south line of Roger L. Hayes and William D. Hayes (DR 922-334), also being the north line of the southwest quarter of Section 10 and along a line of the Crooked Creek Cemetery (DR 132-366, parcel #2) South 01 degrees 54 minutes 52 seconds West 396.00 feet to an iron pin set;

thence along another line of the Crooked Creek Cemetery (DR 132-366, parcel #2) North 87 degrees 58 minutes 43 seconds West 132.00 feet to an iron pin set on the east line of Section 9;

thence along another line of the Crooked Creek Cemetery (DR "F", pg. 53) and along Alan G. Horner and Anita L. Horner (OR 1687-966) North 87 degrees 41 minutes 20 seconds West 231.00 feet to an iron pin set;

thence along another line of the Crooked Creek Cemetery (DR "F", pg. 53) and Alan G. Horner and Anita L. Horner (OR 1687-966) North 01 degrees 54 minutes 52 seconds East 396.00 feet to an iron pin set on the north line of the southeast quarter of Section 9;

thence along the north line of the southeast quarter of Section 9 also being the north line of Alan G. Horner and Anita L. Horner (OR 1687-966) and a line of the Crooked Creek Cemetery (DR 132-366, parcel #1) North 87 degrees 41 minutes 20 seconds West 297.00 feet to a point in a creek, being the southeast corner of James R. Sturtz (OR 1102-137);

thence leaving the north line of the southeast quarter of Section 9 also being the north line of Alan G. Horner and Anita L. Horner (OR 1687-966) and along a line of

James R. Sturtz (OR 1102-137) North 15 degrees 33 minutes 47 seconds West 18.94 feet to a point, an iron pipe found bearing North 74 degrees 46 minutes 03 seconds East 0.20 feet;

thence continuing along a line of James R. Sturtz (OR 1102-137) North 15 degrees 33 minutes 47 seconds West 145.70 feet to an iron pipe found on a line of the New Concord Bible Church, Inc. (DR 892-115);

thence leaving the line of James R. Sturtz (OR 1102-137) and along the New Concord Bible Church, Inc. (DR 892-115) North 63 degrees 16 minutes 20 seconds East 230.87 feet to an iron pipe found;

thence along another line of New Concord Bible Church, Inc. (DR 892-115) South 86 degrees 58 minutes 03 seconds East 373.18 feet to an iron pipe found beside an existing stone on the east line of Section 9;

thence leaving the New Concord Bible Church, Inc. (DR 892-115) and along the east line of Section 9 South 01 degrees 32 minutes 42 seconds West 264.08 feet to the place of beginning containing 6.49 acres, more or less,

NOTES:

Access to the Crooked Creek Cemetery is across the drive along the northeast line of James R. Sturtz (OR 1102-137) property.


All of Parcel No.:	66-66-20-09-27-000	(± 3.19 acres)
All of Parcel No.:	66-66-20-09-28-000	(± 2.10 acres)
All of Parcel No.:	66-66-20-10-29-000	(± 1.20 acres)
TOTAL		6.49 ACRES

SWIERZ

Iron pins set are 5/8 inch rebar 30 inches long with identification caps ("MUSK CTY" "SWIERZ 8062"). This legal description was written by Denis P. Swierz based on a field survey completed November 2007 by Muskingum County Engineers' Office. The bearings in this description are based on NAD 83, Ohio South Zone, State Plane coordinates as per GPS Observations from Muskingum County Engineer GPS monument - GPS 88.

Subject to all easements, right of ways, restrictions, reservations, etc.. of record

and those that may be implied.

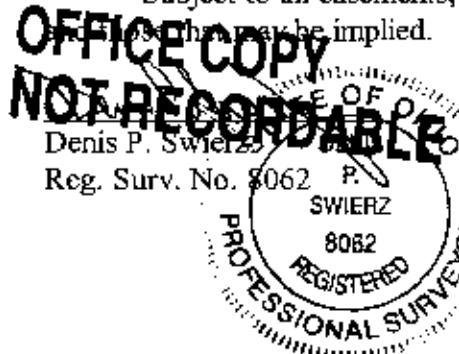

12/03/07
Date

APPROVED FOR CLOSURE
[Signature] 12/19/07

EXEMPT FROM
PLANNING COMMISSION
[Signature] 12/19/07

§

NEW CONCORD BIBLE CHURCH, INC. APPROVED FOR CLOSURE
DR 892-115

~~APPROVED FOR CLOSURE~~

N 63°16'20"
230.87 FT

PARCEL #: 66-20-09-27-000
3.19 ACRES
DR 132-366

SOUTHEAST CORNER OF THE
NORTHEAST QUARTER OF
SECTION 9, T 1 N., R 5 W.

P.O.B.

EXEMPT FROM
PLANNING COMMISSION

DETAIL NOT
TO SCALE

~~N 15.35 F1~~
145.70 F1

N 74°46'03" E
0.20 FT
N 15°33'47" W
18.94 FT

PARCEL NO.

ALL OF: 66-66-20-09-27-000	±3.19 ACRES
ALL OF: 66-66-20-09-28-000	±2.10 ACRES
ALL OF: 66-66-20-10-29-000	±1.20 ACRES
TOTAL	+6.49 ACRES

**MUSKINGUM COUNTY
ENGINEERS OFFICE**

155 REHL ROAD
ZANESVILLE, OHIO 43701
(740) 454-0155

ALAN G. HORNER & ANITA L. HORNER
DR 1687-966

ALAN G. HORNER & ANITA L. HORNER
DR 1687-966

DUANE JAMES BARNES &
LEESA SOUTO
DR 2085-259

I HEREBY CERTIFY THIS PLAT
TO BE CORRECT AS SURVEYED
NOVEMBER 2007

$$100 \quad 0 \quad 100$$


Scale: 1" = 100'

LEGEND

- IRON PIN SET $\frac{5}{8}$ " X 30" W/CAP
MARKED "MUSK CTY"
"SWIERZ 8062"
- IRON PIN FOUND
- IRON PIPE FOUND
- POINT

NOTE:
REFERENCE FOR RIGHT-OF-WAY TO CEMETERY
FOUND IN DEED VOLUME 274. PAGE 305-307.

BASIS OF BEARING:

BEARINGS ARE BASED ON NAD 83, OHIO SOUTH
ZONE, STATE PLANE COORDINATES AS PER GPS
OBSERVATIONS FROM MUSKINGUM COUNTY
ENGINEER GPS MONUMENT - GPS 88.

PERTINENT DOCUMENTS AND SURVEYS USED:

1. DEED REFERENCES SHOWN
2. TAX MAPS
3. SURVEY RECORDS FOUND IN THE
MUSKINGUM COUNTY ENGINEERS OFFICE,
ZANESVILLE, OHIO.

STATE OF OHIO
DENIS
P.
SWIERZ
8062

**OFFICE COPY
NOT RECORD**

DENIS P. SWIERZ
PS# 8062

DATE 12/03/07