

**Michelle Wilson**

Situated in the State of Ohio, County of Muskingum, City of Zanesville, Township 16,  
Range 14; bounded and described as follows:

Being all of Michelle Wilson Volume 1035, page 363, Parcel NO. 80-83-19-01-05-000.  
Being part of Lot 28 of Cliff Wood Addition to Zanesville Plat Book 1, page 98.499  
+29

Commencing at the Northeast corner of Lot 28; (Intersection of Prospect Avenue and  
Oak ~~Street~~ <sup>Ave</sup>) Thence South 21°10'00" East along Oak ~~Street~~ <sup>Ave</sup> 48.00 feet to an iron pin set  
the place of beginning; Thence continuing South 21°10'00" East along Oak ~~Street~~ <sup>Ave</sup> 48.00  
feet to an iron pin set; Thence leaving Oak ~~Street~~ <sup>Ave</sup> South 59°44'58" West along C. Tabler  
Volume 969, page 351 133.75 feet to an iron pin set on the East line of a ~~private~~ <sup>private</sup> Alley  
Thence North 02°15'00" East along said alley 19.80 feet to an iron pin set; Thence  
leaving alley North 46°31'51" East along E.M. Norris Volume 770, page 60 134.25 feet  
to the place of beginning containing 0.09 Acres more or less.



Bearings are based on the North line of Lot 28 bearing South <sup>88°50'00"</sup> ~~88°50'00"~~ East.

Above description is based on a survey by R.L. Daniels, Registered Surveyor NO. 5410,  
October 28, 2004, and is intended for the legal transfer of property described and does  
not intend to describe all or any easements of record nor encroachments unless otherwise  
indicated.

Iron pins set are NO. 5 reinforced bars 30 inches long with plastic ID caps.

Reference: Volume 1035, page 363

**OFFICE COPY  
NOT RECORDABLE**

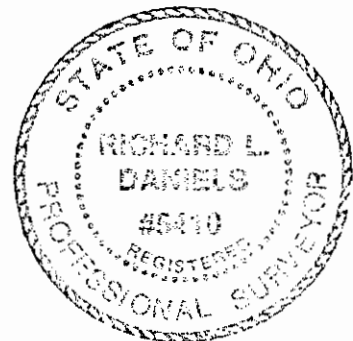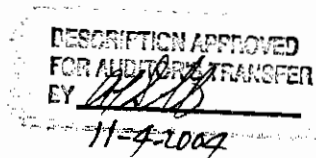


PROSPECT AVE. 49.5'




1" = 40'

- IRON PIN SET
- IRON PIN FOUND

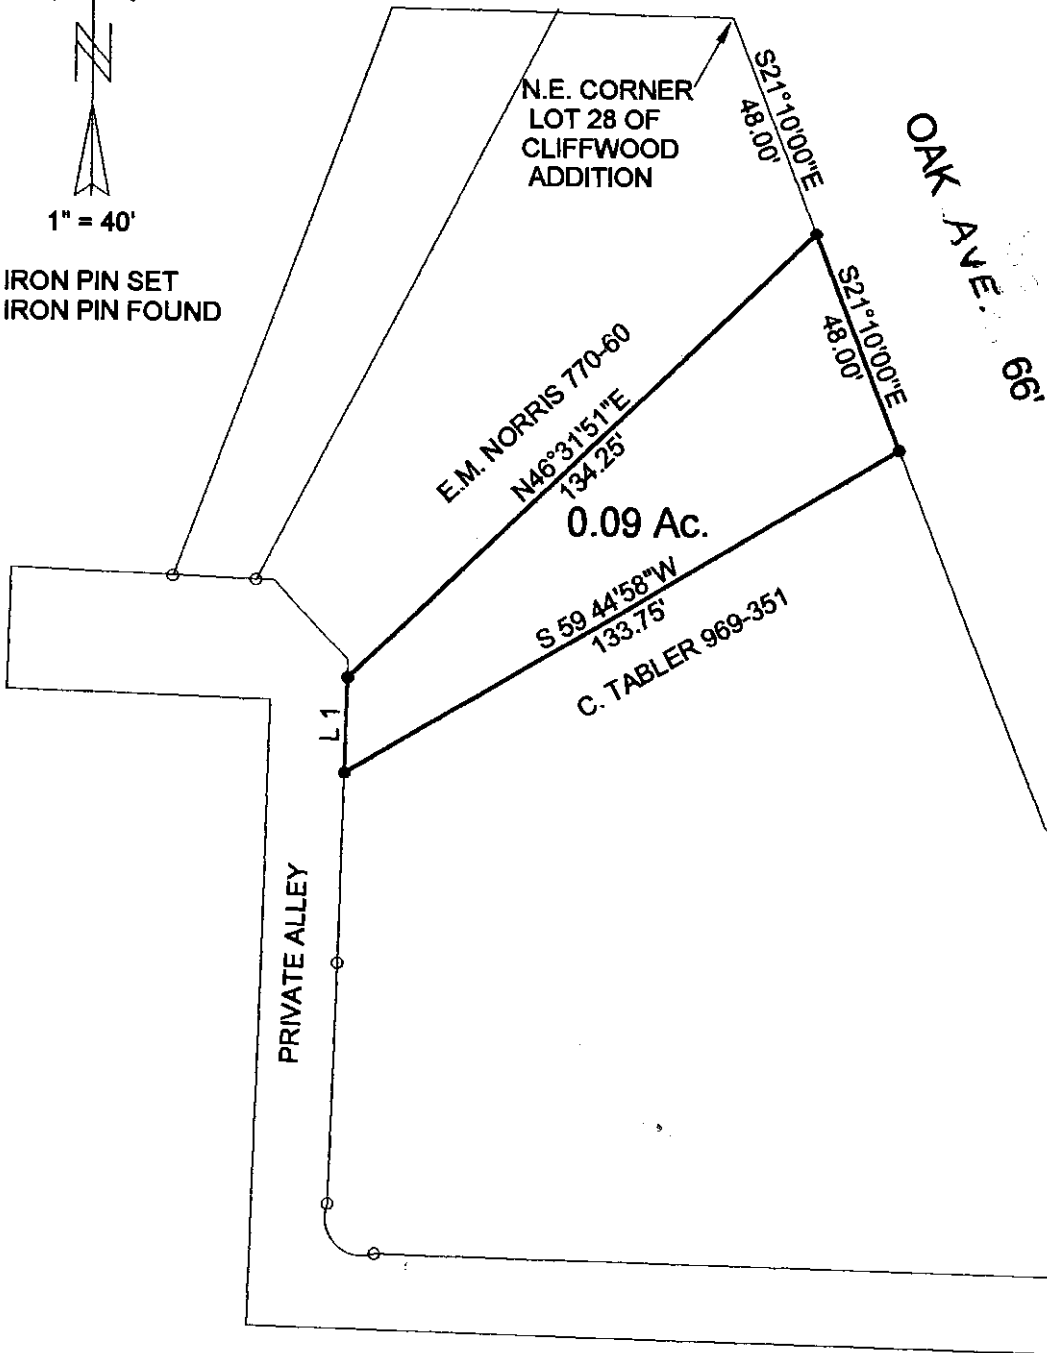

| Line | Bearing    | Distance |
|------|------------|----------|
| 1    | N2°15'00"E | 19.80'   |

DESCRIPTION APPROVED  
FOR AND TO BE TRANSFER  
BY [Signature]  
11-4-2002

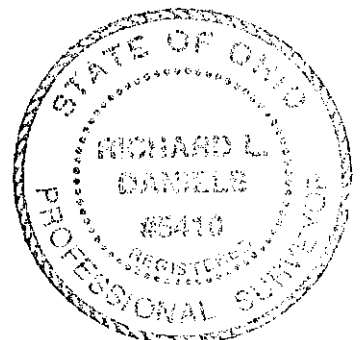

MICHELLE WILSON

ALL OF PARCEL No. 80-83-19-01-05-000  
DEED VOL. 1035, PG. 363  
Part of Lot 28, of Cliffwood Addition to  
Zanesville. Plat Book 1, Pg 193-199  
State of Ohio, Muskingum County, City of  
Zanesville

OFFICE COPY  
NOT RECORDABLE  
10-28-04 Reg. Surv. 5410