


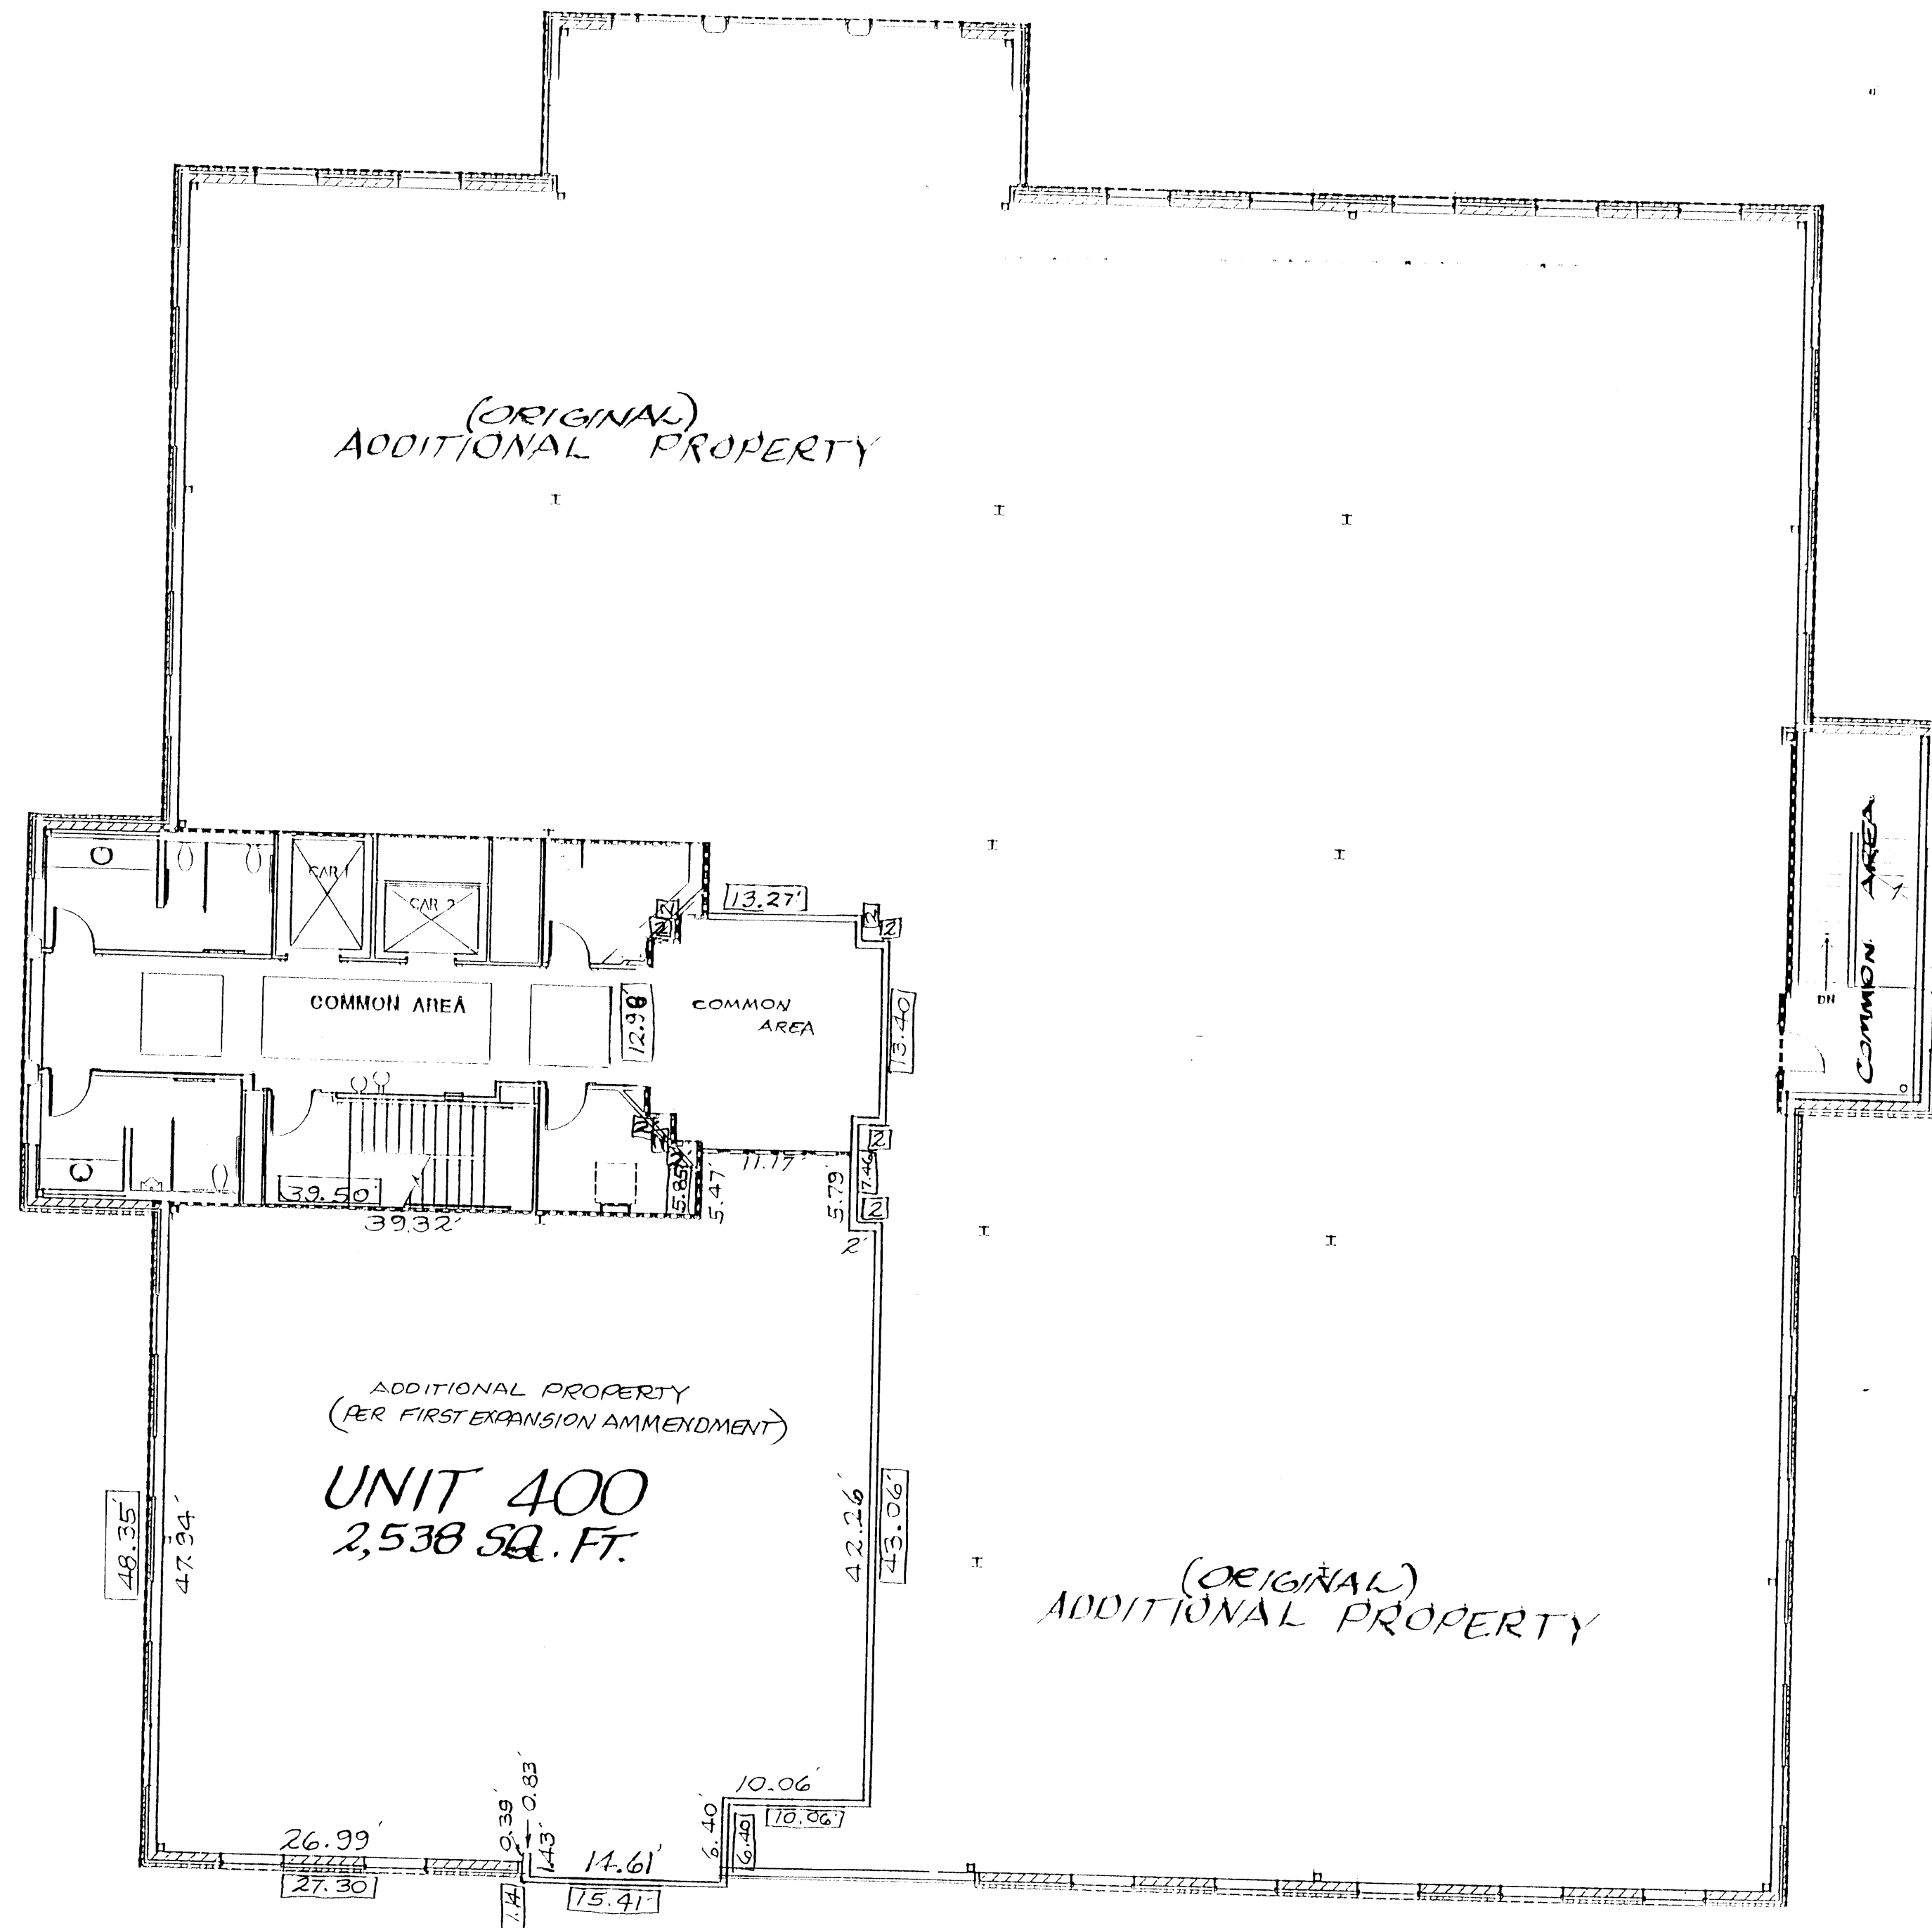

NOTES: FOR DIMENSIONS OF THE ORIGINAL CONDOMINIUM PROPERTY
SEE EXHIBIT "C" RECORDED IN PLAT BOOK 17, PAGES 711RU 13

DIMENSIONS WITH SQUARES (□) AROUND THEM ARE
THOSE THAT DESIGNATE THE NEW AREA TO BE ADDED TO
THE EXISTING CONDOMINIUM.

DIMENSIONS WITHOUT SQUARES ARE THOSE THAT
DESIGNATE THE INTERIOR PAINTED SURFACE OF UNIT 400

I HEREBY CERTIFY THAT THIS PLAT IS A CORRECT REPRESENTATION OF
A SURVEY MADE BY ME AND THAT IT CORRECTLY SHOWS ALL THE IMPROVEMENTS
AS CONSTRUCTED _____ 1999

JEFFERY W. STUBBS, ARCHITECT 7359

L. PETER DINAN REG. SURVEYOR 45451

EXHIBIT THREE
FIRST EXPANSION AMMENDMENT ADDITIONAL PROPERTY

FOURTH FLOOR
GOOD SAMARITAN MEDICAL CENTER
MEDICAL OFFICE BUILDING 2 CONDOMINIUM

REVISIONS APPROVED
DATE 4-3-98