


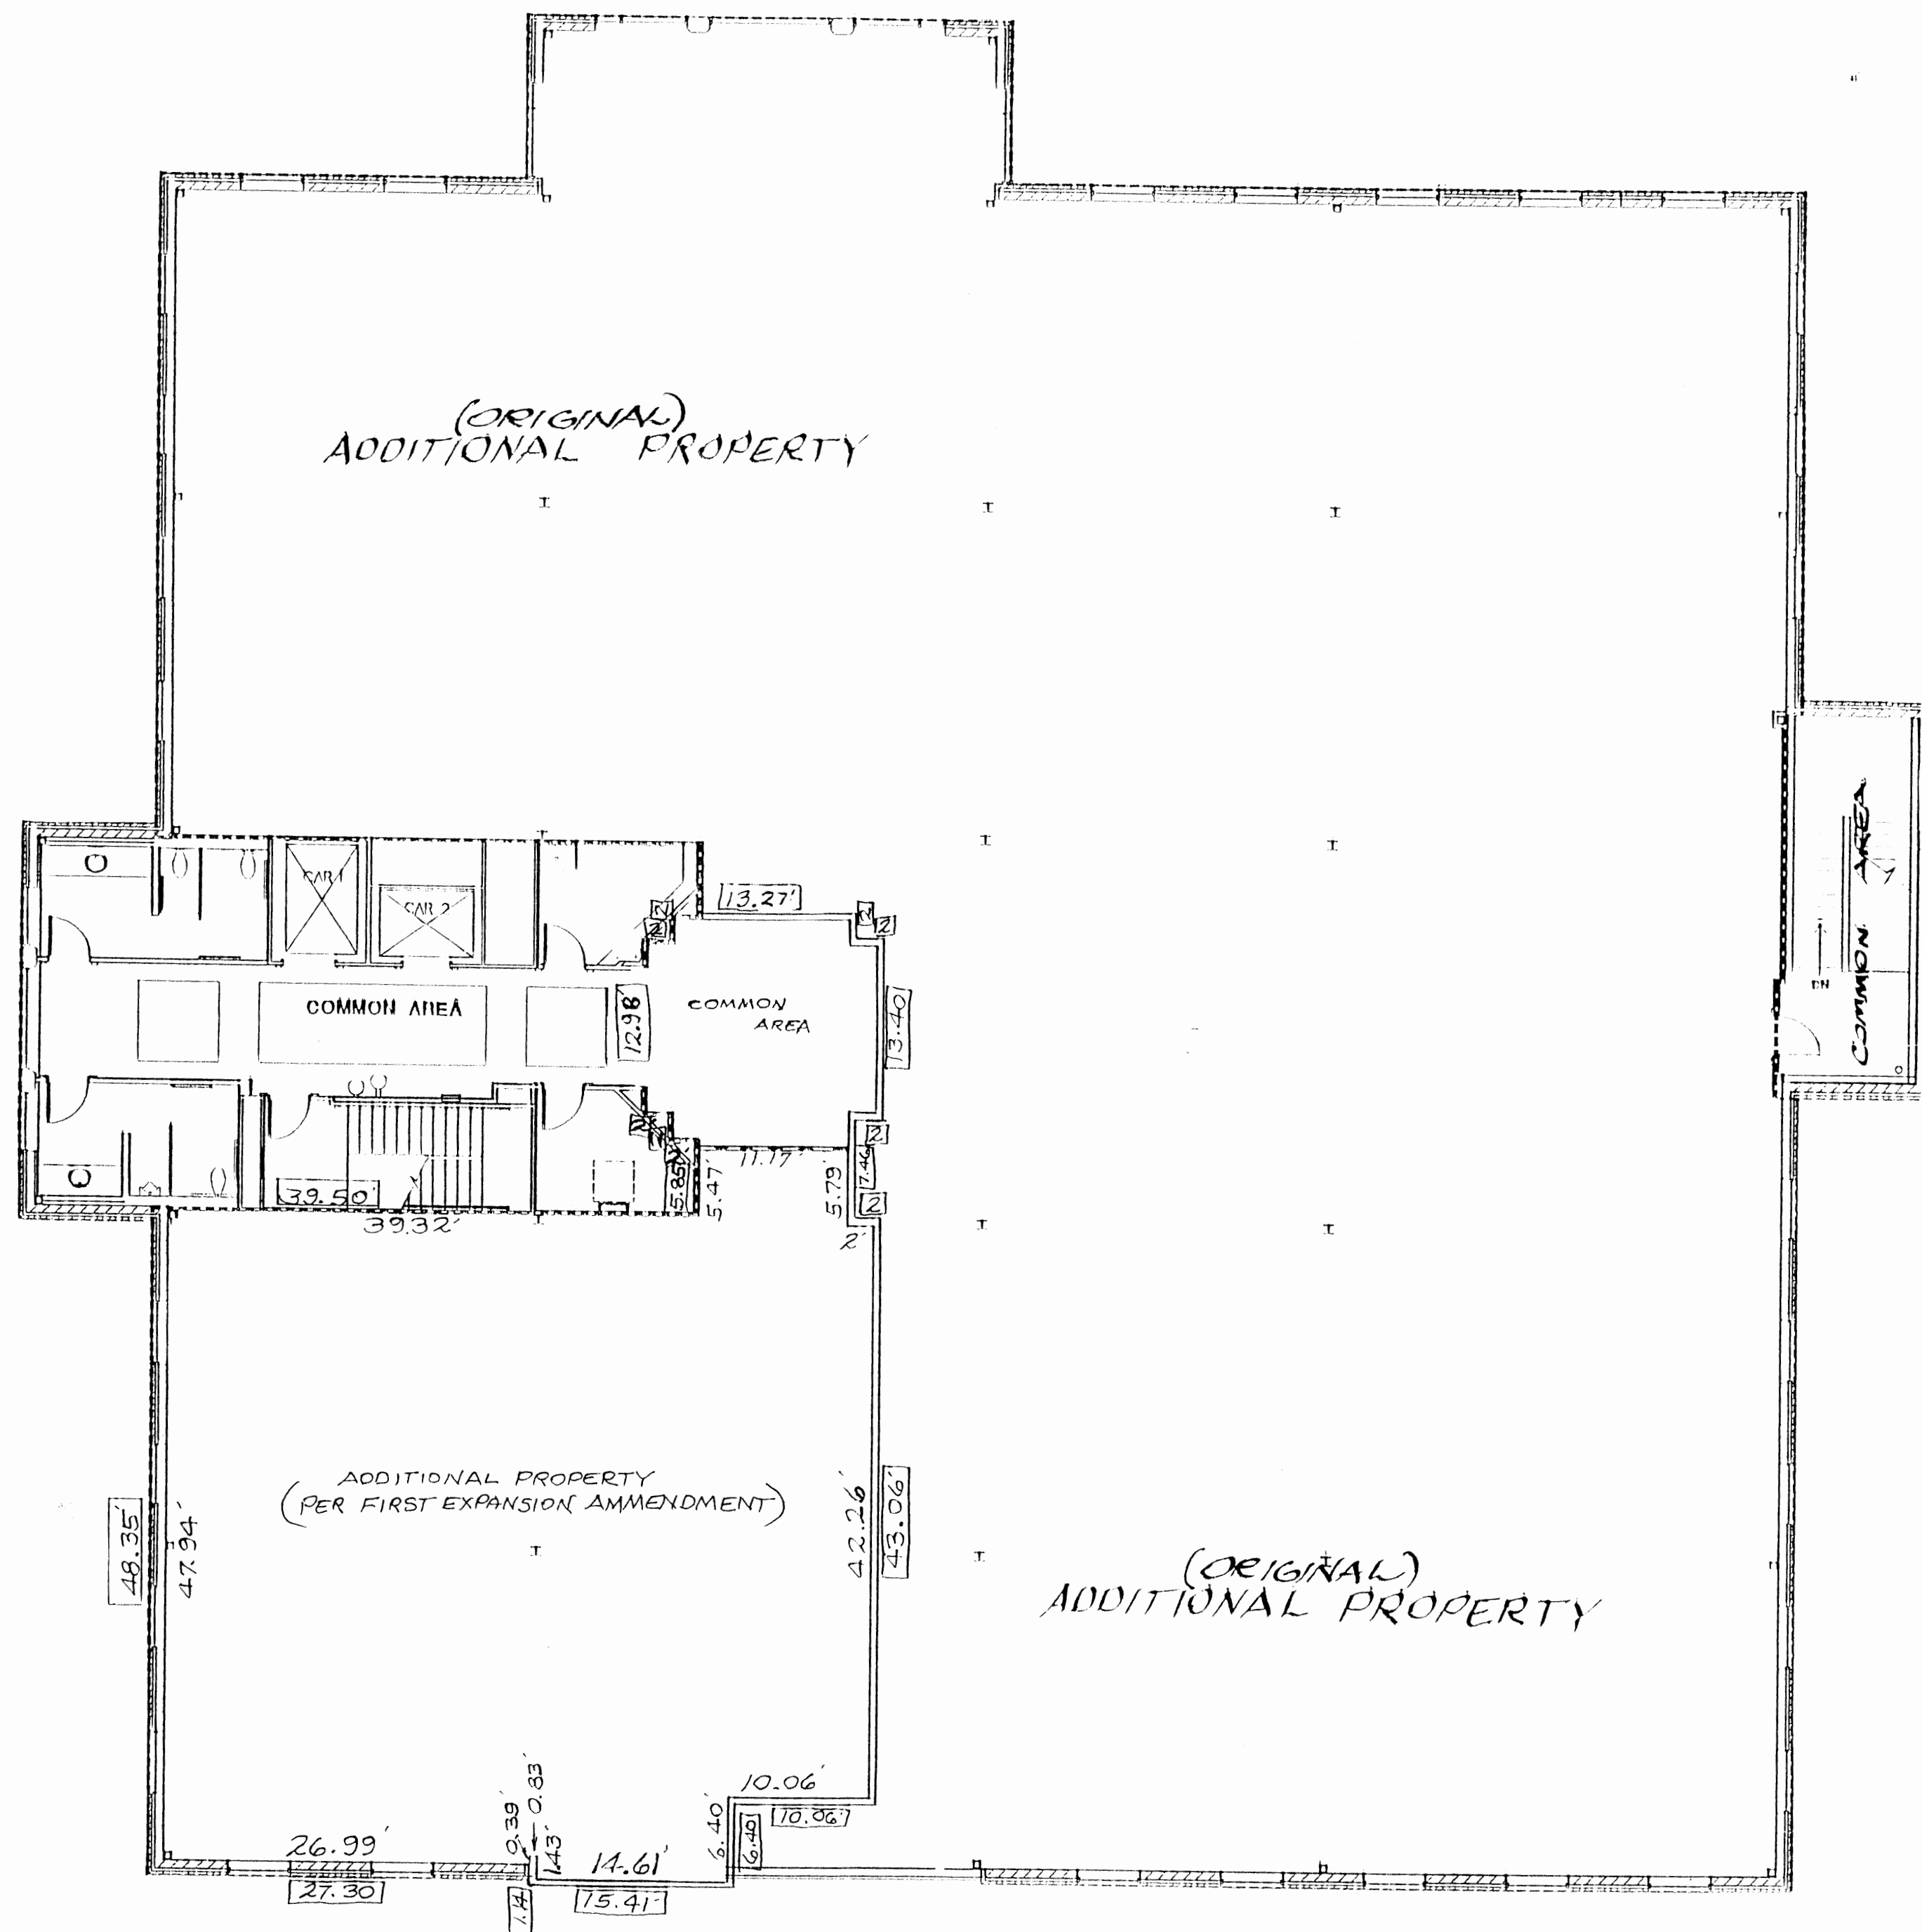

NOTES: FOR DIMENSIONS OF THE ORIGINAL CONDOMINIUM PROPERTY
SEE EXHIBIT "C" RECORDED IN PLAT BOOK 17, PAGES 7111R-13

DIMENSIONS WITH SQUARES (□) AROUND THEM ARE
THOSE THAT DESIGNATE THE NEW AREA TO BE ADDED TO
THE EXISTING CONDOMINIUM.

DIMENSIONS WITHOUT SQUARES ARE THOSE THAT
DESIGNATE THE INTERIOR PAINTED SURFACE OF UNIT 400

I HEREBY CERTIFY THAT THIS PLAT IS A CORRECT REPRESENTATION OF
A SURVEY MADE BY ME AND THAT IT CORRECTLY SHOWS ALL THE IMPROVEMENTS
AS CONSTRUCTED _____ 199

JEFFERY W. STUBBS, ARCHITECT 7359

L. PETER DINAN REG. SURVEYOR #5451

EXHIBIT TWO
FIRST EXPANSION AMMENDMENT ADDITIONAL PROPERTY

FOURTH FLOOR
GOOD SAMARITAN MEDICAL CENTER
MEDICAL OFFICE BUILDING 2 CONDOMINIUM

RECORDS SECTION
FOR AUTOMATIC REPRODUCTION
4-3-98