


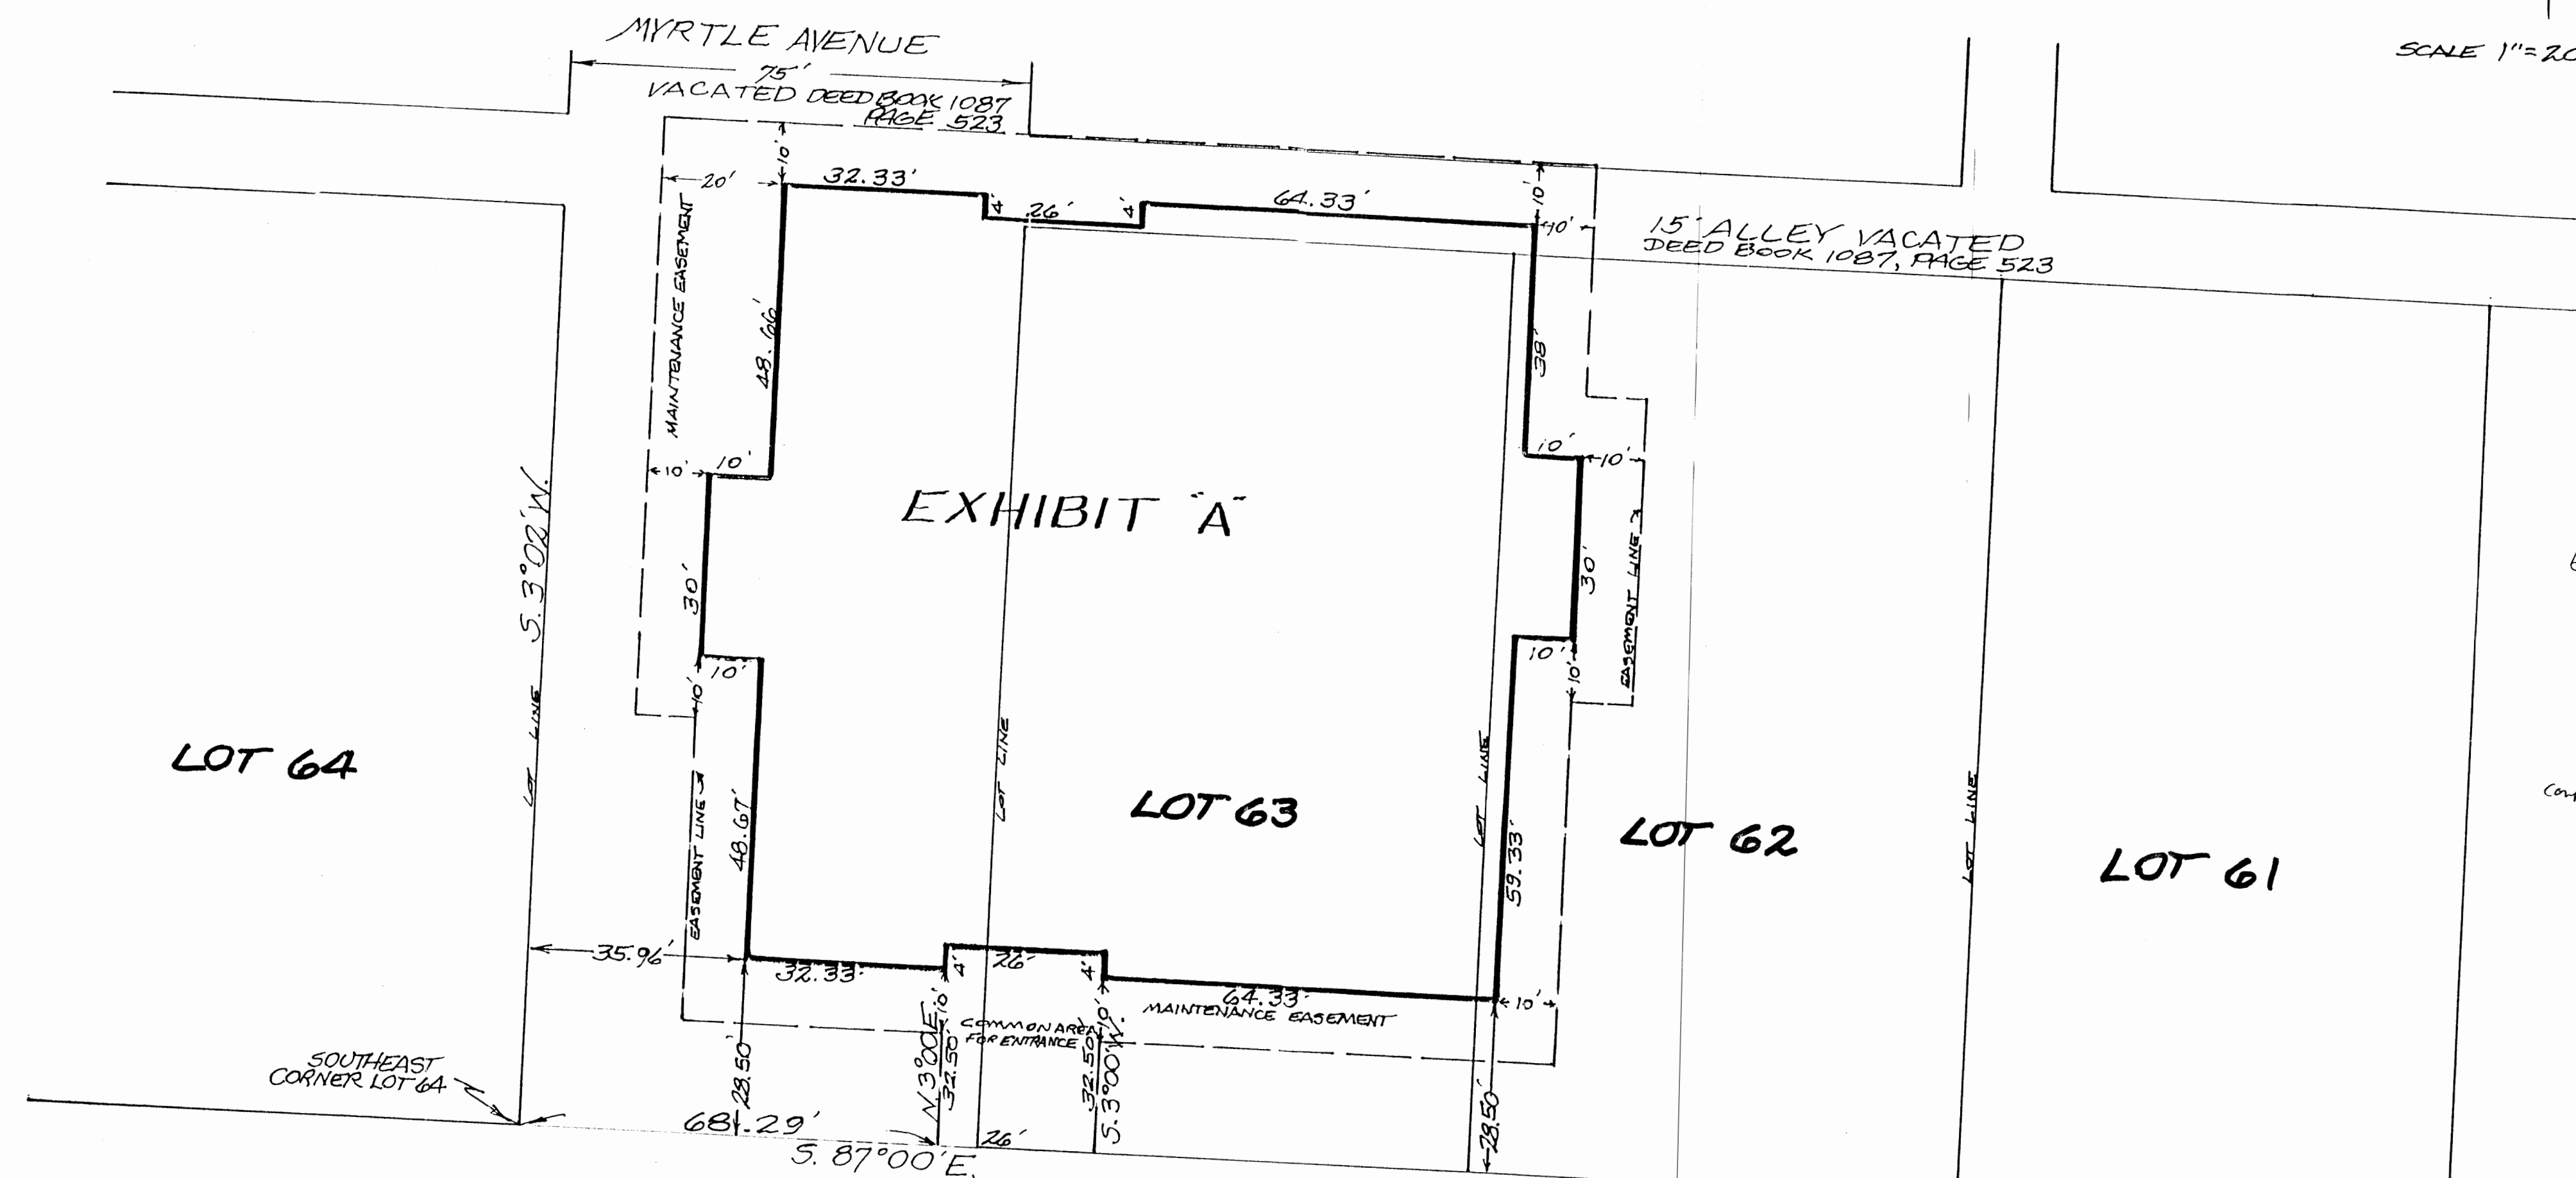

N

SCALE 1"=20'

breakdown of
ac.
in separate
plots?
comp to
.386 ac. total

DESCRIPTION APPROVED
FOR AUDITORS TRANSFER
BY 12-4-96

I HEREBY CERTIFY THAT THIS PLAT IS A CORRECT REPRESENTATION OF
A SURVEY MADE BY ME AND THAT IT CORRECTLY SHOWS ALL THE IMPROVEMENTS
AS CONSTRUCTED 1996

JEFFERY W. STUBBS, ARCHITECT 7359

L. PETER DINAN REG. SURVEYOR #5451

FOREST AVE.
75' RIGHT OF WAY

GOOD SAMARITAN MEDICAL

751 FOREST AVENUE
ZANESVILLE, OHIO