

BB-17-01-15

~~REDACTED~~ 20BU

7-10

JOHN R. MARSHALL
REGISTERED SURVEYOR
530 LONGVIEW AVENUE
ZANESVILLE, OHIO

Situated in the State of Ohio, County of Muskingum ~~REDACTED~~
of Zanesville.

Being a part of the old seventh ward new third ward, bounded
and described as follows:

Commencing at the southwest corner of lot 18 in Millwood and
recorded in plat book 1, page 227 of the plat records of said county;
thence south along the easterly right of way line of Brighton Blvd.
a distance of 180.00 feet to an existing iron pin at the true place
of beginning for the parcel herein intended to be described; thence
east along the southerly line of lands now or formerly owned by E.
Deweese and recorded in deed book 384, page 89 of the deed records of
said county a distance of 143.00 feet to an iron pin; thence south
a distance of 40.00 feet to an iron pin; thence west along the northerly
line of lands now or formerly owned by I.A. and B.J. Baum and recorded
in deed book 812, page 247 of the deed records of said county a distance
of 143.00 feet to a point; thence north along said right of way line
a distance of 40.00 feet to the true place of beginning, containing
Thirteen (0.13) hundredths acres more or less;

This description was written April 10, 1985 by John R. Marshall
registered surveyor no. 5307.


OK YAD
4-22-85

DATE: APRIL 10, 1985


OFFICE COPY
NOT RECORDABLE
REG. 5307

Richard Lson

JOHN R. MARSHALL
REG. SURVEYOR
530 LONGVIEW AVE.
ZANESVILLE, OHIO

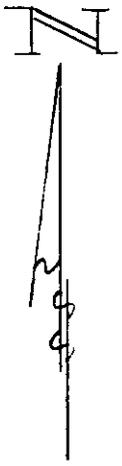

SCALE: 1"=30'

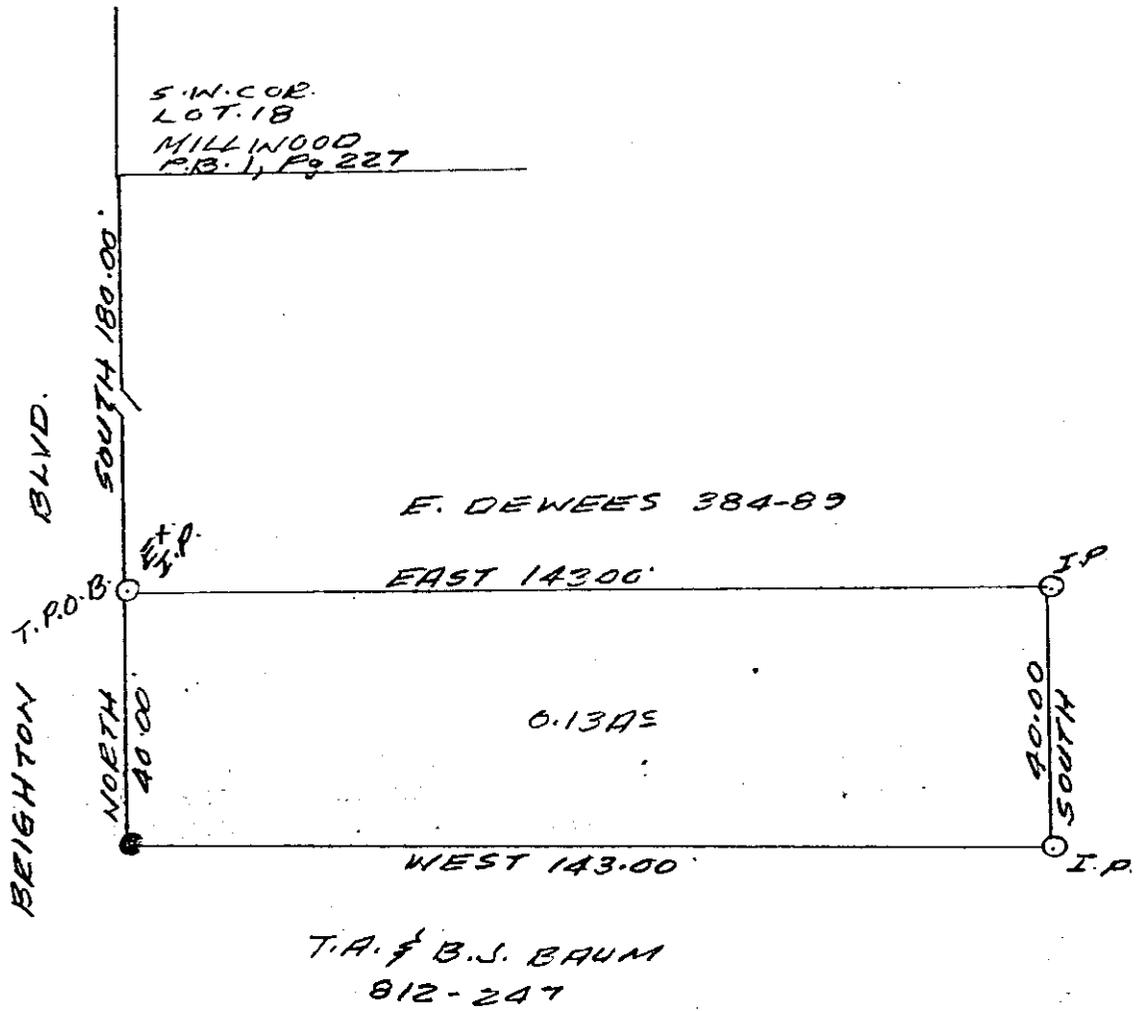

PLAT SHOWING
[ALL OF] JUDY K. WINLAND
629-308

BEING IN THE OLD SEVENTH WARD,
NEW THIRD WARD CITY OF
ZANESVILLE, MUSKINGUM COUNTY,
OHIO.

DATE: APRIL 10, 1985

OFFICE COPY
NOT RECORDABLE
REG. SURV. 5307