

SURVEYORS

RECORD

NO. 3

1886-1910

Index to Copies of the Original Field Notes of the
U.S. Military District

Surveys of quarter townships and subdivisions of quarter townships.

Indexed by townships and ranges. If parts of surveys are missing, check adjacent townships or ranges for information.

T. 1 - R. 5	Book #1	pg. 1-5	T. 3 - R. 8	Book #3	pg. 29-33
	Book #2	pg. 1-3	Sub. Vol. #3		pg. 14-24
Sub. Vol. #2		pg. 1-23			
T. 1 R. 6	Book #1	pg. 18-22	T. 3 - R. 9	Book #3	pg. 41-44
	Book #2	pg. 10	Sub. Vol. #3		pg. 38-57
Sub. Vol. #2		pg. 65-87			
T. 1 - R. 7	Book #2	pg. 16-17			
	Book #3	pg. 1-6			
Sub. Vol. #2		pg. 130-138			
T. 1 - R. 8	Book #2	pg. 17-18			
	Book #3	pg. 20-23			
T. 1 - R. 9	Book #2	pg. 18-19			
	Book #3	pg. 34-36			
Sub. Vol. #3		pg. 25-37			
T. 2 - R. 5	Book #1	pg. 6-11			
Sub. Vol. #2		pg. 24-44			
T. 2 - R. 6	Book #1	pg. 23-27			
	Book #2	pg. 11			
Sub. Vol. #2		pg. 88-108			
T. 2 - R. 7	Book #3	pg. 7-12			
T. 2 - R. 8	Book #3	pg. 24-28			
Sub. Vol. #3		pg. 1-13			
T. 2 - R. 9	Book #3	pg. 37-40			
T. 3 - R. 5	Book #1	pg. 12-17			
Sub. Vol. #2		pg. 45-64			
T. 3 - R. 6	Book #2	pg. 4-9 & 11,12			
Sub. Vol. #2		pg. 109-129			
T. 3 - R. 7	Book #3	pg. 13-19			
Sub. Vol. #2		pg. 139-147			

Index to Copies of the Original Field Notes of the
Congress Lands East of the Scioto

Surveys of 2 mile blocks and subdivisions into 1 mile sections.

Indexed by Townships and Ranges.

T. 10 - R. 13	Vol. #1	pg. 1-21
Sub. Vol. #6		pg. 74-89
T. 11 - R. 13	Vol. #1	pg. 22-37
Sub. Vol. #6		pg. 90-103
T. 12 - R. 11	Vol. #7	pg. 39-52
Sub. Vol. #6		pg. 1-15
T. 12 - R. 12	Vol. #7	pg. 24-38
Sub. Vol. #6		pg. 37-54
T. 12 - R. 13	Vol. #1	pg. 38-45
Sub. Vol. #6		pg. 104-109
T. 13 - R. 11	Vol. #7	pg. 1-12
Sub. Vol. #6		pg. 16-30
T. 13 - R. 12	Vol. #7	pg. 13-23
Sub. Vol. #6		pg. 55-71
T. 14 - R. 14	Vol. #2	pg. 1-44
T. 15 - R. 14	Vol. #2	pg. 45-70
Sub. Vol. #6		pg. 110-127
T. 16 - R. 14	Vol. #2	pg. 71-79
Sub. Vol. #6		pg. 128-133
T. 17 - R. 15	Vol. #3	pg. 1-37
Sub. Vol. #6		pg. 134
T. 18 - R. 15	Vol. #3	pg. 38-50
Sub. Vol. #6		pg. 135-141

Index to Index

Page		T - R	T - R
306	Adams	36	
324	Blue Rock	12 12	
328	Brush Creek	10 13	11 13
316	Cass	3 7	3 8
336	Clay	14 14	
312	Falls	9 7	9 8
326	Harrison	13 12	10 13
302	Highland	12 12	11 13
318	Hobfurnell	25	25
320	Jackson	1 9	18 15
316	Jefferson	3 9	
320	Leaking	3 8	
310	Madison	2 9	
322	Meigs	3-8	3-7
304	Monroe	12 11	
314	Muskingum	3 5	
332	Newtont	2 7	2 8
304	Perry	15 14	17 15
322	Rich Hill	1 6	
306	Saline	13 11	
324	Salt Creek	2 6	
334	Springfield	13 12	12 13
302	Union	16 14	15 14
308	Washington	1 5	2 7
330	Wayne	1 7	2 7
		13-12	11 13
			12 13

3

Survey Rec


S/R - 2



Part of the North West Quarter of Section 17 Township 11 Range 13
 of the Original Survey of Lands in Ohio - south of the Military
 Line - being now Brush Creek Township - Muskingum County OHIO
 Surveyed for Balser Deiterick Jan^r 1886


Frederic Howell
 County Surveyor

Scale 4 Chains to an Inch

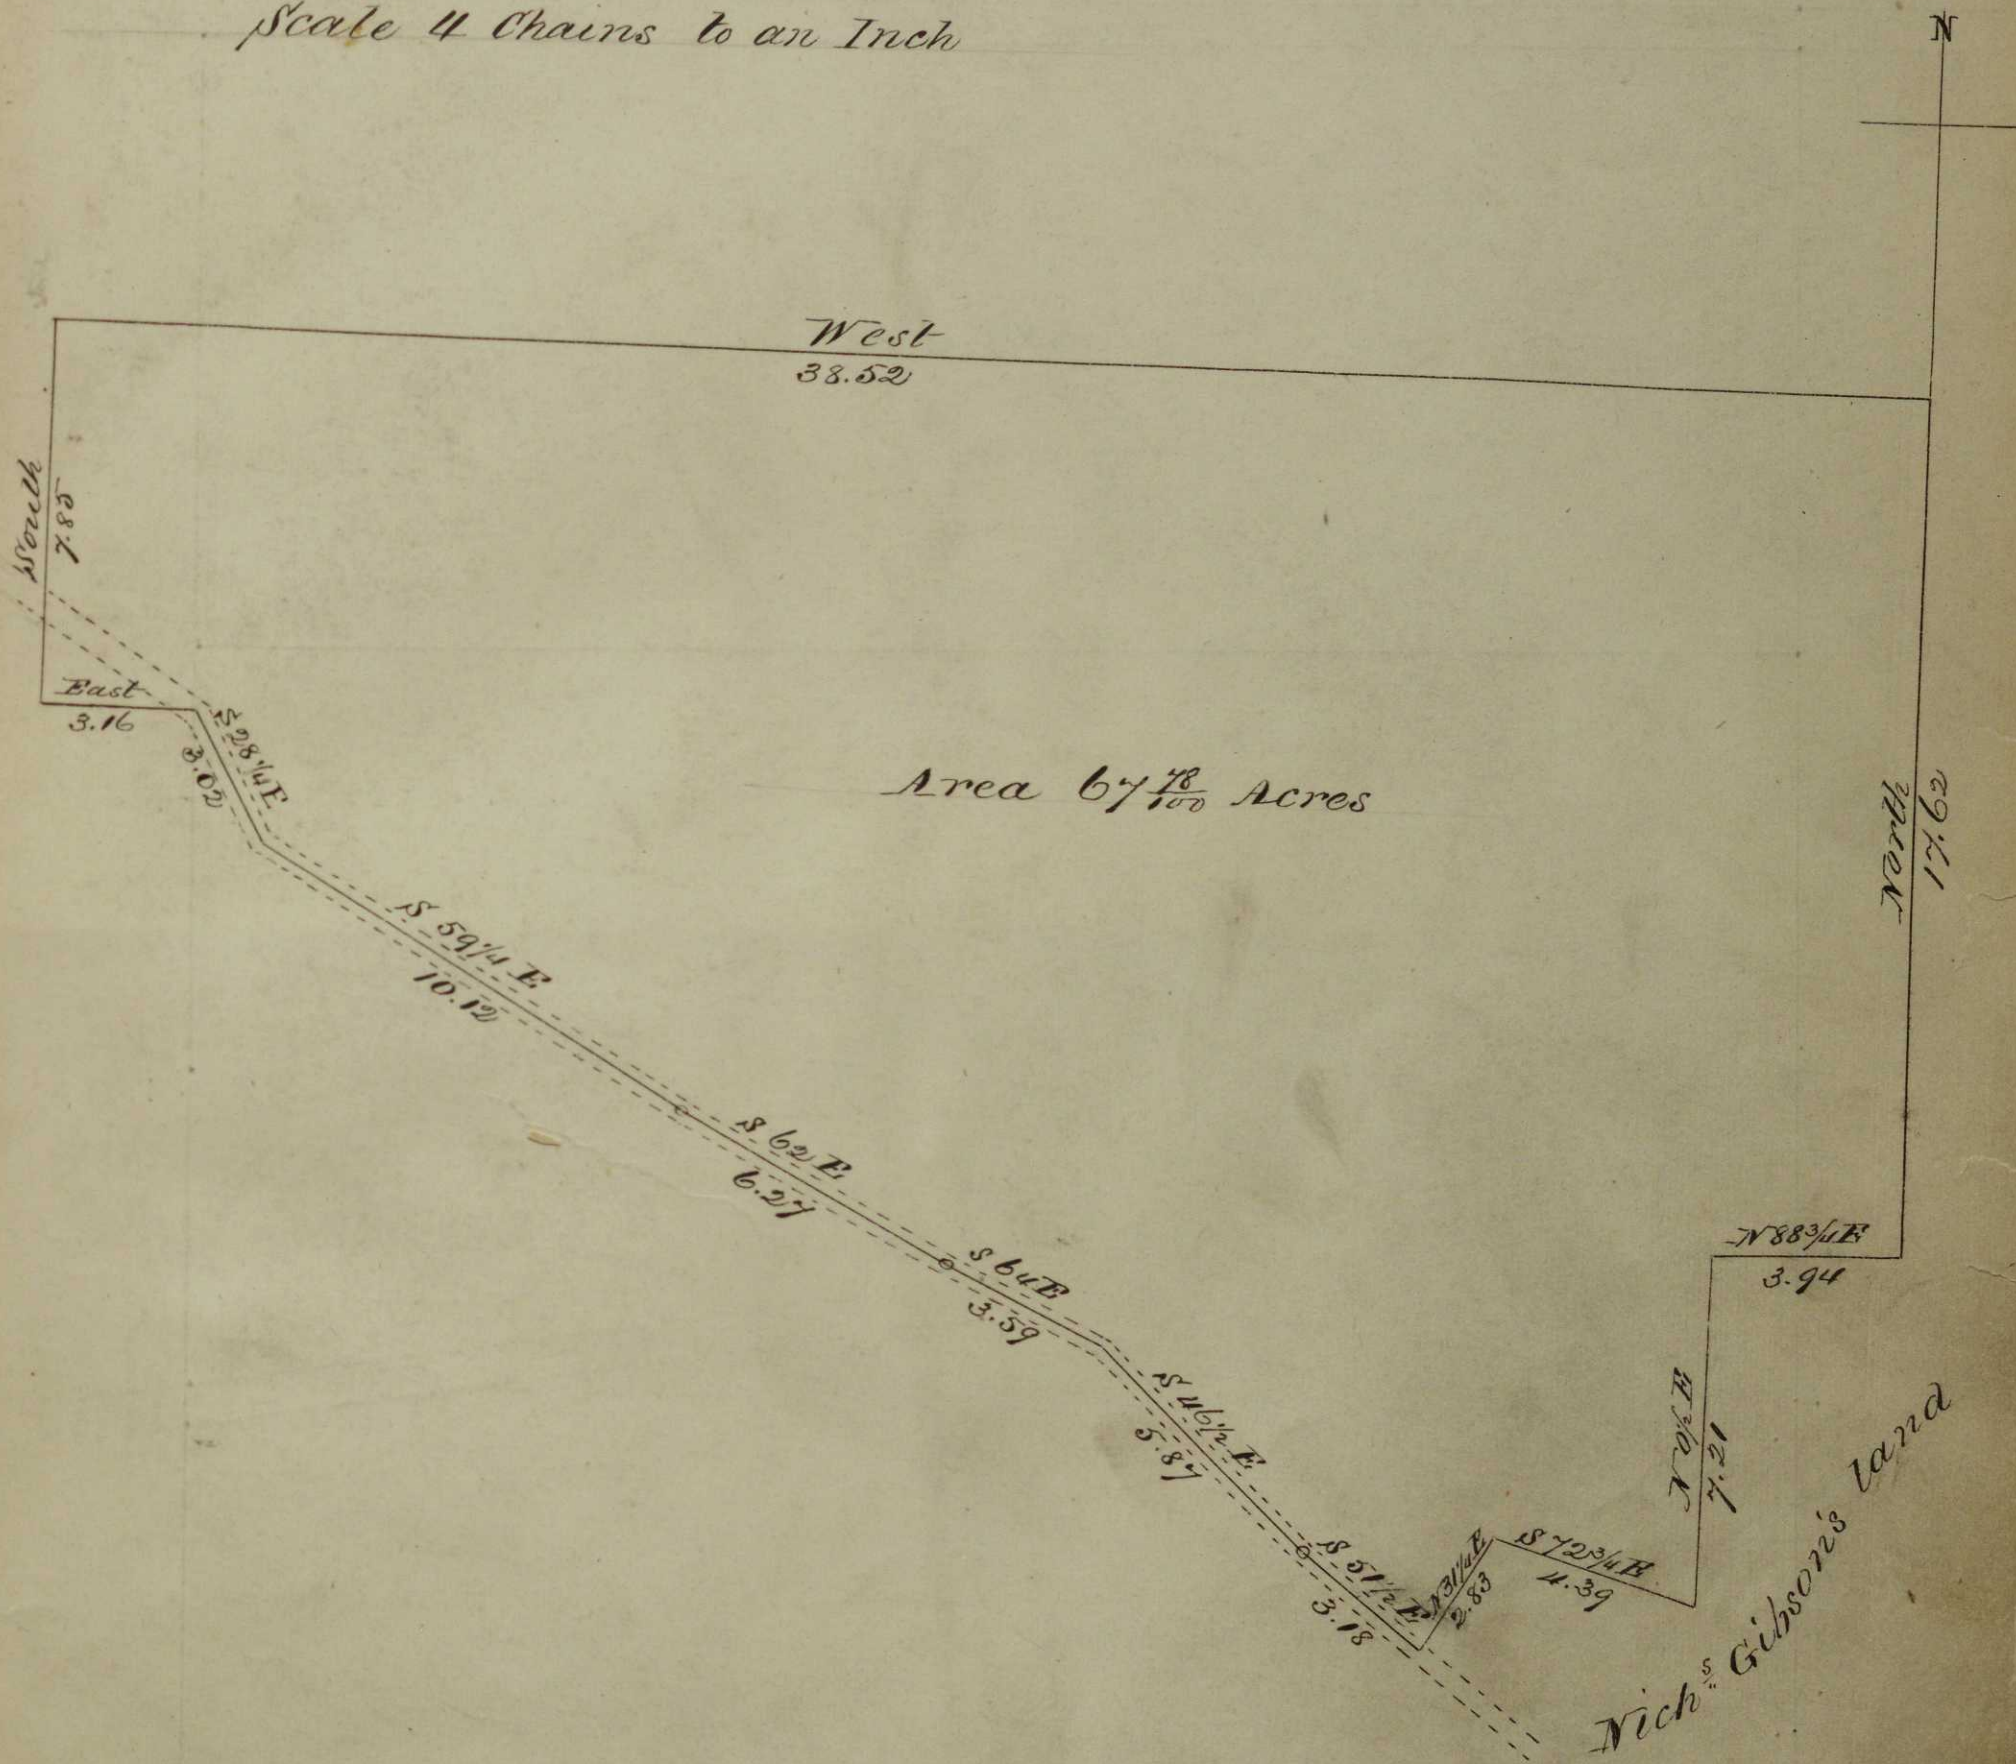


Survey of Lot 2 of Underswood Subdivision of Lands
in Falls Township - Muskingum County Ohio - for Elgin Ray
Owen Gadd } chairman
Owen Gadd }
Elgin Ray, Marker
Sam Kelley, Staffman

Surveyed March 10th 1886.
Albert E. Howell
Deputy County Surveyor

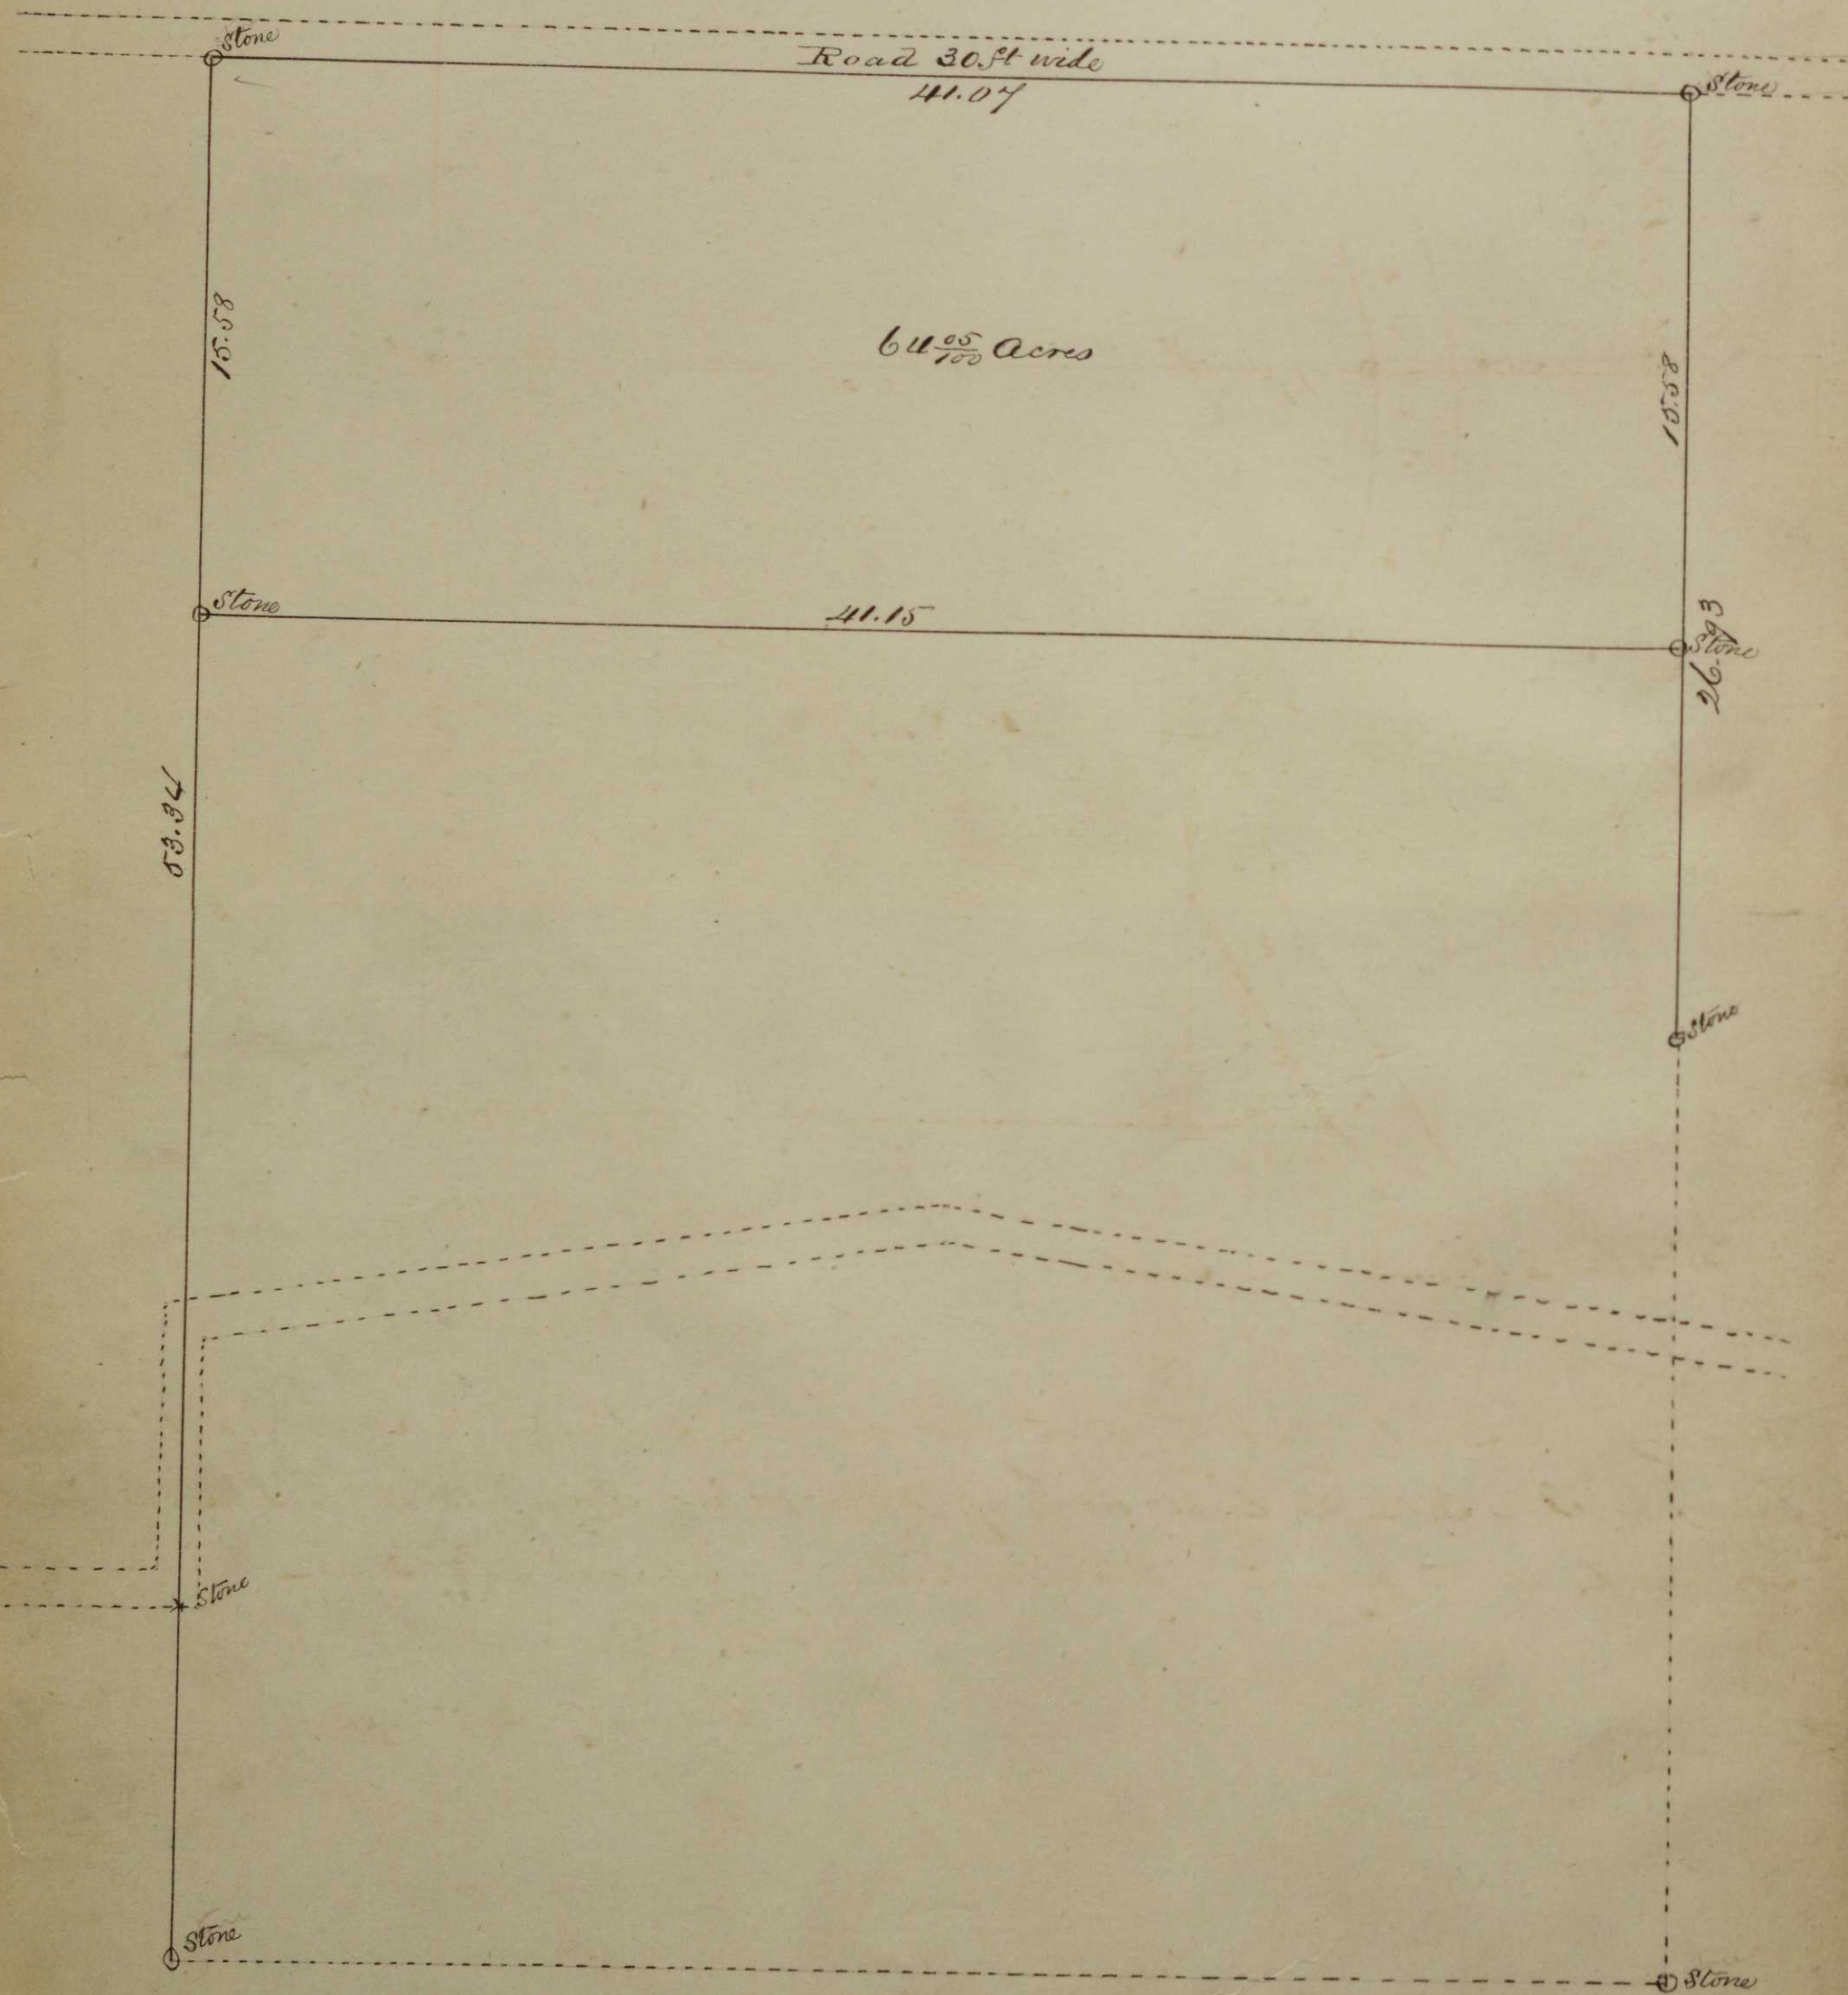


Scale 5 Chains to an Inch

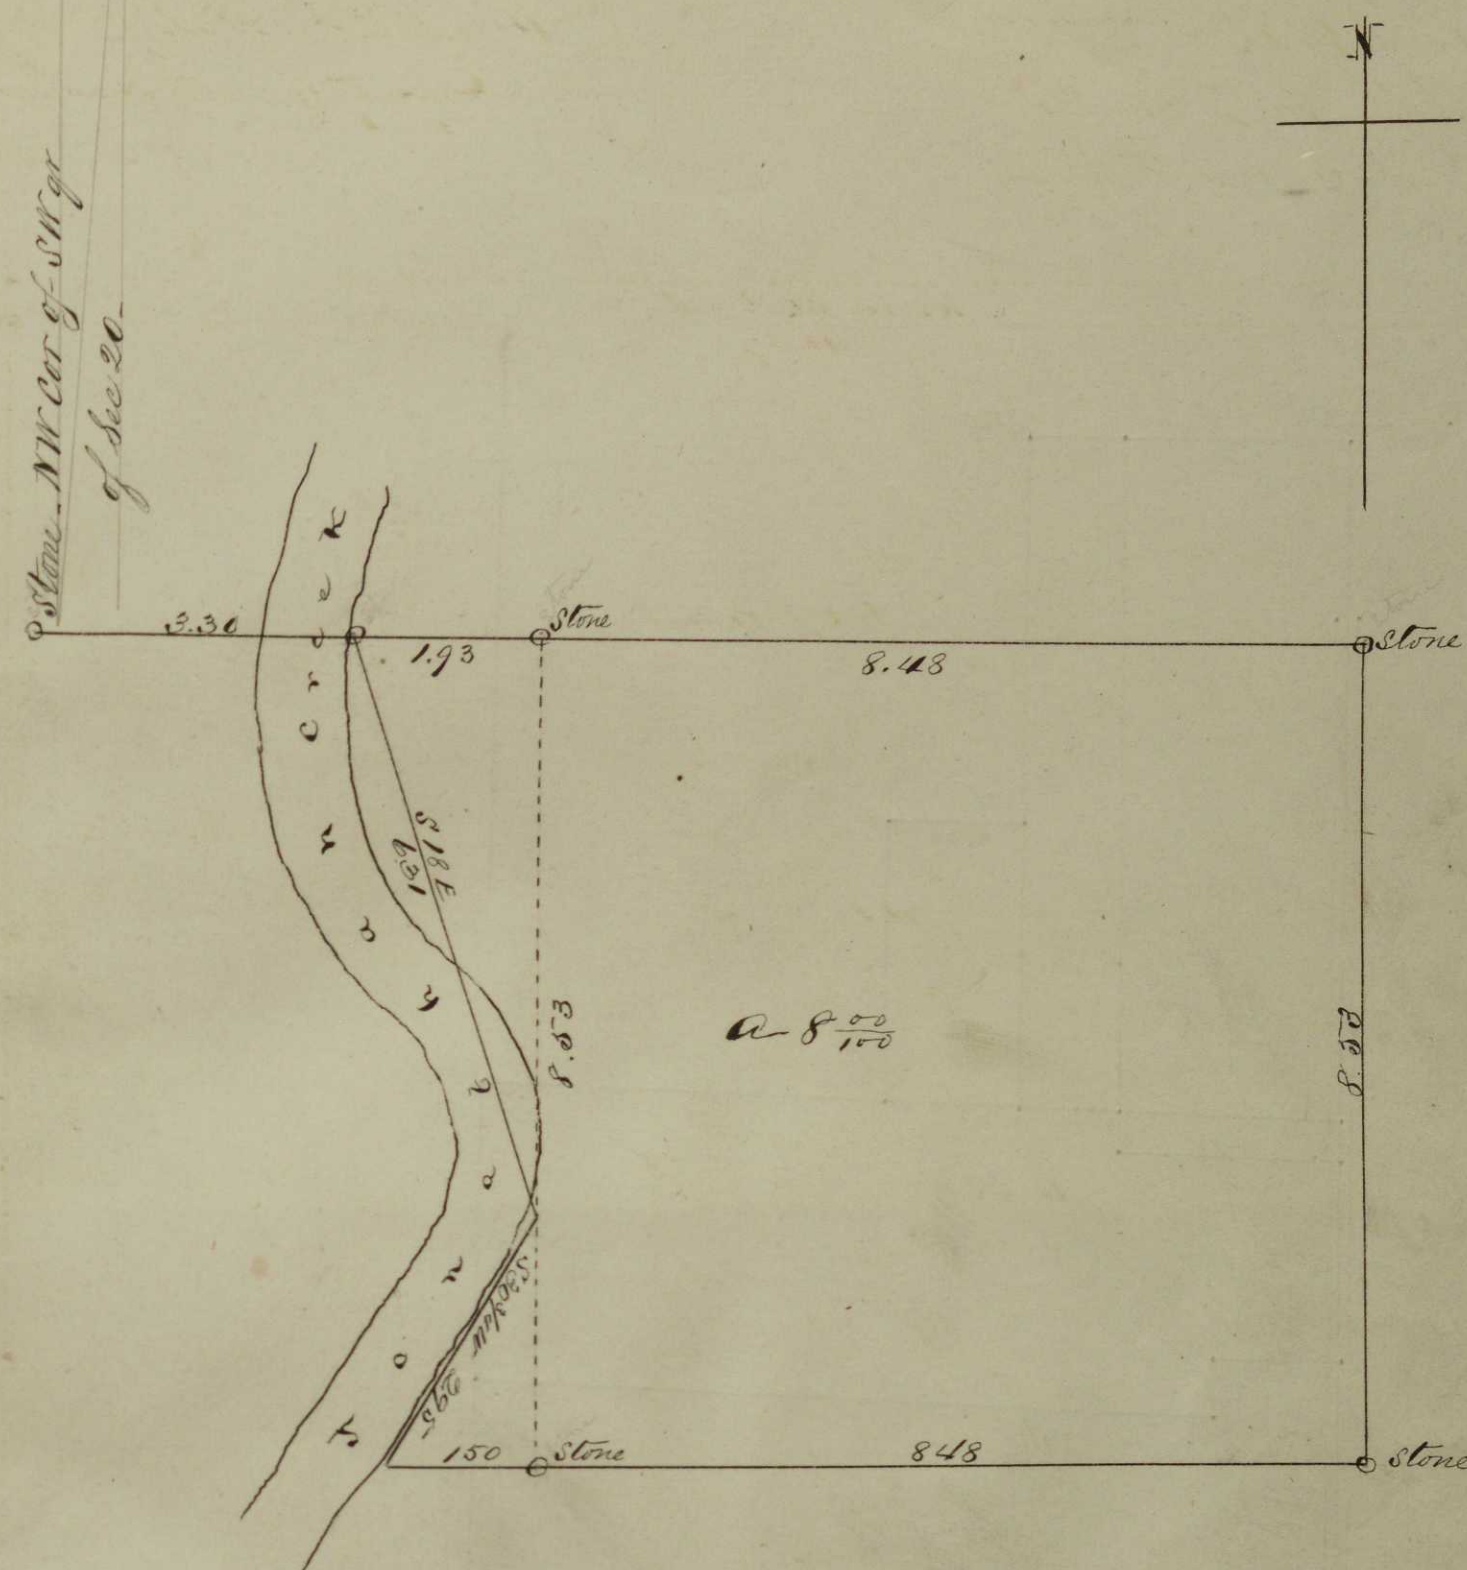

Scale 2 Chains to an Inch

Survey of Lands Near the North West corner of Section 20 in Township 15 Range 14
being a Fee Title of Eight-acres off the N.W. corner of J.W. Melick's 38 acre tract
Surveyed at the request of A.J. Melick - March 25th 1886 -
Fred Howell
County Surveyor

127

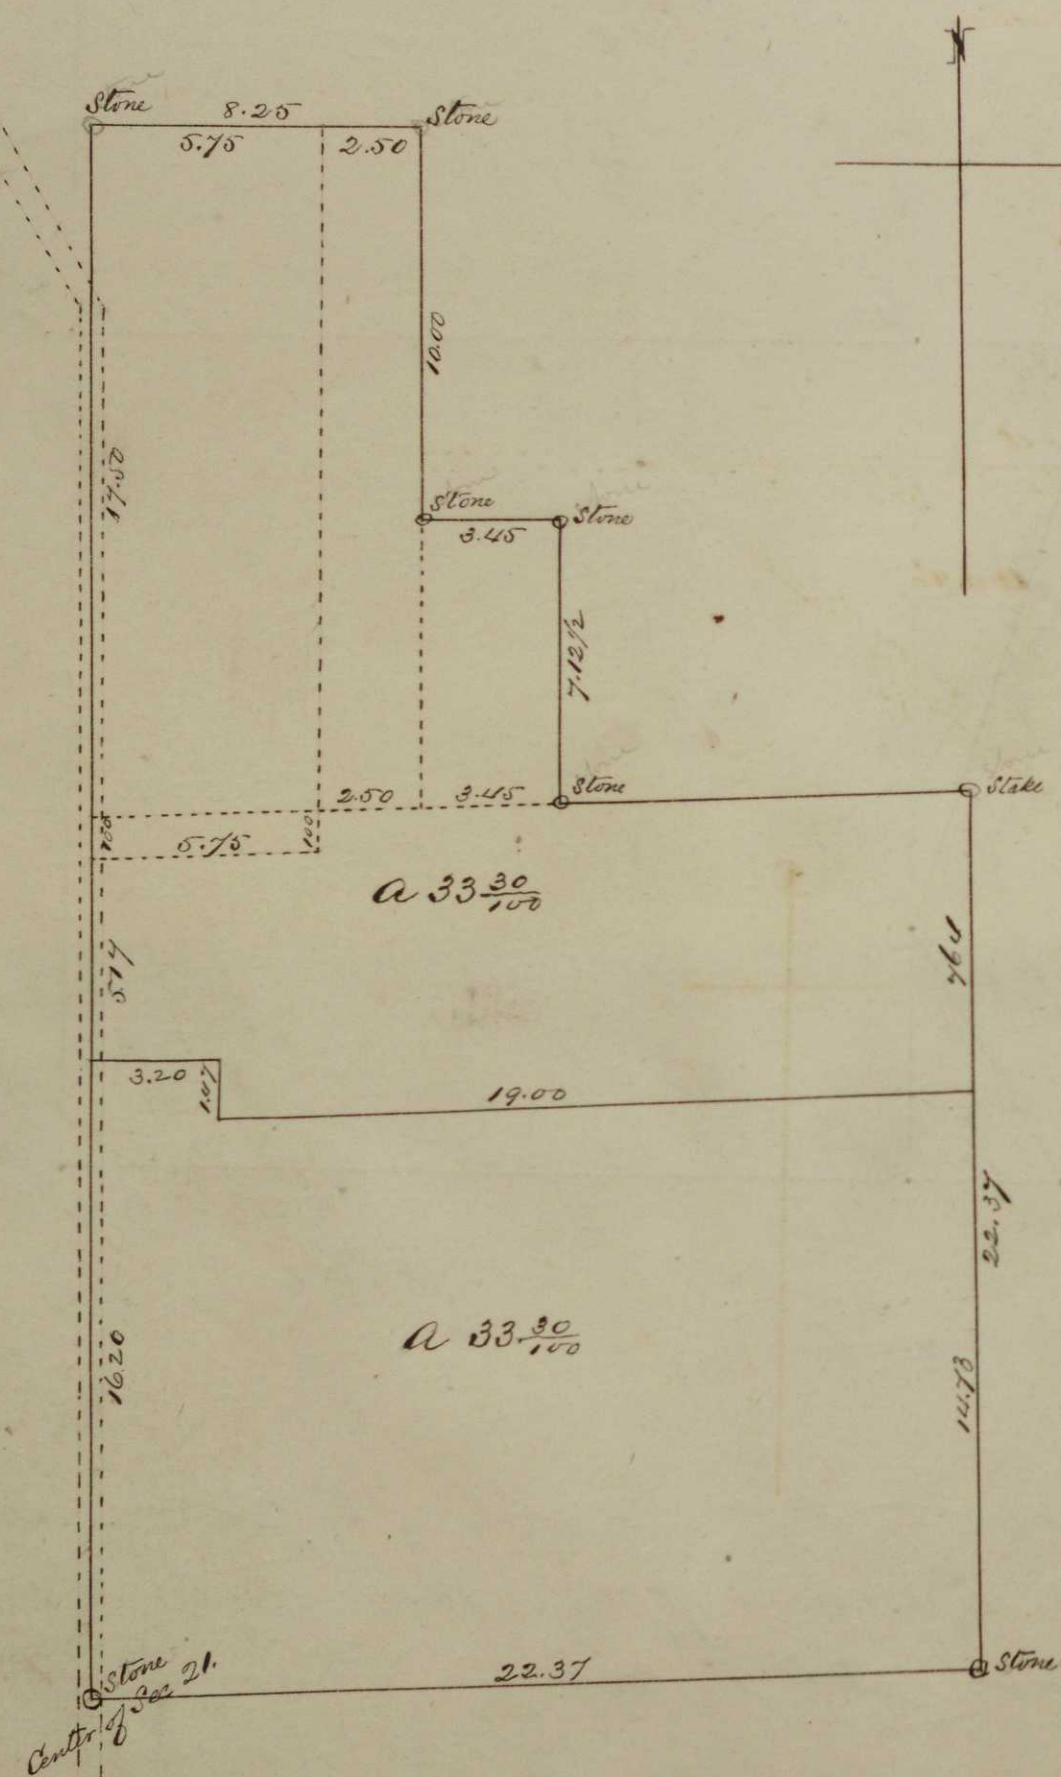


Survey of a part of the North East quarter of Section 21 in Township 1
Range 9 - Hopewell Township - Muskingum County Ohio - for Cumberland and
Leke Johnson - March 23rd 1886 -

John Francis }
Jos Remion } Chairmen
Newton Smith marker

Fred Howell
County Surveyor -

Survey of the North West corner of the South East quarter of Section 4 in
Township 13 and Range 11 - Rich Hill Township for Thomas Muirhead April 2nd 1886

A. E. Howell }
John Forsyth } Chairmen
Danl Smalley marker

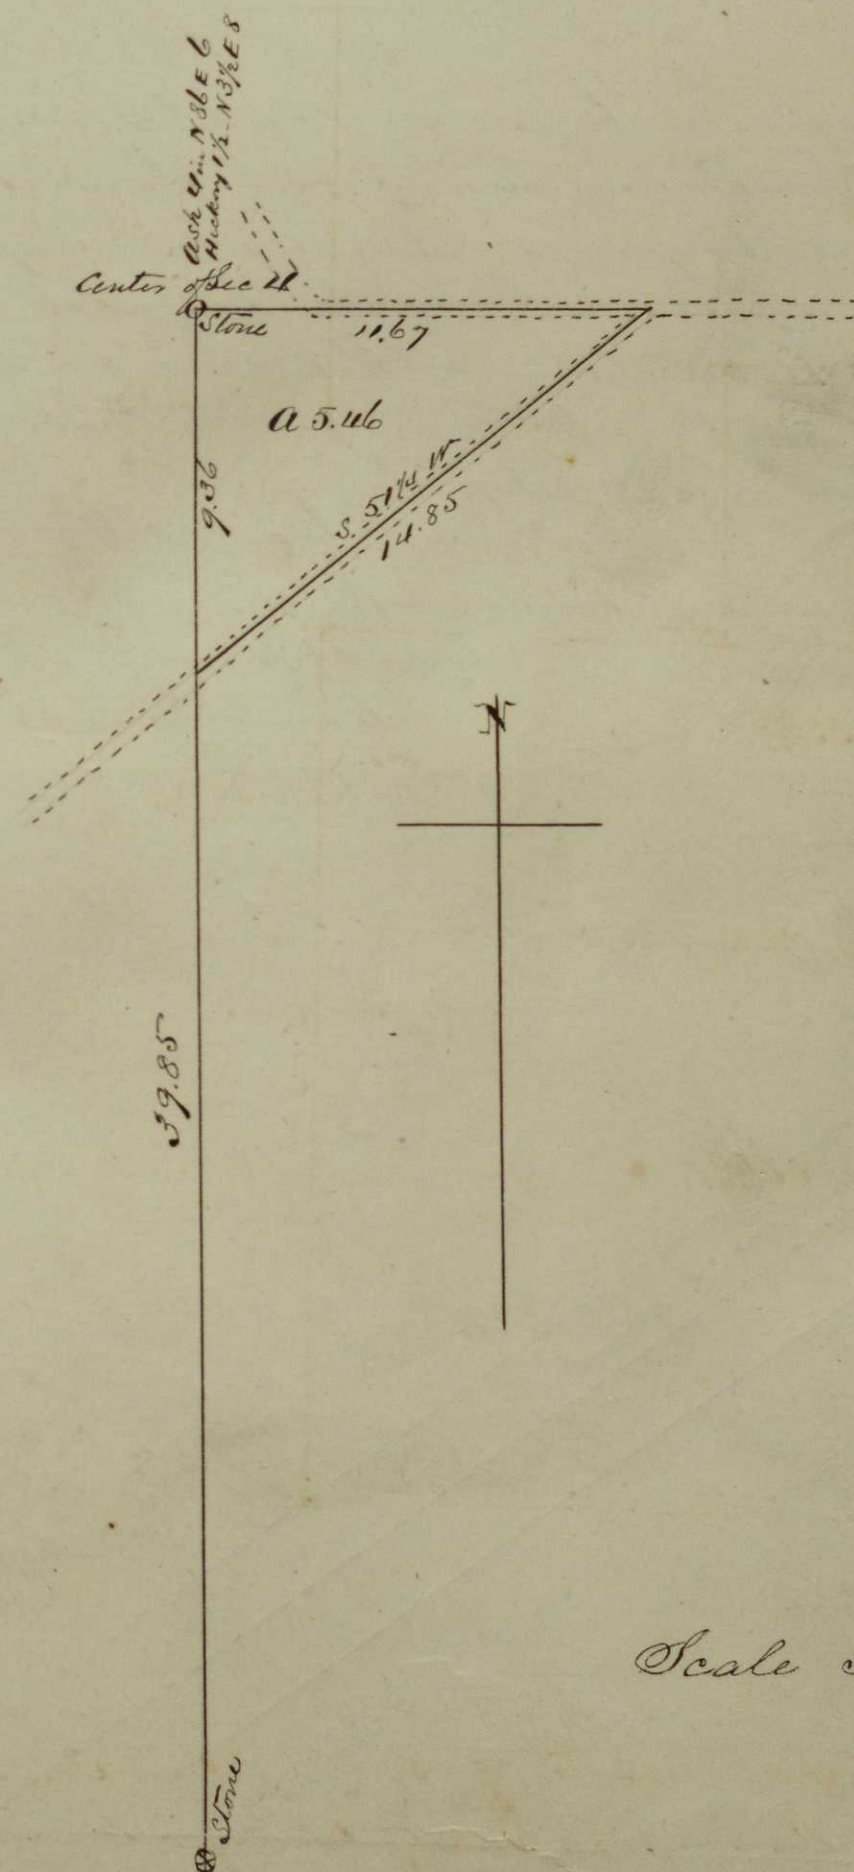

Scale 5 Chains to an Inch -

Scale 20-or 2 Chains to an Inch


Licking Valley Muskingum County. O
April 13th 1886.

Signed George Kreager—


Sworn to and Subscribed before me the 13th day of Apr^{il} 1886

Frederick Howell

County Sumner

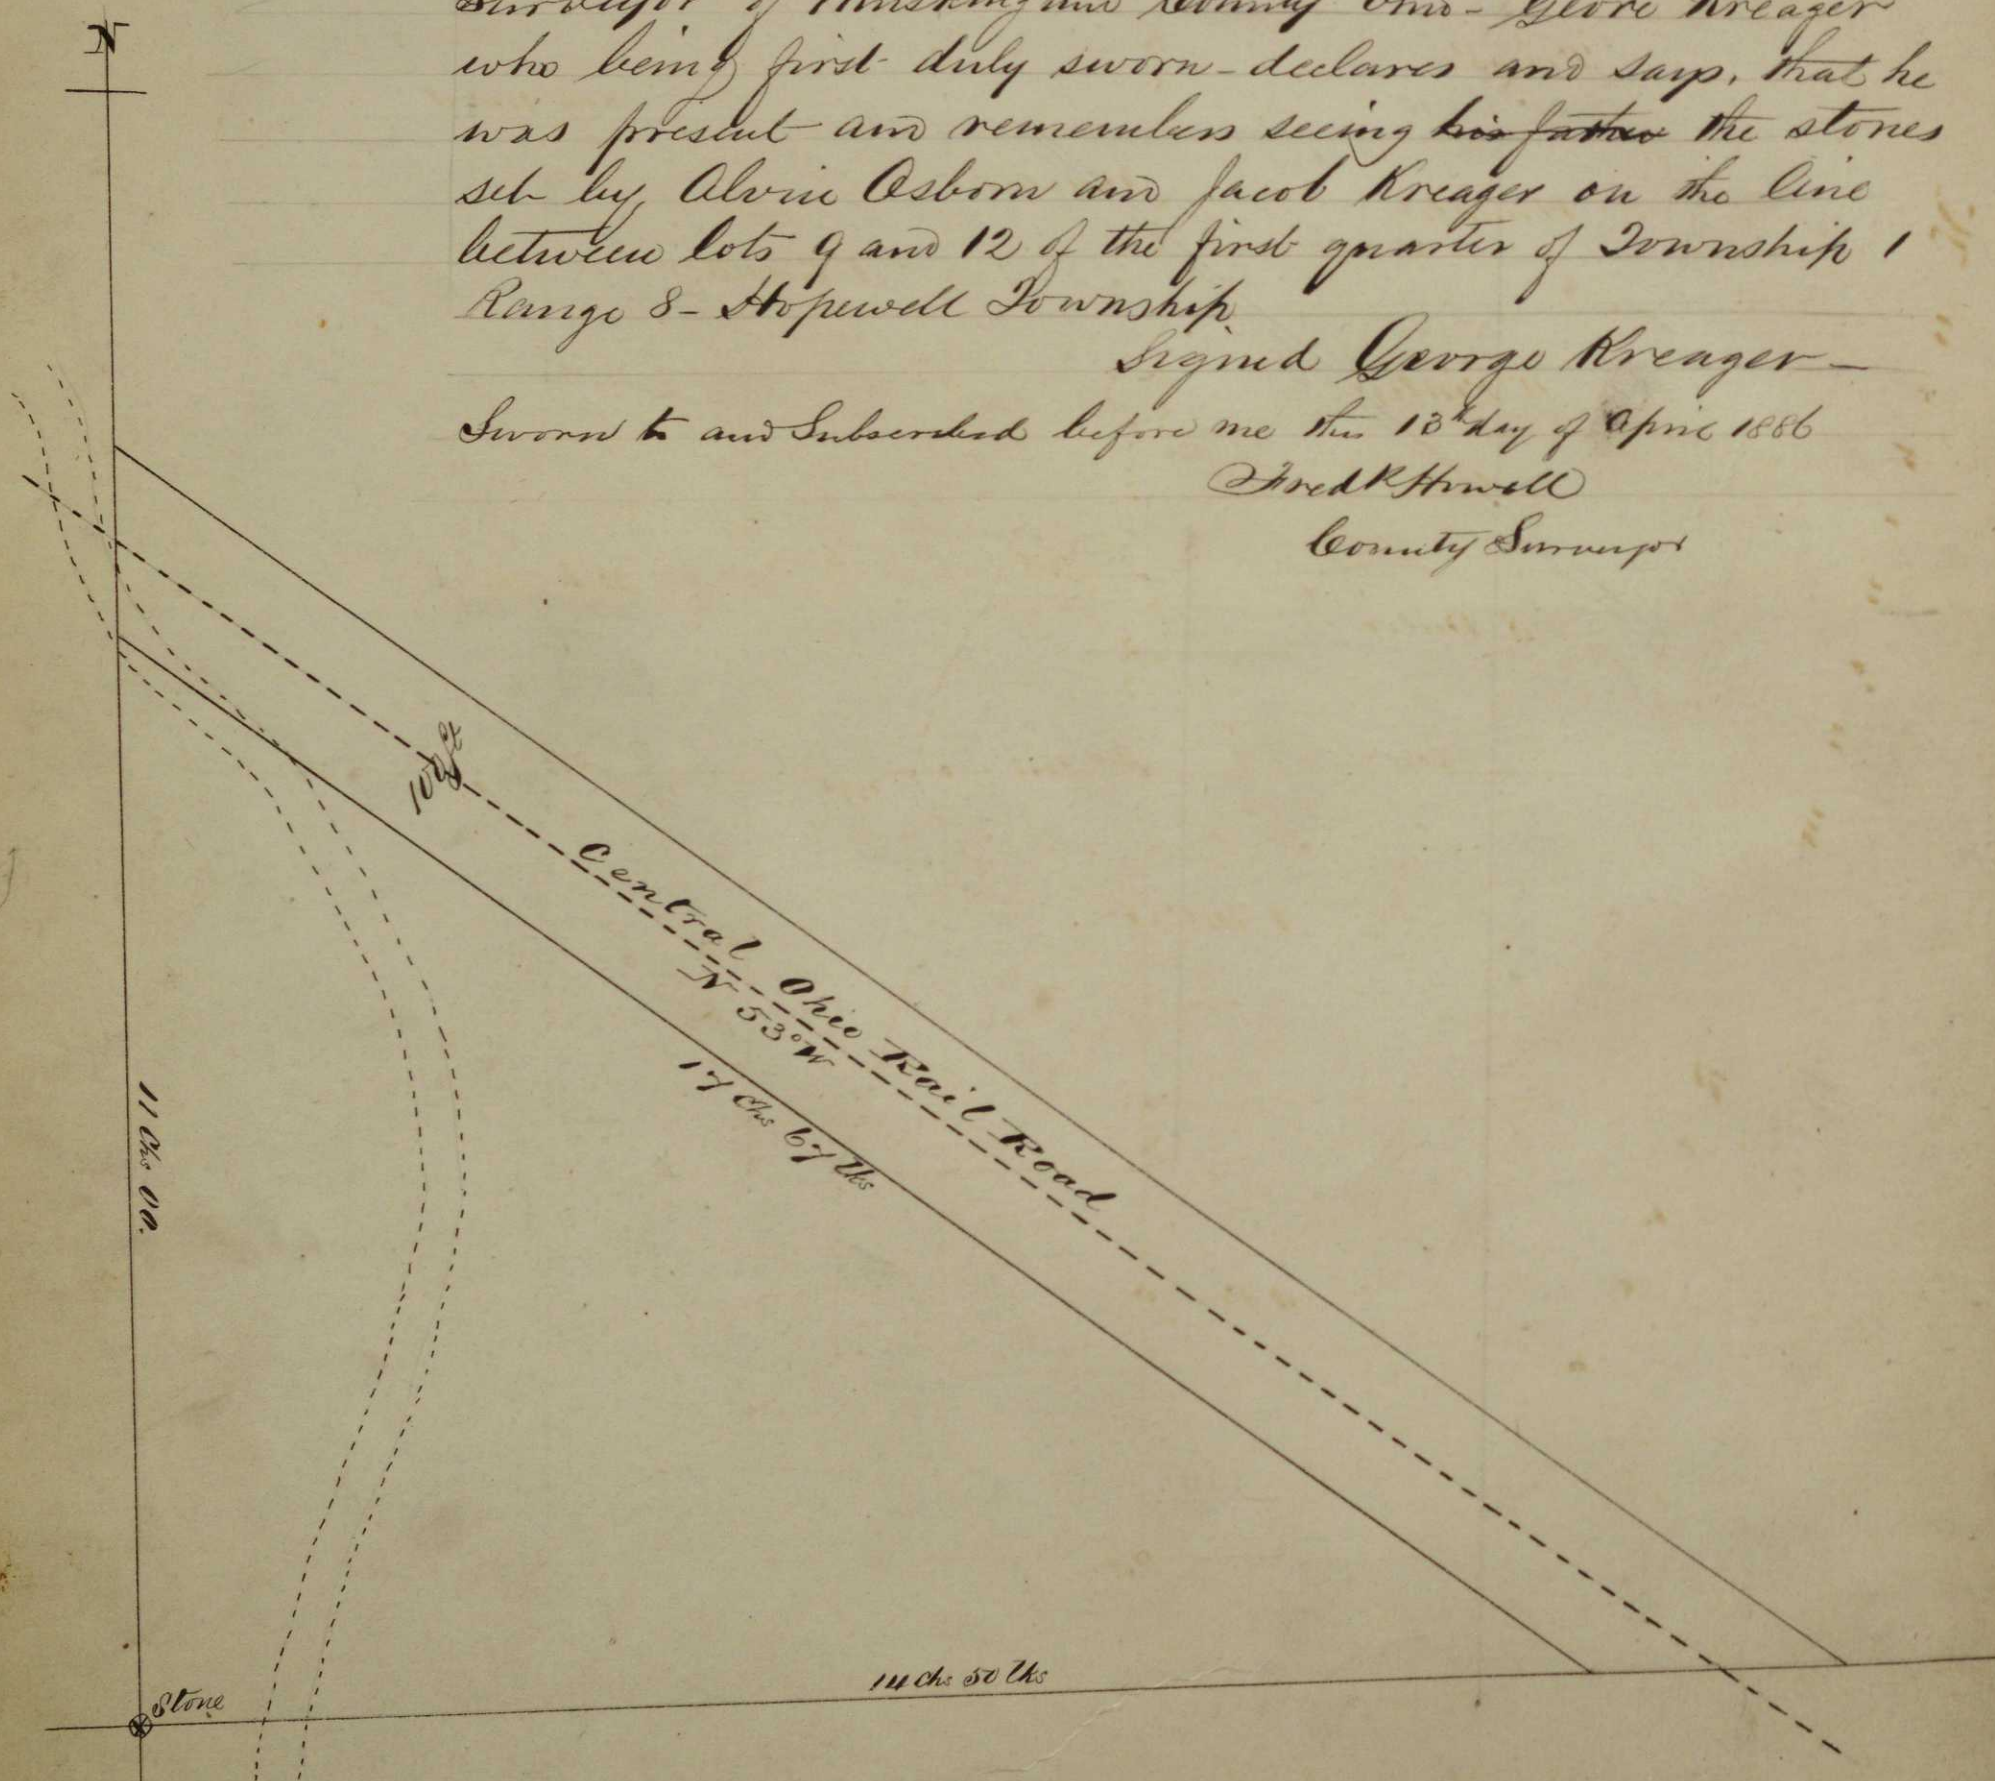


A E Howell
Geo W Leasmo
A R Peyton
O W Ross
J J Leasmo

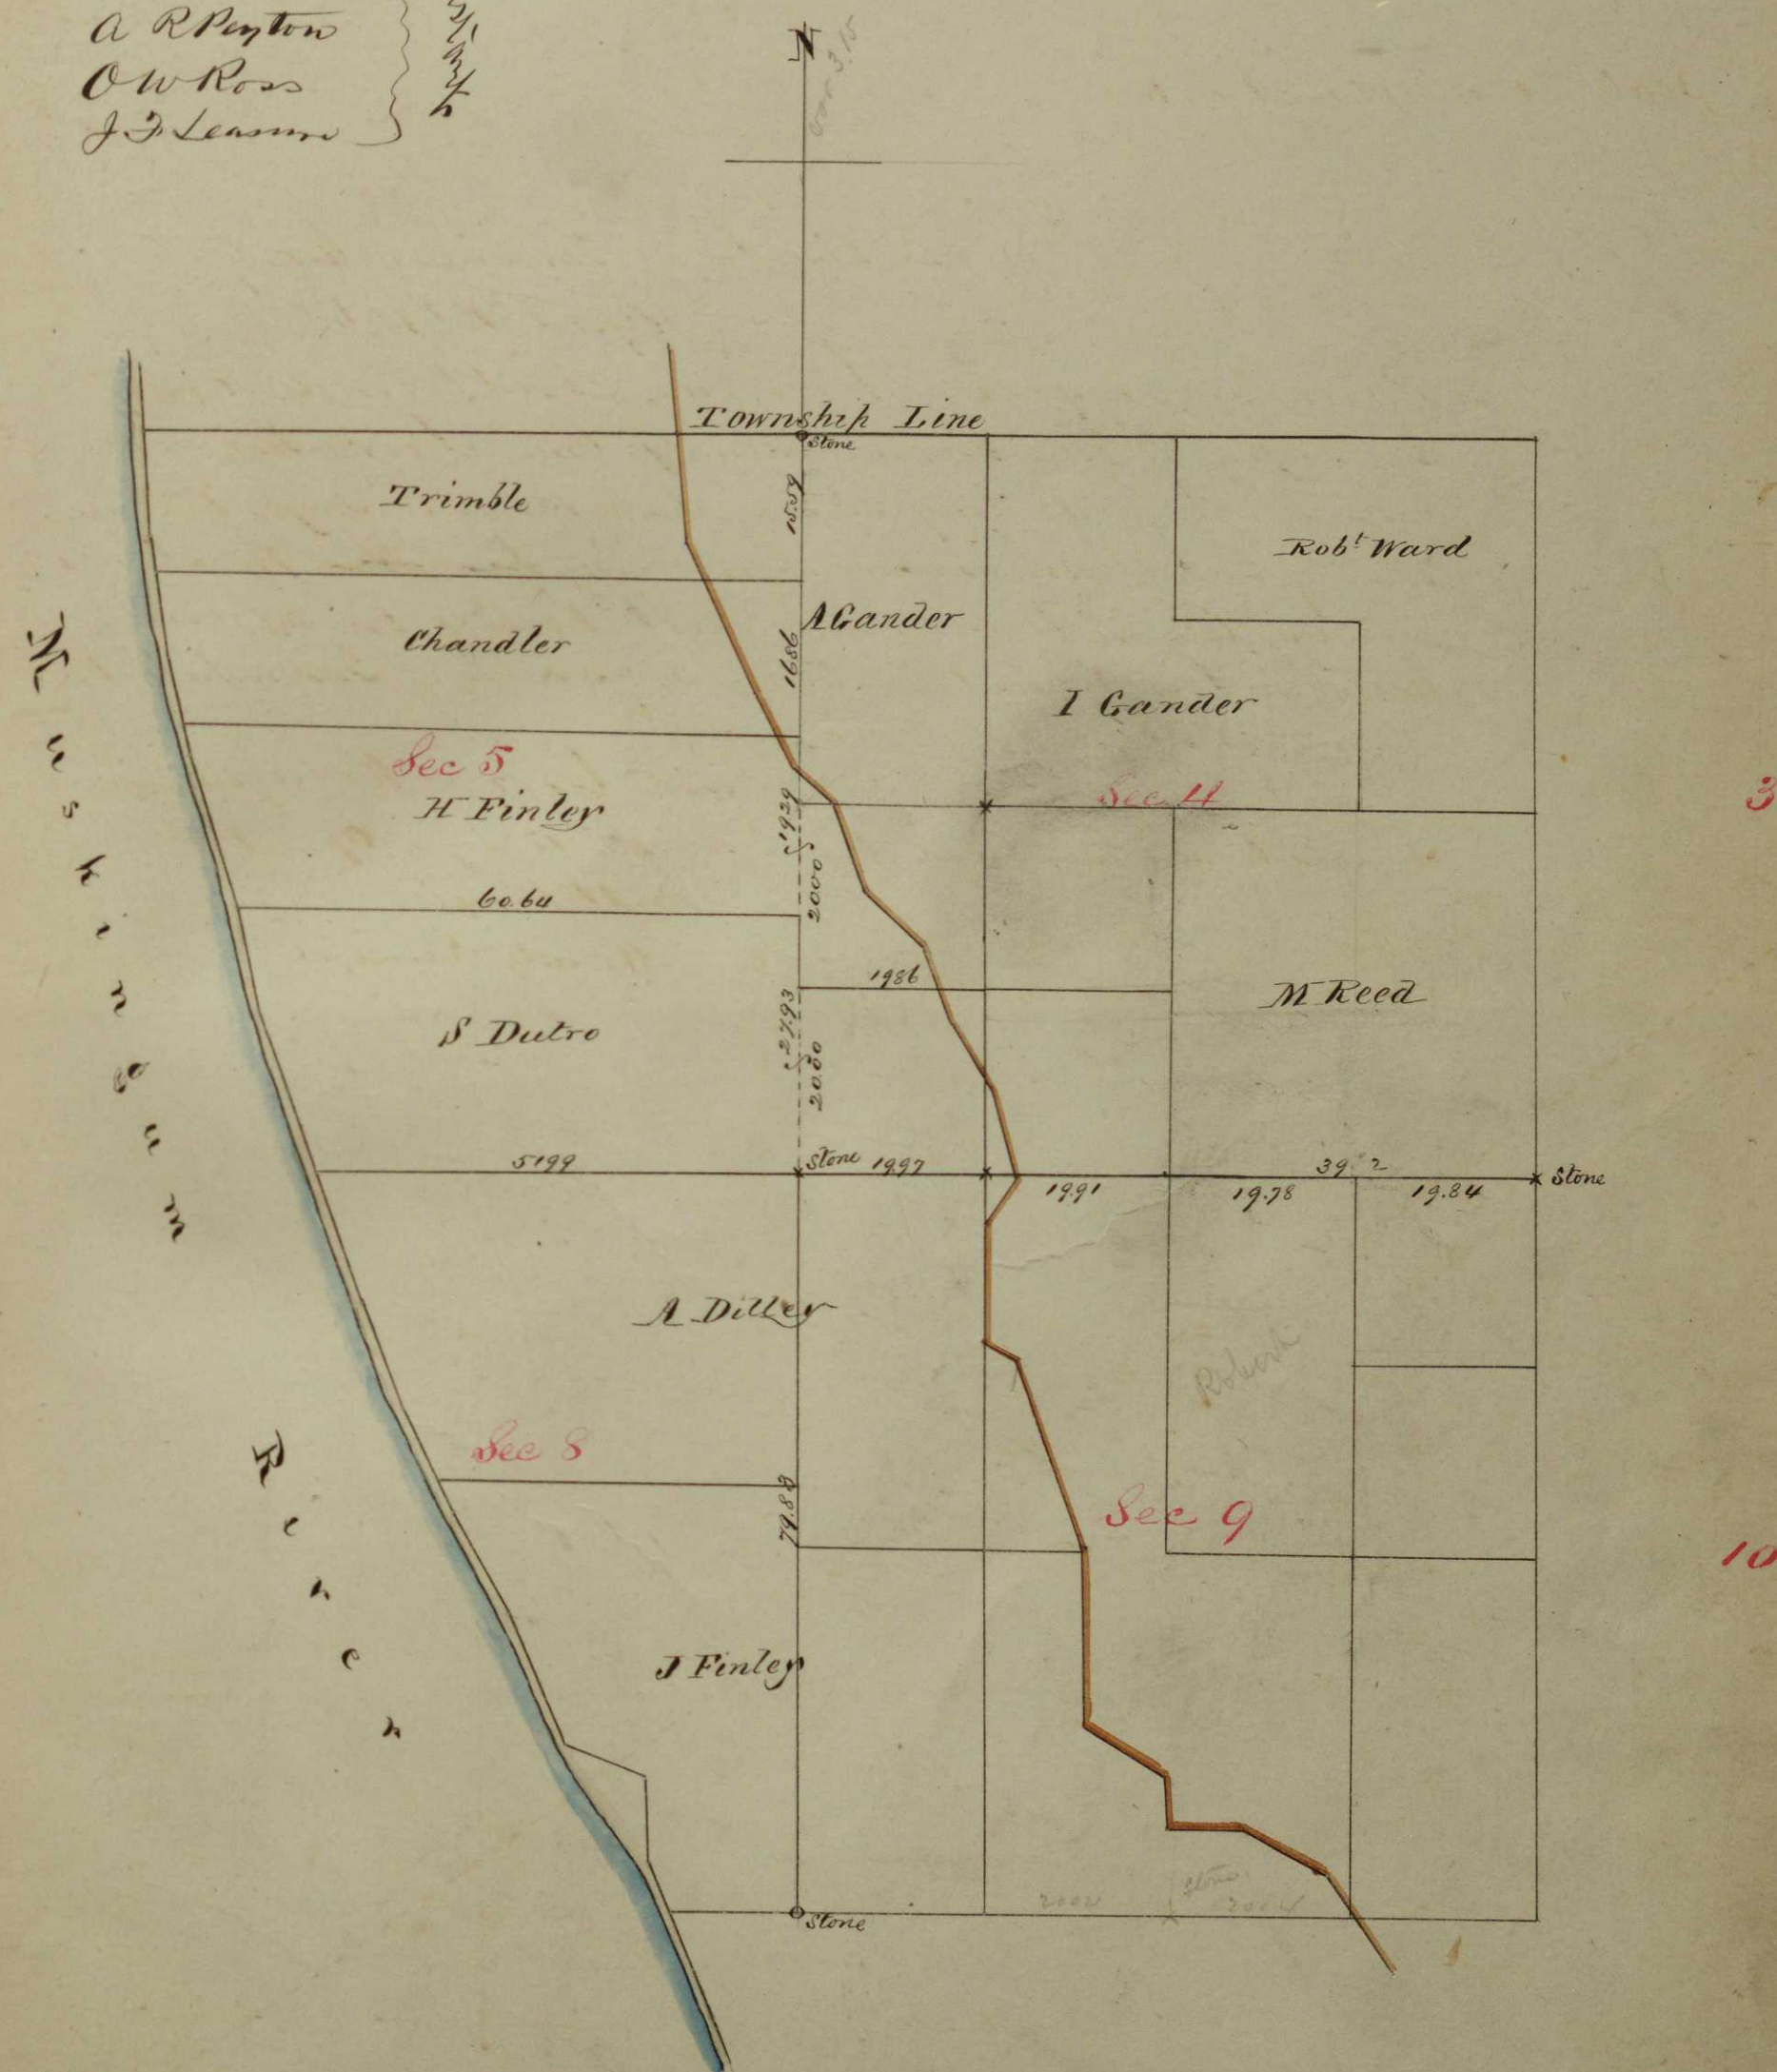

Scale 20 Chains to an Inch


Good Howell
County Surveyor

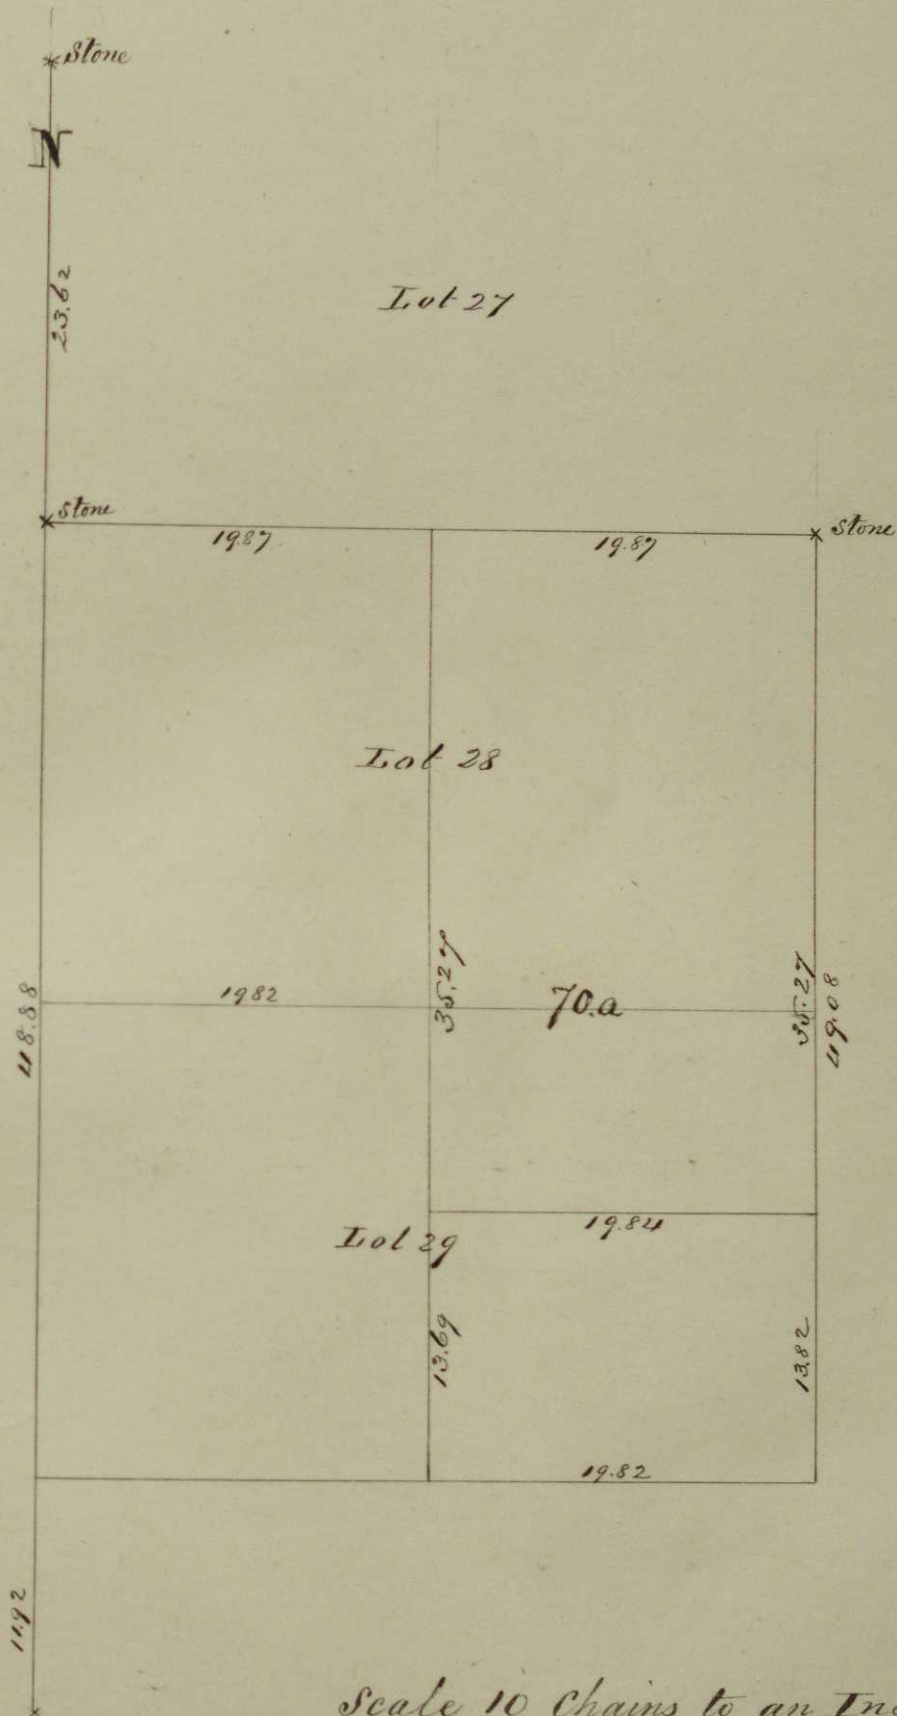

Survey of 70 acres off the North End of the East Half of Lots 28 and 29 of
the Third quarter of D 1-R 9-Hopewell Tp - April 21st 1886 for Albert Ewers

Am A Small }
Jos R Hursey } Chain carriers
Andrew Bell Marker


Fred Howell
County Surveyor

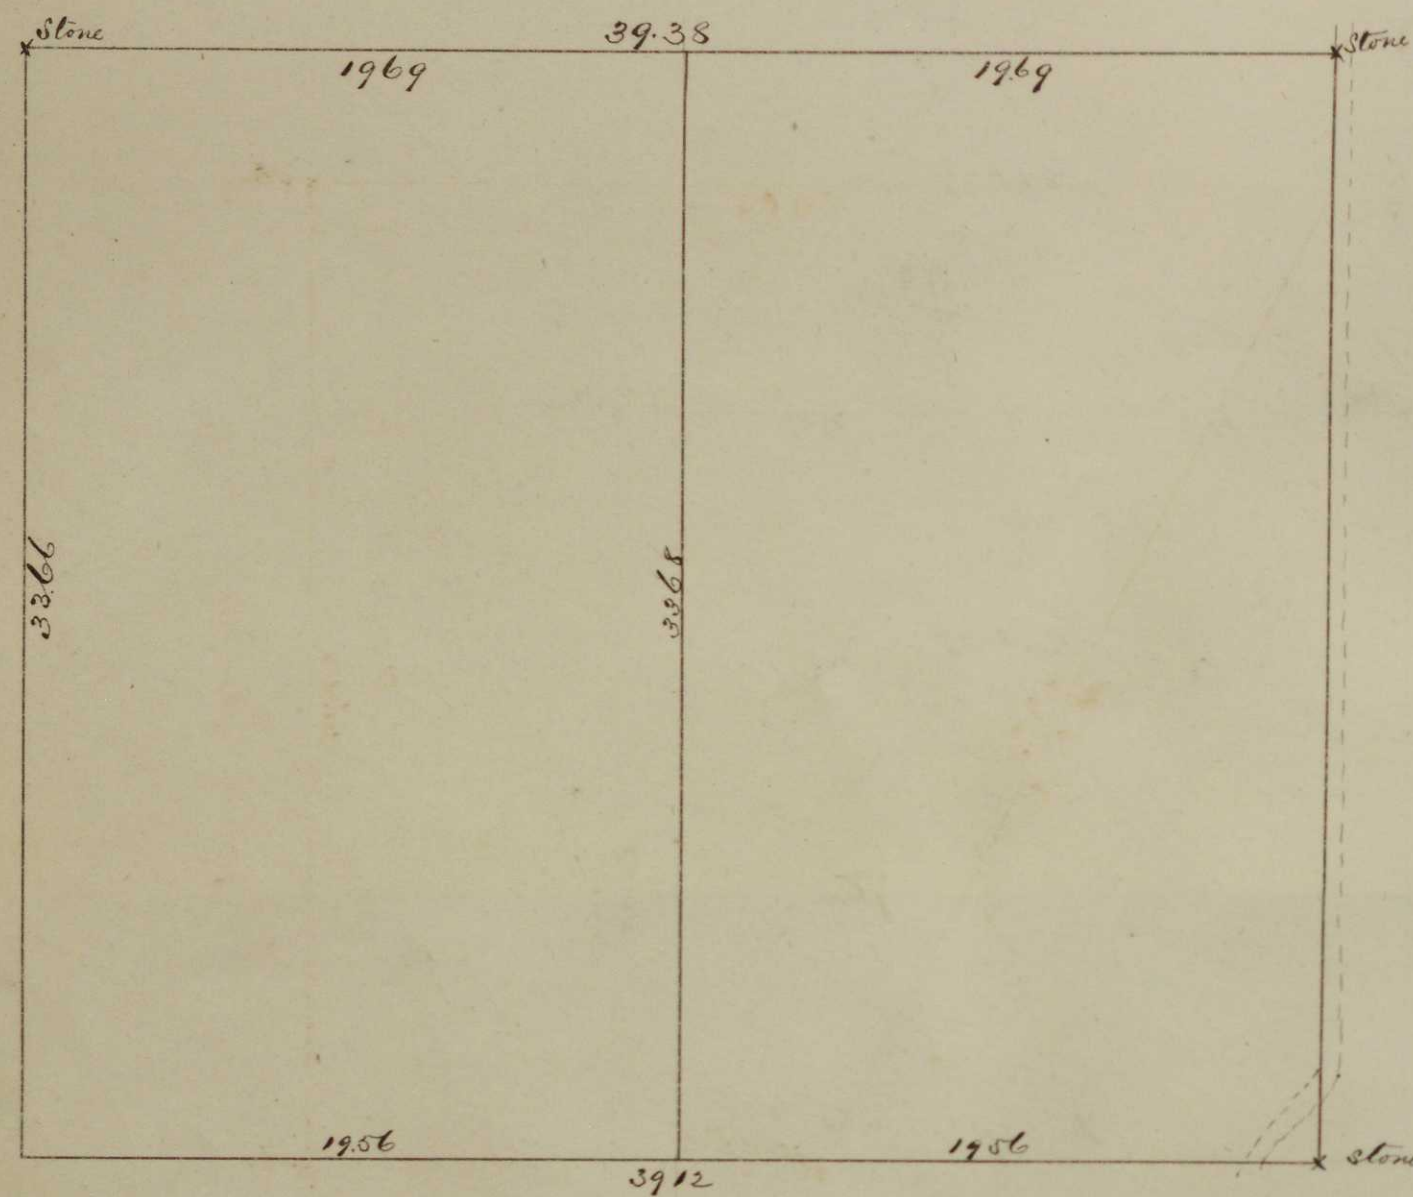

Survey of the S west quarter of Sec 8 T18 R 15 Hopewell Township
the Le Willey Farm - Surveyed for C M Vandembark - May 7th 1886 -

A E Howell
Deputy Co Sur

1.17

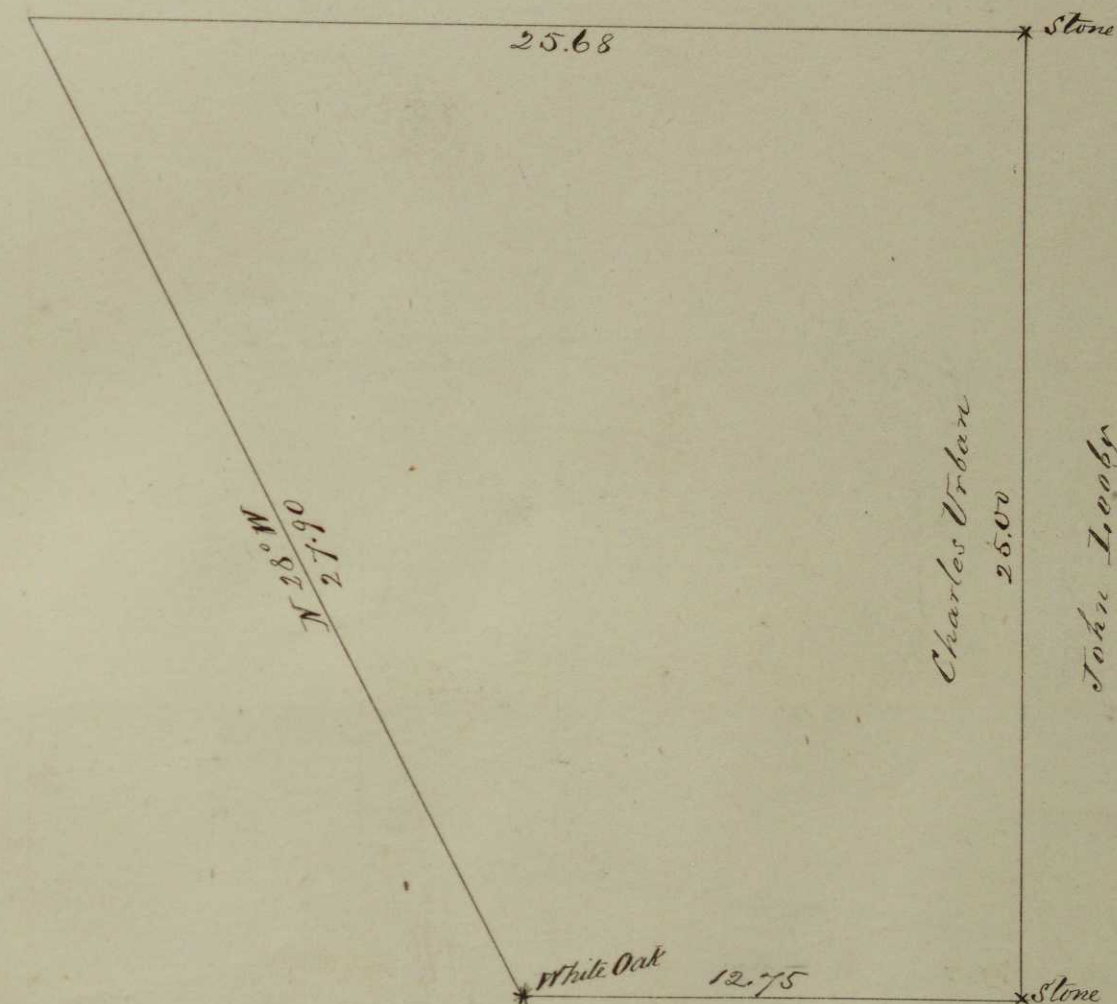


Survey of Line between John Loozy and Charles Urban in Section 15 T16
and R 14 - Springfield Township - May 12th 1886 -

Scale 5 Chains to an Inch

Fred Howell
County Surveyor

1.12

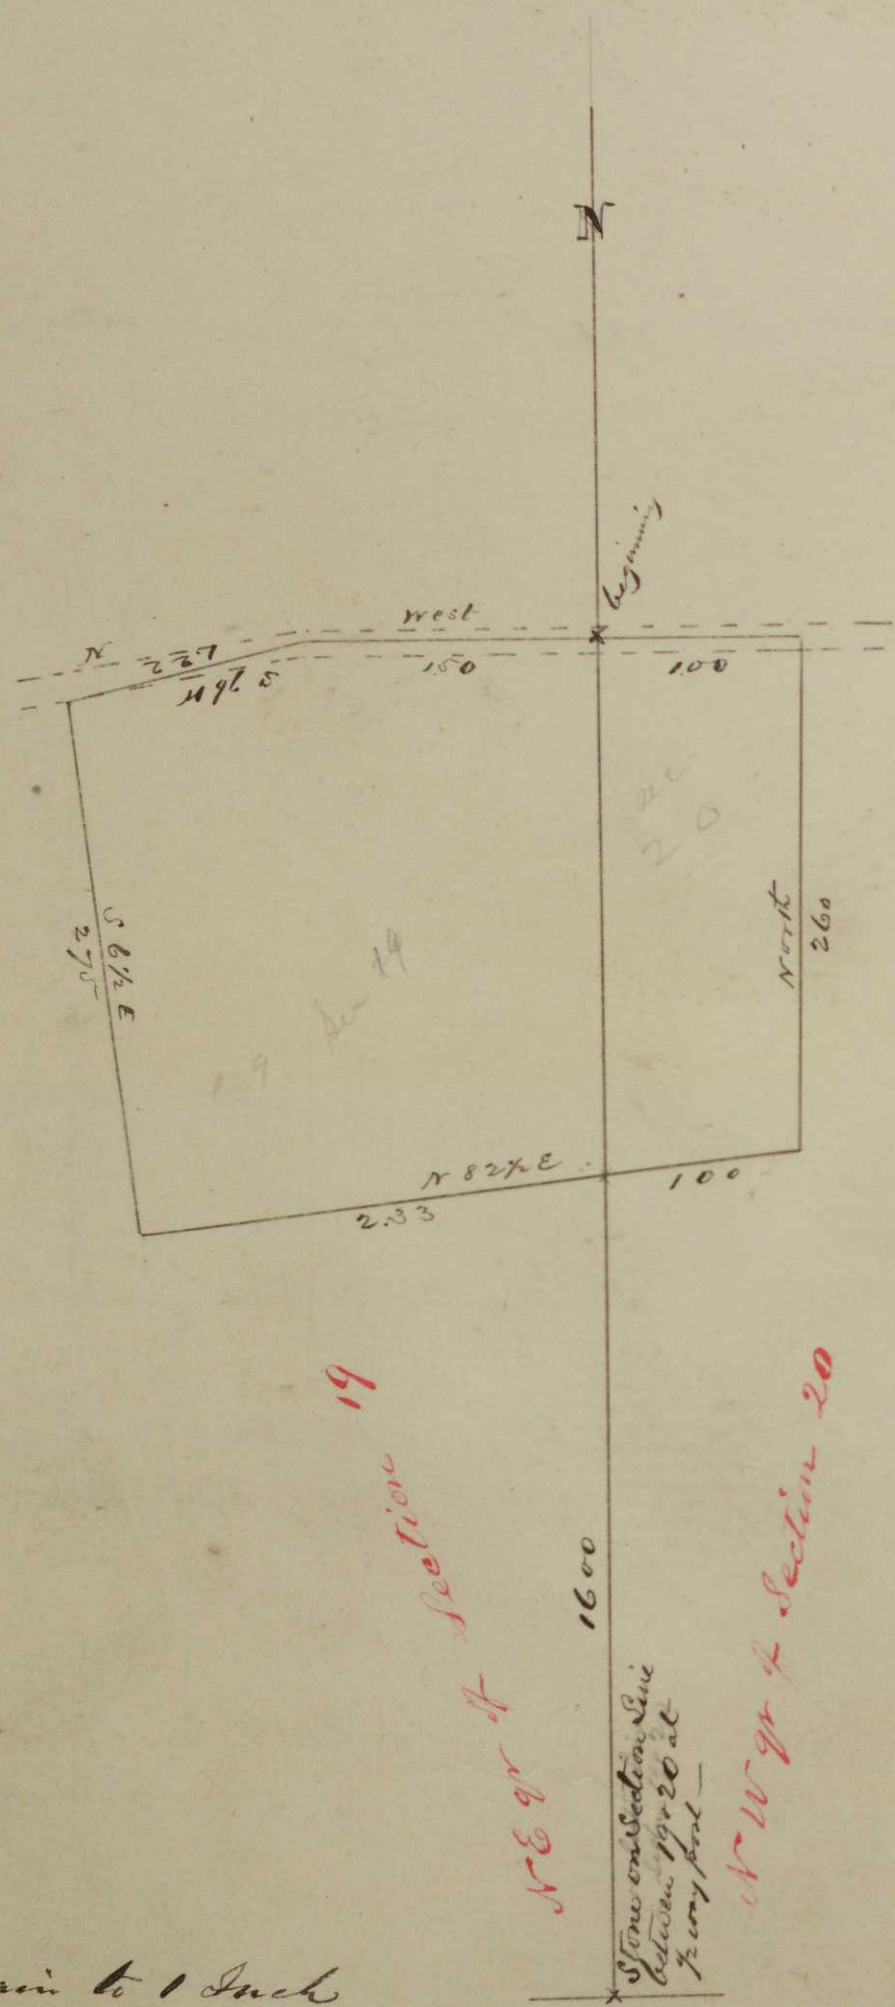


Scale 1 chain to 1 Inch

Survey of Lot for School House on the Merriam Farm in Section 19 and 20 Township 12 Range 12 Harrison Sp. June 15th 1886 -

Fred Howell
County Surveyor

132

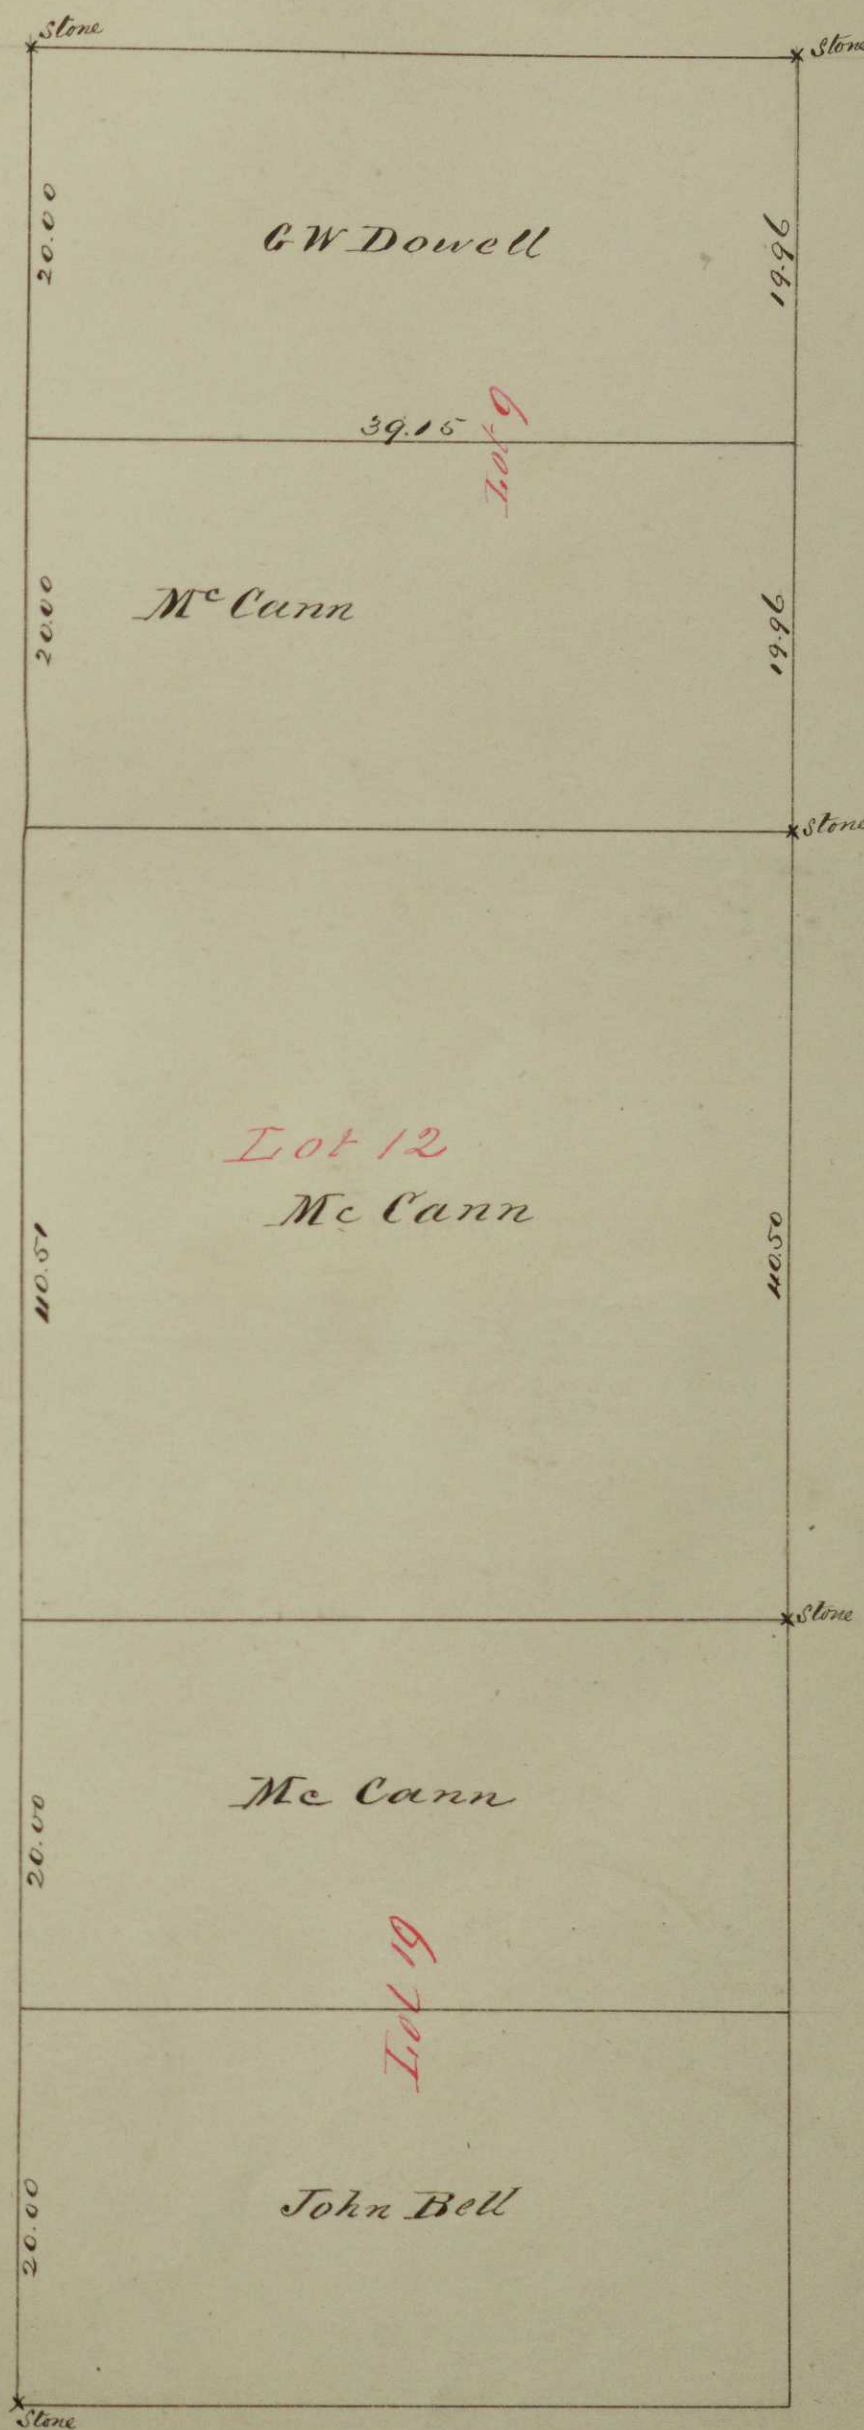





Scale 10 chains to an Inch

Survey of Lands of J H McCann Lots 9, 12 and 19 of 3rd quarter of T3 R8. Cass Sp. Muskingum County Ohio June 1st 1886 -

A. Estowell } Chainman
J A McCann }
J A McCann } Marker
G W Dowell }
C Eichorn } Flagman
Howard Slack }

Fred Howell
County Surveyor


163

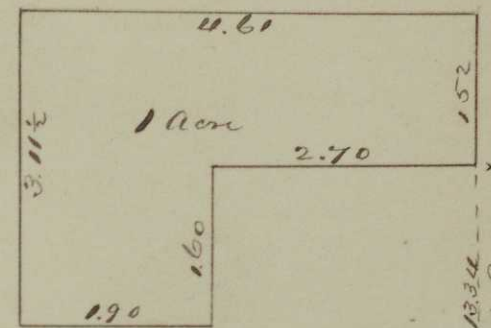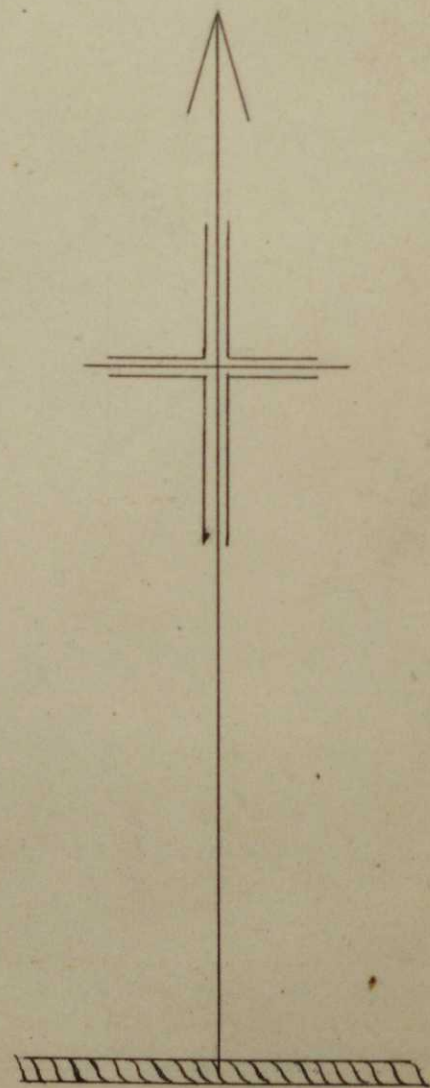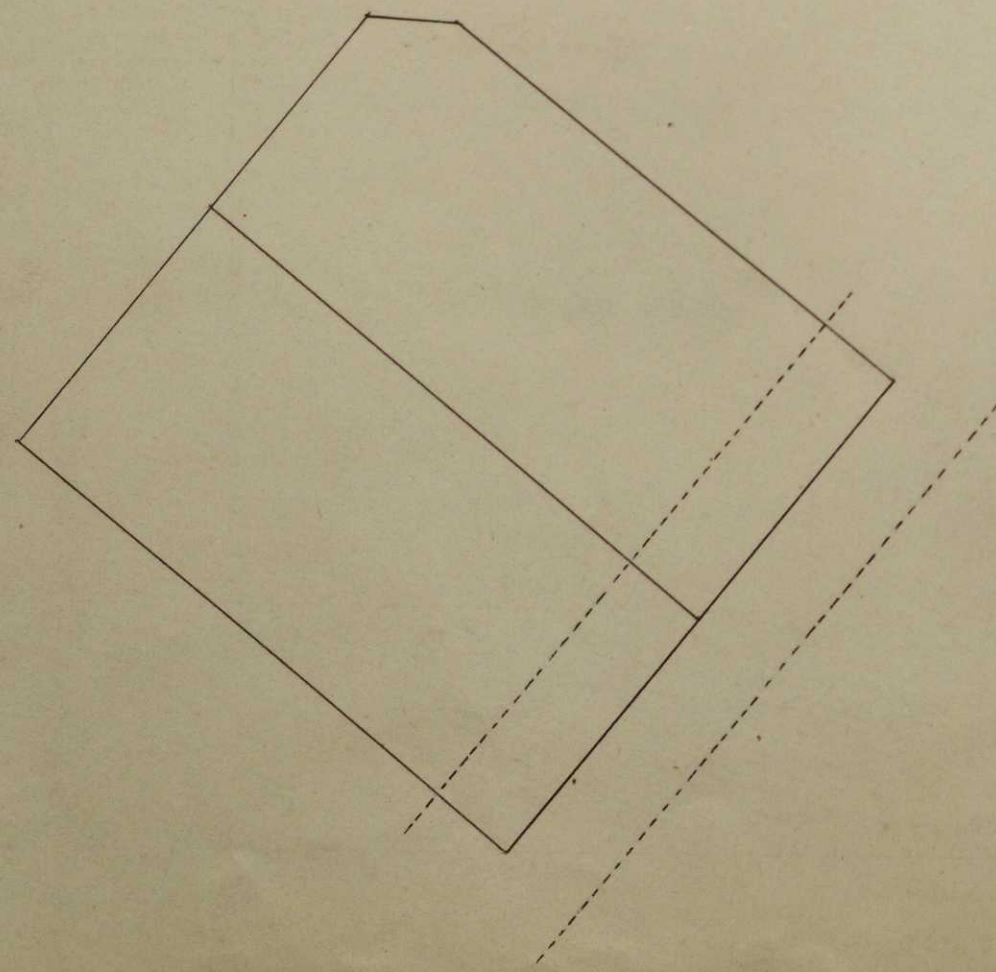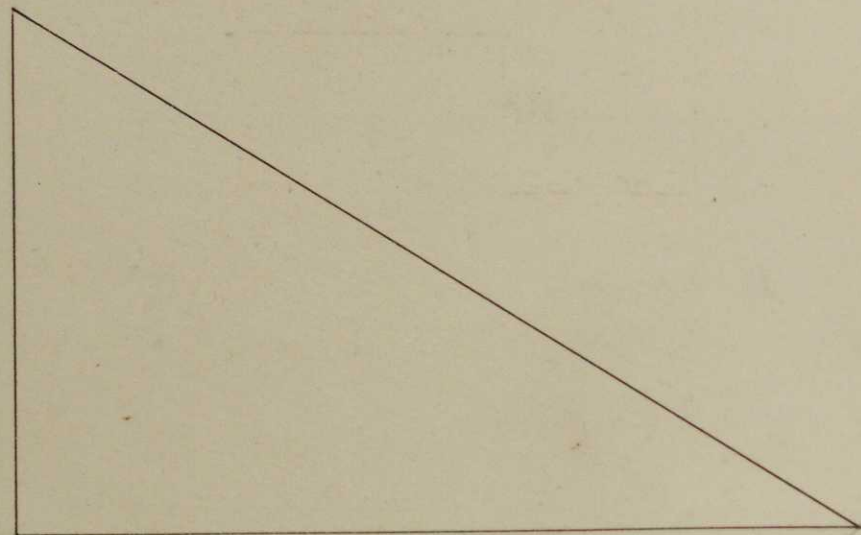

Stone S.E. Cor of S.W. 1/4 Sec 6.

Survey of a part of the South West quarter of Sec 6 31 Range 6 - Perry Township
 Scale 2 Chs to an Inch for J.C. Harris
 Jos Fisher Jr
 Deputy Co Sur

112

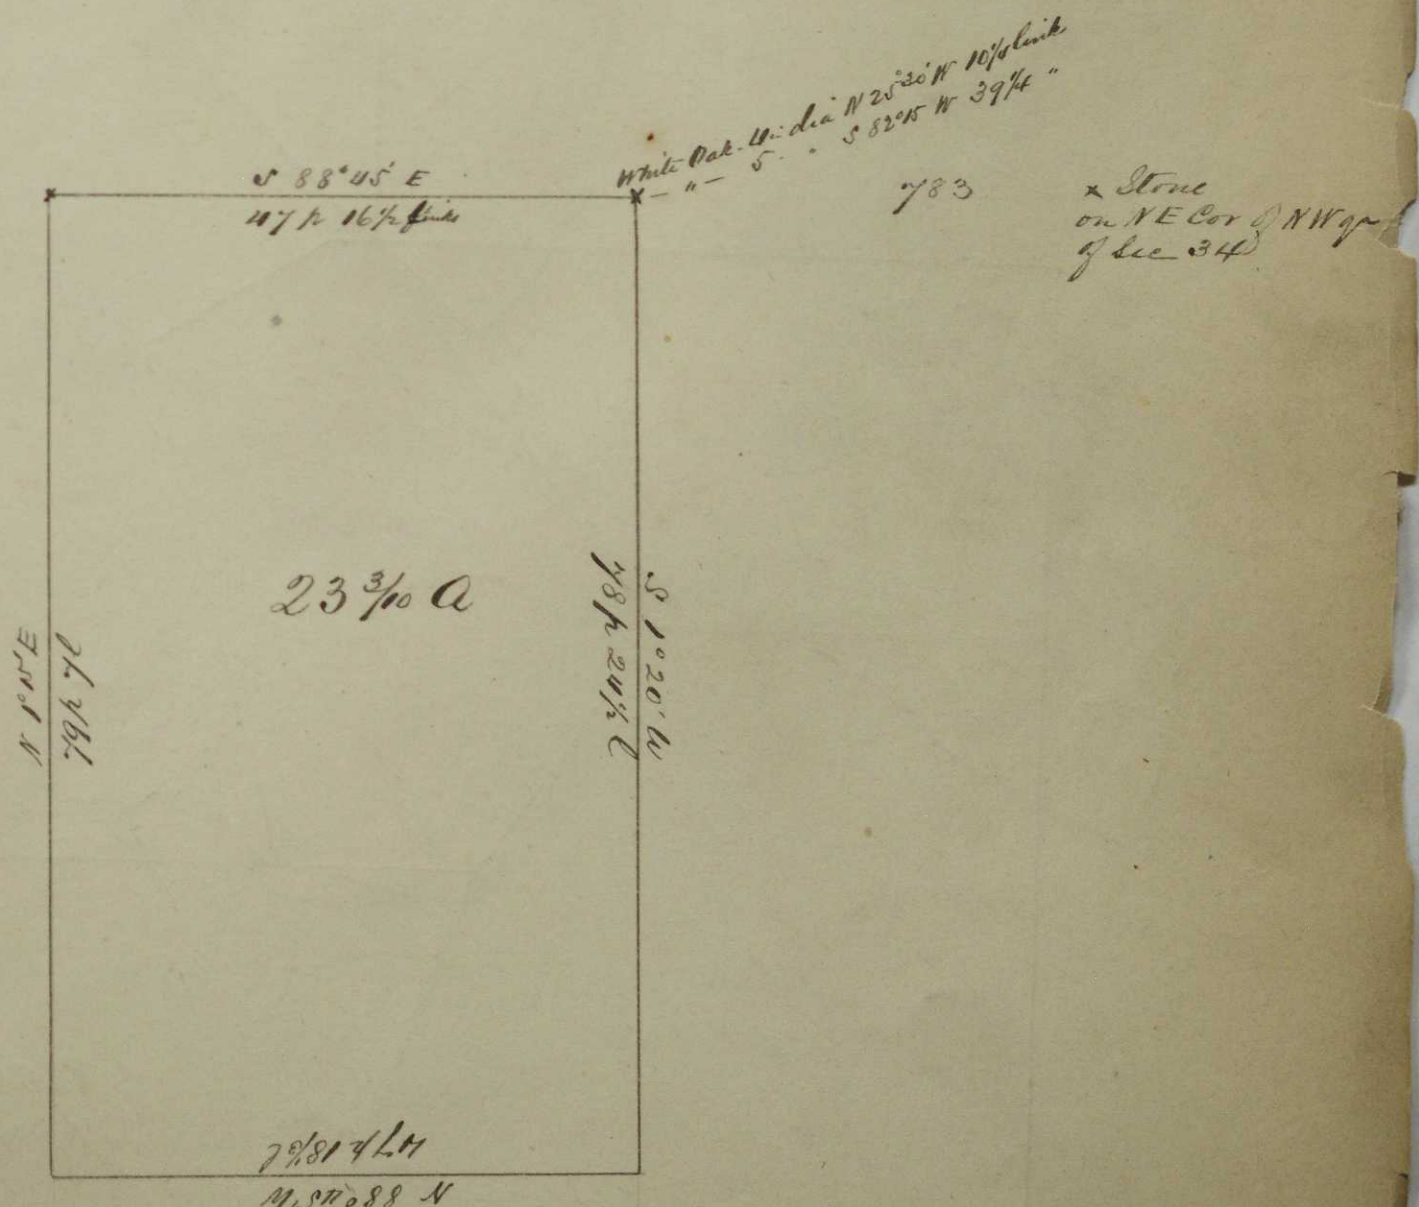


Scale 2 Chas to an Inch

Survey of part of North West quarter of Sec 34 - Township 13 Range 12
 Salt Creek Township Nov 8 1886
 for Eugene McDonald
 Josephus Clapper
 Louis B. Harmon } Chancery
 Fred Howell
 County Surveyor

112

Survey of Part of the Peter Fletcher Farm for widows
Dower (and Plat of Chas Roberts Survey)
Jan 27 1887

Fred Howell
County Surveyor

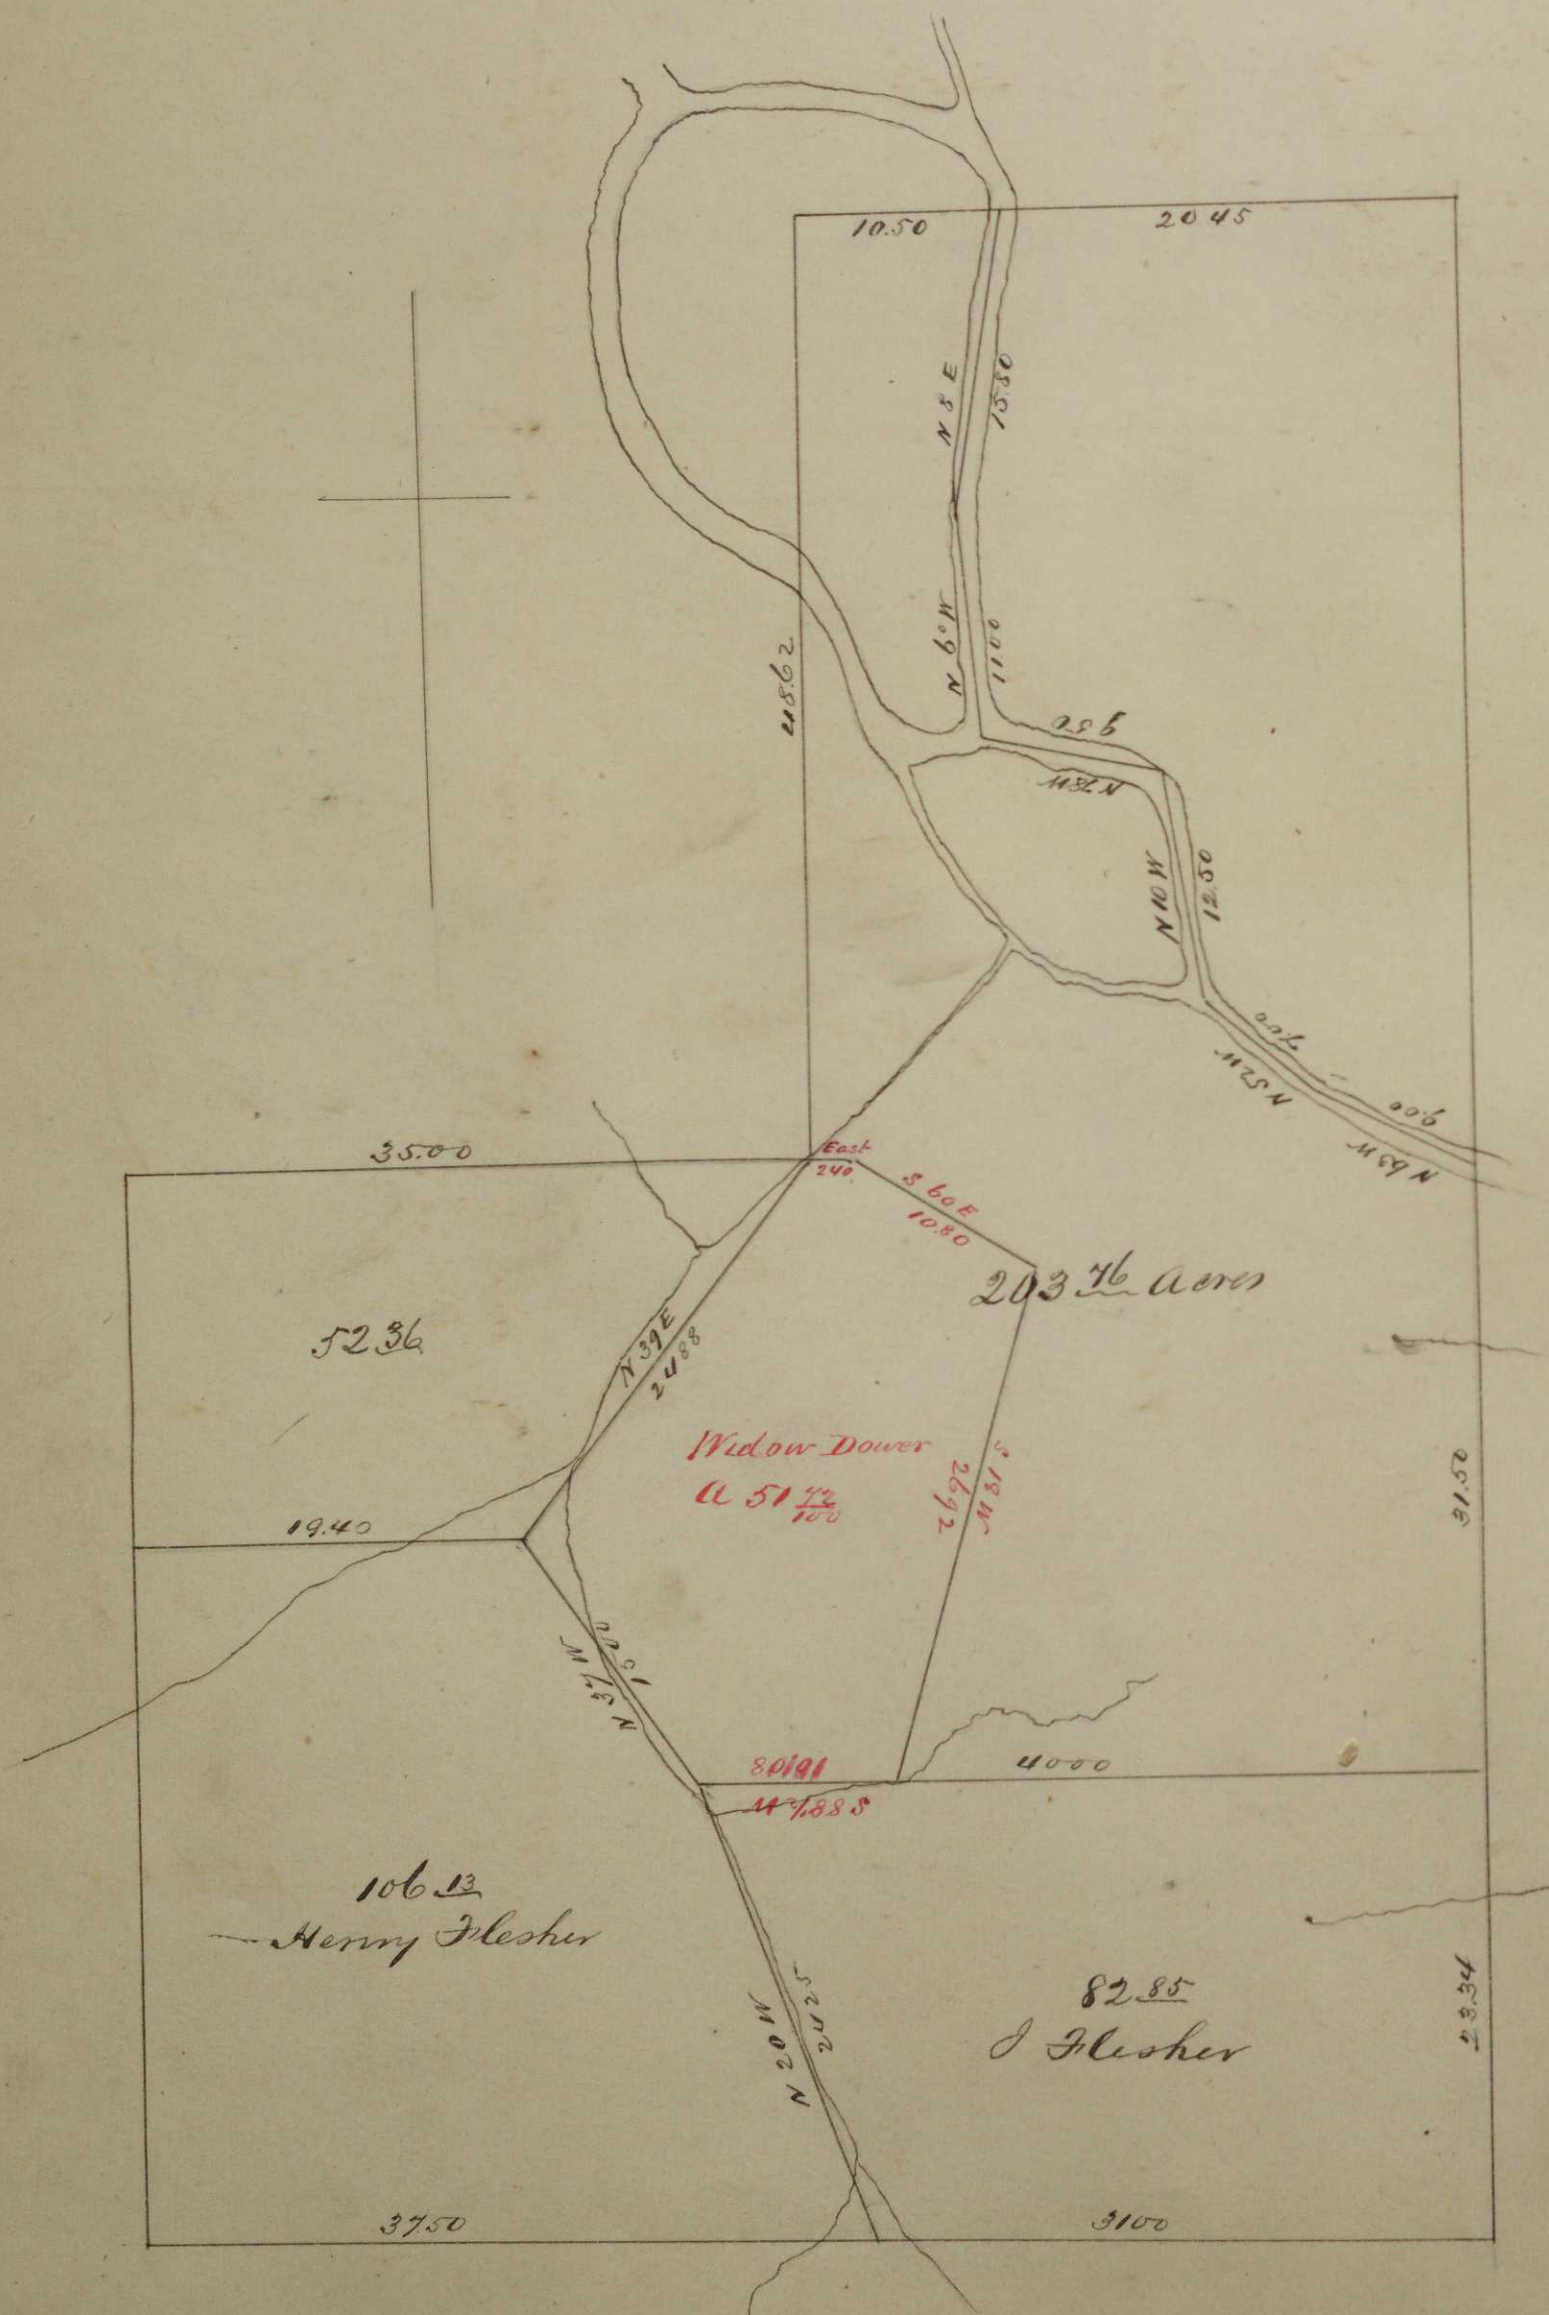


Scale 10 chains to an Inch

Rec'd for Recording to date 2.12

Survey of a part of Sec 9
T 12 R 12 Blue Rock Tp
for Mary & Stephen Finley
and Saml Davis.


Jos Fisher Dep
Scale 6 Chains to an Inch
Jan 1887
Var from Original Survey
3° 15' West

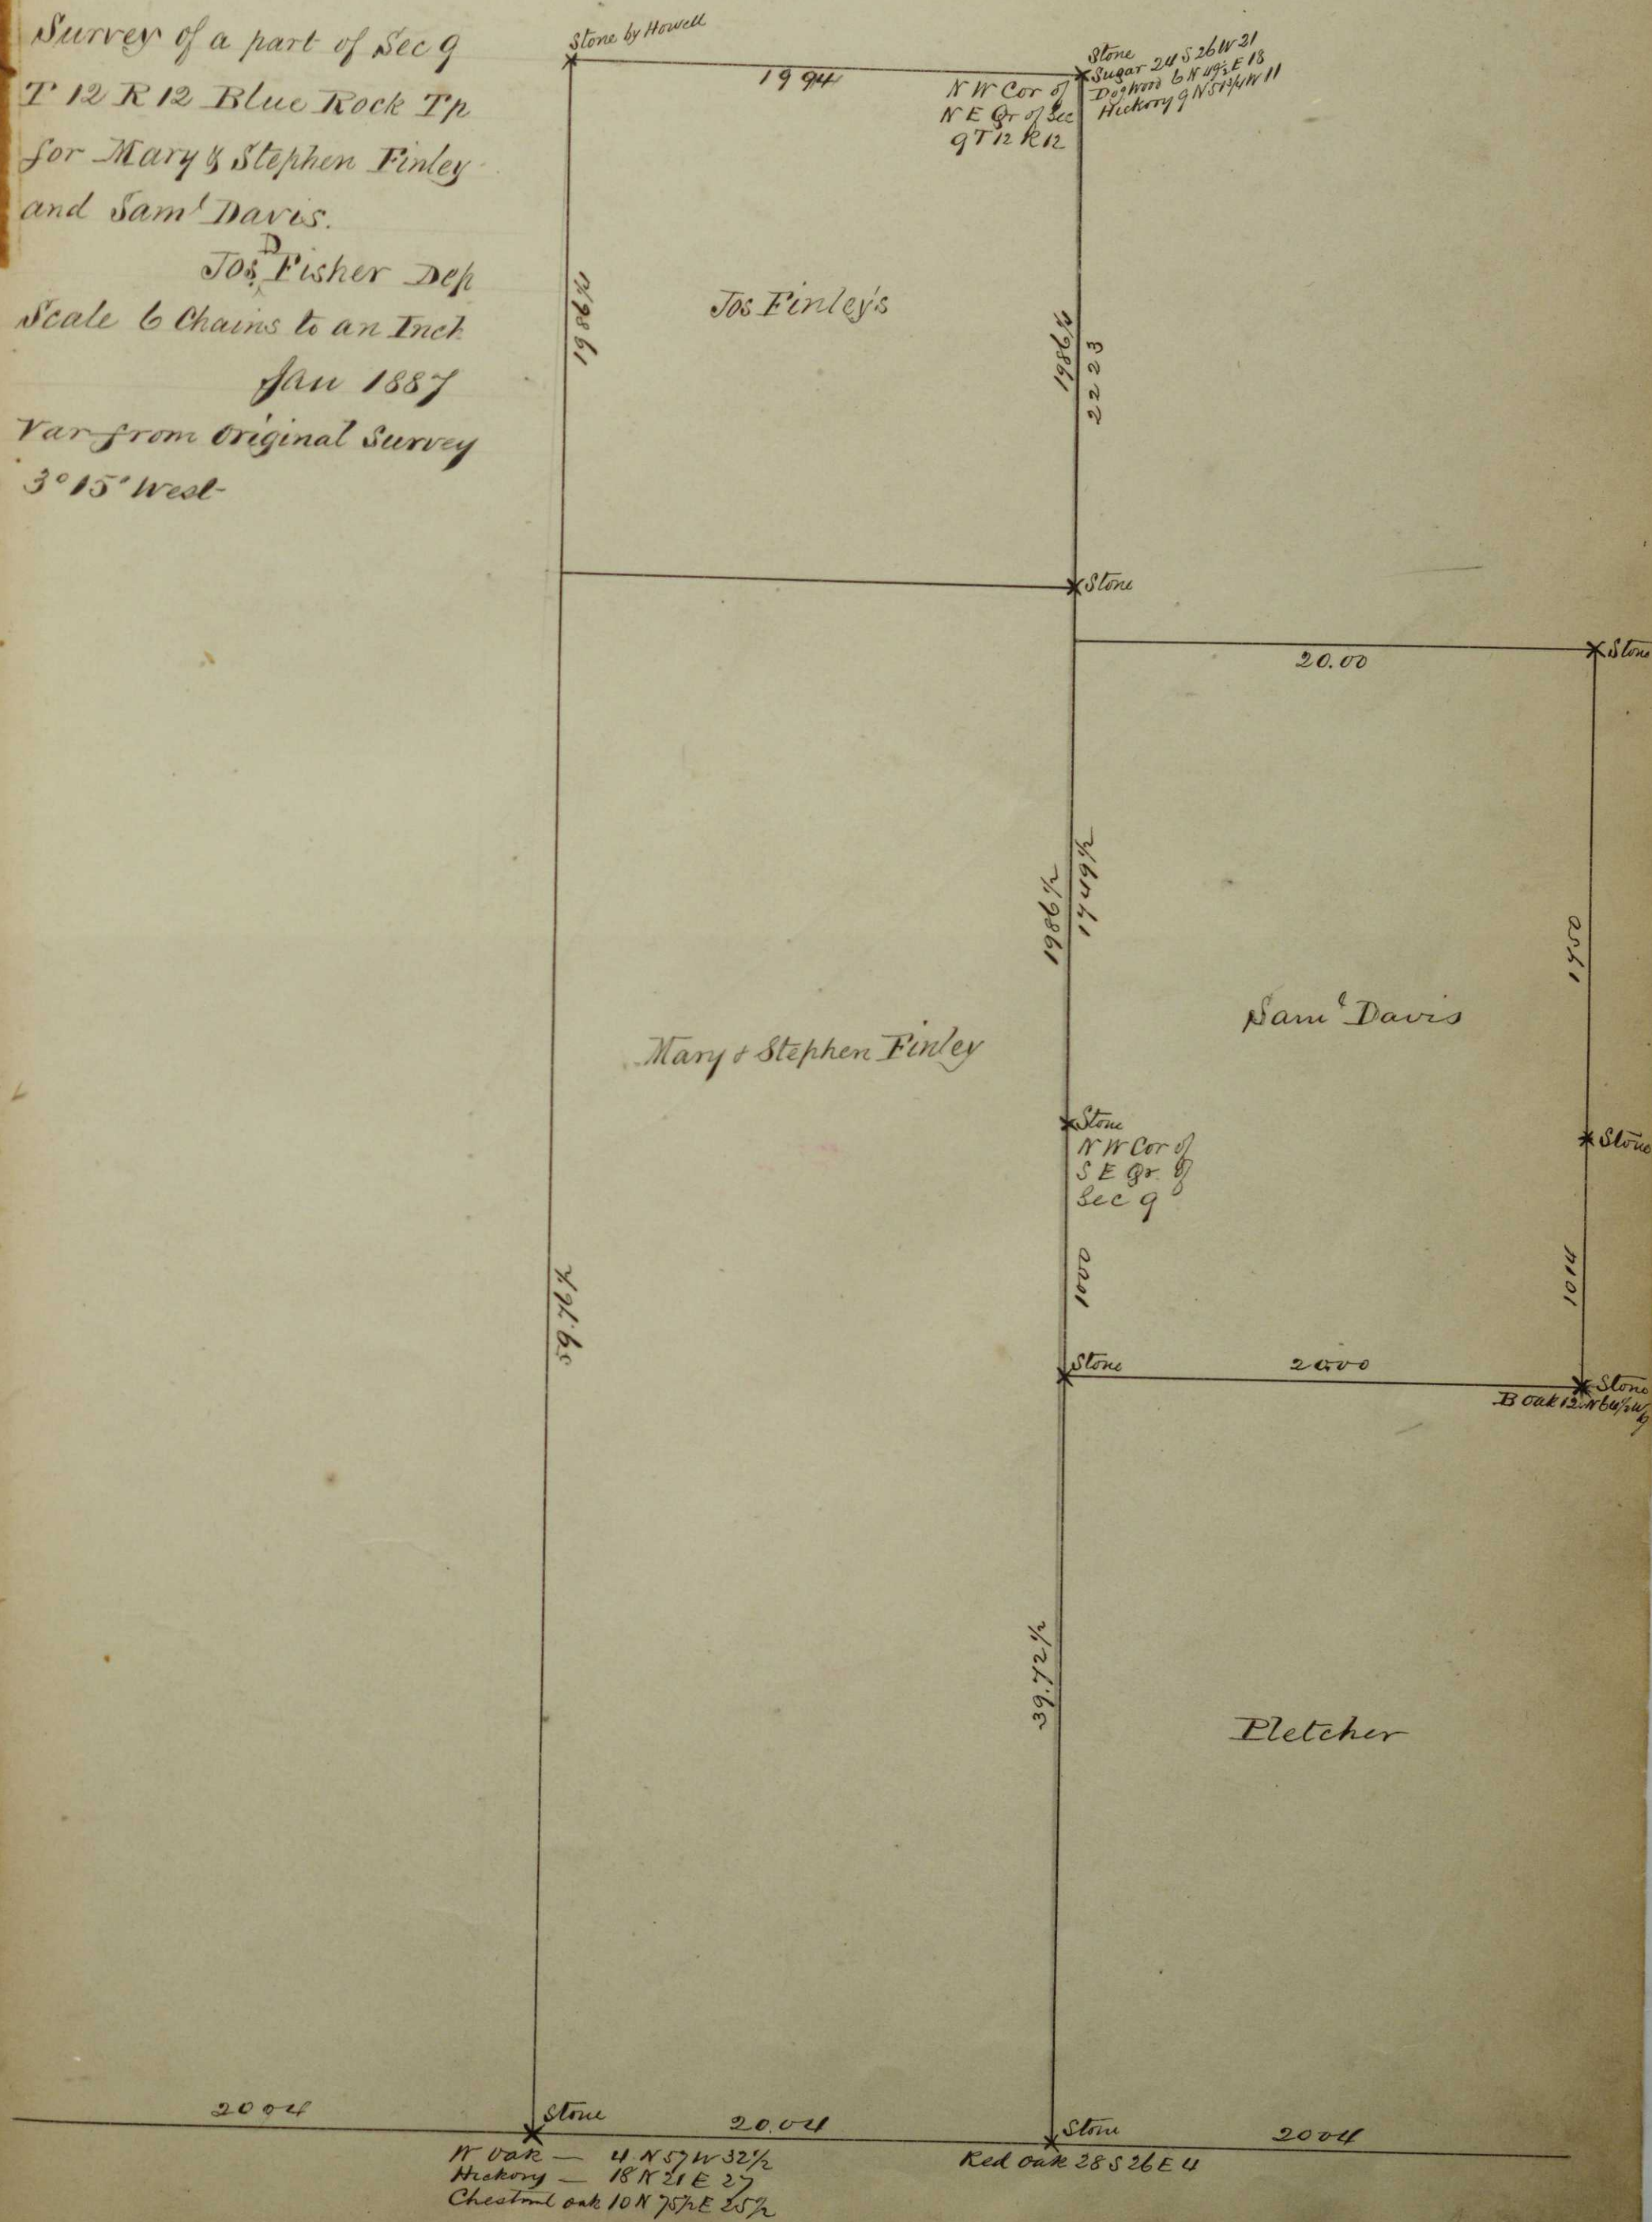


Scale 2 Chains to an Inch
Var $3\frac{1}{2}^{\circ}$ West

J D Fisher
Deputy Surveyor

March 29th 1887

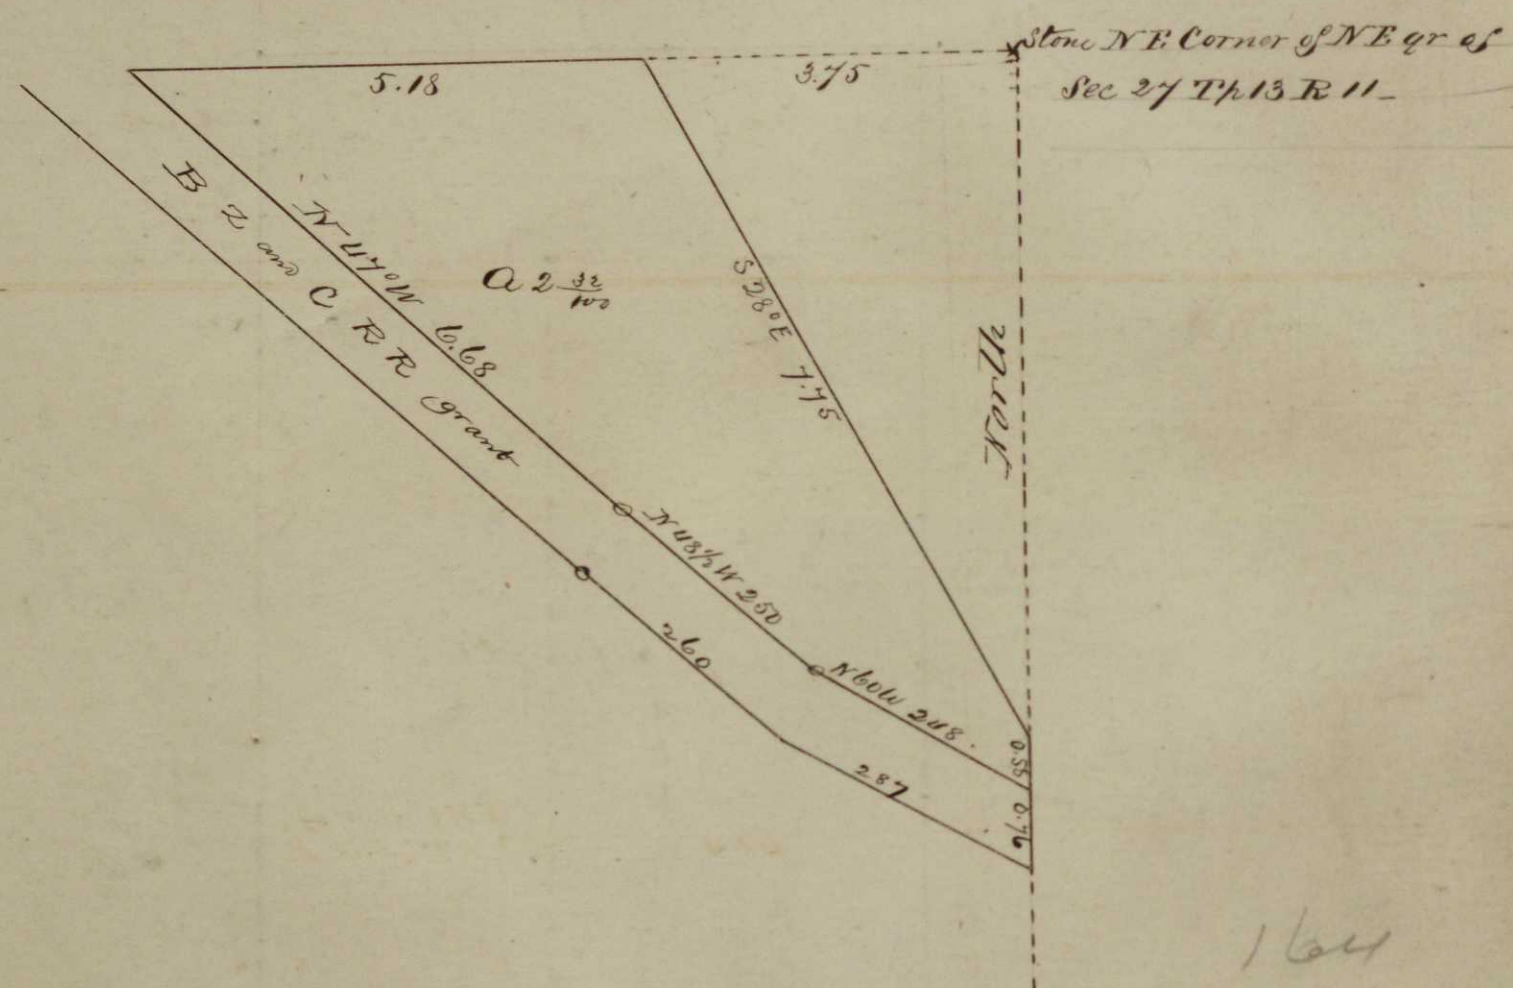

1644

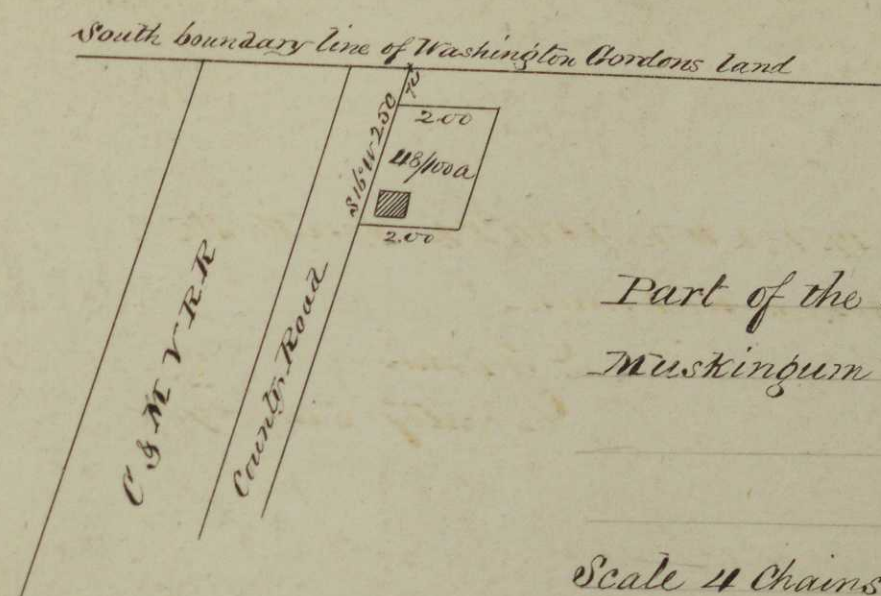


Part of the North West qr of Sec 3 T^h 14 R^h 14 Clay T^h.
Muskingum County OHIO. for Eldon & Co. Penna.

J D Fisher
Deputy Surveyor

Scale 4 Chains to an Inch.
Variation 3° West.

June 14th 1887.

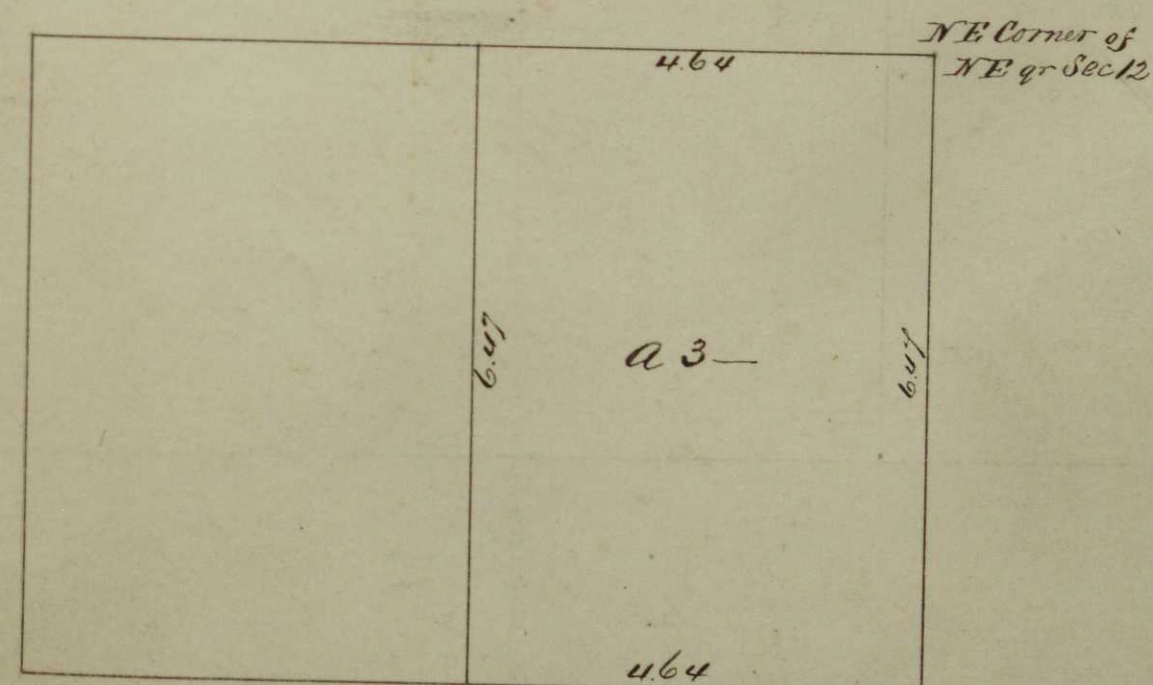

Part of the North East quarter of Sec 12 Tp 11. Range 13 Brush Creek Twp
surveyed August 1887 for Valentine Eichman and Dan Hock.


Scale 2 Chains to an Inch.

Var $3\frac{1}{2}^{\circ}$ West

J. D. Fisher
Deputy Surveyor—

Stone NW Corner of the
SE qr of Sec 17 T3R6

Jacob H. Hanks
83 $\frac{13}{100}$ Acres

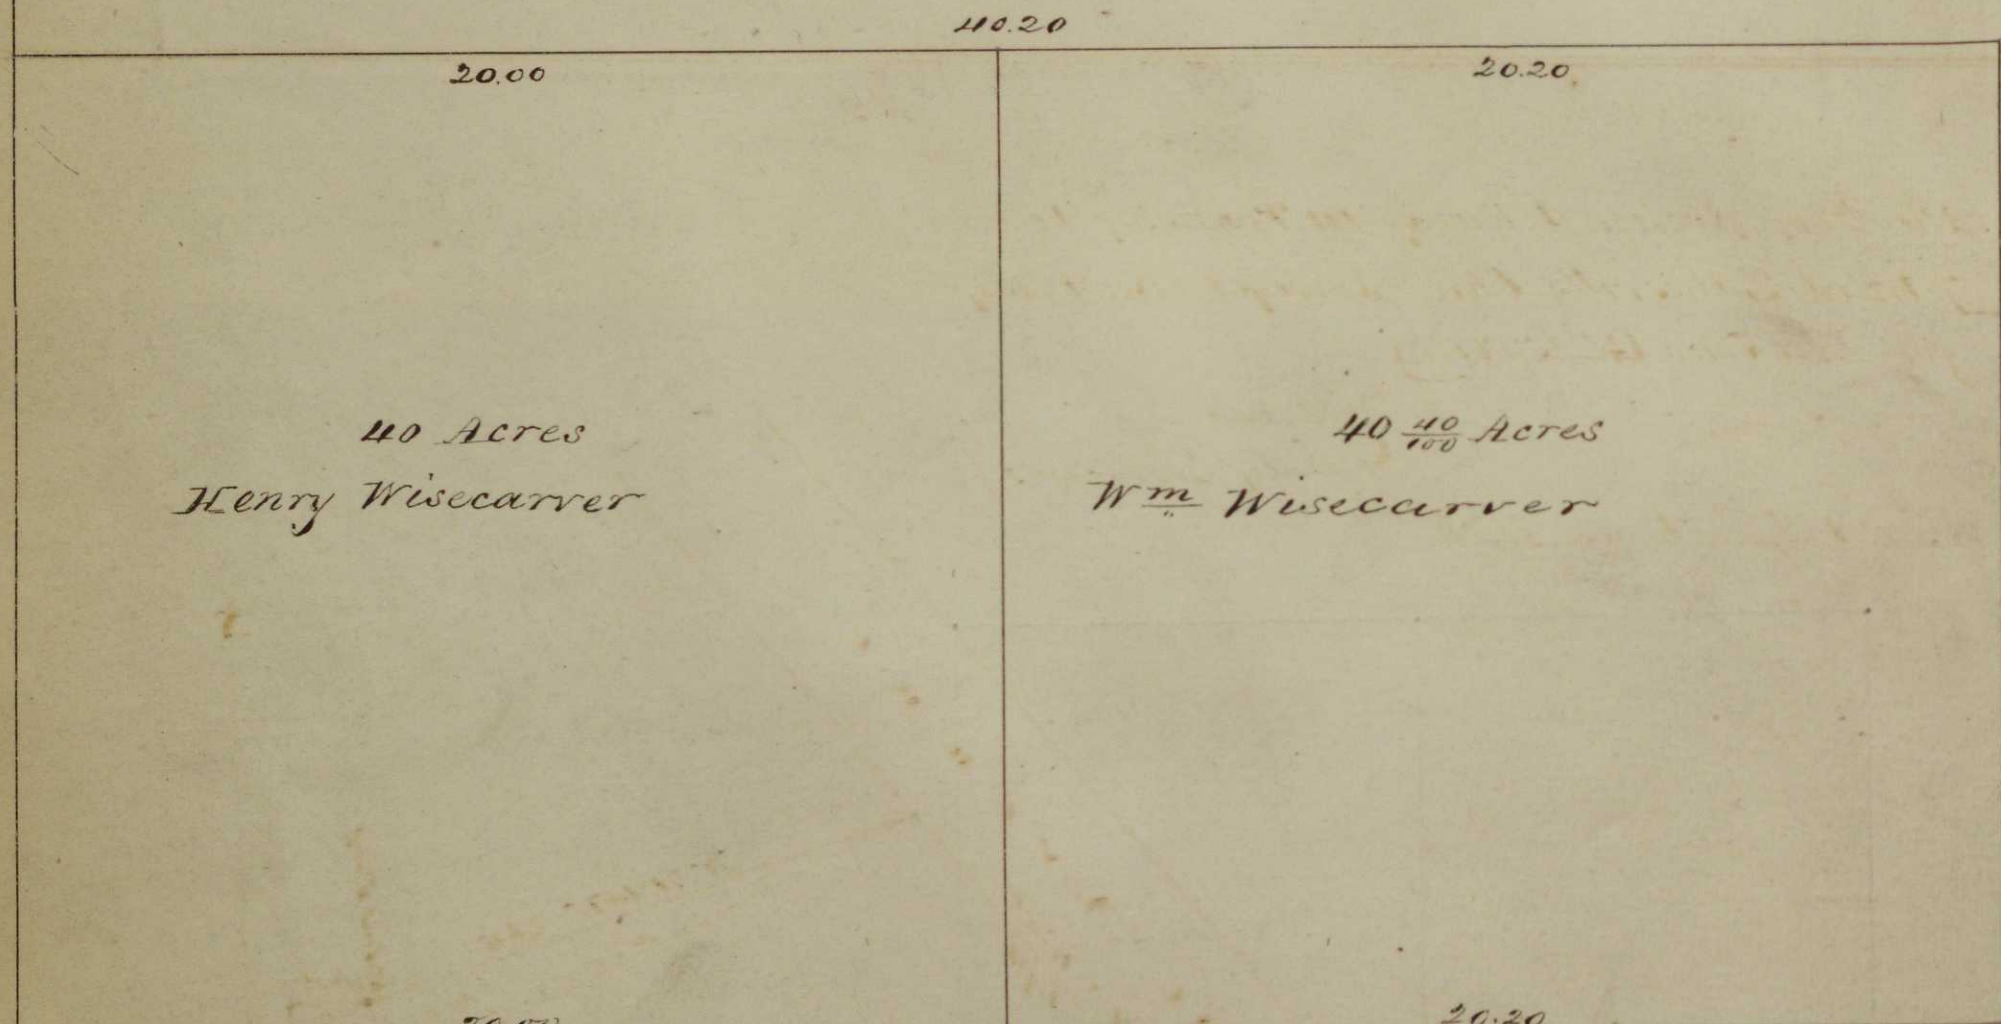

Stone SW Corner of the
SE quarter of Sec 17 T3R6

Survey of the South Half of $\frac{1}{4}$ Sec 17 Township 3 Range 6 Adams Township

September 1st 1887

Var 3° West

Scale 4 Chains to an Inch

J. D. Fisher
Deputy Surveyor

134

Part of the South West quarter of Sec 8 T12R13 Wayne Tl


Surveyed August 3rd 1887 for Saml McGinness and

Wm W Crozier

Scale 2 Chains to an Inch

Var 3° West

J. D. Fisher
Deputy Surveyor

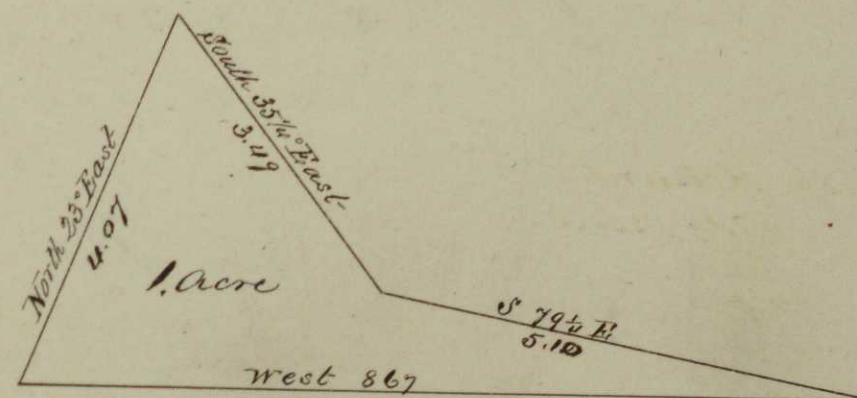

112


Part of Section 1 Range 14 Township 16

7 Ward Lanesville Ohio Surveyed Dec 1st 1887

for Mrs John Goldsworthy

J. D. Fisher
Deputy Surveyor

Scale 1 Chain to an Inch

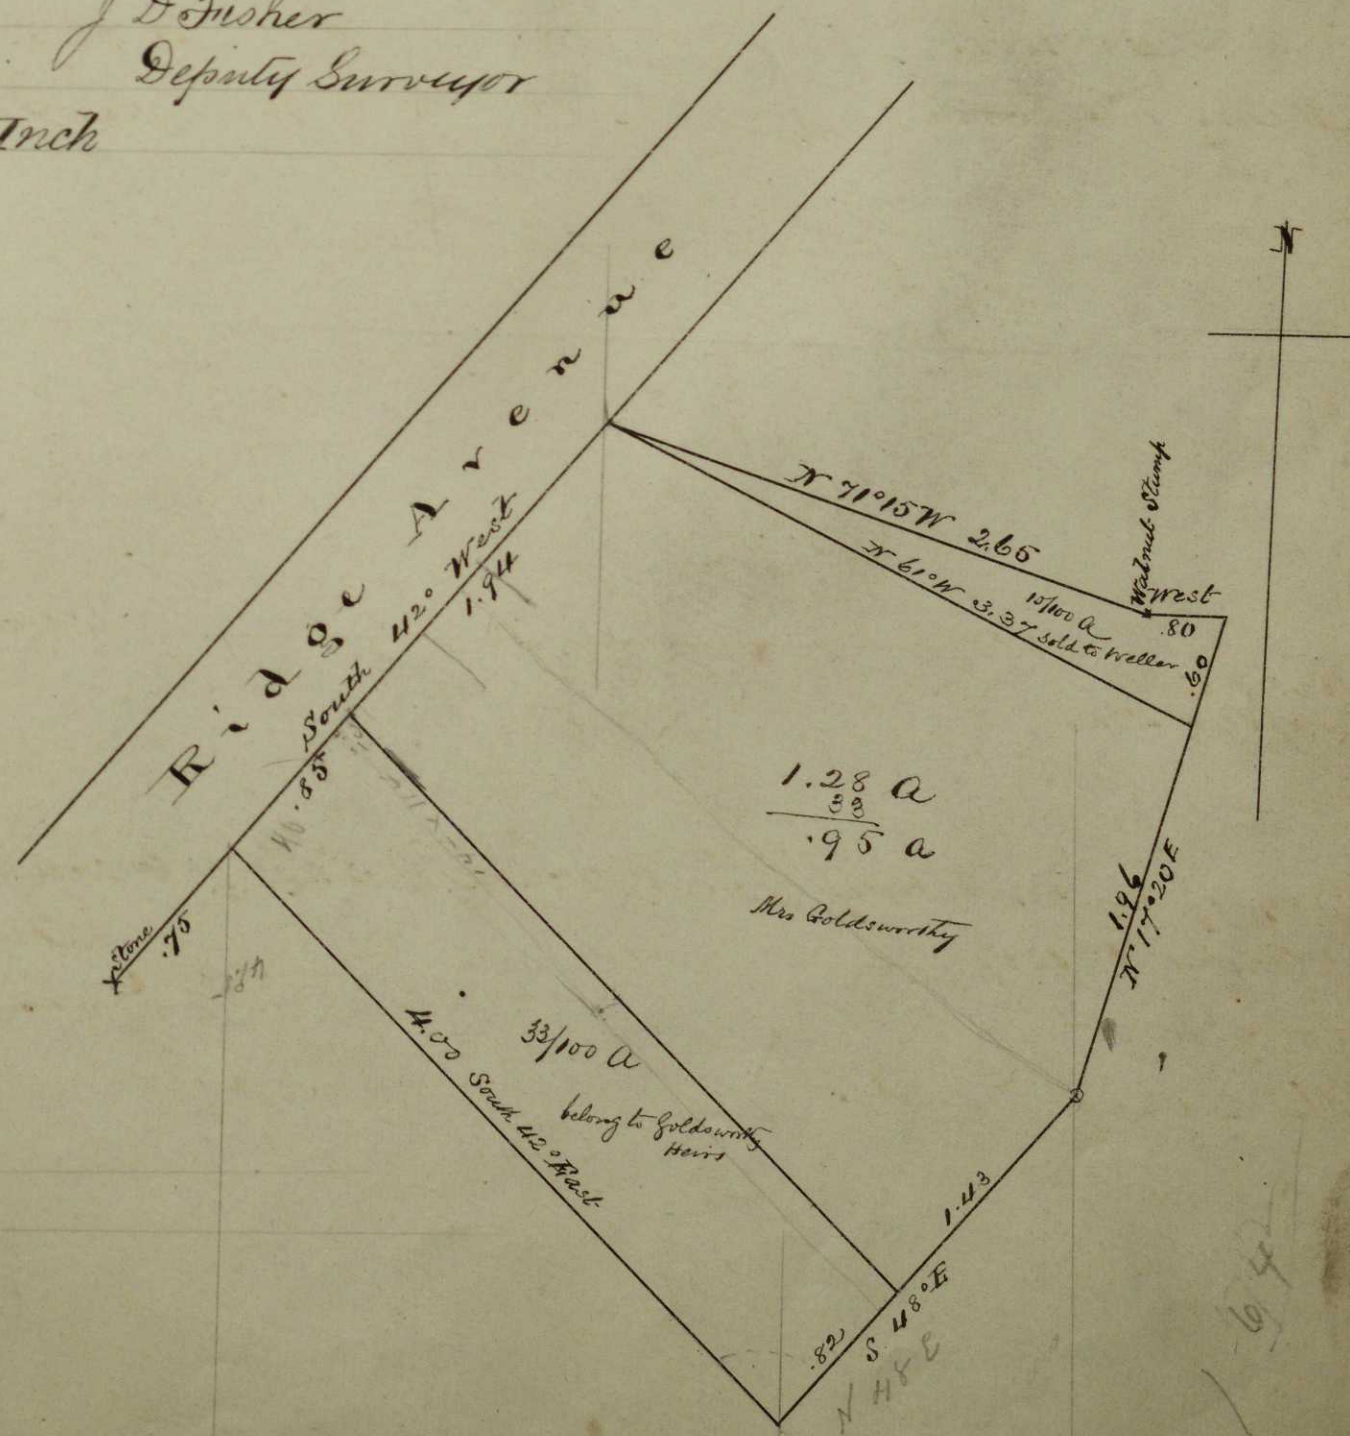



164

Survey of a part of the South East quarter of the 11th
 quarter of Township 2 Range 9 Tricking Township
 Muskingum County OHIO for Gershon Vandebark
 February 25th 1887.

Frank Howell
 County Surveyor

Var 3° West


Scale 4 Chains to an Inch

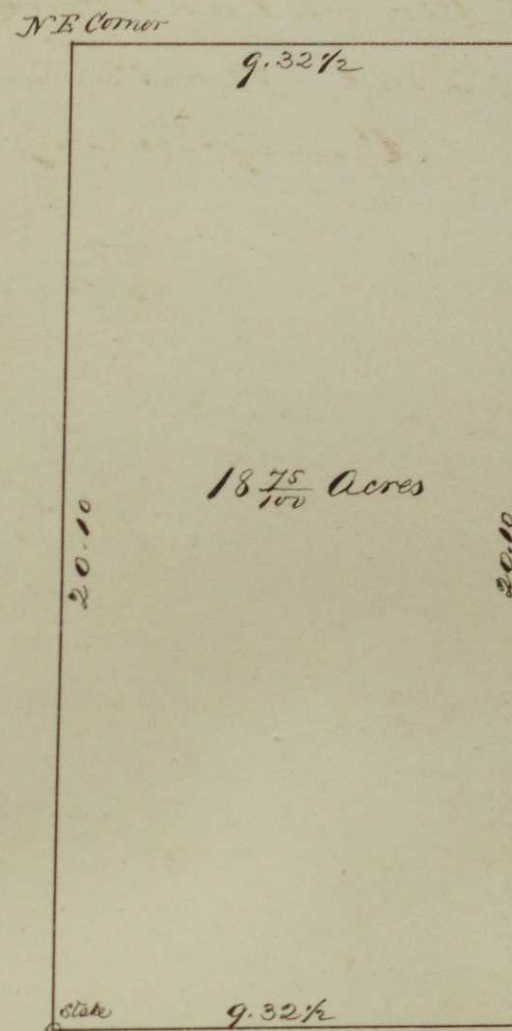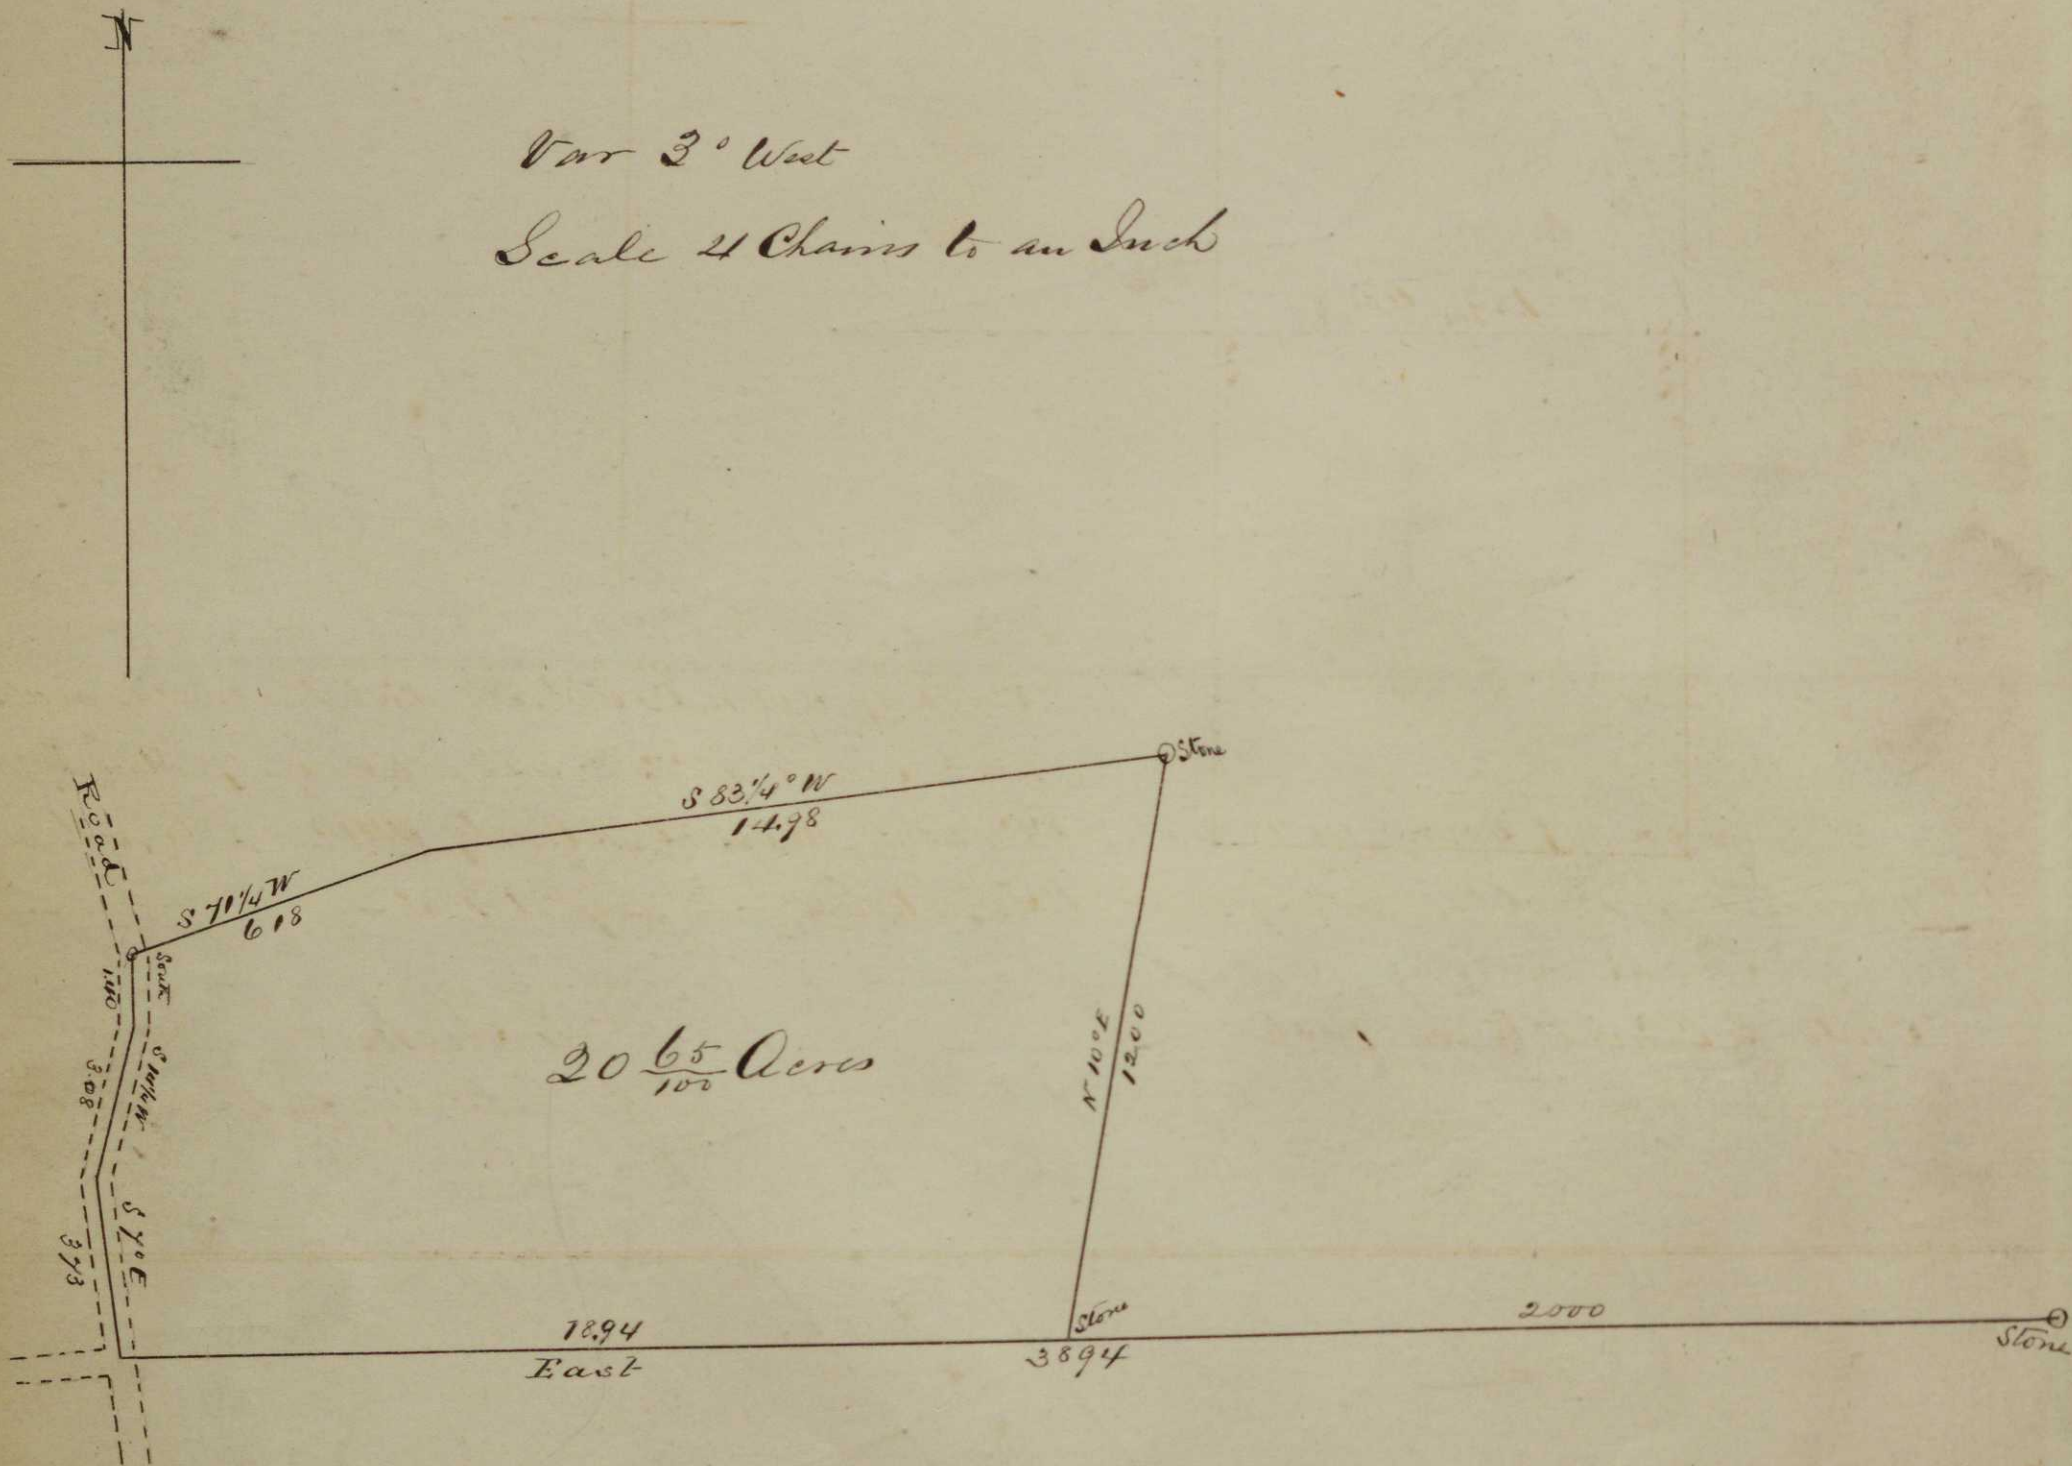

Part of John Crabtree's Estate in the South
 West Corner of Township 2 Range 7 Muskingum
 Township Muskingum County OHIO - Surveyed for
 John Kelley - Jan 11th 1887.

Scale 4 Chains to an Inch


J. D. Fisher
 Deputy Surveyor

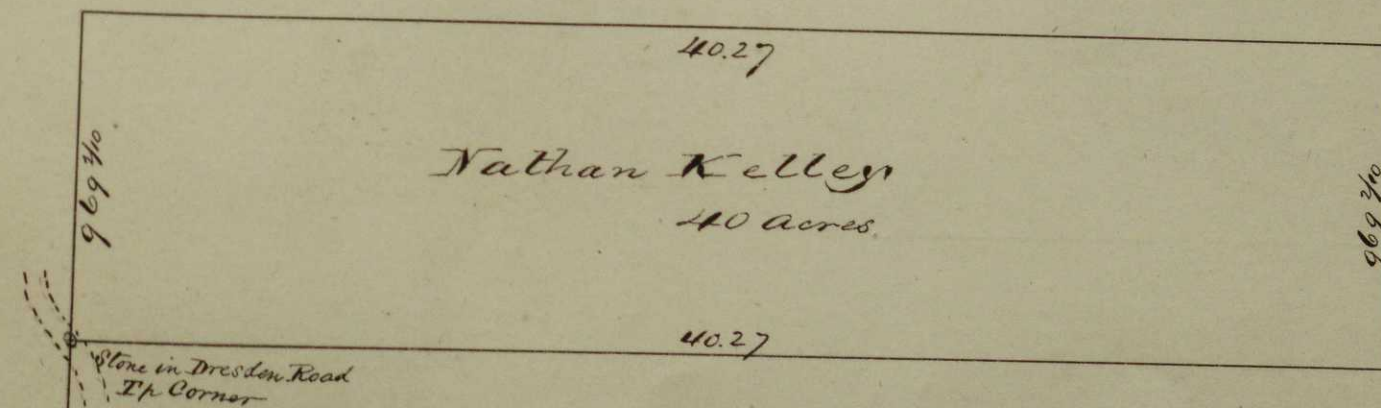


Part of the John Crabtree Estate in the South West Corner of Township
 2 Range 7 Muskingum Township, Muskingum County Ohio - Surveyed for
 Nathan Kelley Jan 5th 1887.

Scale 6 Chains to an Inch

J. D. Fisher
 Deputy Surveyor

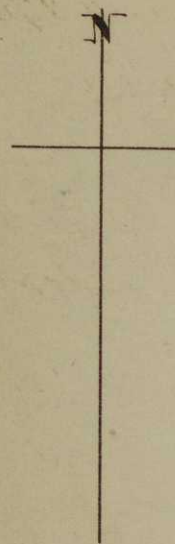

Part of the South West quarter of Section 16 Township 13
Range 11 - Rich Hill Township - Muskingum County OHIO

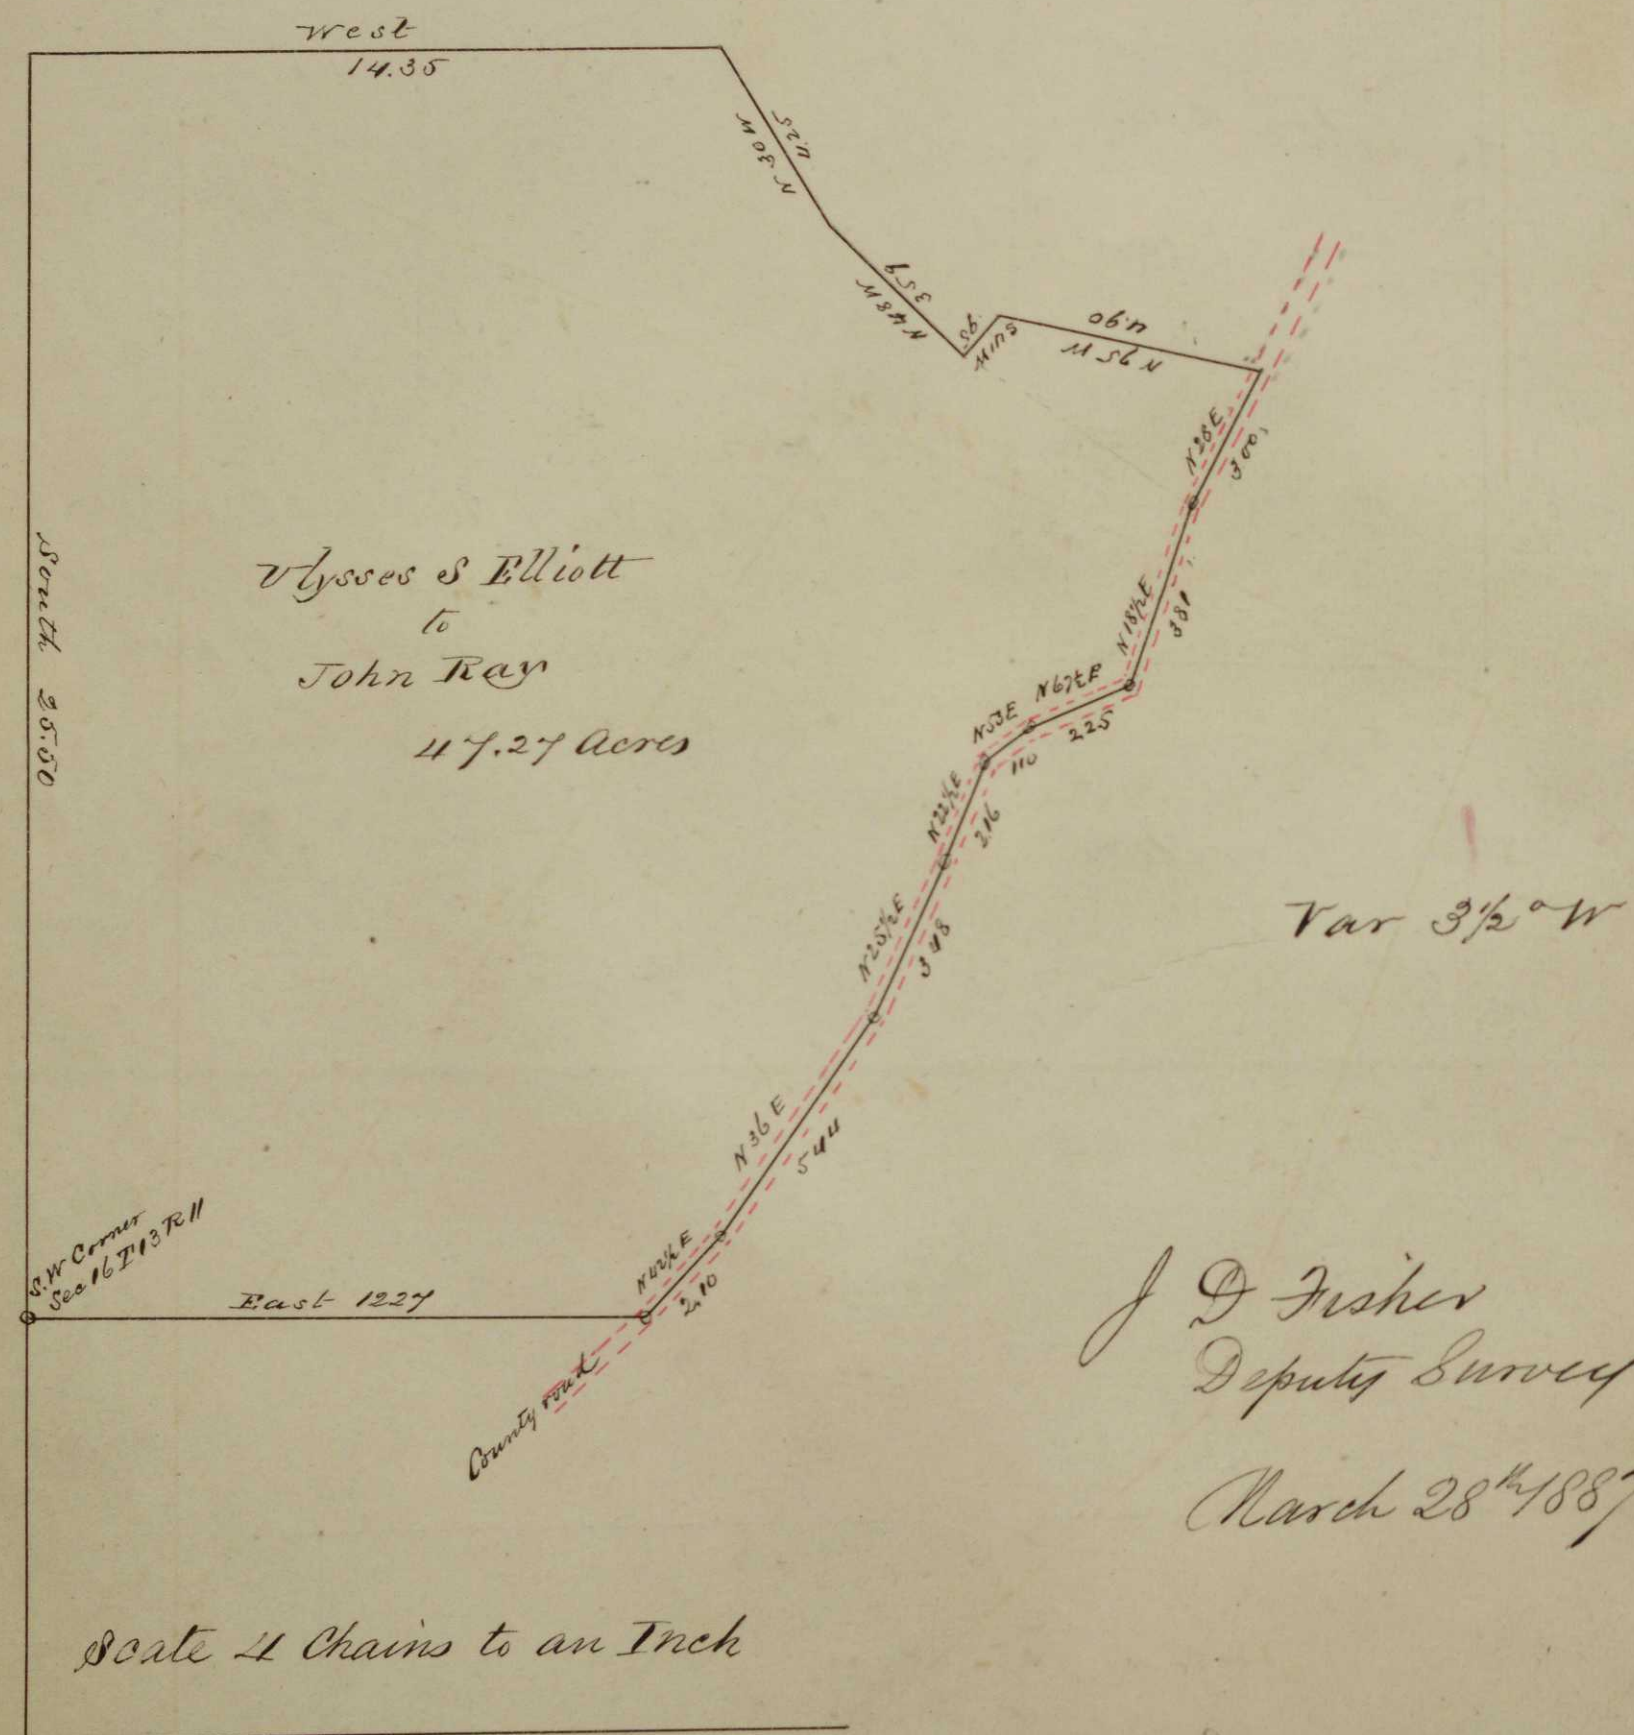


J. D. Fisher
Deputy Surveyor
March 28th 1887

Parts of Lots 18 and 23 in the 1st quarter of Township 1 Range 9 Hopewell Twp
Muskingum County OHIO Surveyed for A. E. Drumm and Hamline
Fairbanks Jan 1st 1887

Variation 3° west


Scale 2 Chains to an Inch

J D Fisher
Deputy Surveyor

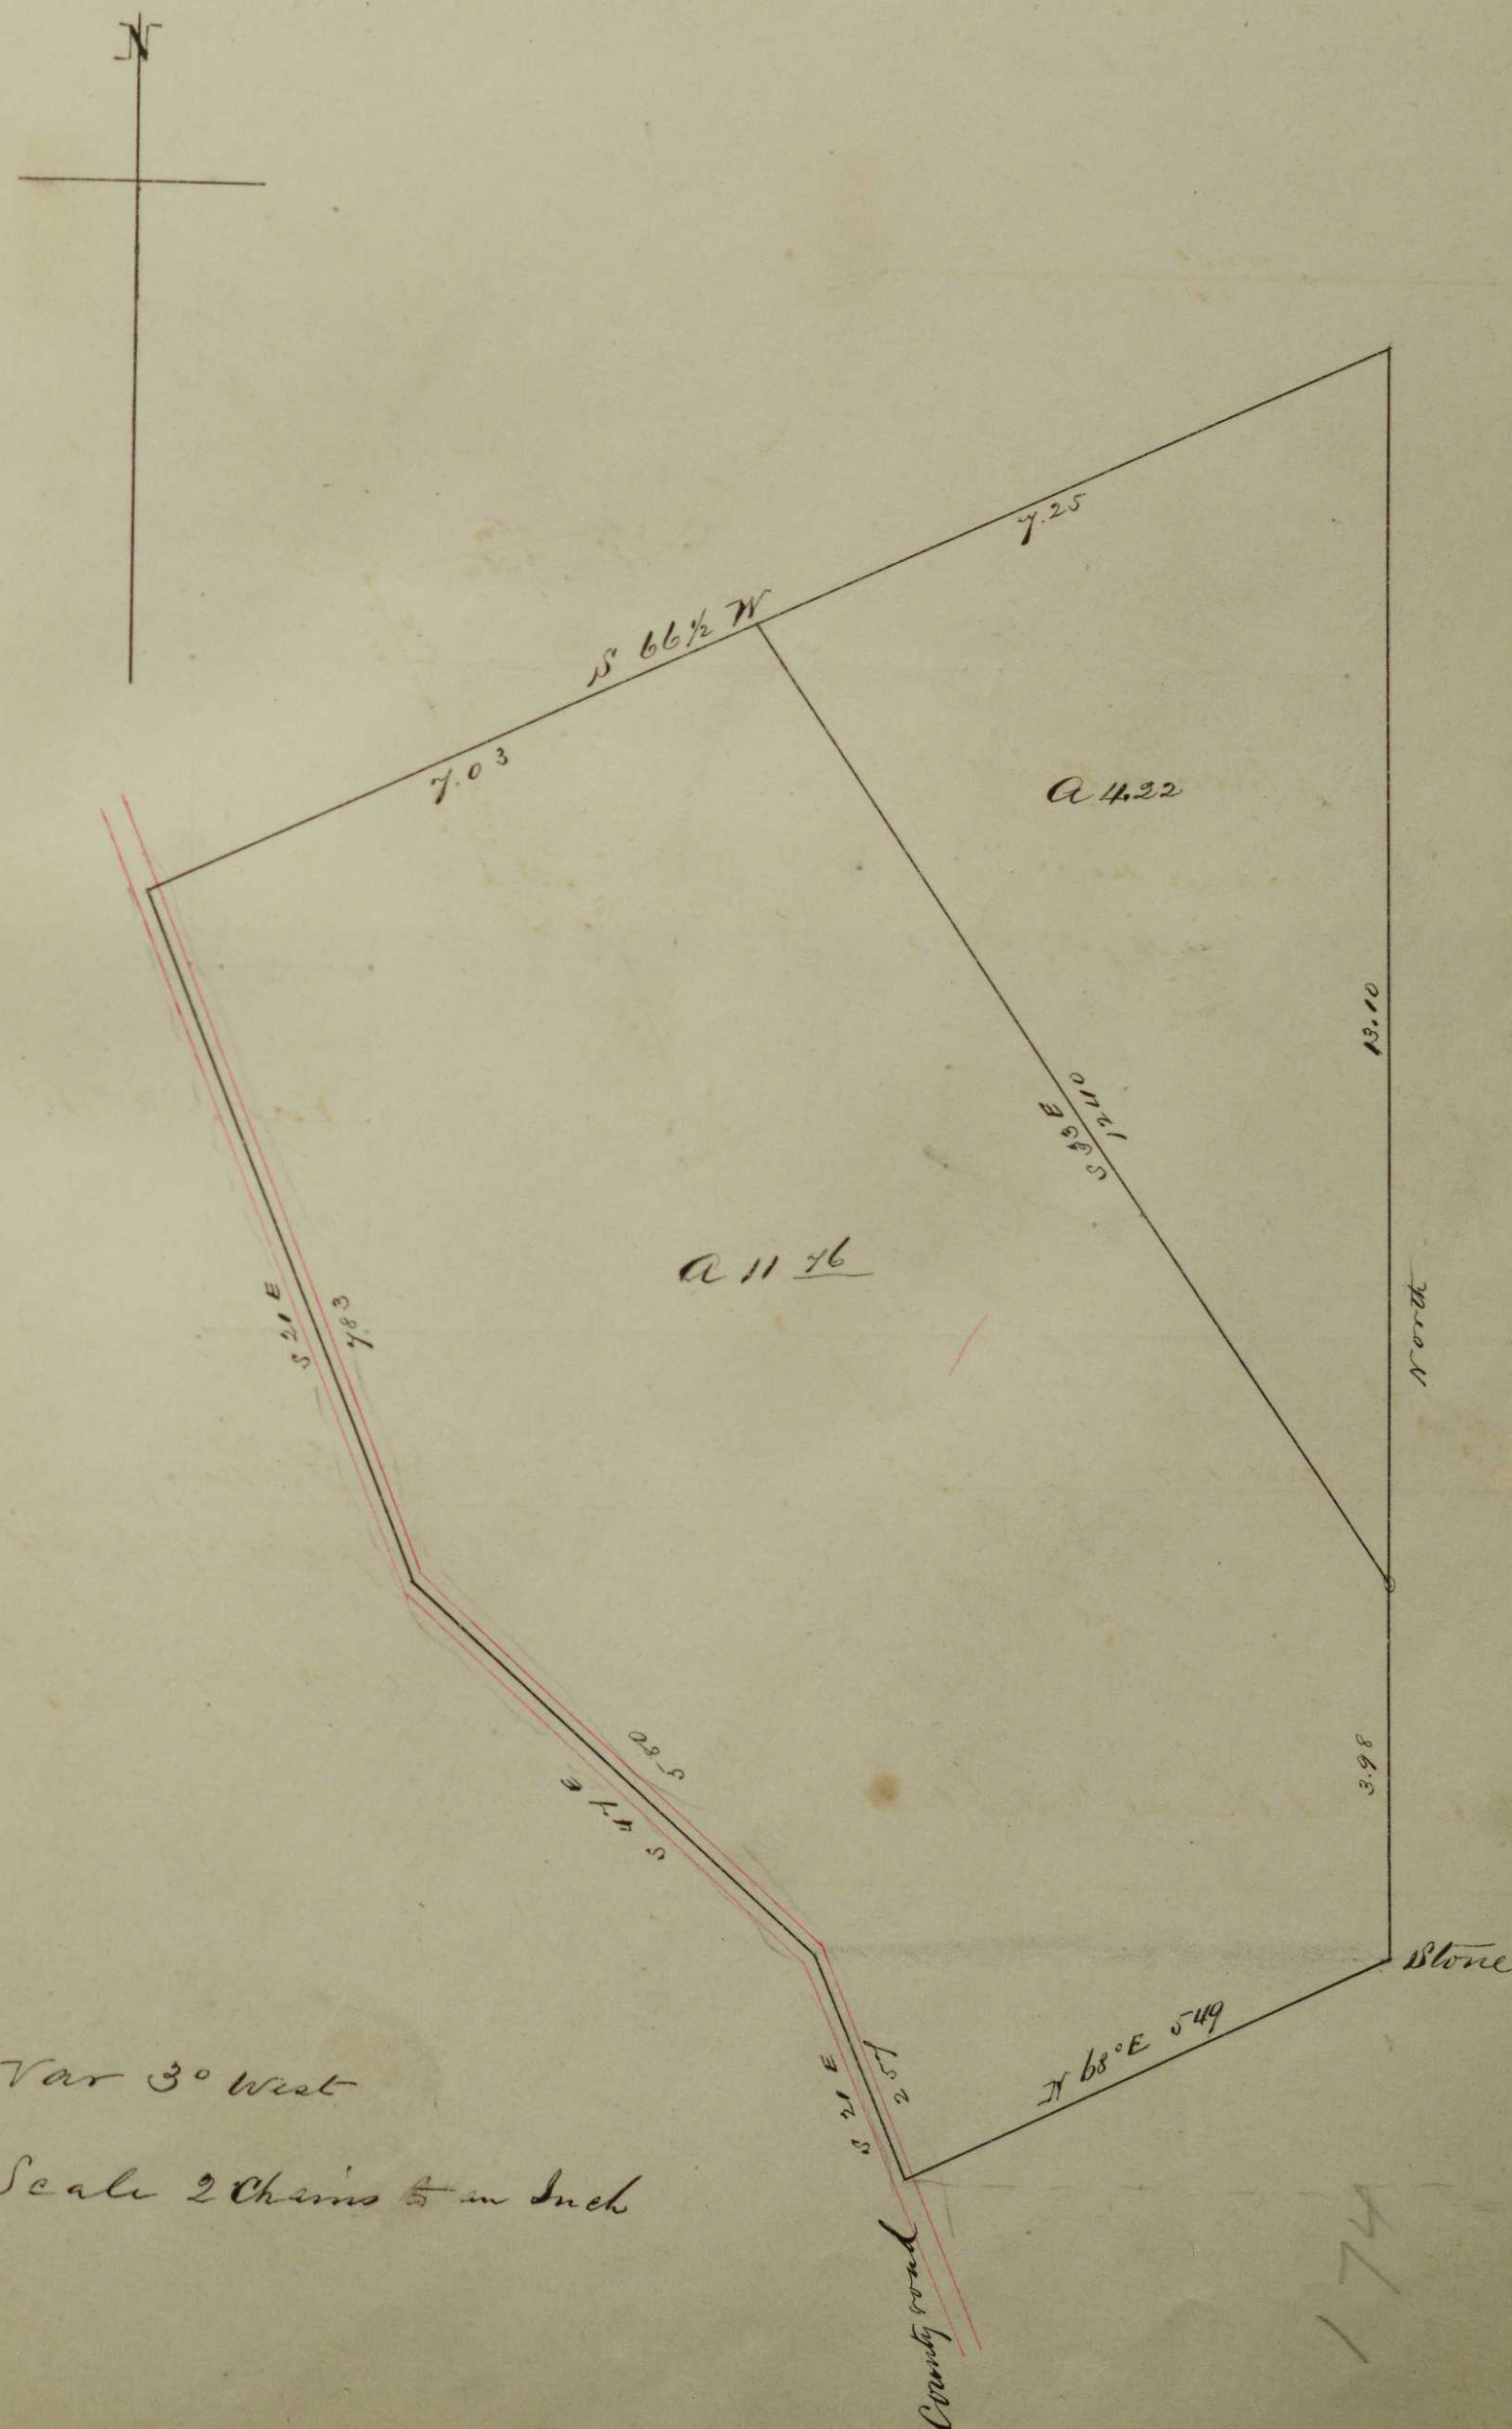

Part of Lot One of Underwoods Sub-div
Township 1 Range 7. Washington Township
Muskingum County OHIO. Surveyed for
James Walworth March 23. 1887.


Var 3.37 west
Scale 6 Chains to an Inch

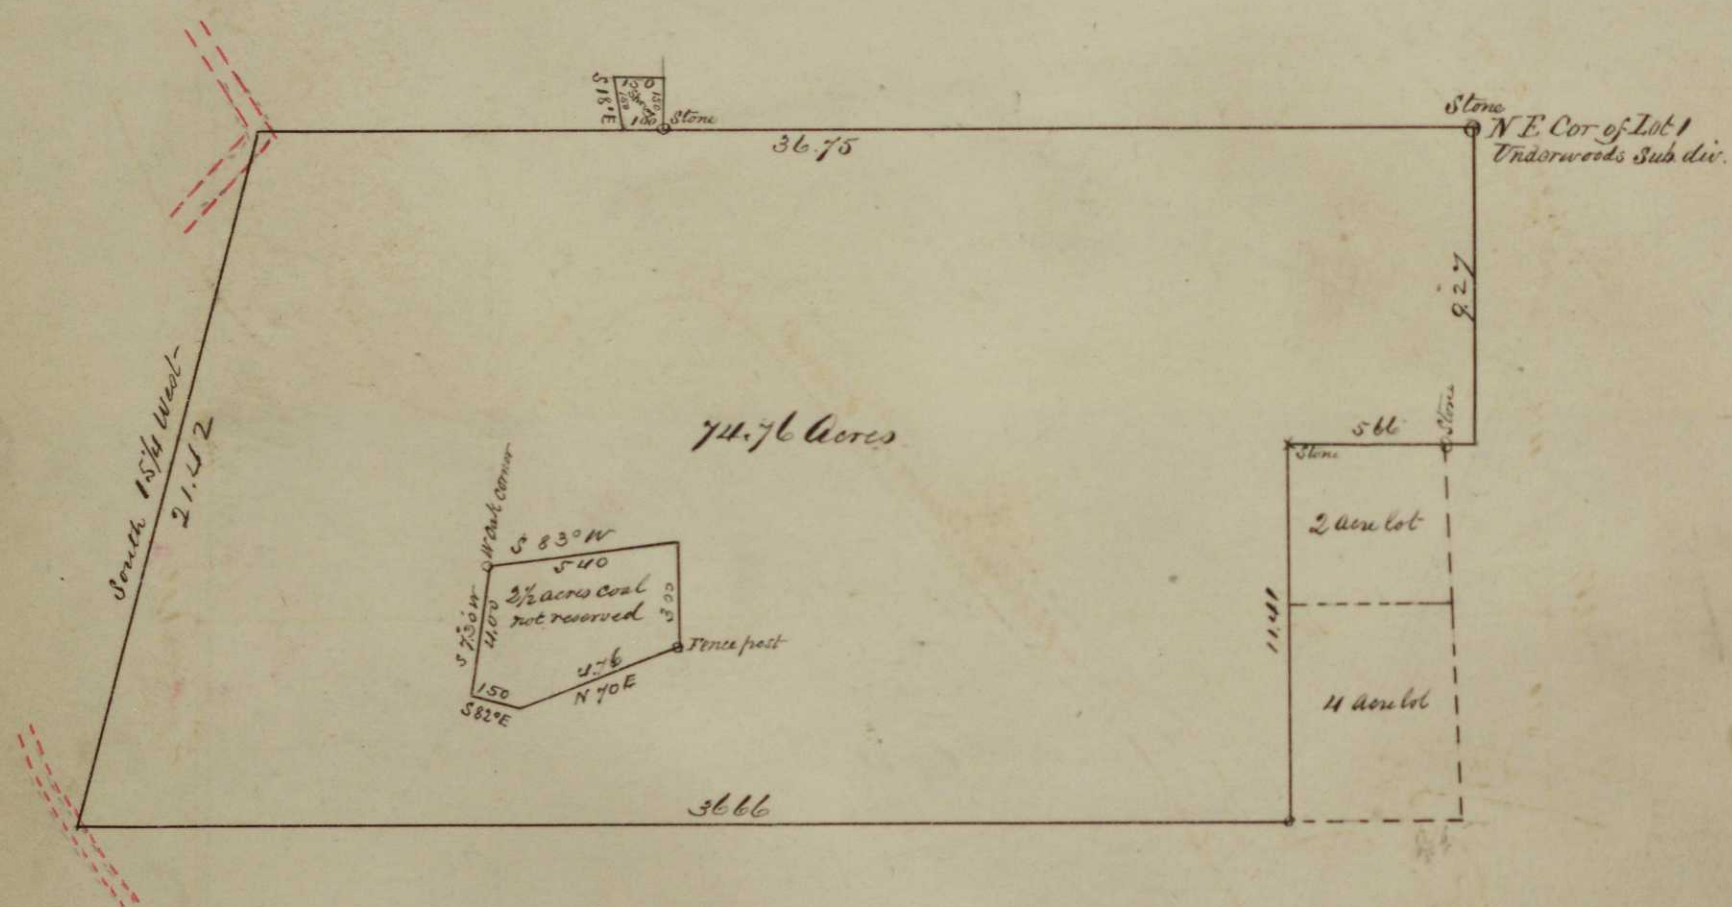


234


*Southeast quarter of Section 19, and Northeast quarter of Section 23, Township 3
Range 9, Jackson Township, Muskingum County OHIO - Surveyed for Mrs
Julia P Chandler - Jan 12, 1887*

Var 3° W
Scale 6 Chains to an Inch
Fred Howell - Co Surveyor

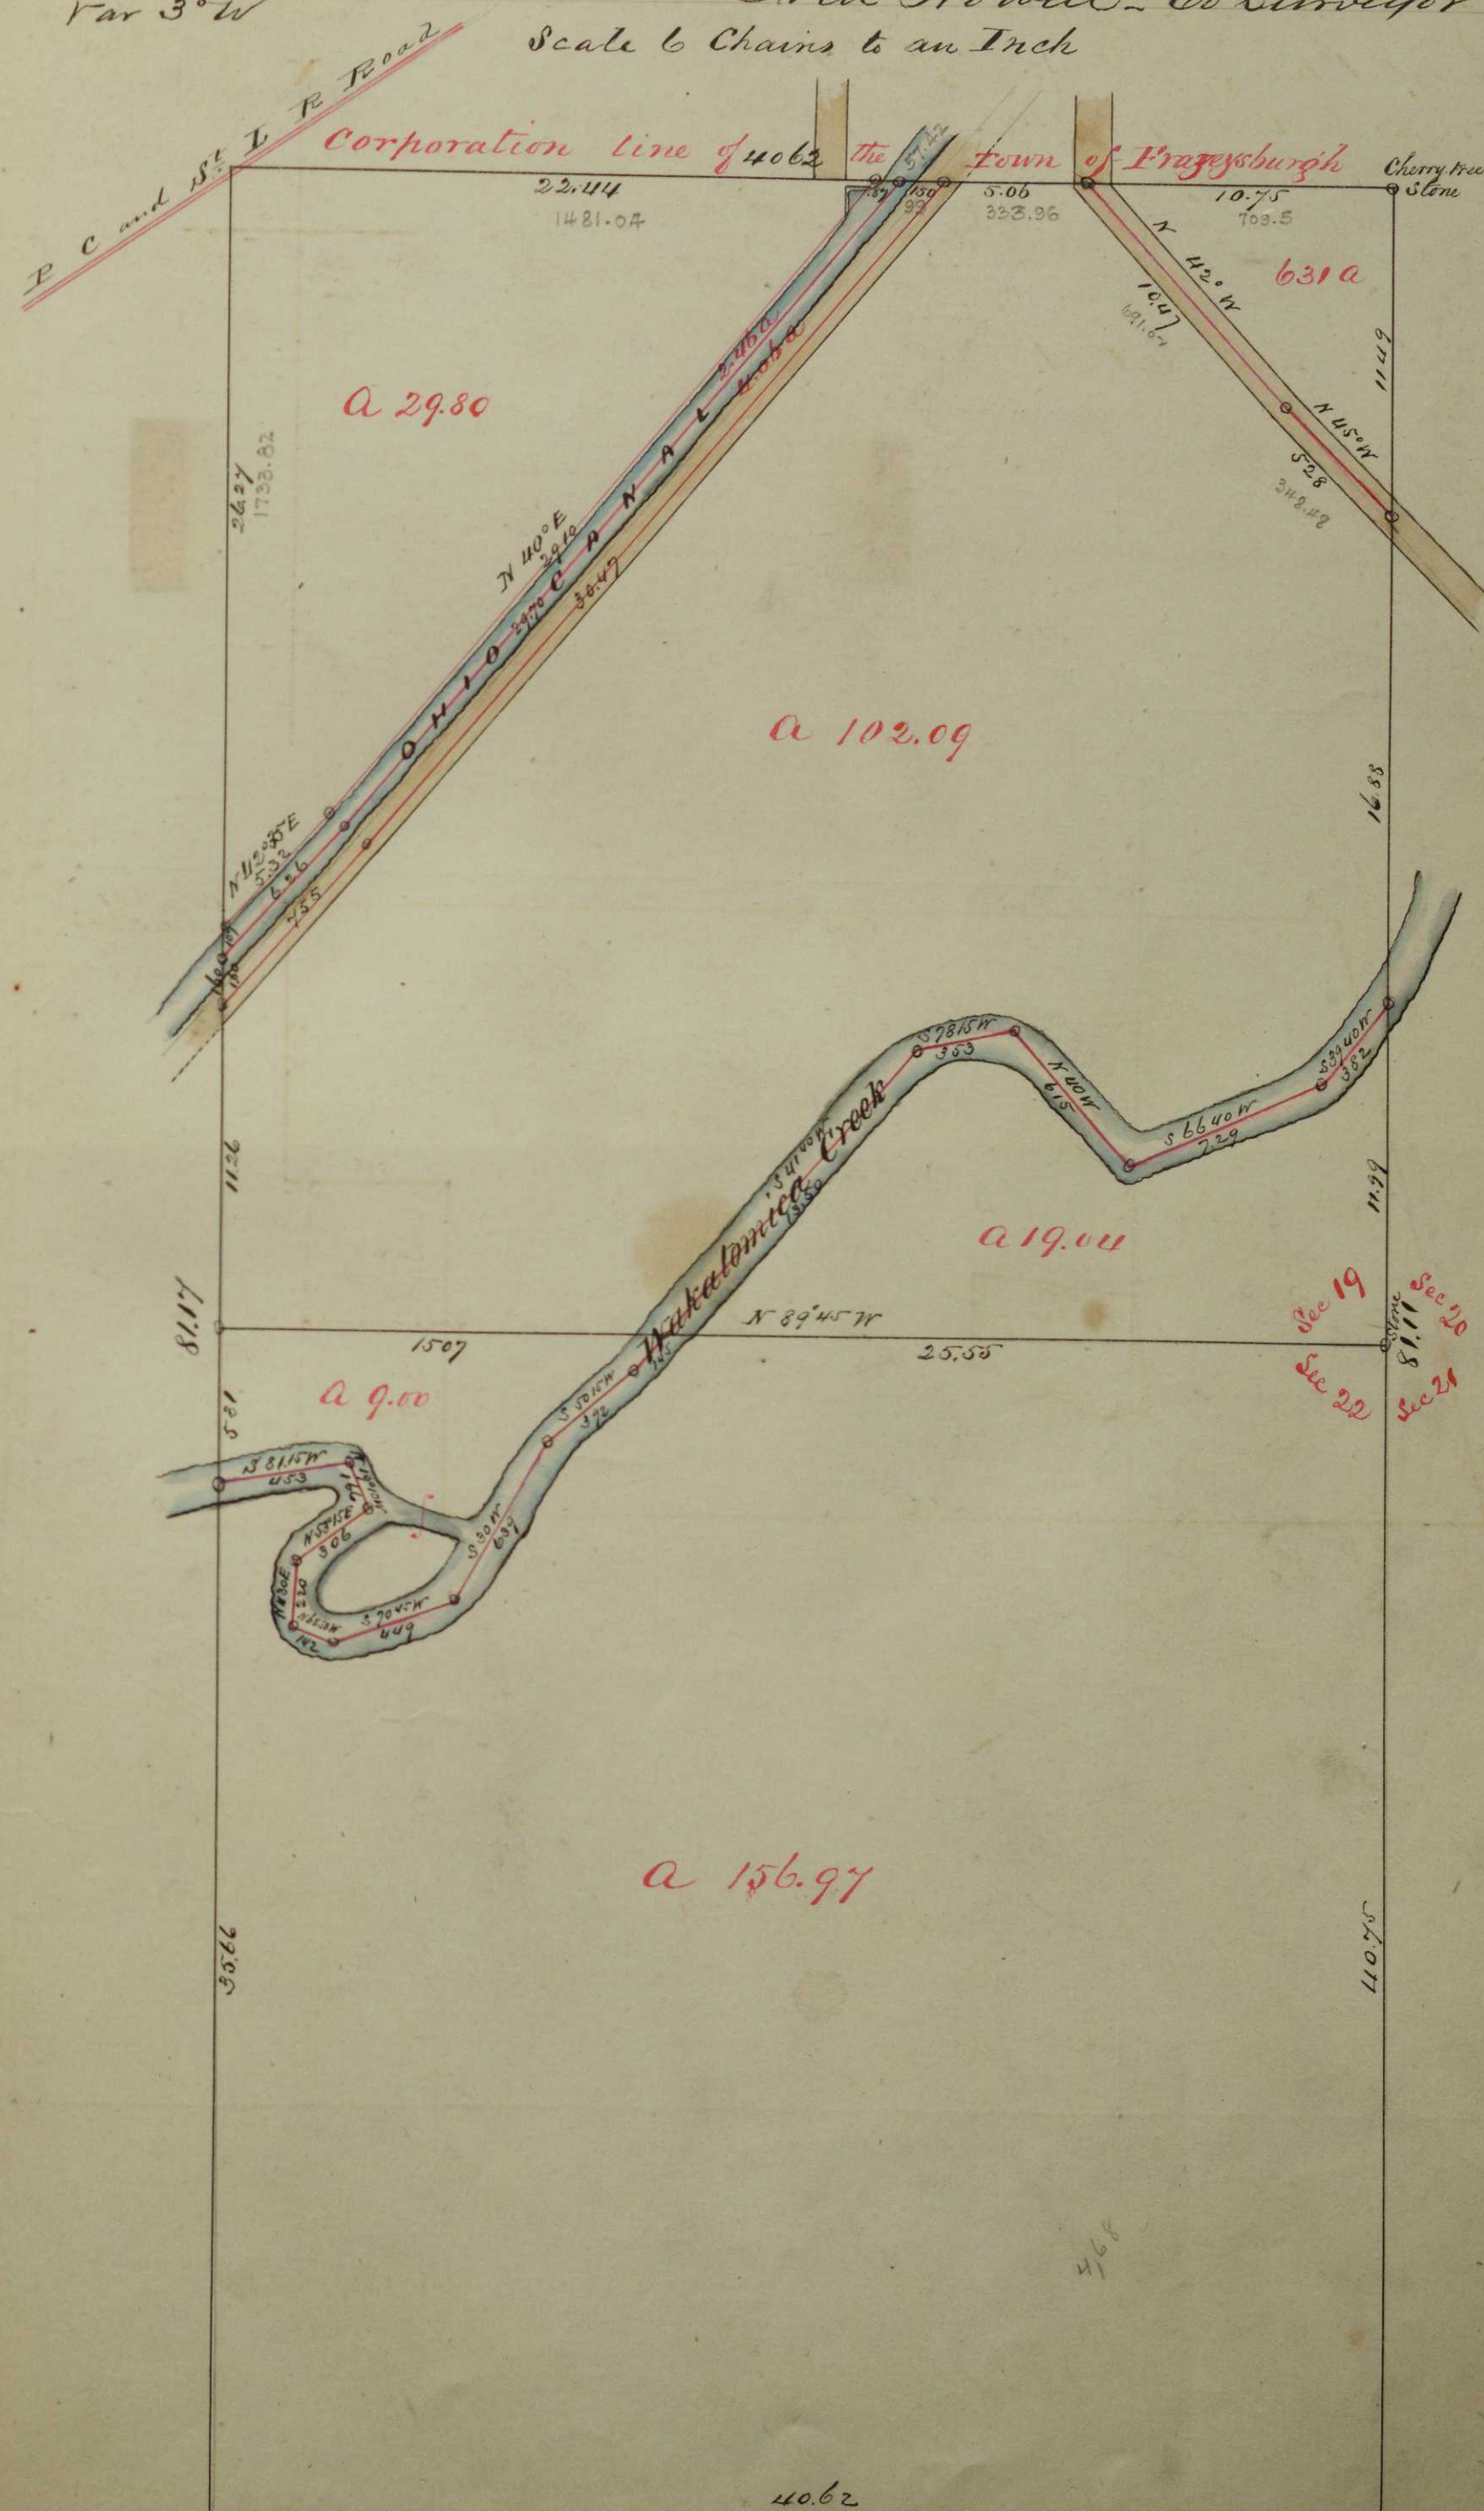

Jos D Fisher
Surrey

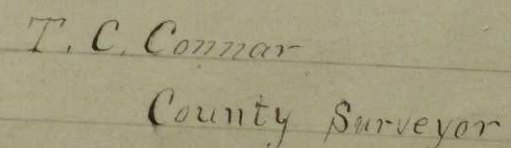


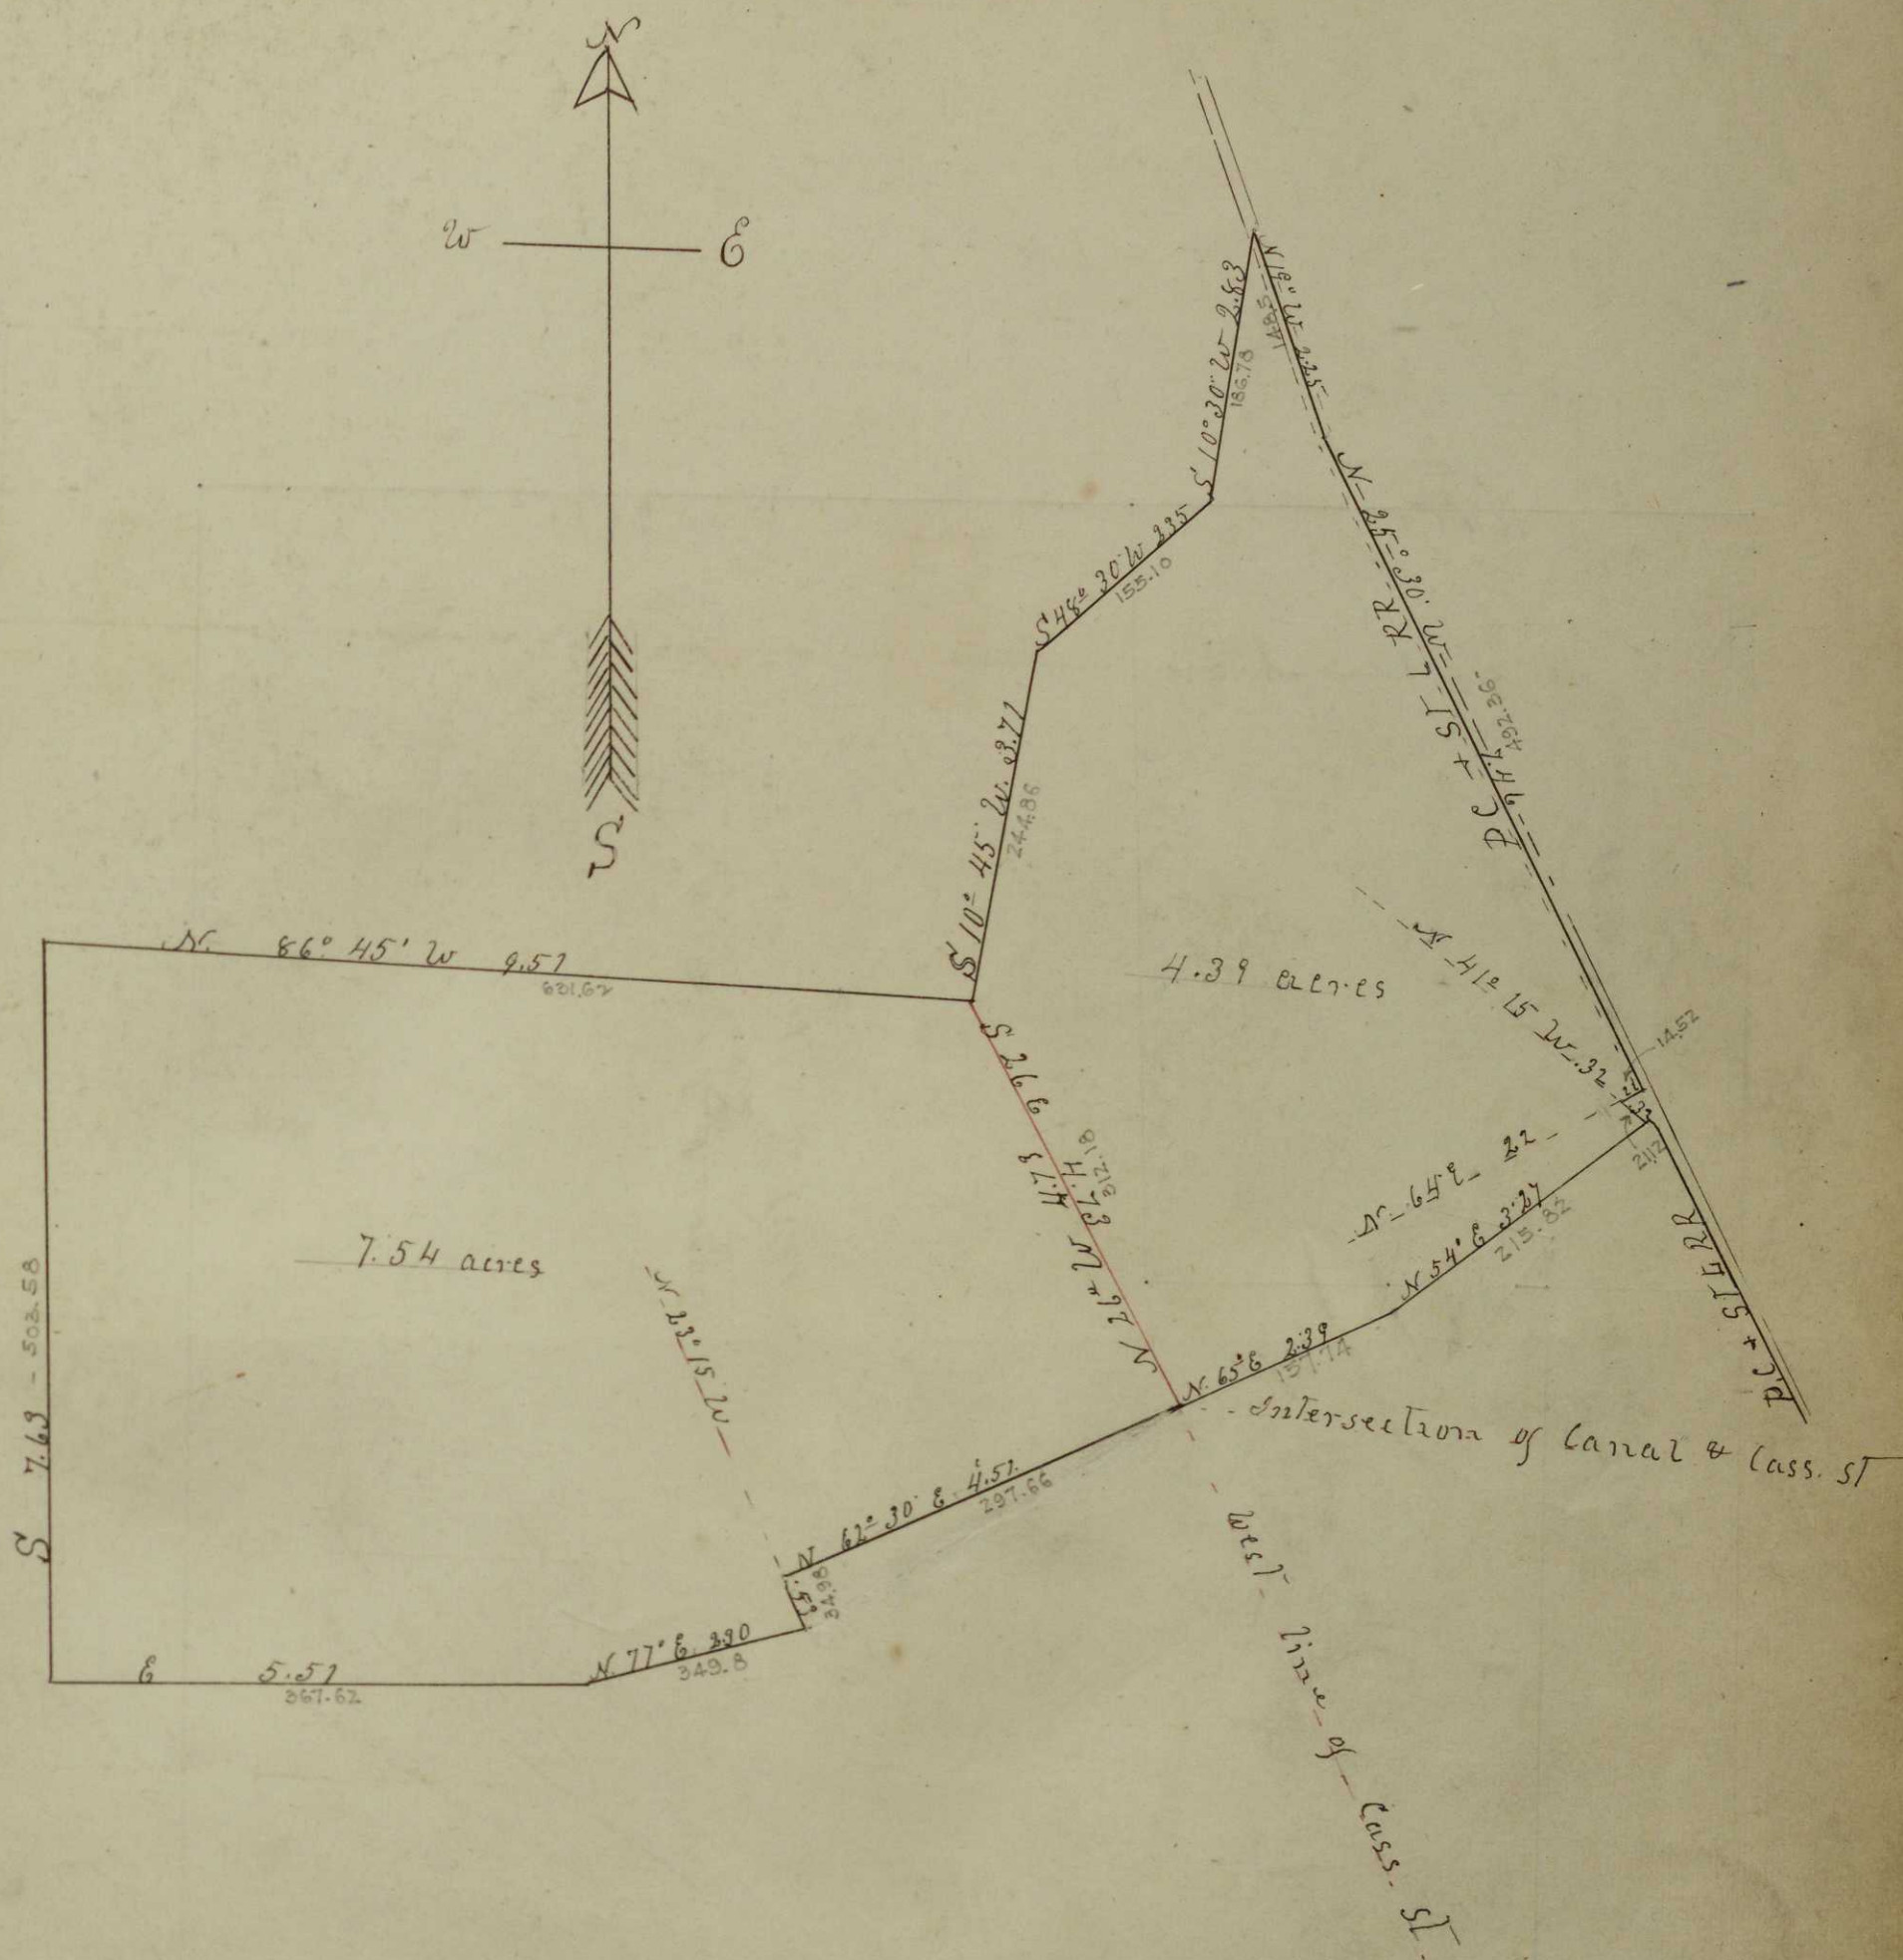


Survey of land belonging to
Robert Lemert and Frank Lemert
Situated in the
Town of Dresden Muskingum Co. O.
(4.39 acres being cut off by red line)
Being a part of lot 47 in the subdivision
of the first quarter of Township 3
Range 8 of the U.S. Military lands

May 8th 1889

Attest T. C. Connor
County Surveyor

M. Dunn
Dept Surveyor

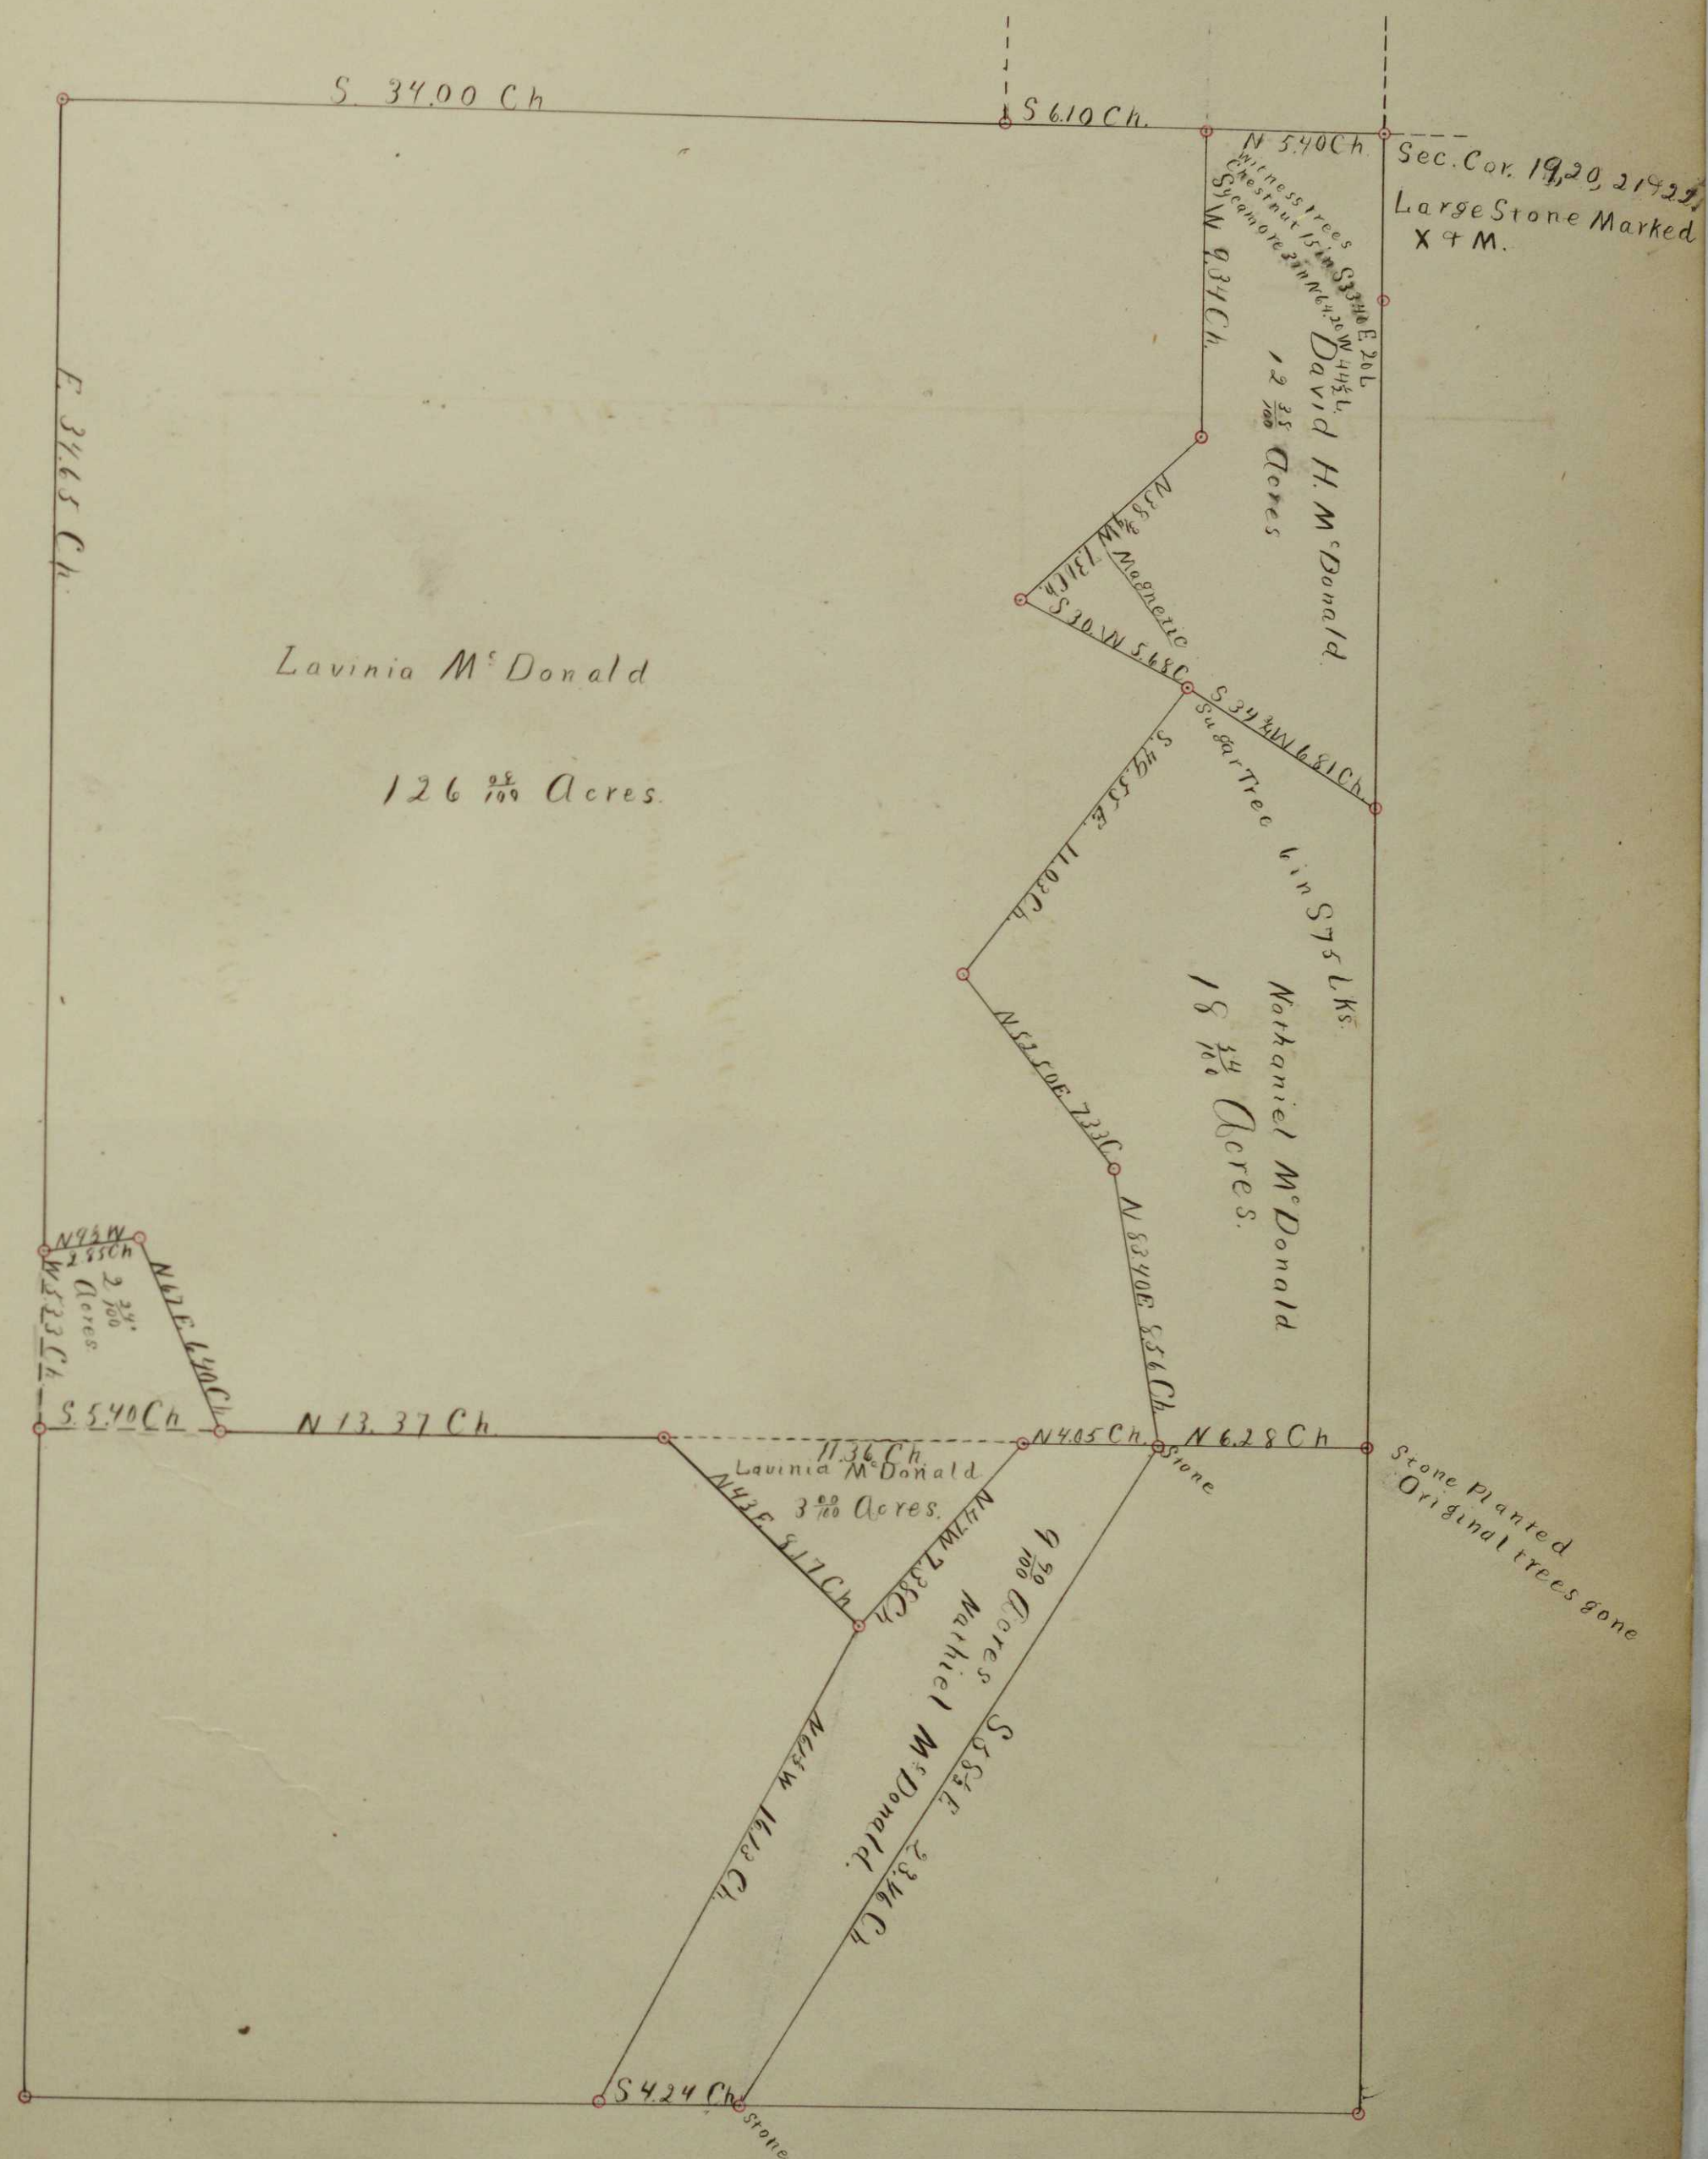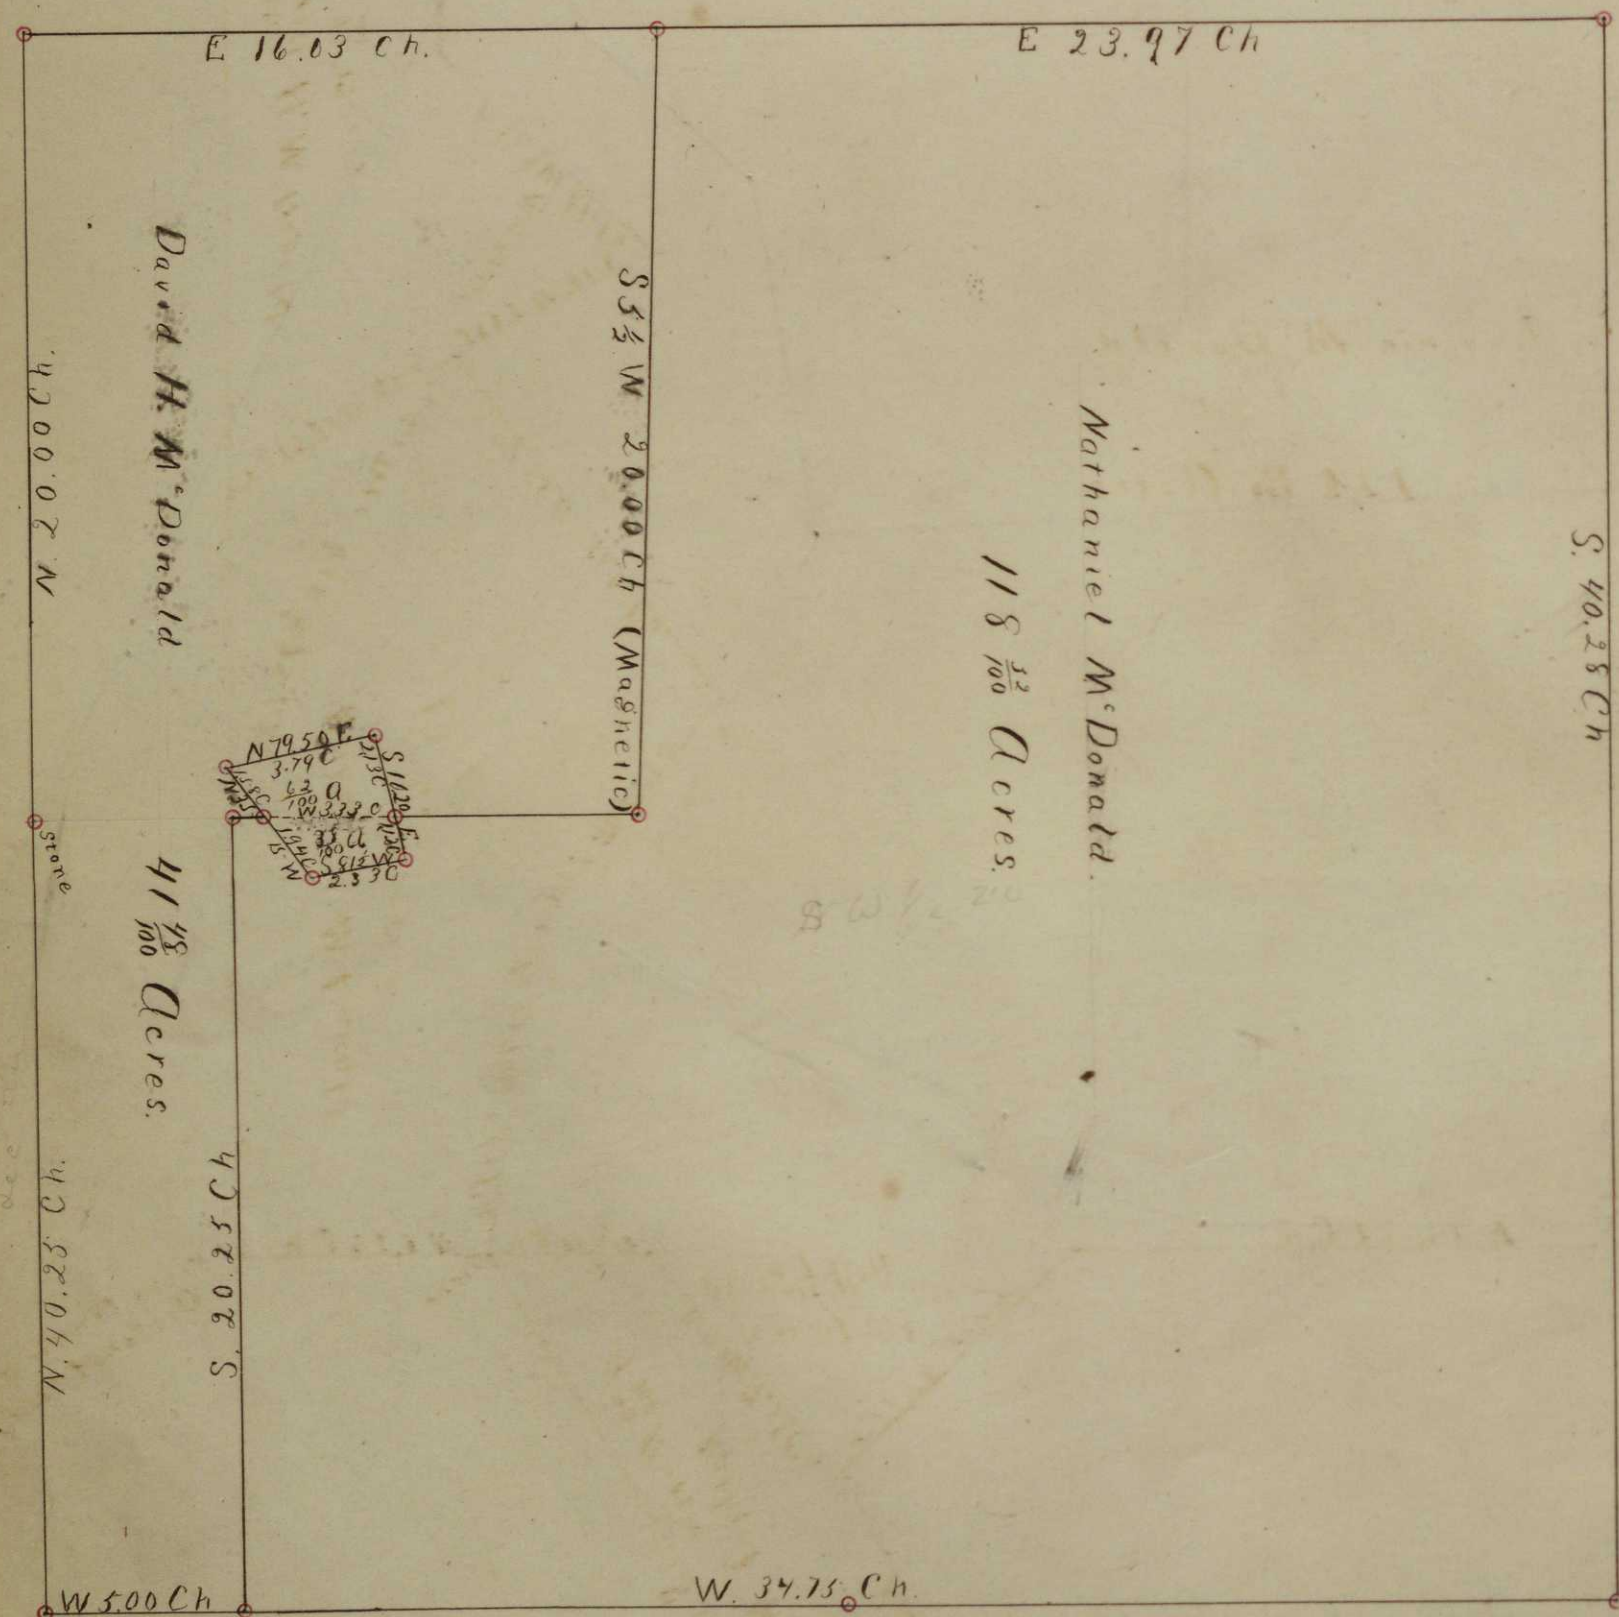

East 12.95

Survey of lands belonging to E. Perry
Being a part of the 3rd quarter of Tp 2
U.S. Military lands.

Surveyed May 31 1888

M. Dunn.

Deputy Co Surveyor

North 27.16 ch.

South 29.64

N 58° W 47.5 ch

S 89° W 47.5 ch

N 33° W 45.0 ch

N 45° W 6.25 ch

C-150 River road

C.C. & S. RR
C-3

Plat of A Survey of a proposed new County
Road Commencing at the East side of the Dresden road
on the line running East between the lands of Nathan Kelley
and heirs of Simeon Kelley. G.W. Scott Emmett C Kelley
Edward Wilkinson John Bell and the heirs of Ignatious Kelley
and others as petitioned for and made the Survey with
the following Courses and distances

(Field notes) Commencing at A on plat and run East
65 chains + 50 links To B Thence S $68^{\circ}30'$ E 2.00 chains to C
Thence N $72^{\circ}15'$ E 2.25 ch To D Thence N $77^{\circ}30'$ W 2.75 ch
Thence E 18.33 chains To the point of intersection
with the River Road at F Said Survey also
crosses the C.C. & S. RR as shown on plat
Slakes on land lines were driven a suitable
points along the line

Attest

J.L. Connor
Co SurveyorSurveyed June 20th 1889

Mr Dunn

Dept Co Surveyor

In Falls T P

7-309 (1941)


Dresden road

To a stake Driven in the center of
the proposed Road Thence North 13°
East 120 to a stake Thence N 3° 45' E 204
and along the bank of a small stream to
A stake Thence North 4.08 chain to a stake
Driven in the center of the Road
Thence N 13° 36' W and across the stream 87 wide
to A stake Driven in the center line of
266. Thence North 15.87 chain to a stake
in the center of the road Thence N 2° W 8.36 ch
to A stake Driven in the center of the Dresden and
Millstead road This ends the Survey
Surveyed June 18th 1889

attest T.C. Connor Mr Dunn Dept of Surveyor


Surveyed May 17th 1889 By
J. M. Dunn
Scale 1" = 200 ft

Sale 1" = 200 ft -

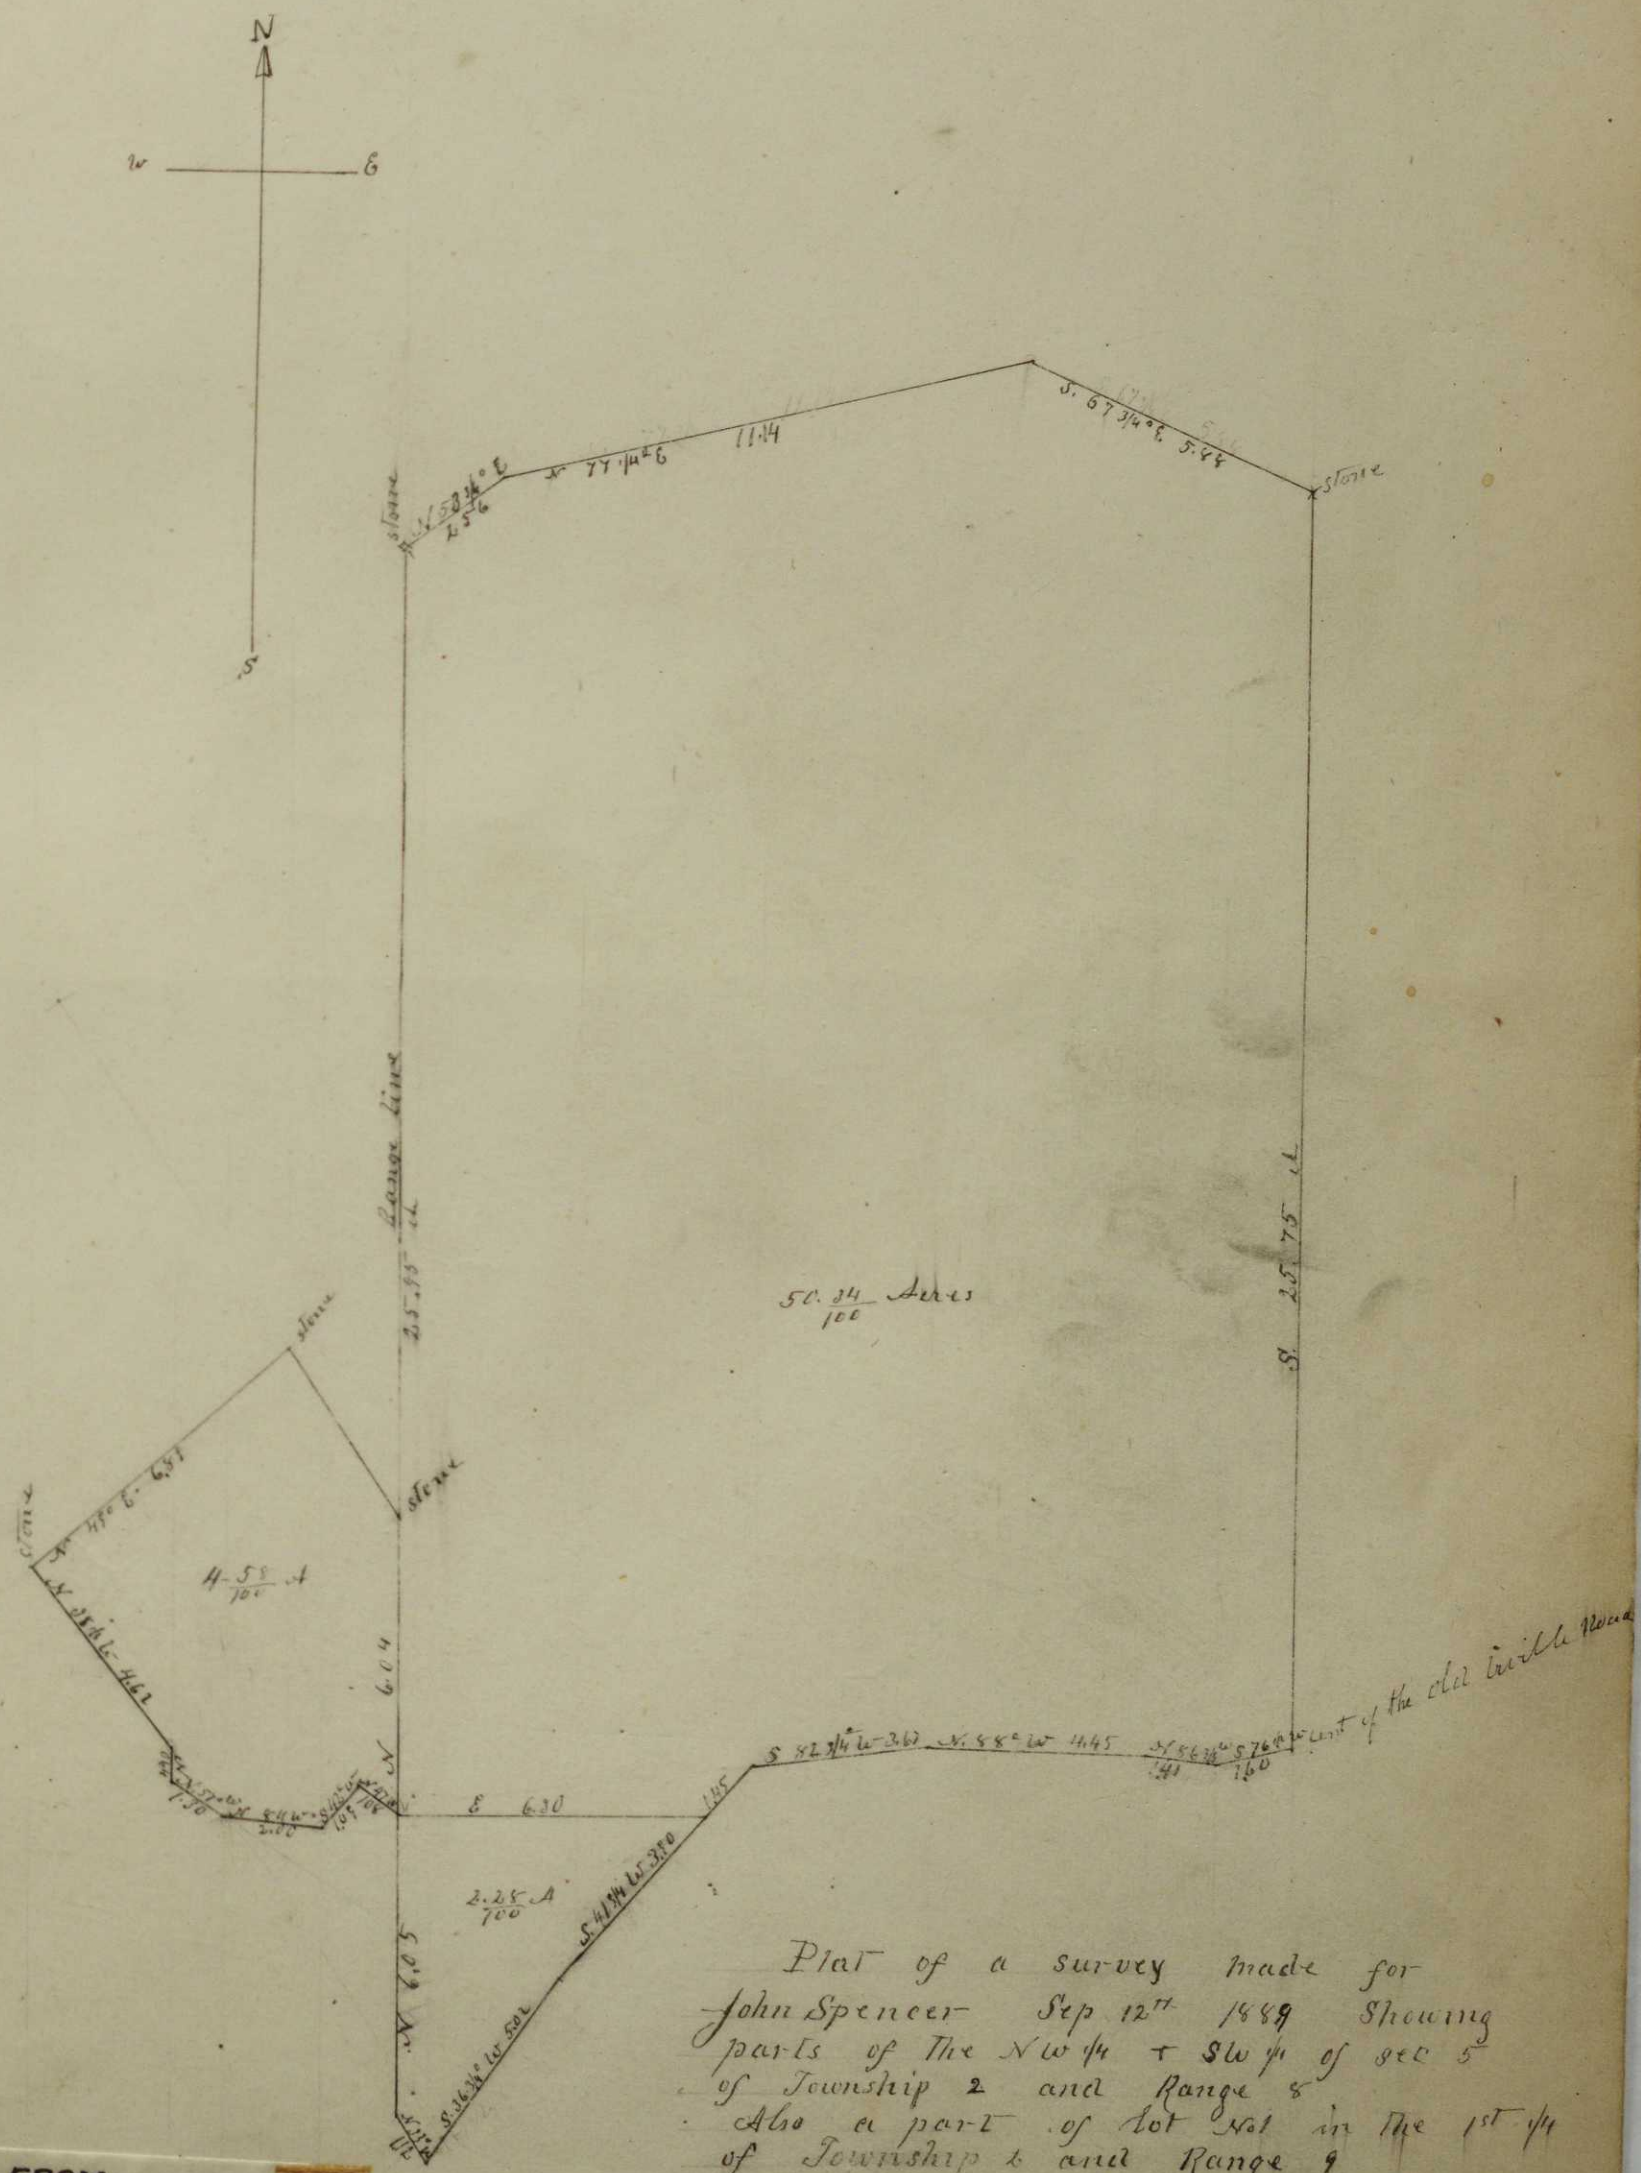

PHOTOSTAT FROM
SURVEYOR'S RECORD BOOK 3, PG. 59
COUNTY ENGINEER OFFICE
MUSKINGUM COUNTY, OHIO
APRIL 1940

Plat of a survey made for
John Spencer Sep 12th 1889 Showing
parts of The NW 1/4 + SW 1/4 of sec 5
of Township 2 and Range 8
Also a part of lot 101 in the 1st 1/4
of Township 2 and Range 9
Scale 1 inch = 4 chains
Attest
J. C. Connor Co-Surveyor
Deft Co Surveyor
Muskingum Twp.

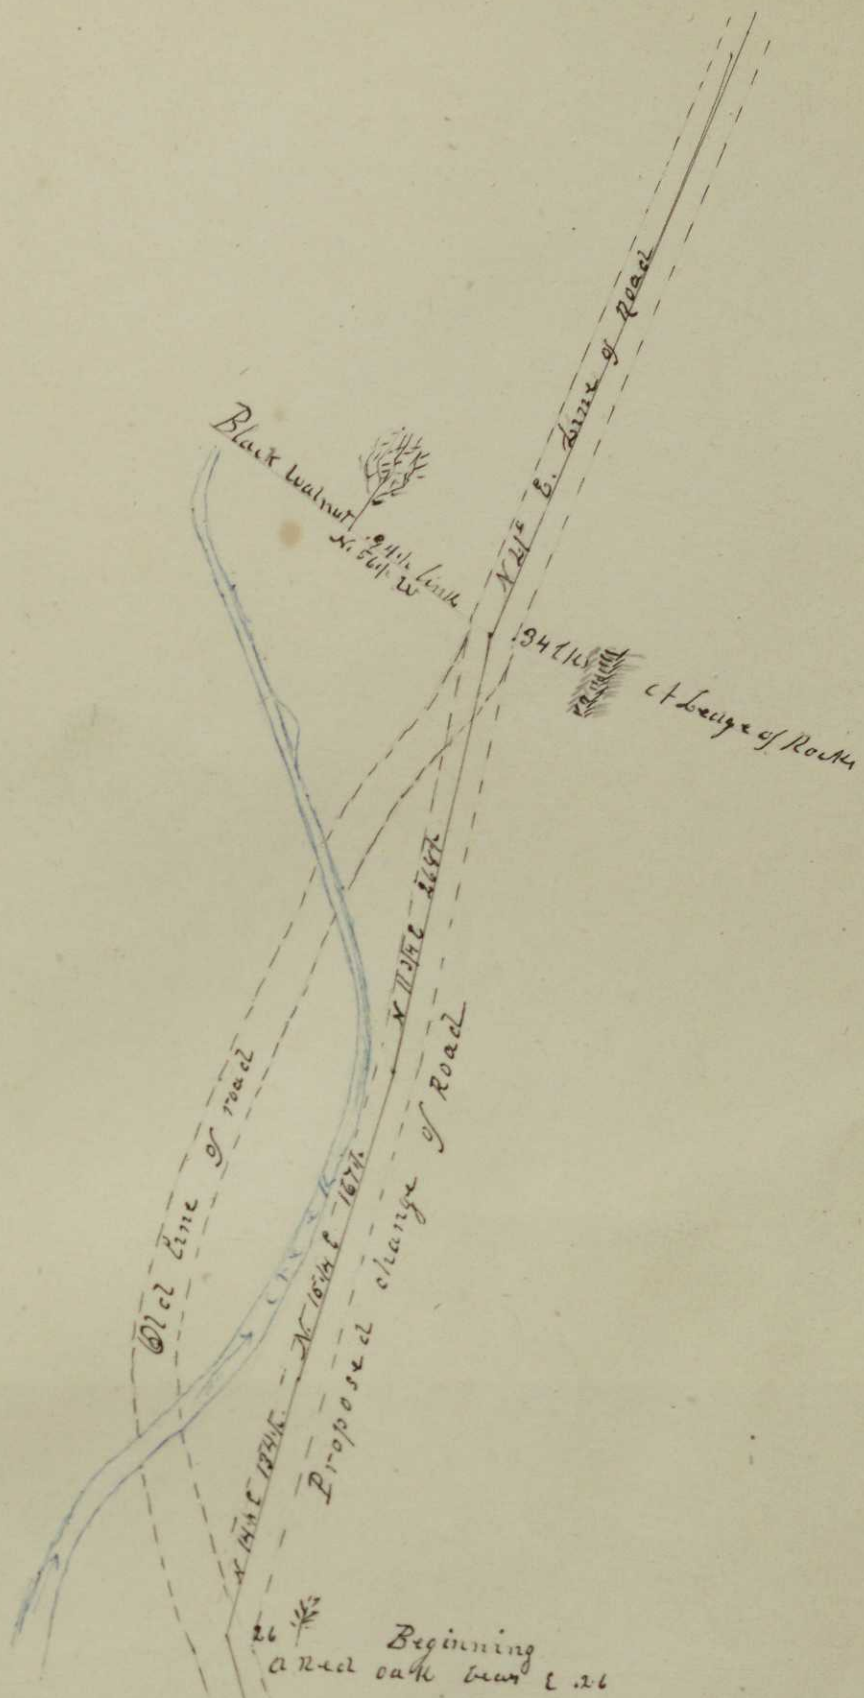













Plat of a proposed change in the
County road leading from the Ridge road
to Licking Valley. Through the lands of
Solomon Drum being in the 1st or W 1/4 Lot 21
Tp 1 R 9 in the County of Muskingum
State of O.


Attest
J. C. Connor
Co Surveyor


Surveyed Oct 1st 1889
Wm Dunn
Dept Co Surveyor

Log Barn

Solomon Drum's Log barn

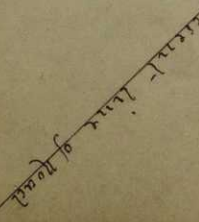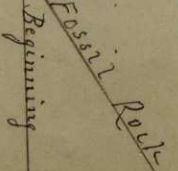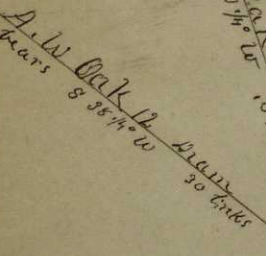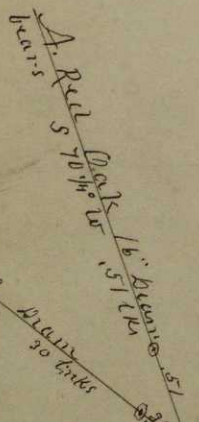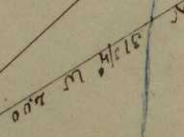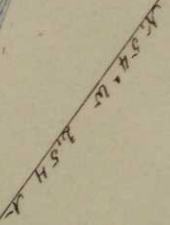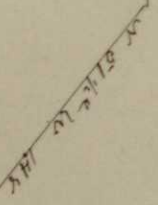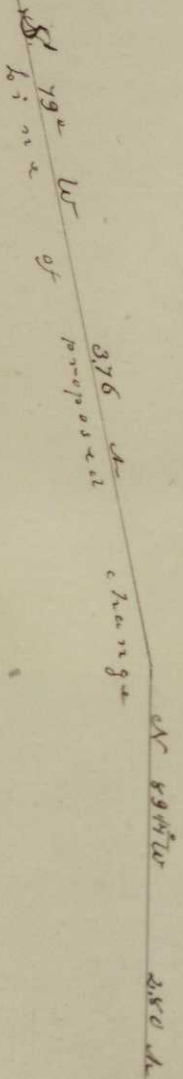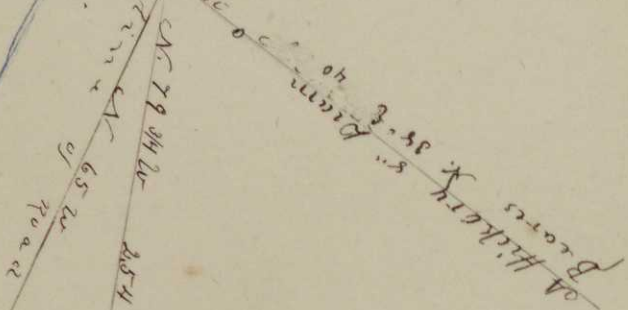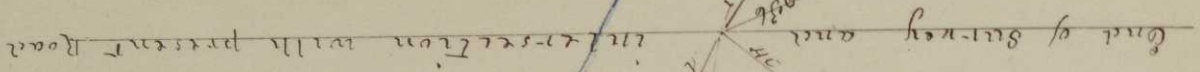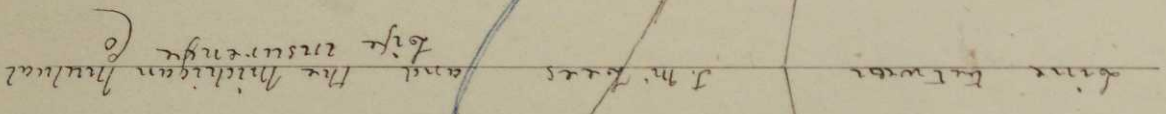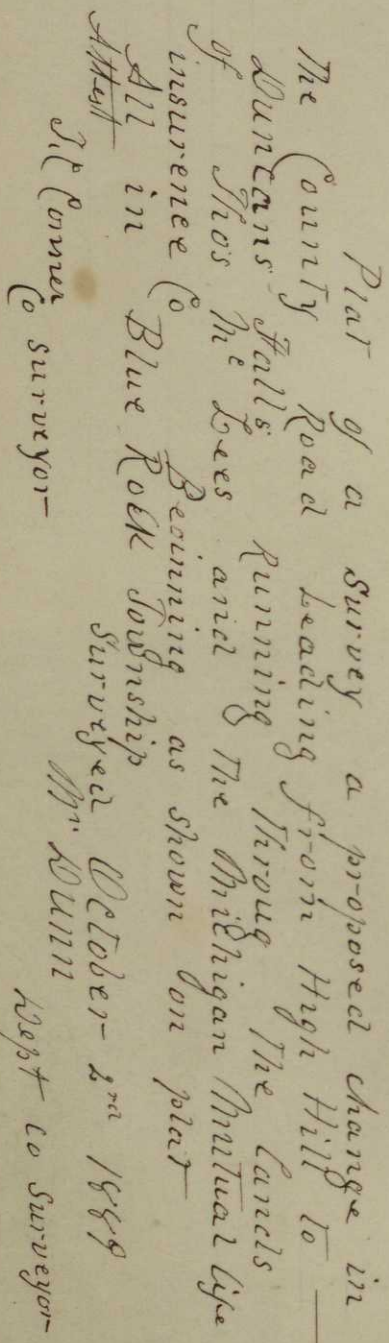

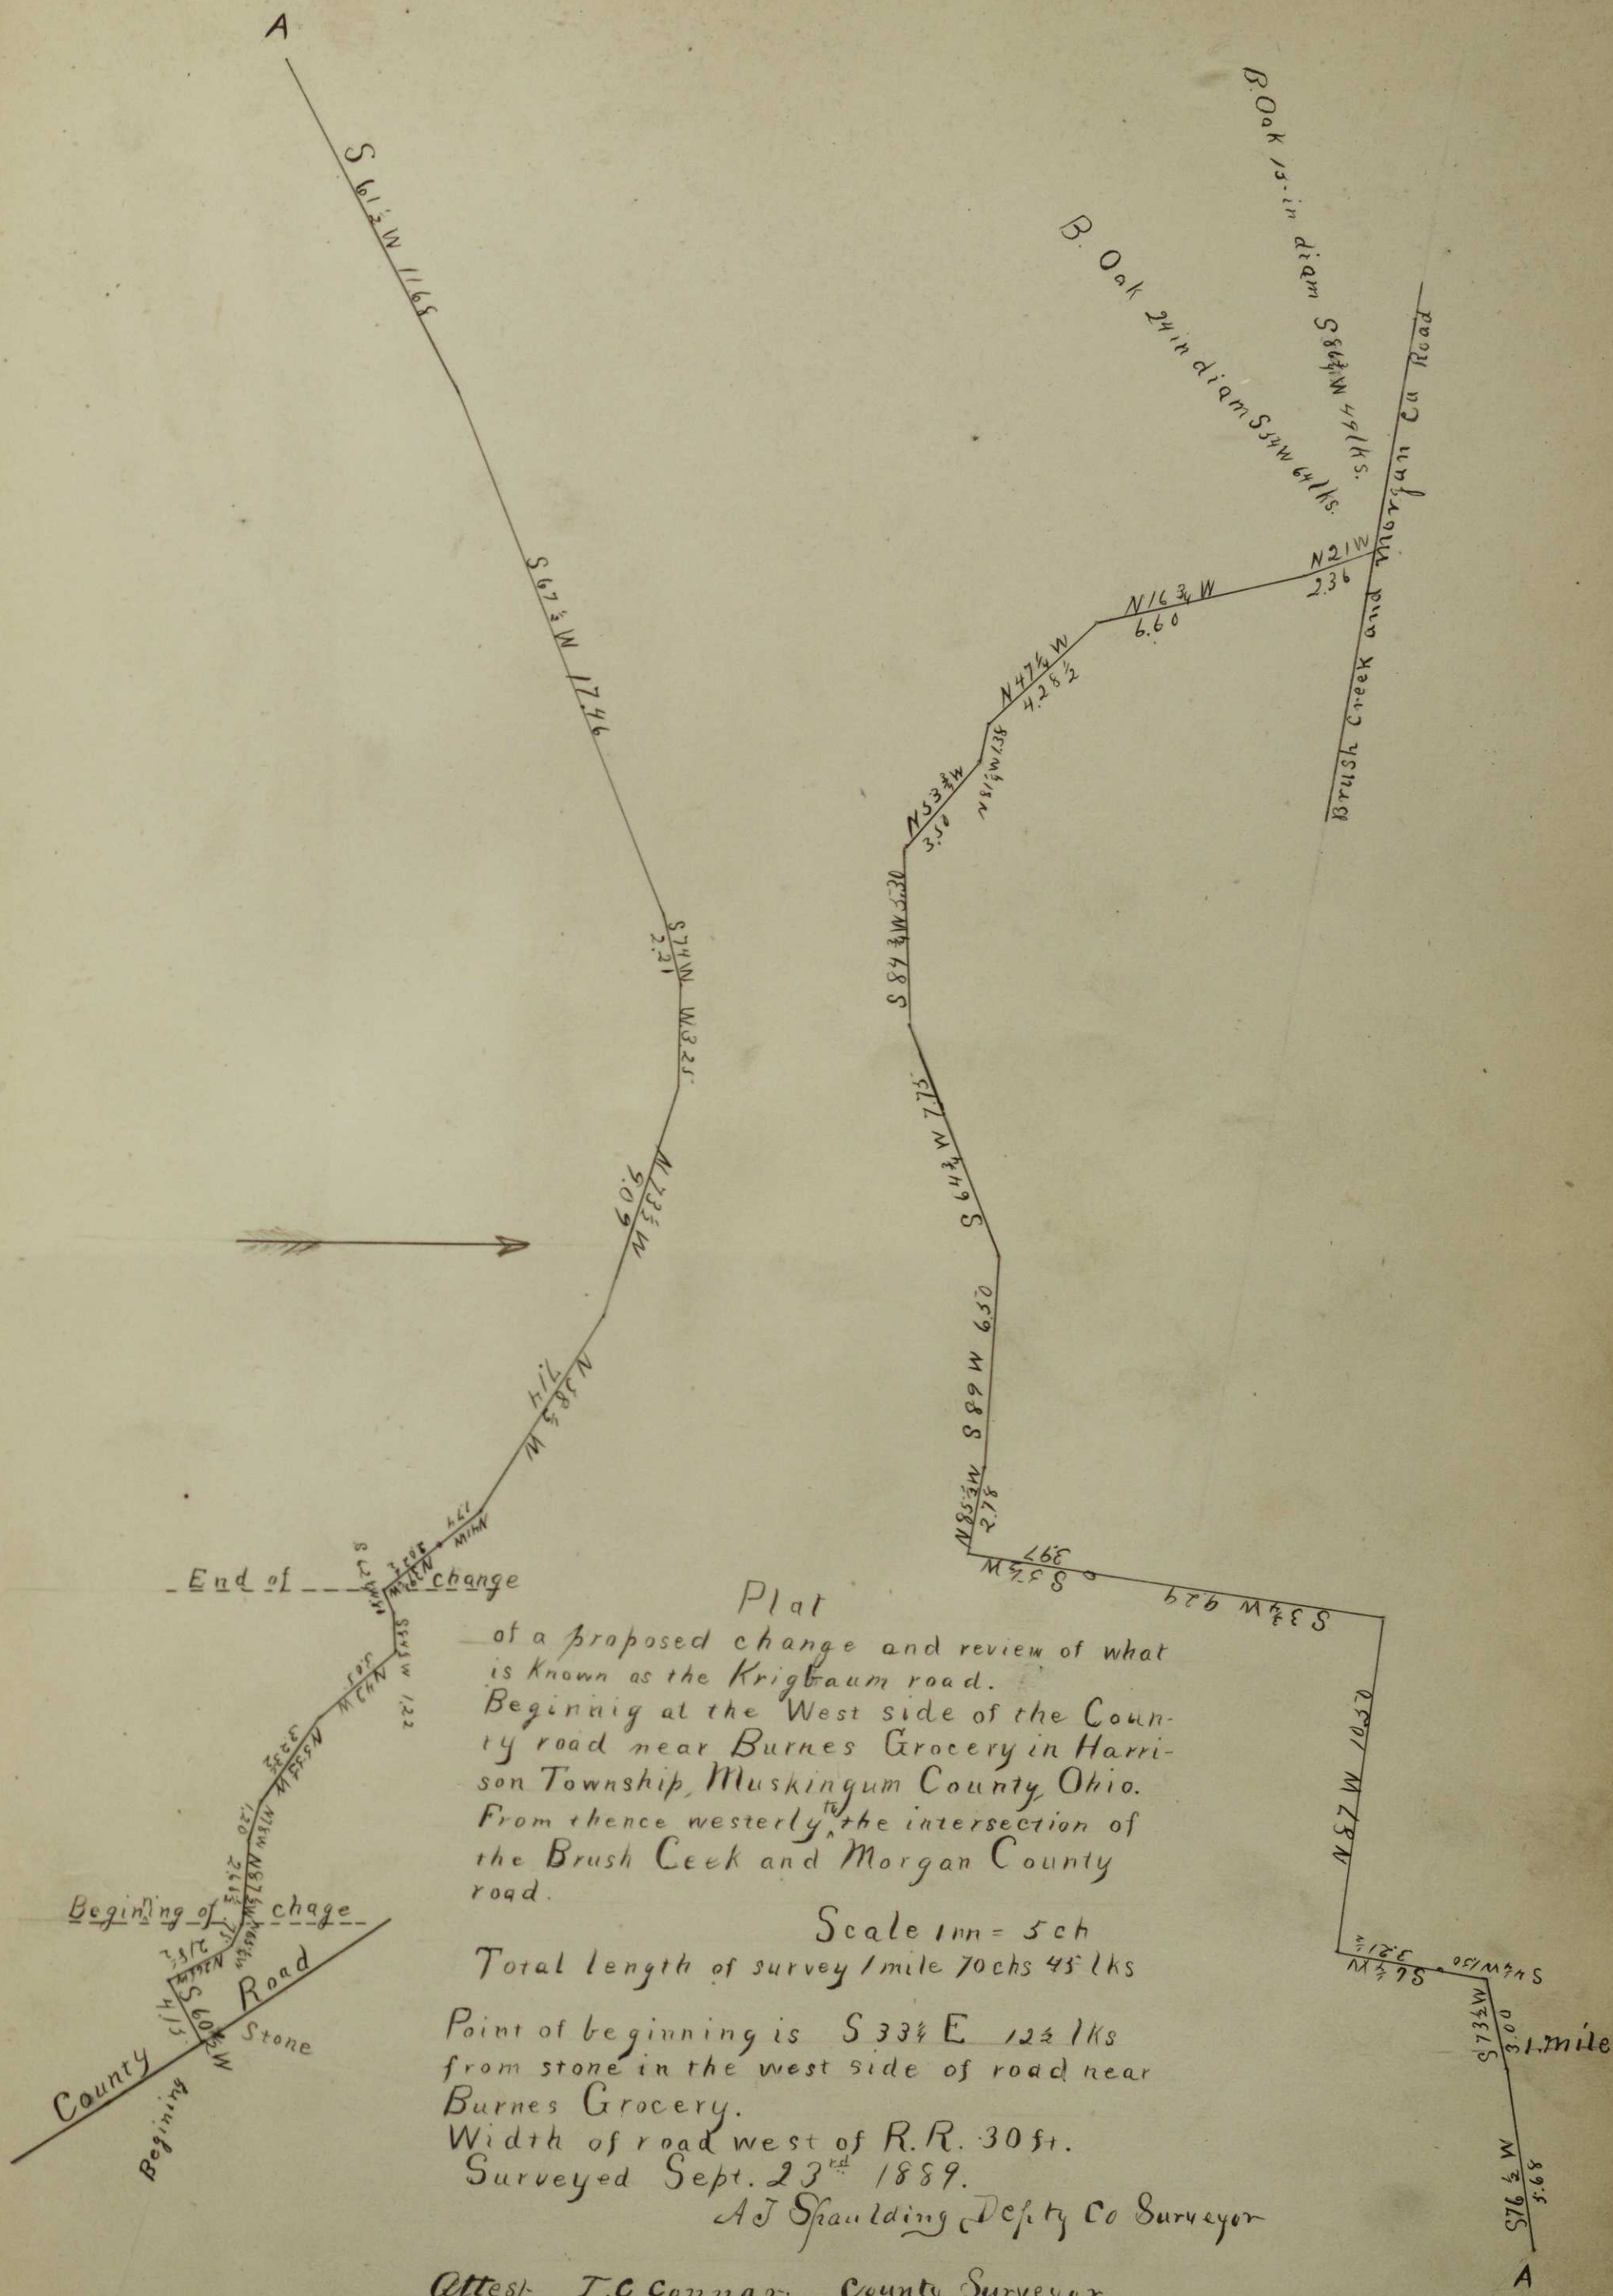

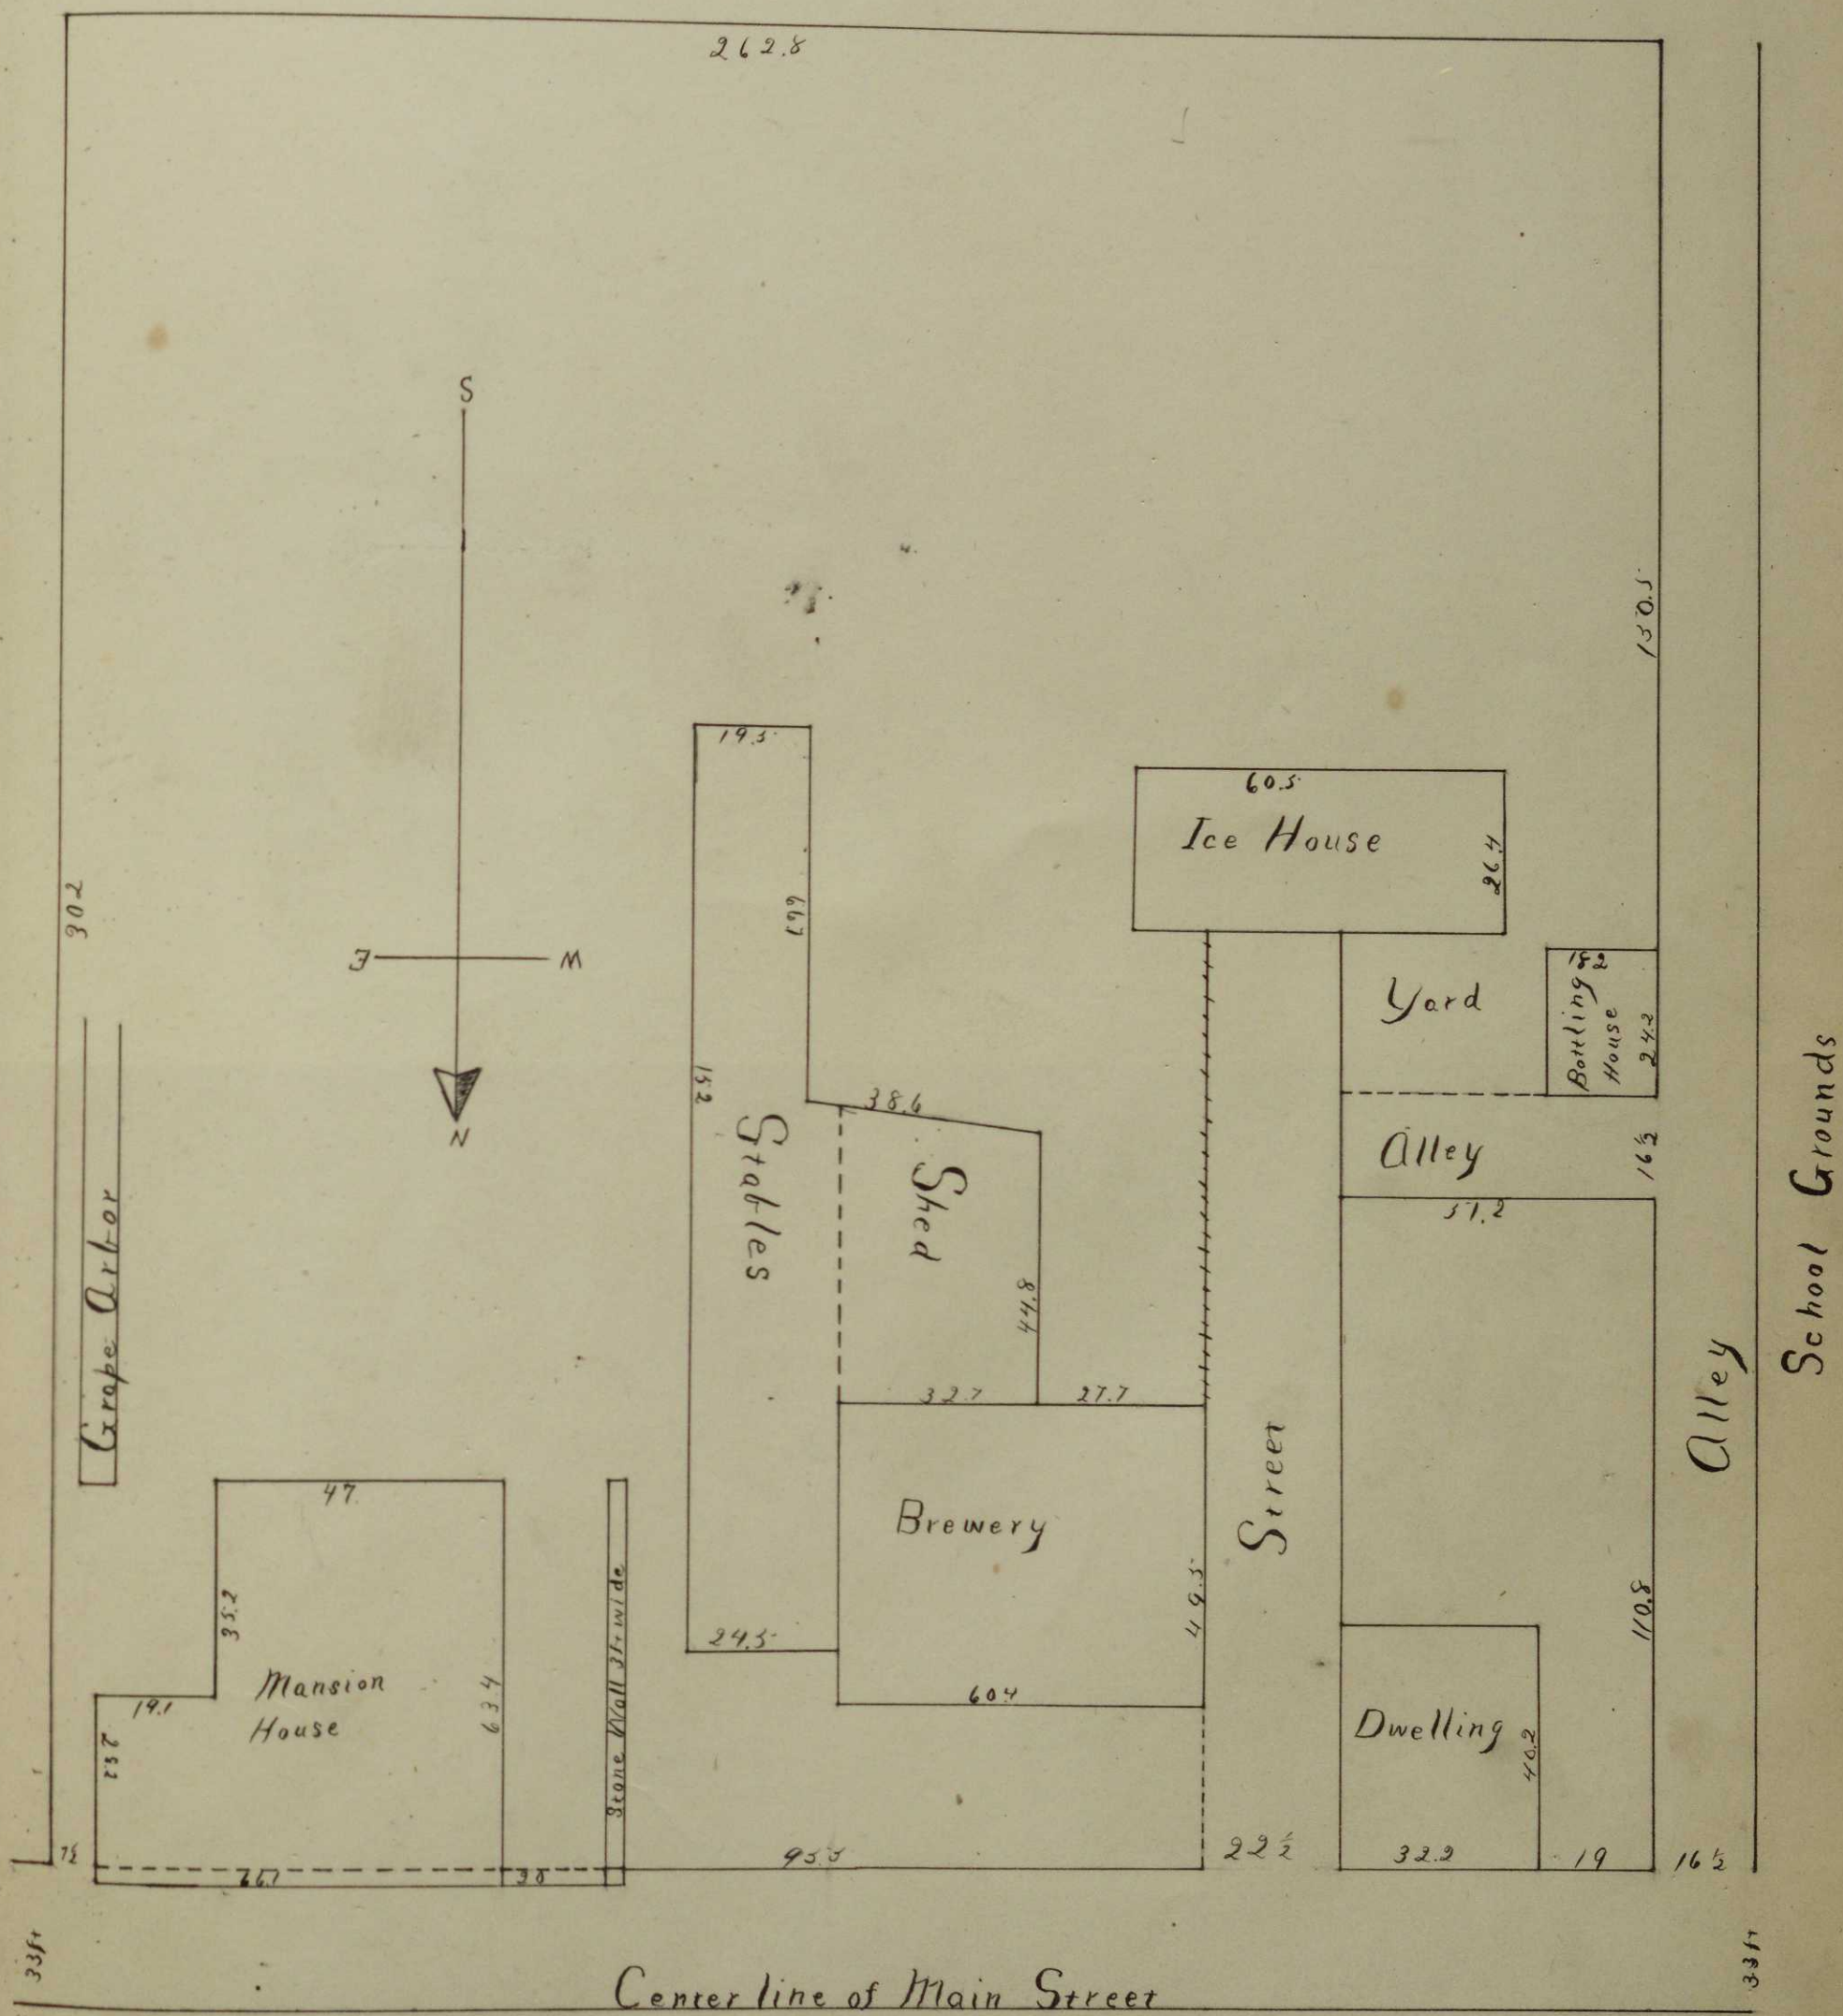

Plat
of the Washington Brewery. Showing the location of the buildings and the proposed
new Street and Alley in the fourth Ward of the City of Zanesville; Mus-
kingum County, Ohio.


Attest

J. C. Conner-
Co Surveyor


Scale 30 ft to 1 inch
Surveyed August 23rd 1889

Wm. Dunn

Deputy Co Surveyor

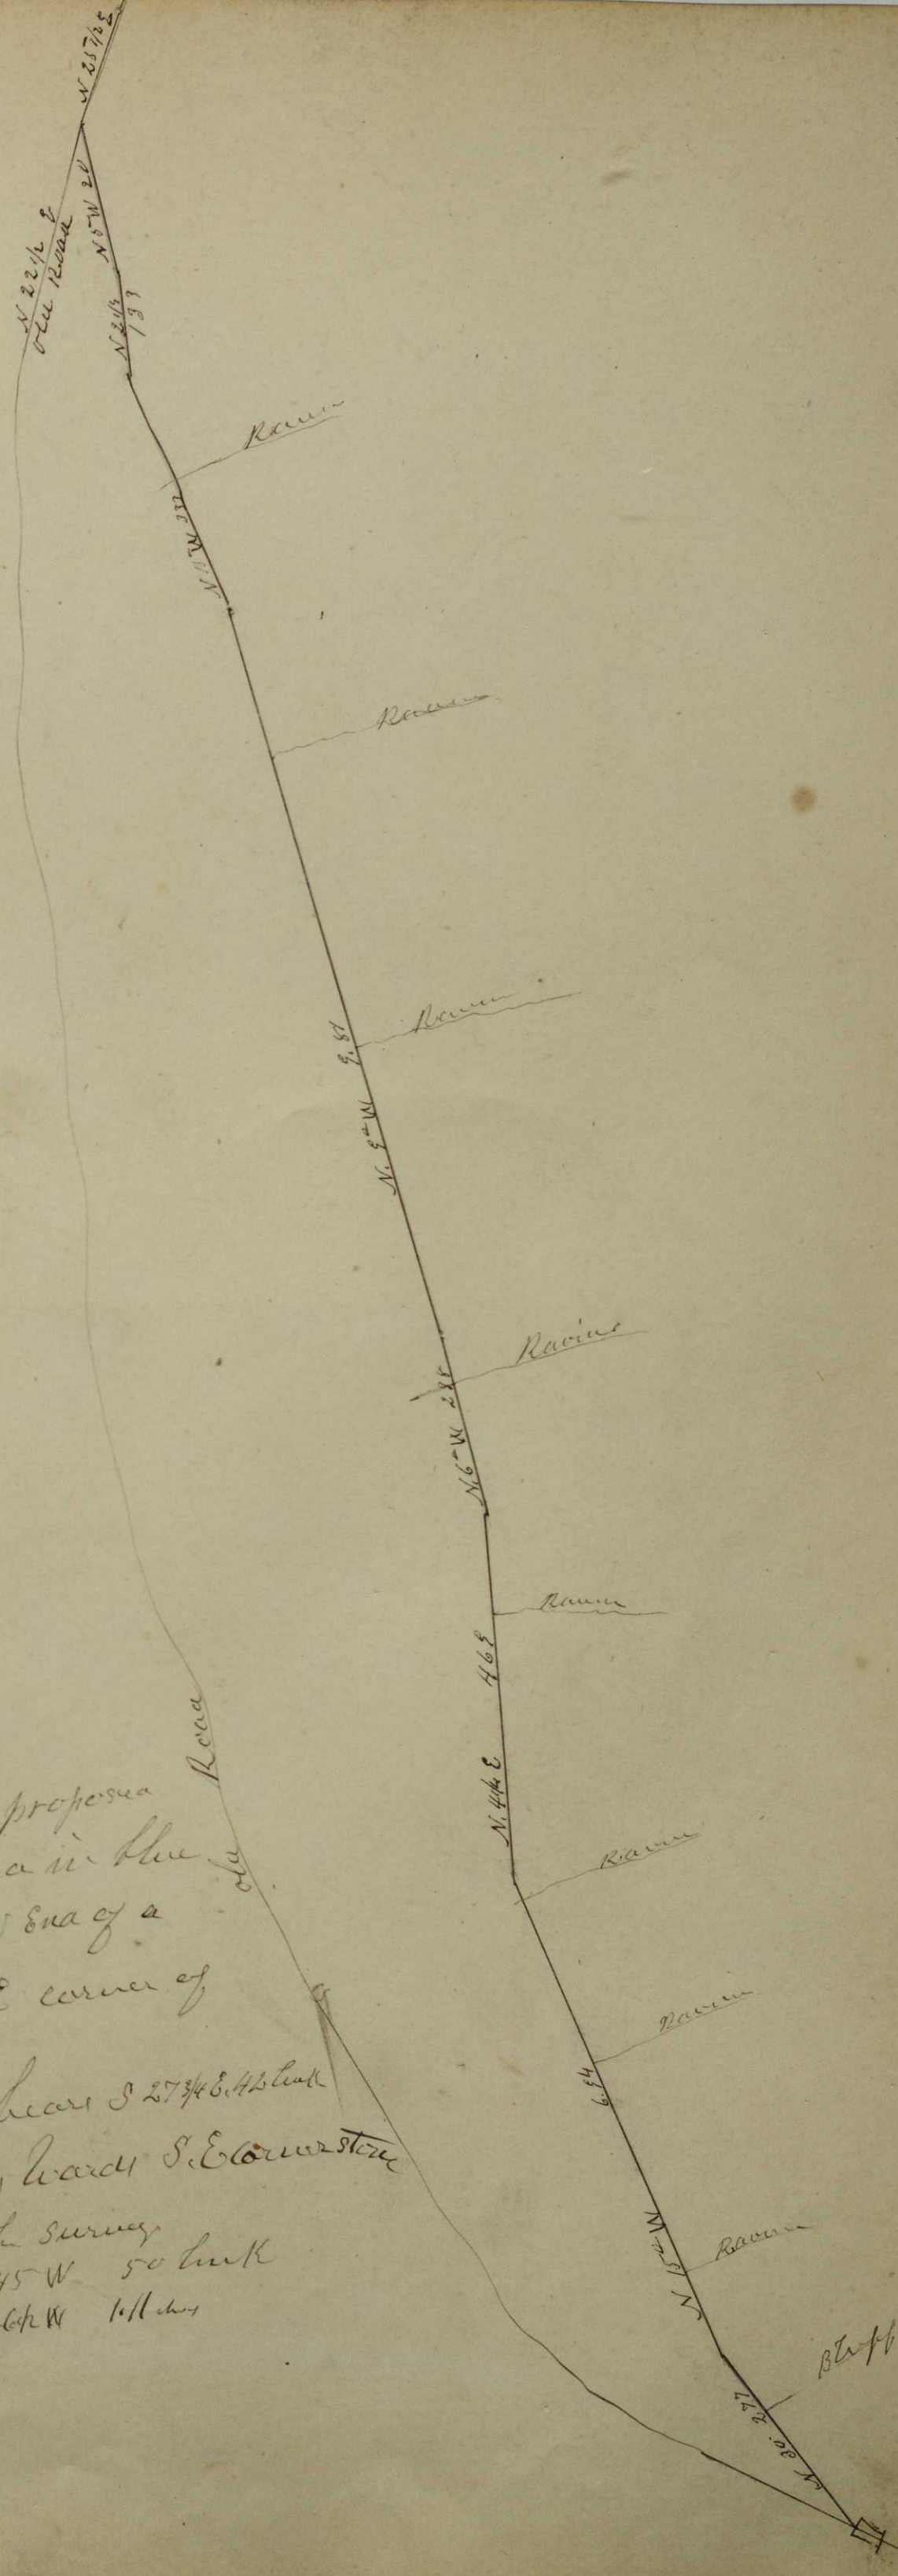

plat of a survey of a proposed
 change in the County Road in the
 Rock Tp. Beginning at the NW end of a
 Small Bridge near the S E corner of a
 James Ward's land
 an Elm tree 24 Drains bears S 27 3/4 E 42 links
 and a 1st 88 links is James Ward's S.E. corner stone
 at the end or front of the survey
 a Sycamore 3 ft bears S 45 W 50 links
 " " 4 " " " 26 1/2 W 111 links

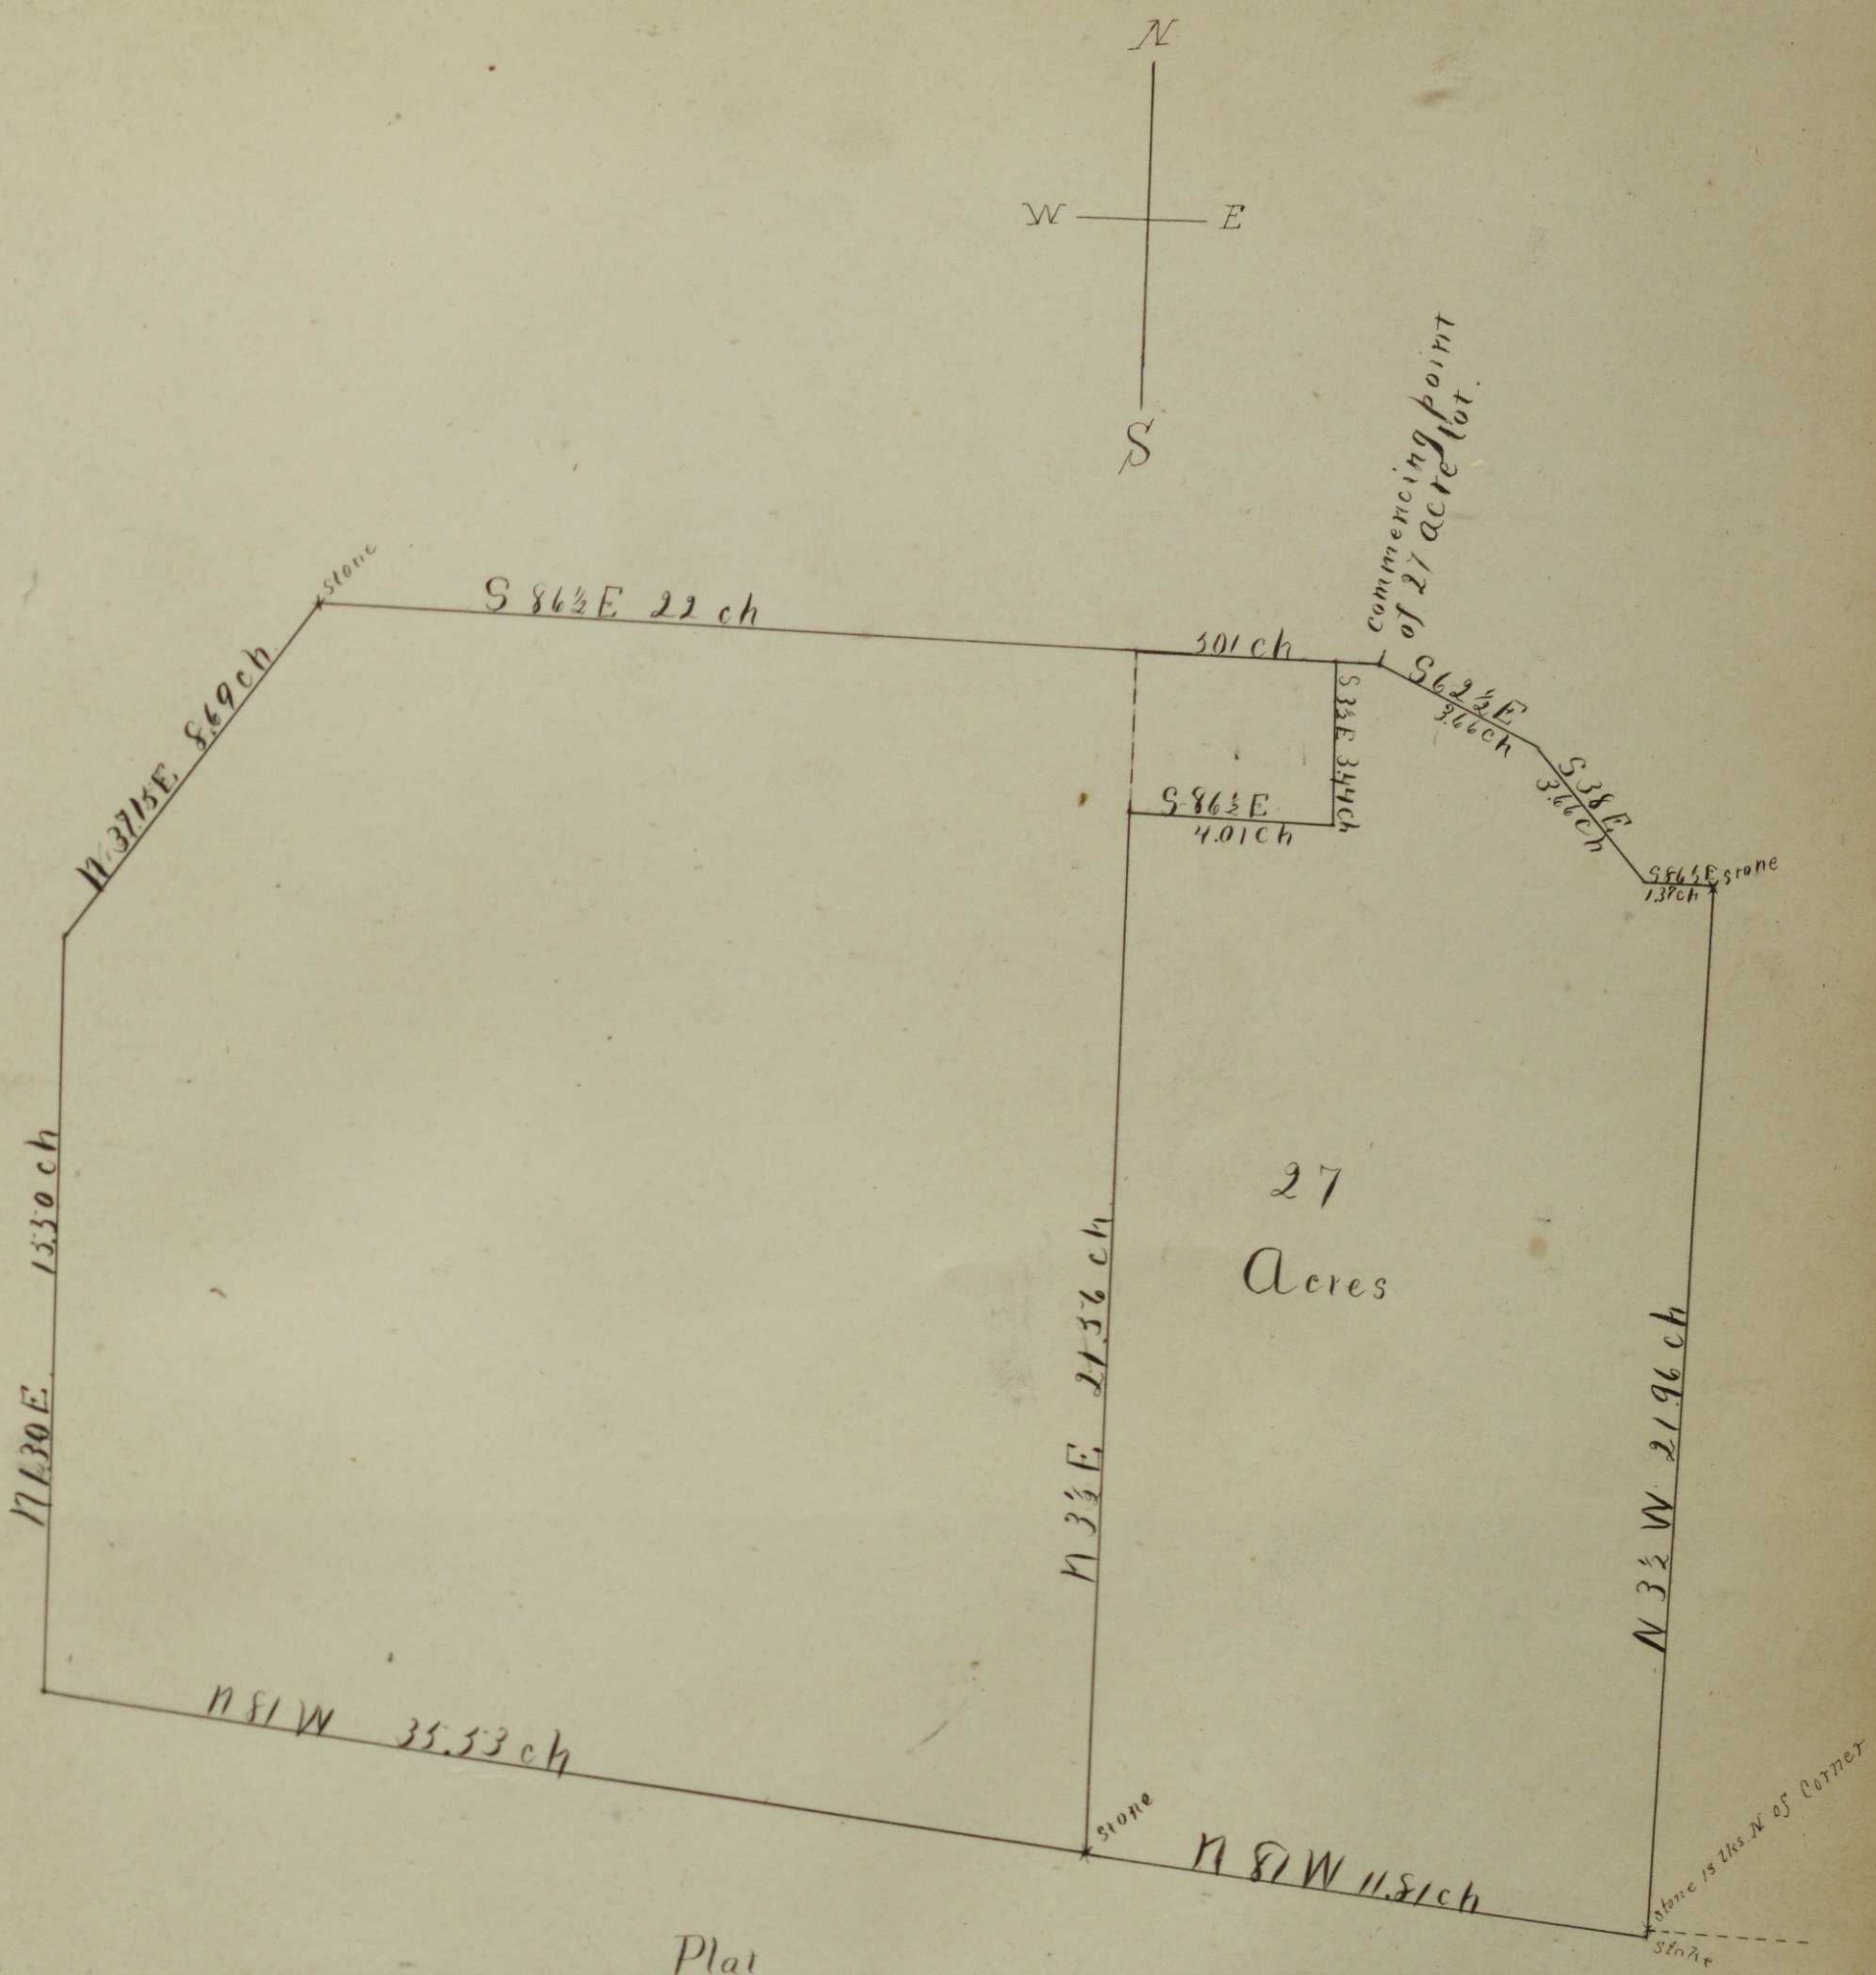

Plat
of a survey of land belonging to M. W. Printz being a part of the S. E.
quarter of Sec. 17 Township 15 Range 14 showing a subdivision by cutting
off a lot containing 27 Acres.

Surveyed Nov 27th 1889

M. W. Printz

Deft Co Surveyor

Variation 3 1/2° West.
Scale 4 ch to 1 inch.


Attest T. C. Connor
County Surveyor


Downer's Addition to the City of Zanesville Ohio

The dimensions of Lots. and the width of Streets and alleys are marked in feet on the plat
Said addition being part of the N.W. qr. of Sec 7. Tp. 12. R. 13.

A. J. Shaulding Surveyor
Attest. S. E. Connor
County Surveyor
September 1889

Scale 60 ft to 1 inch.

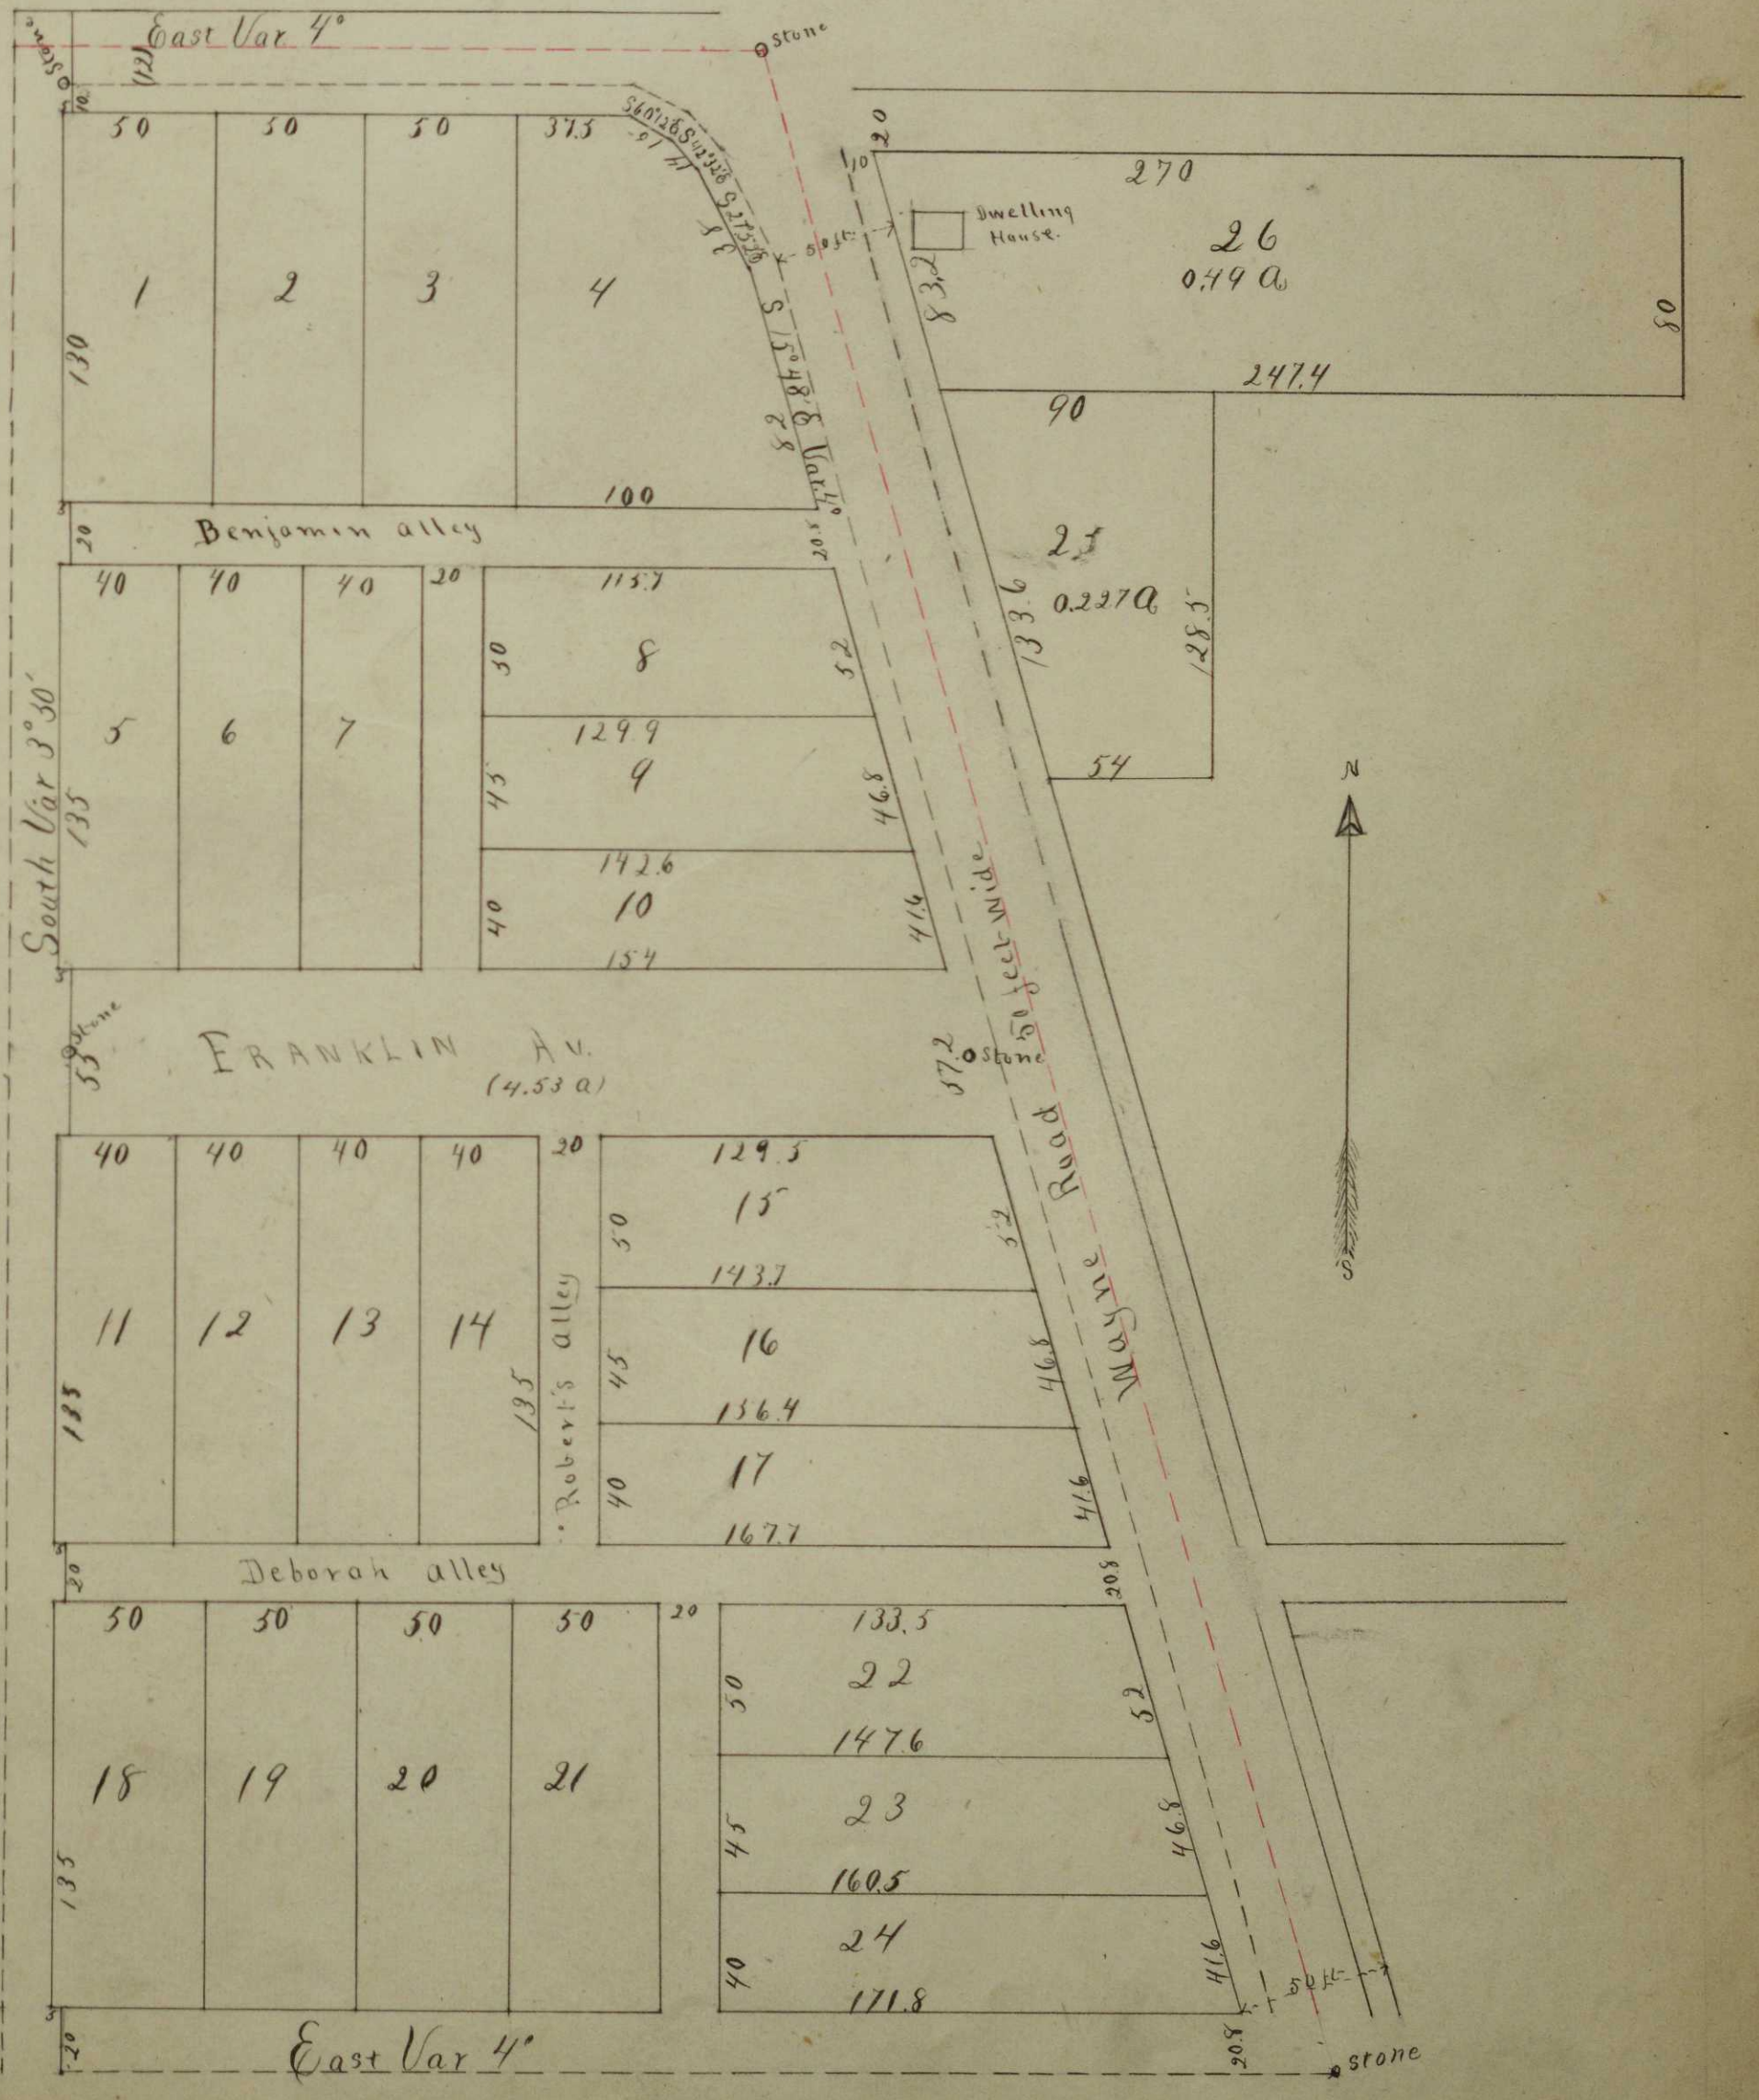

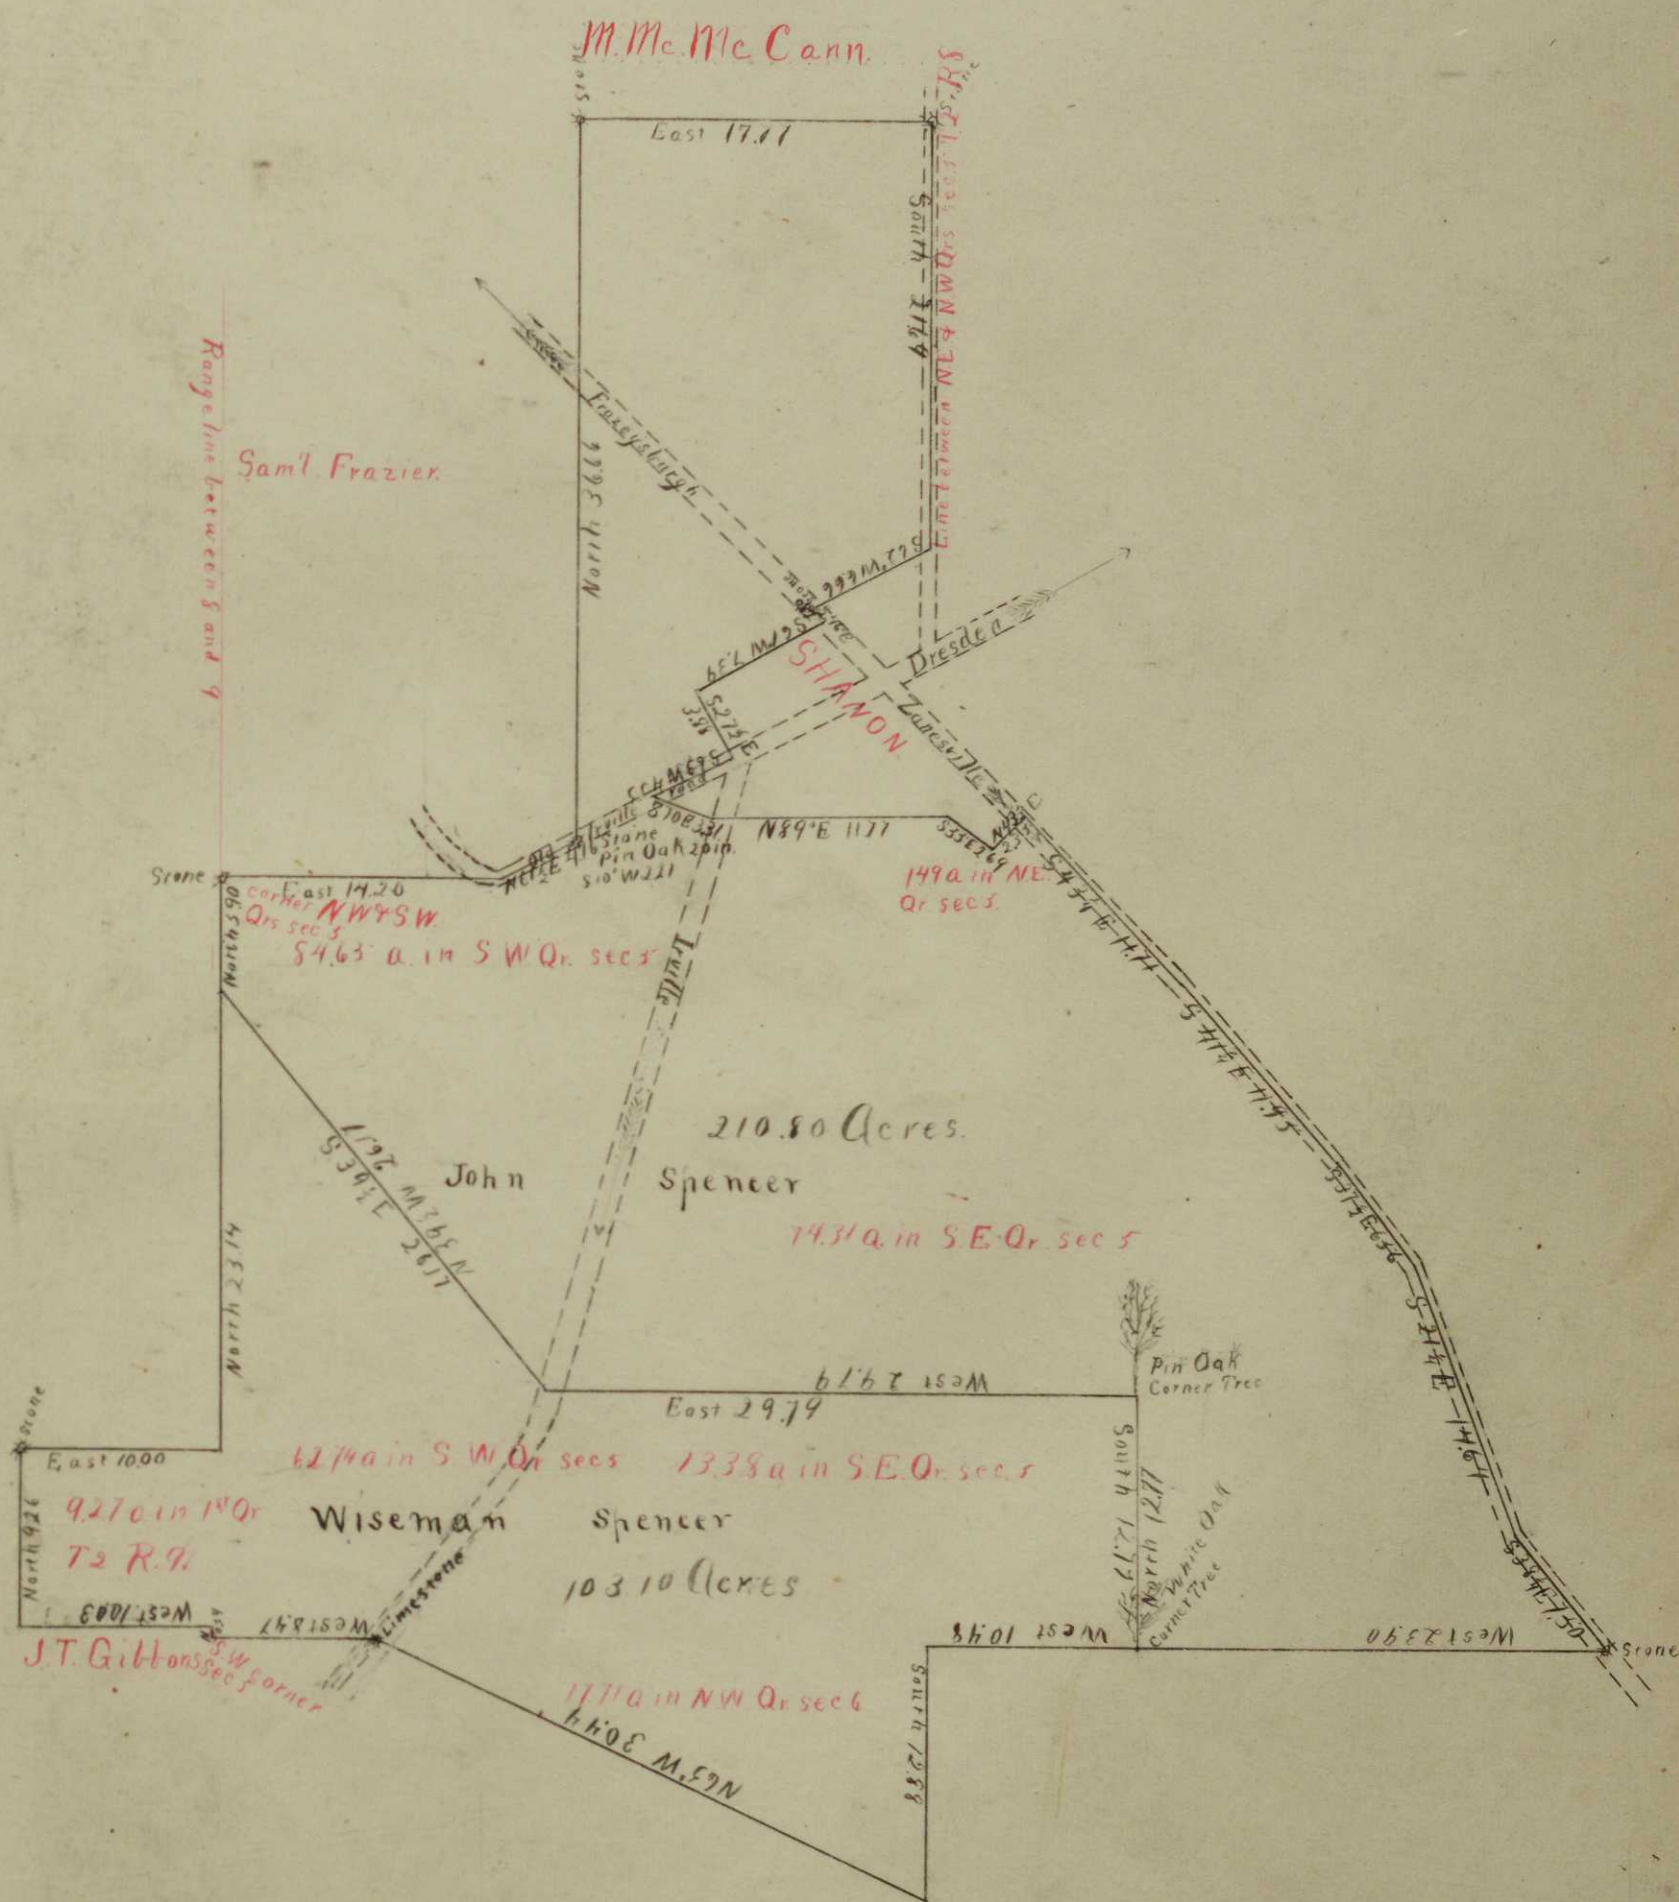

Plat
and Field notes of 1338 acres in S.E. Qr. sec 5 T. 2 R. 8, 17.71 acres N.W. Qr. sec 6 T. 2 R. 8 - 62.74 acres in S.W. Qr. sec 5 and 9.27 acres in 1st Qr T. 2 R. 9. Surveyed at the instance of Wiseman Spencer. And 84.65 acres in S.W. Qr. sec 5 - 50.35 acres in N.W. Qr. sec 5 and 149 acres in N.E. Qr. sec 5 T. 2 R. 8. All in Muskingum Township, Muskingum County, Ohio. Surveyed at the instance of John Spencer October 18 and 19 by

Joseph Fisher, Surveyor.

Scale 10 chains to 1 inch

Survey and plat of location
of County Road running from
Frazey's Burg to West Carlisle as
ordered by the County Commissioners
and surveyed Feb 25 1850
J. C. Connor by Wm Dunn

End of Survey

S. E. corner of land owned by
Josiah Oden and The
N. E. Corner land owned by
John C Lemert and
on the west line of land
owned by
Charles Lemert

Sept 10 Surveyor

1st Beginning of Survey at
the S.W. corner of the lands
of David McNaught

PLAT

OF


HARPER'S ADDITION

TO

NEW CONCORD OHIO

Scale 50 feet = 1"

B. & O. R.R.

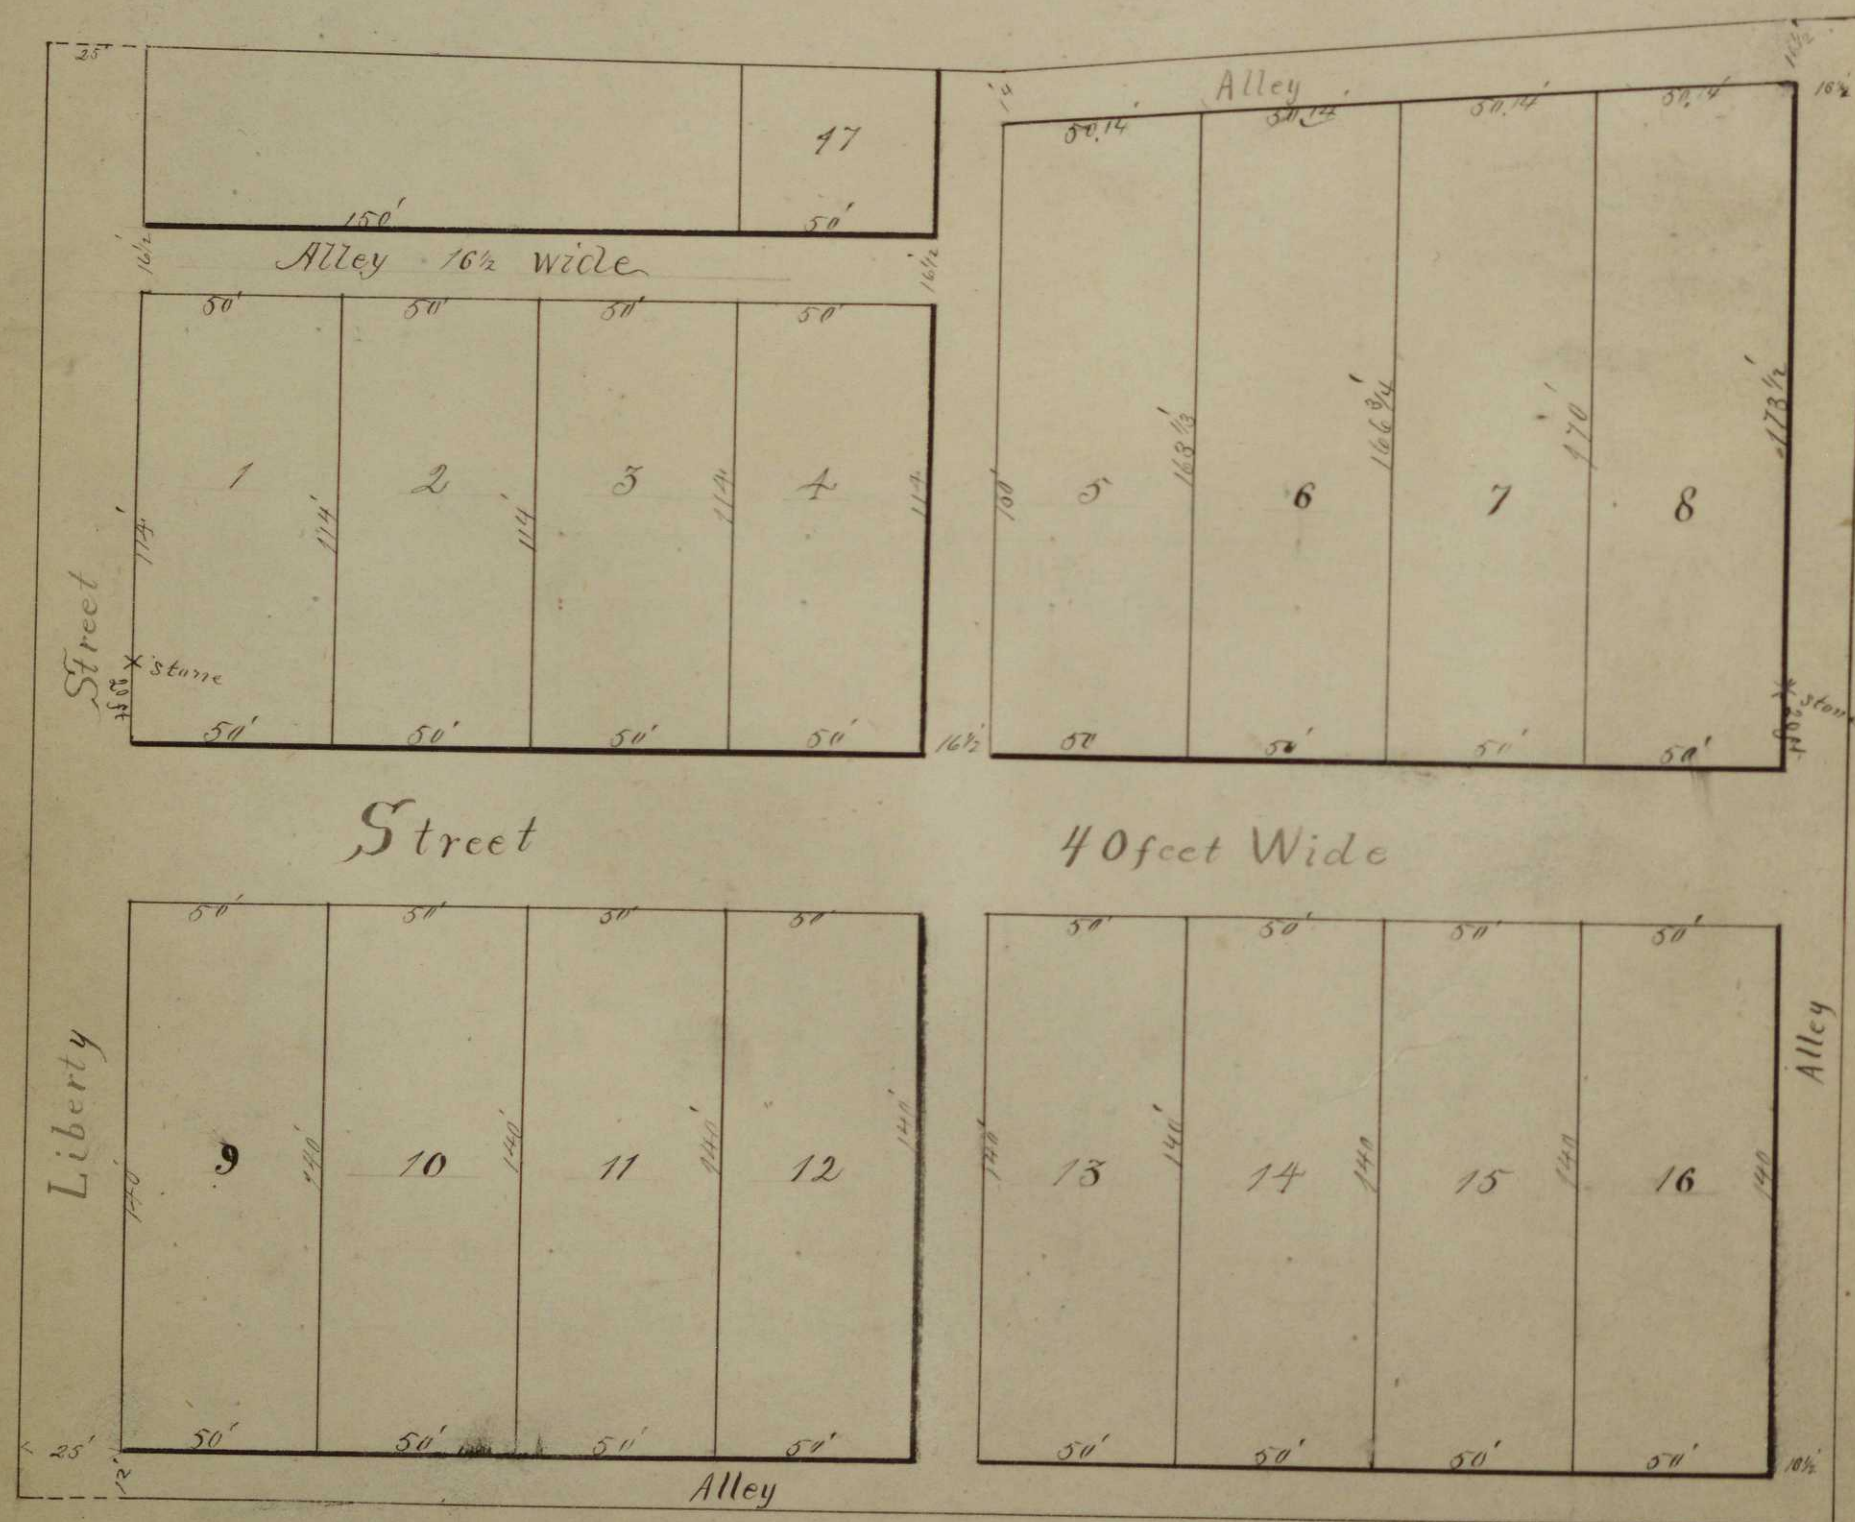


PLAT

of

An alteration of the Zanesville & Shannon Road

Scale 4 ch = 1 inch

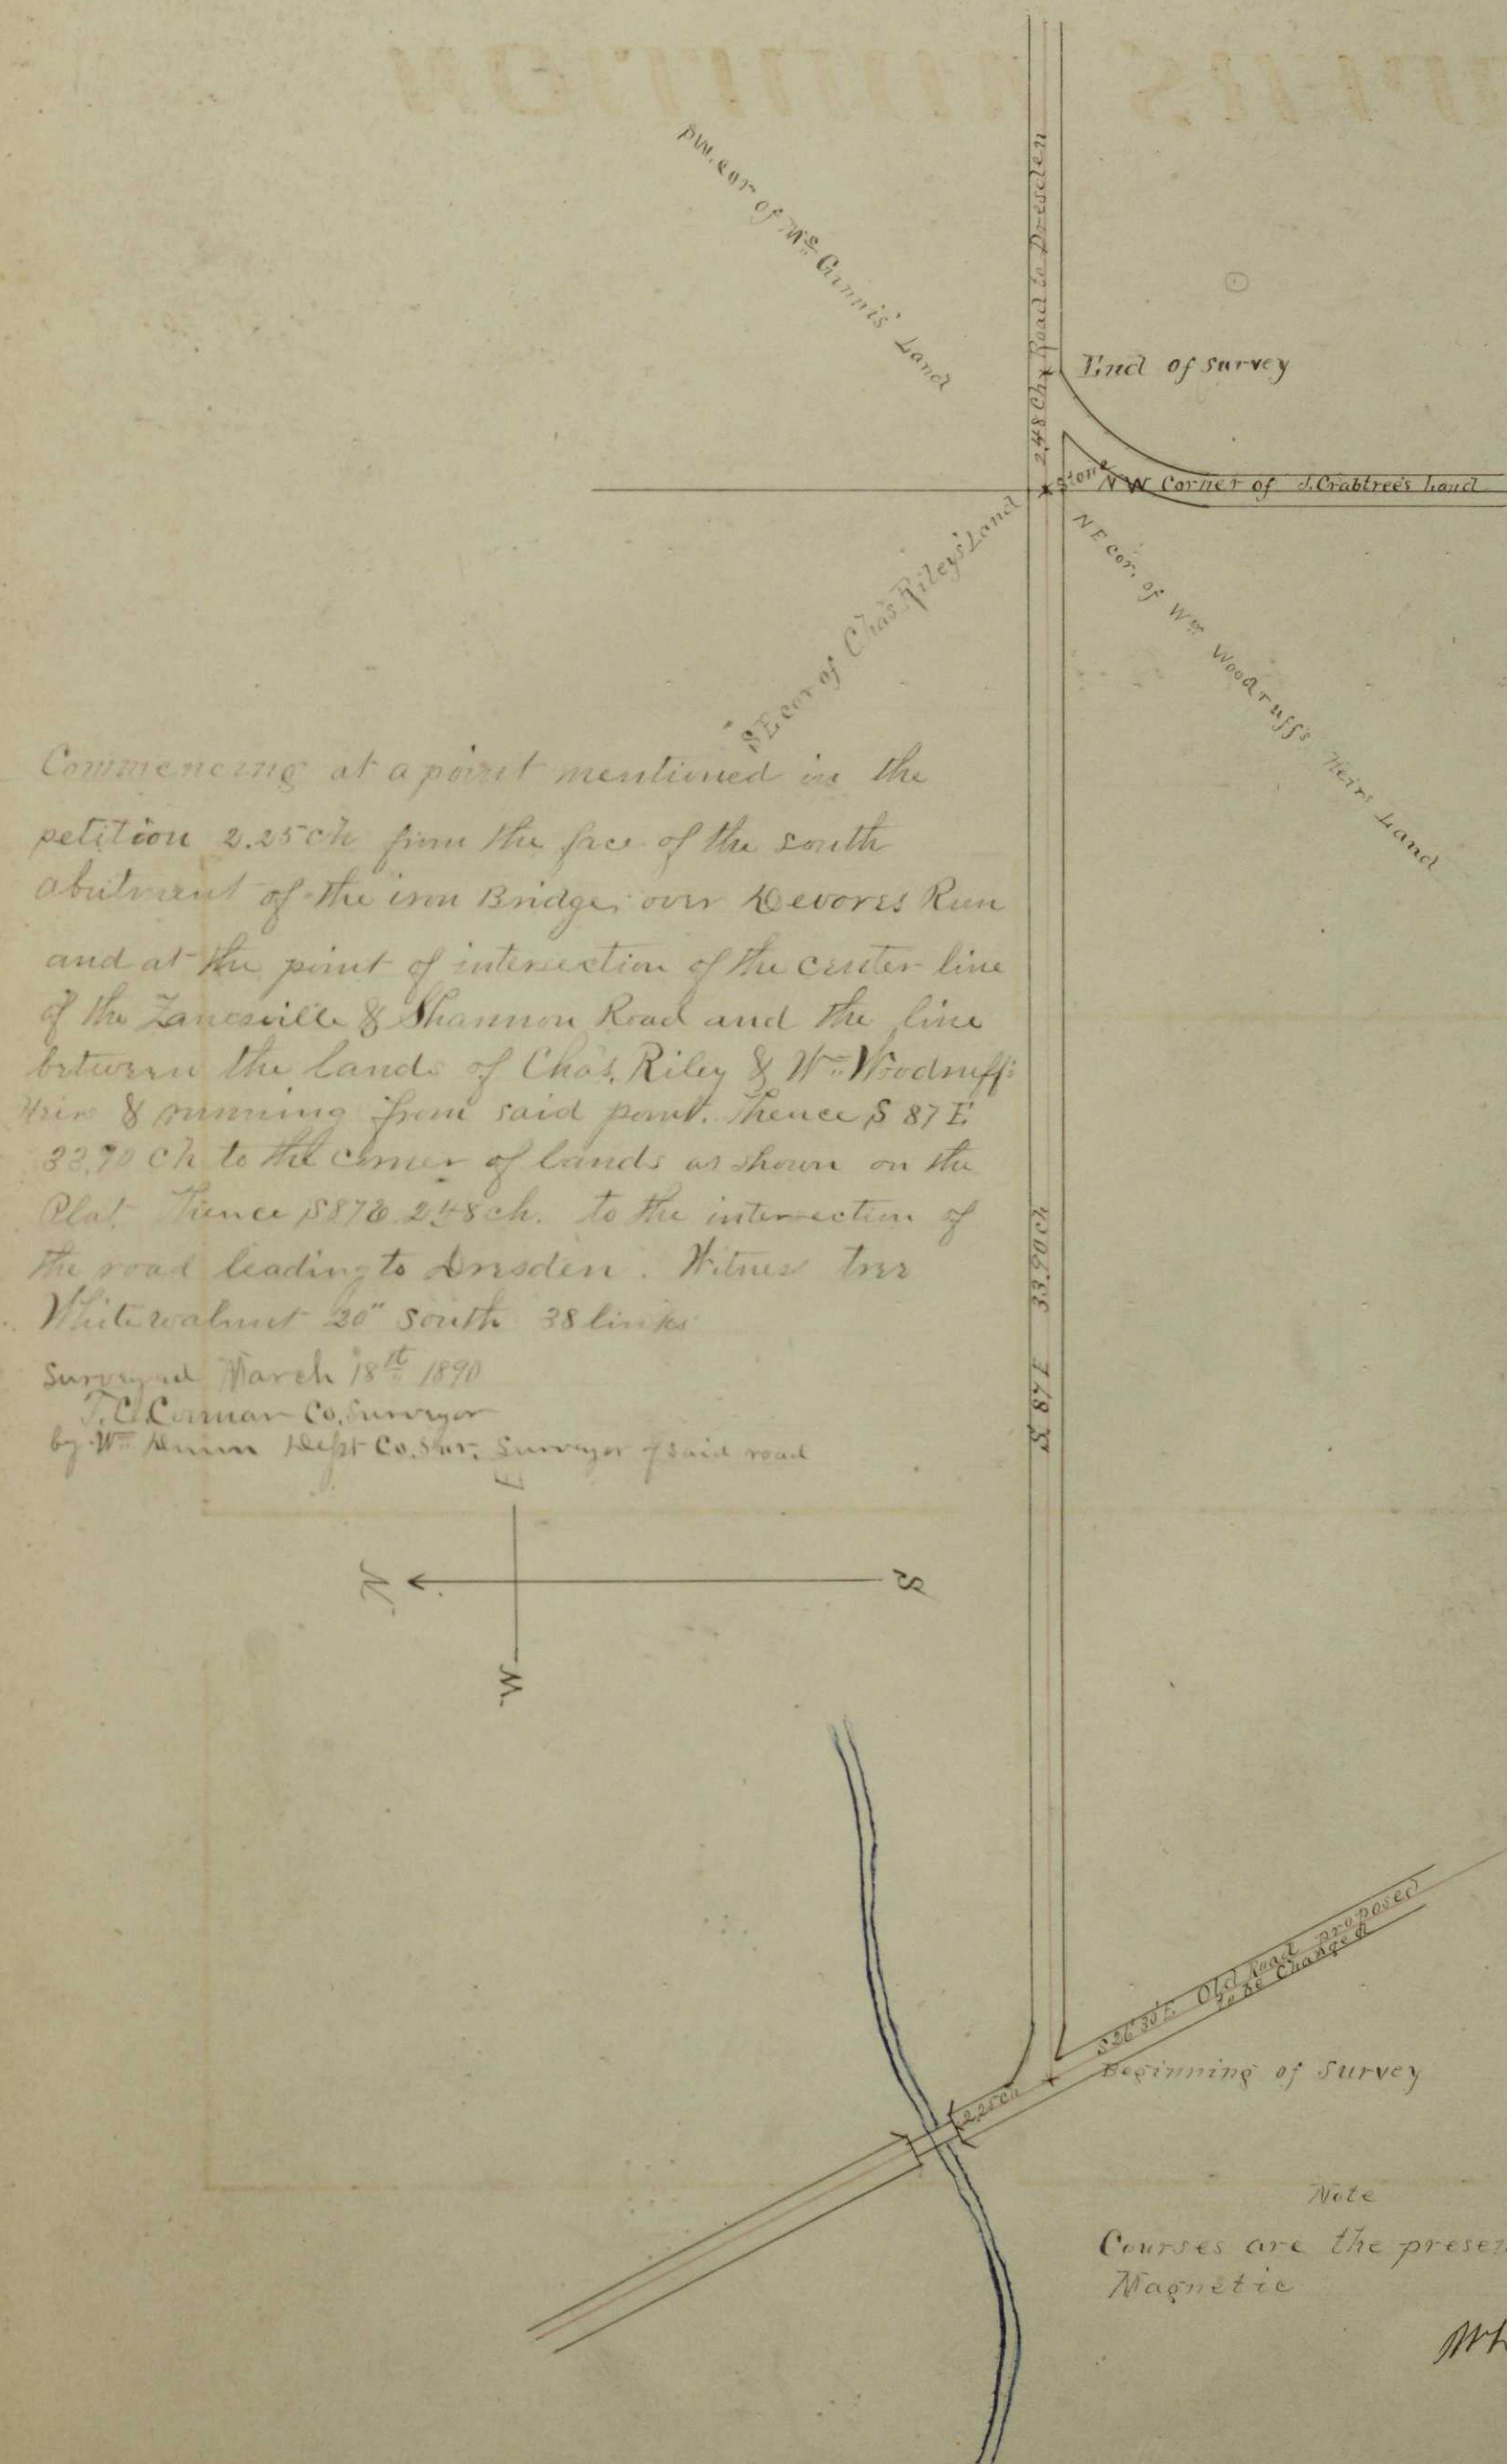



An Alteration of Coal Run Road

Surveyed March 27 & 24th - 1890

Seule Heh = 1271011

J. C. Corcoran Surgeon

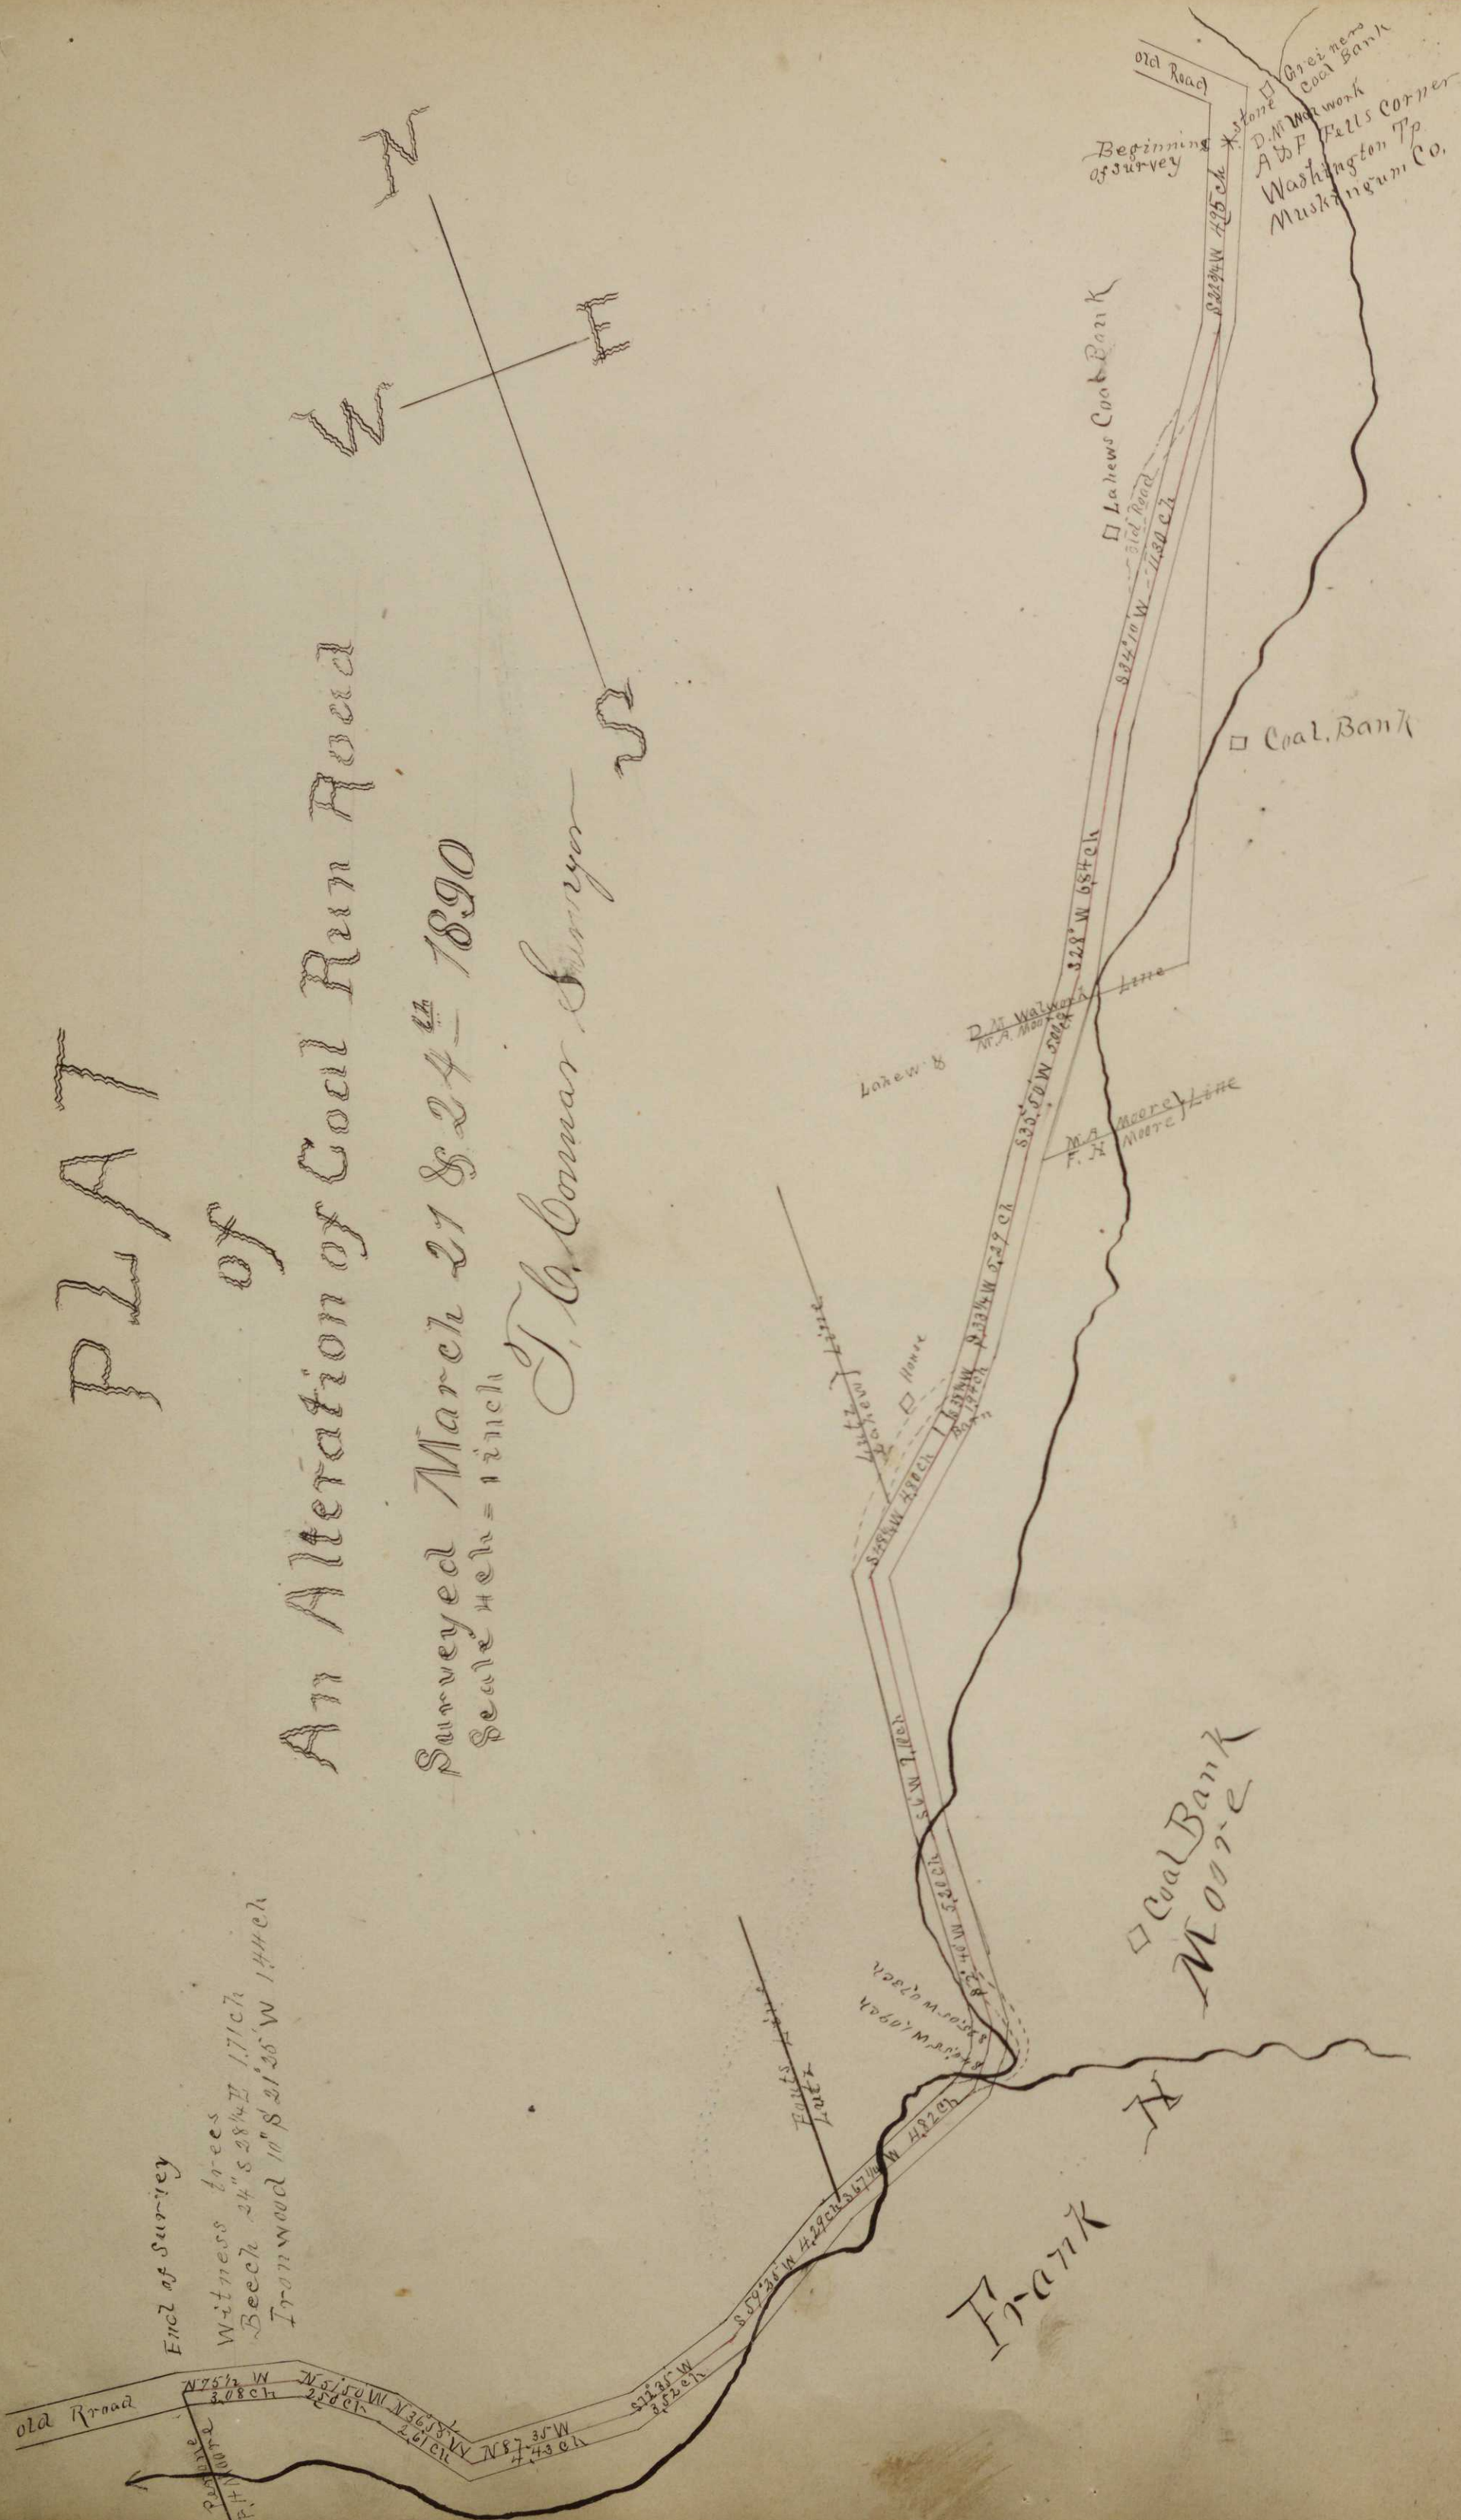


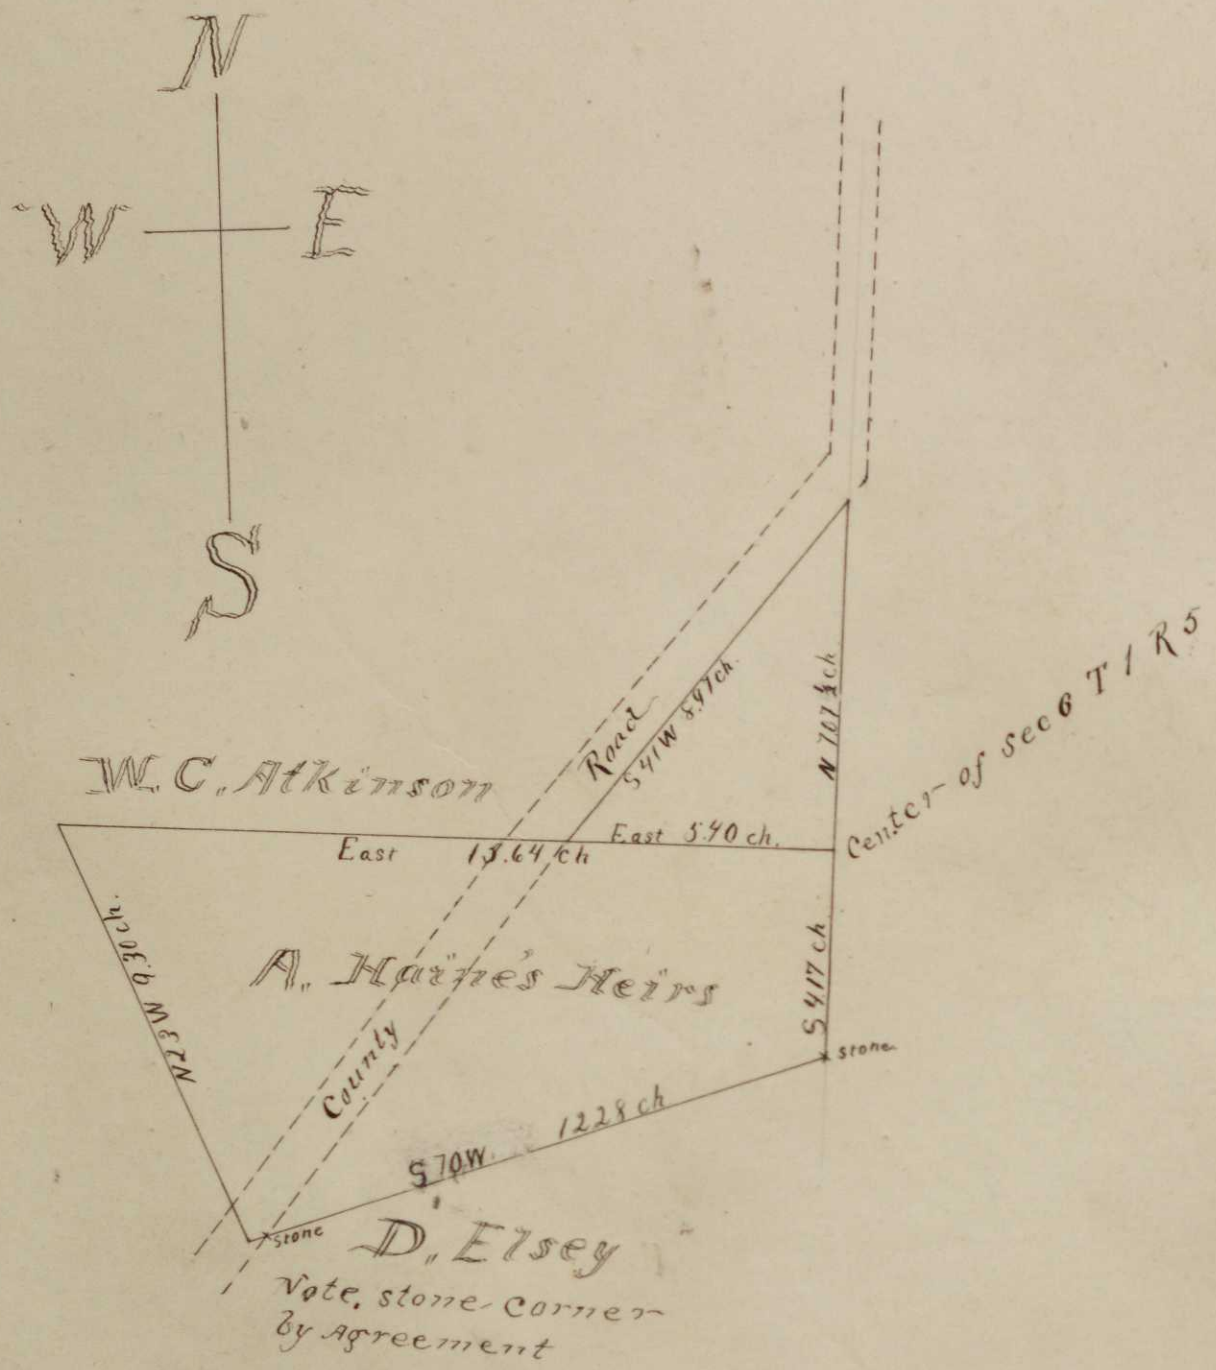

Plat of a Survey made at the instance of A P Drumm.
in Township 1 Range 9. (Hopewell. T.P.) being a part
of Lots No 18 & 23. Surveyed April 3^d 1890.
Courses are Magnetic at time of Survey
Scale 400 ft to an inch.


Scale 4 cm to 1 inch.

A. J. Spaulding, M.D. Surgeon

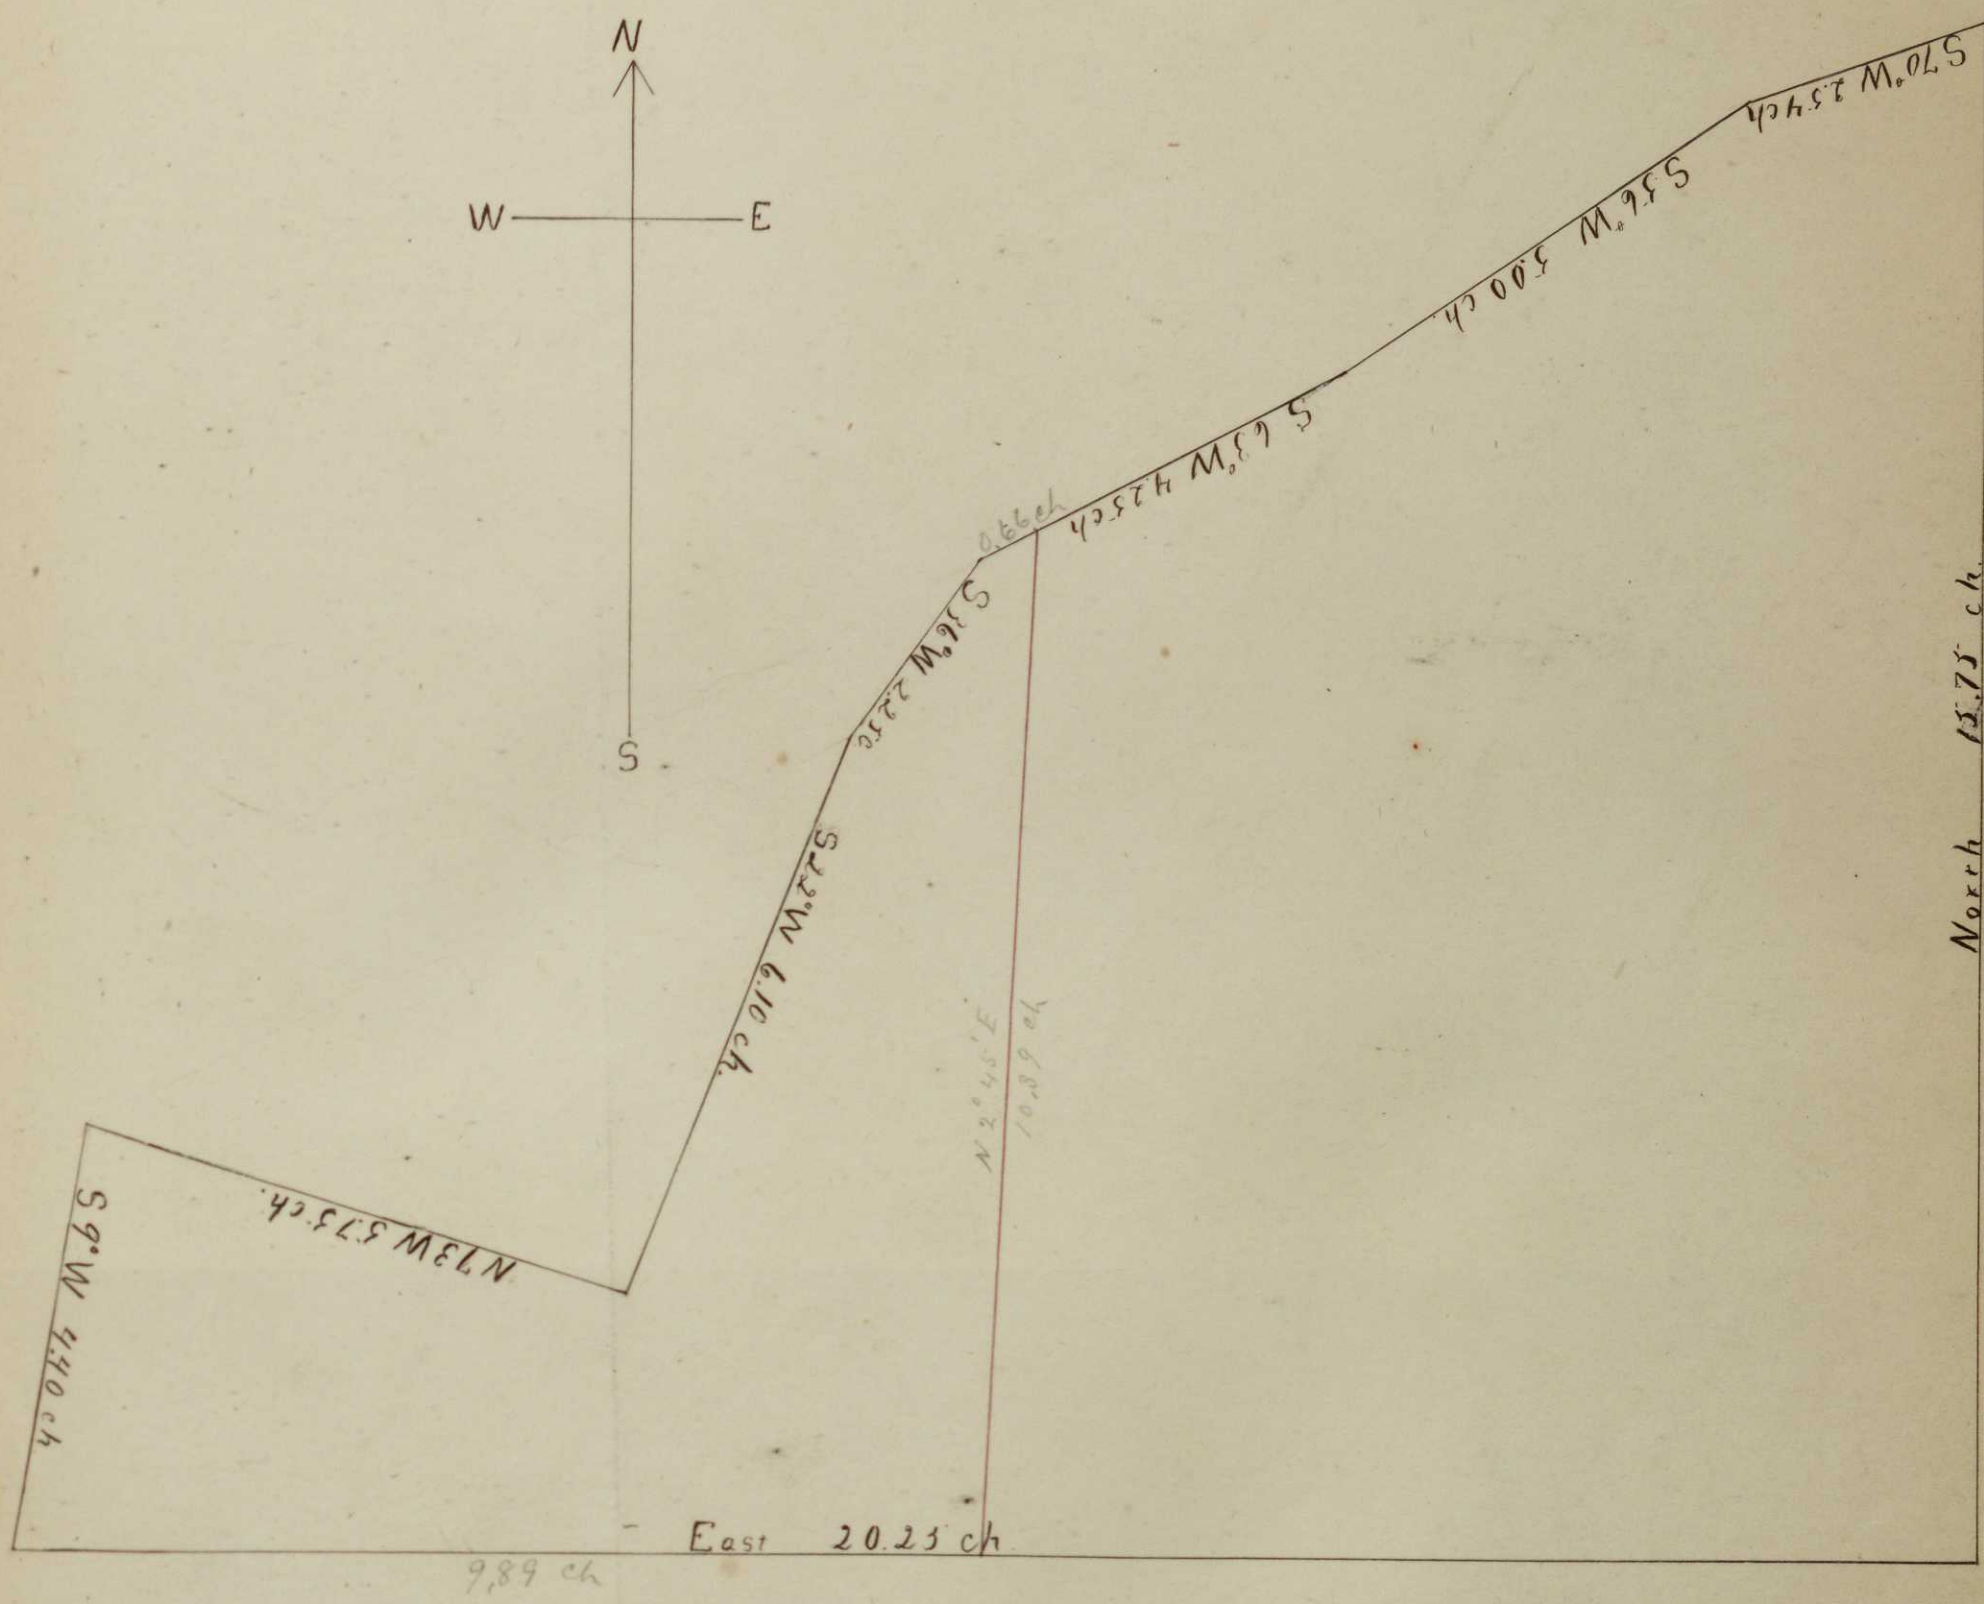


Plat
of a survey of land belonging to Charles H. Roberis situated in
Township 15 Range 14 (Newton Tp.) being in the S. E. corner of the
N. W. $\frac{1}{4}$ of Sec. 32 containing 18 $\frac{1}{2}$ Acres.
Surveyed May 9th 1890 by

W. Dunn
Deputy Co. Surv.

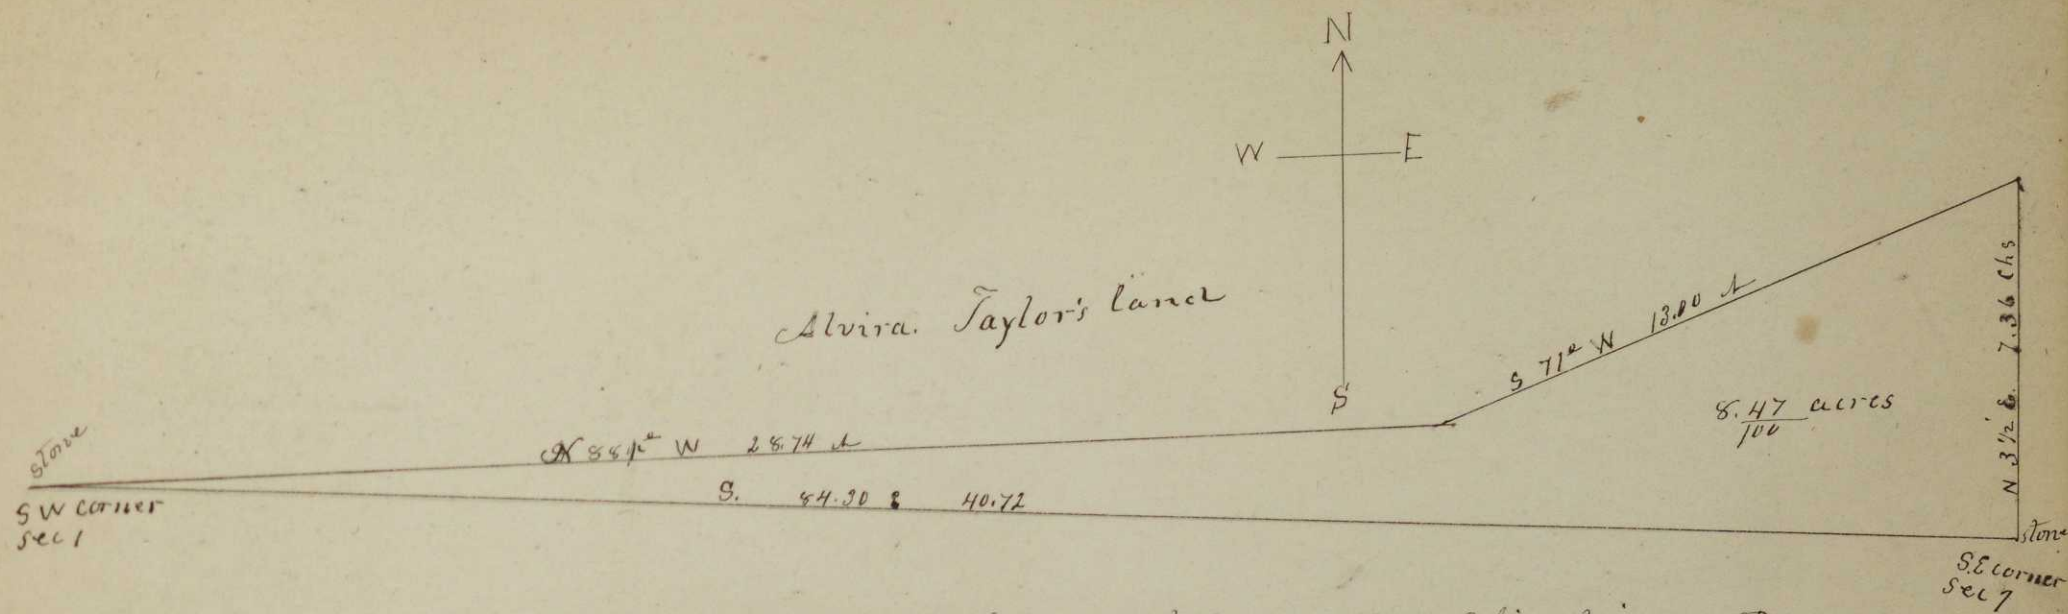

Plat and survey of land belong to Eliza Winn Deceased
 Situated in Perry Township Muskingum Co Ohio bounded
 on the North by land of Alvira Taylor on the south by the
 land of Mr Winn's Heirs On the East by the land of
 W. A Blair and is the south part of the SW 1/4 of sec 7 - T 1 R 6
 surveyed March 23 1891


W. H. Dunn,
 Deputy Co. S.

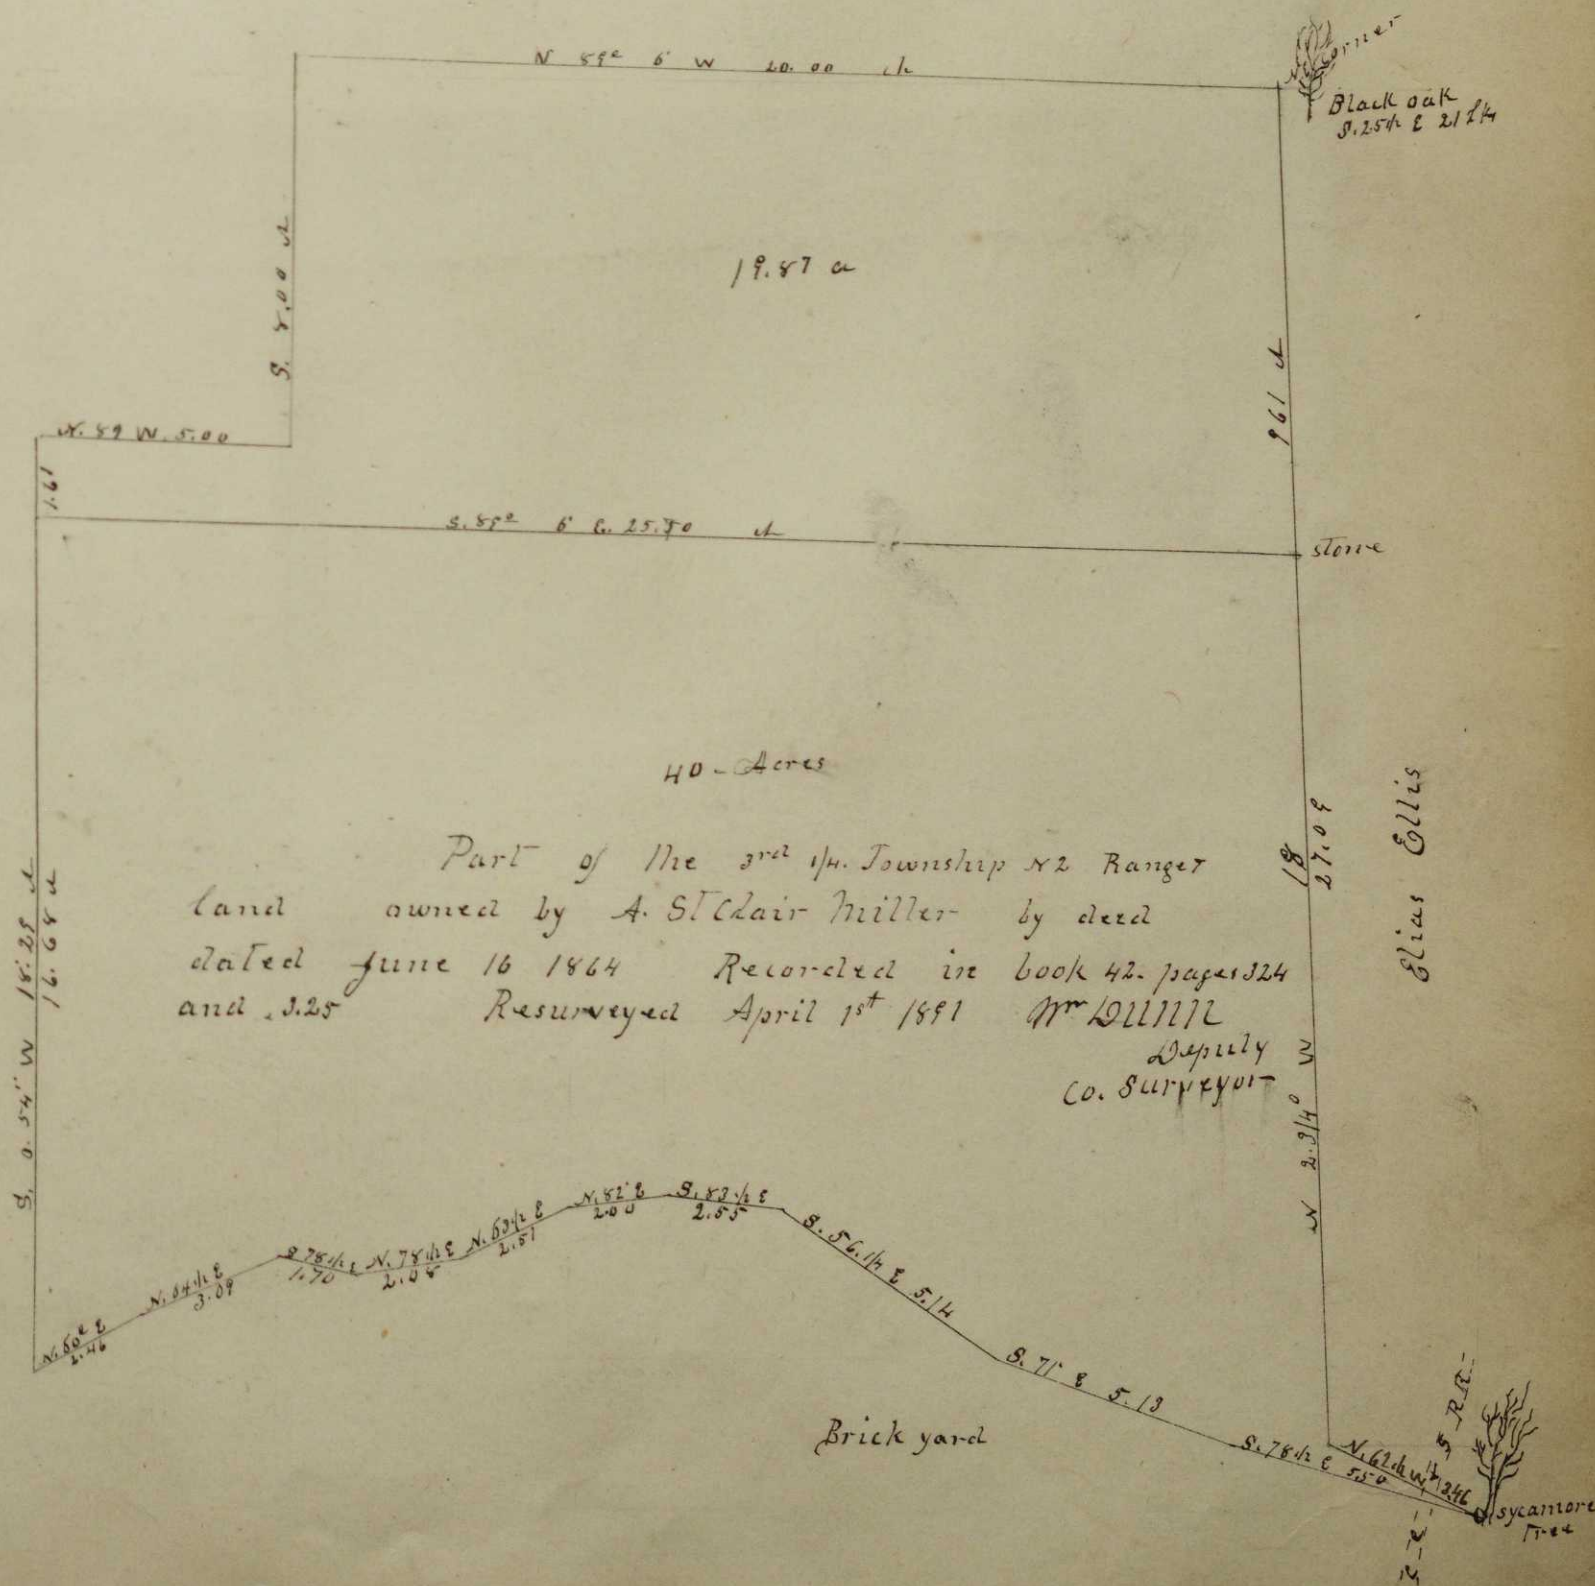


Plat and field notes of land
belong to M. C. Crane. Situated in 3rd 4th
Township No 1 Range 6

Surveyed April 17th 1891

McDunn
Deputy Co
Surveyor

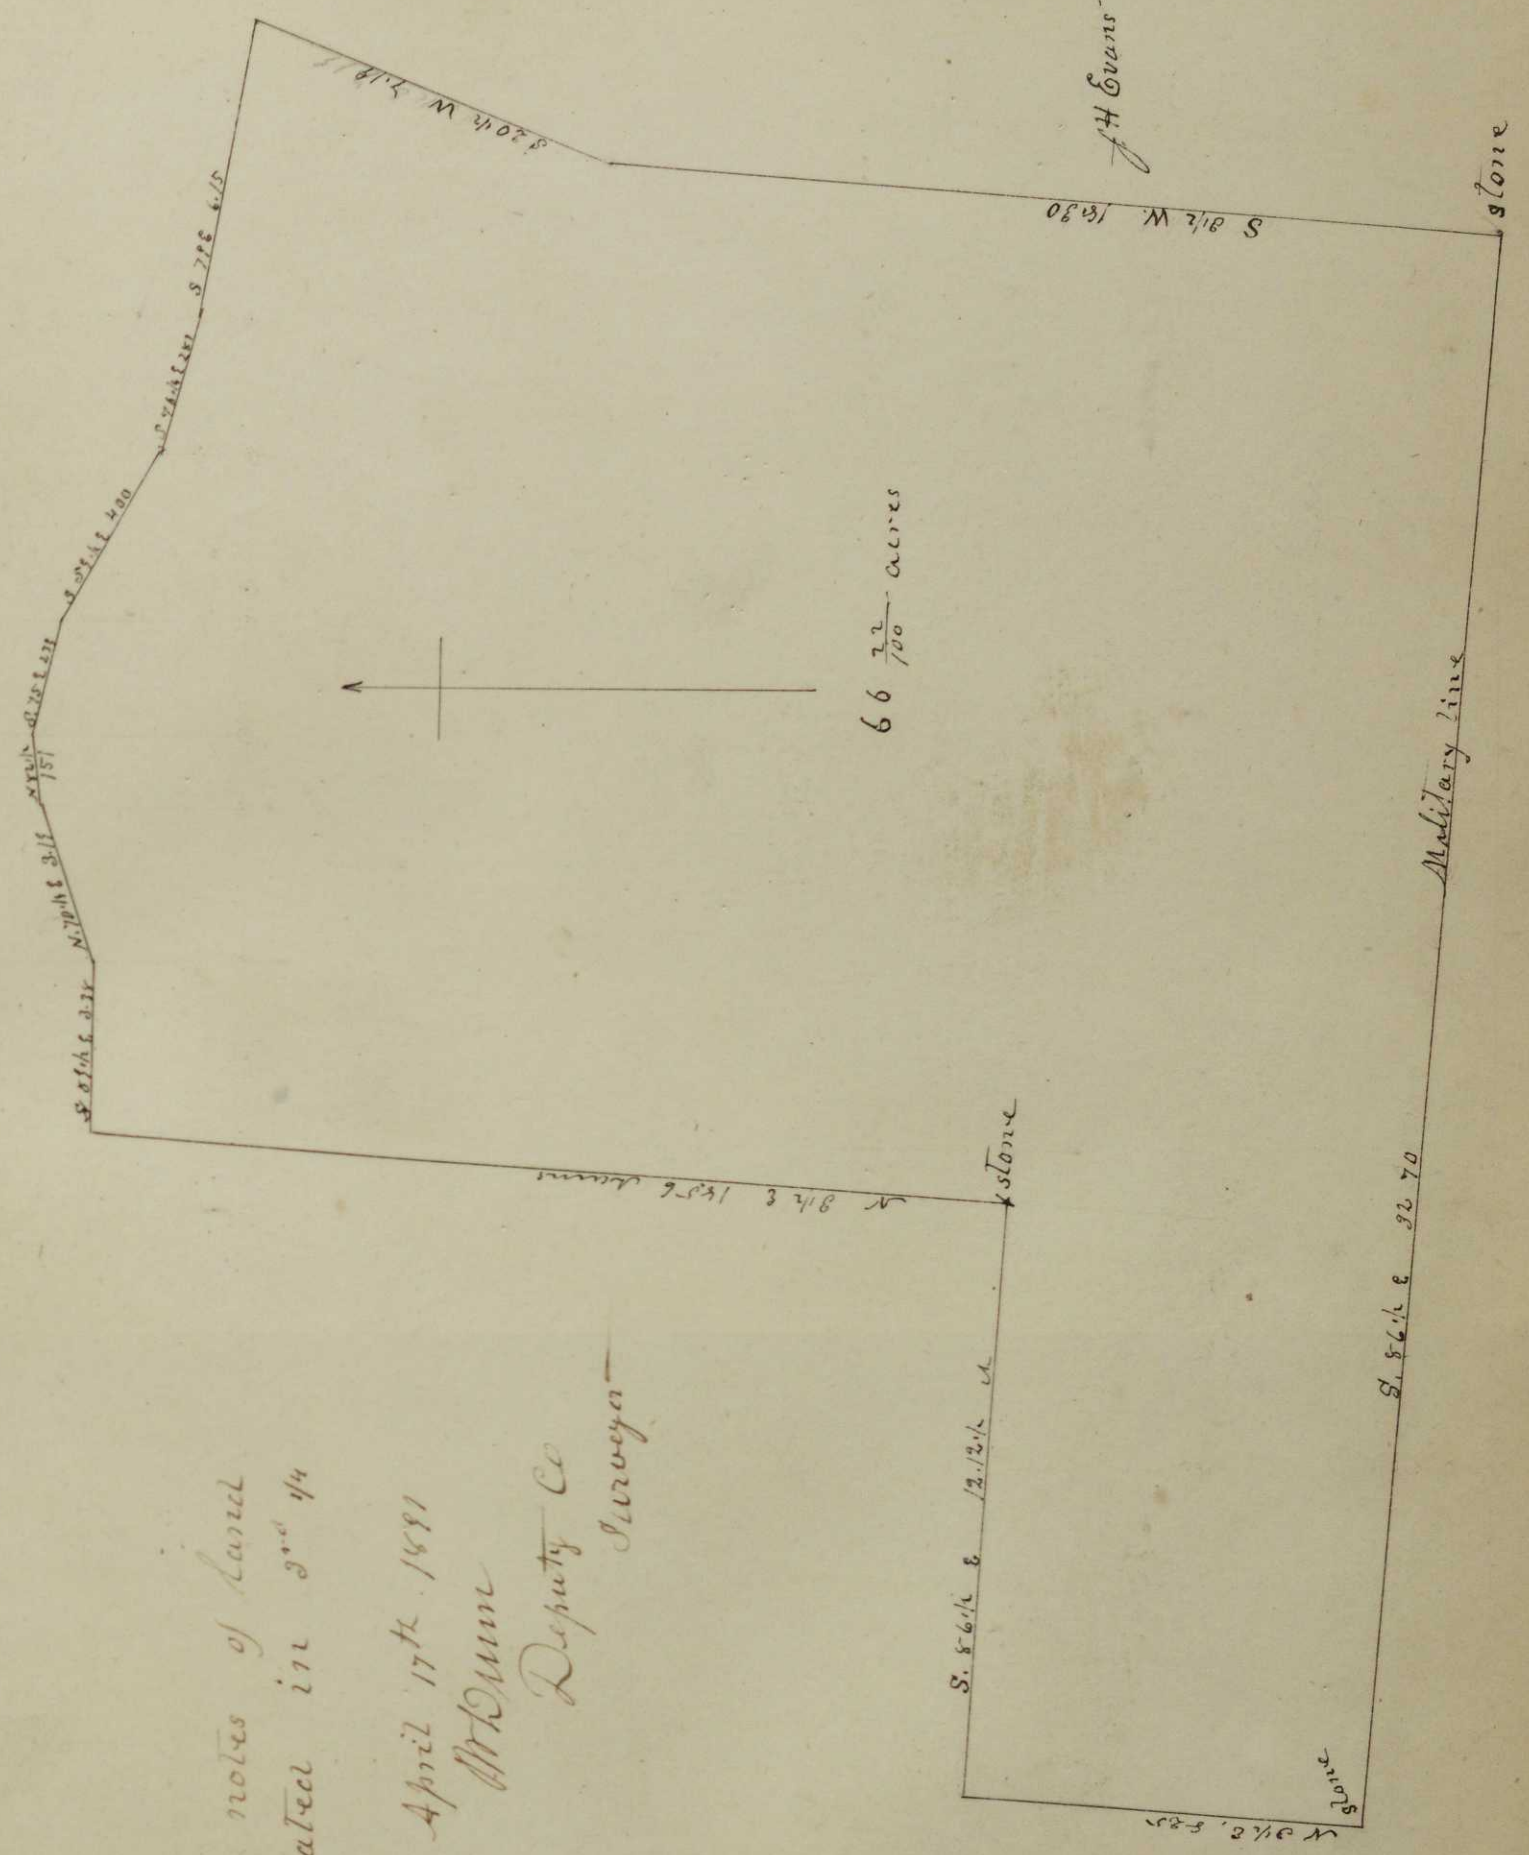

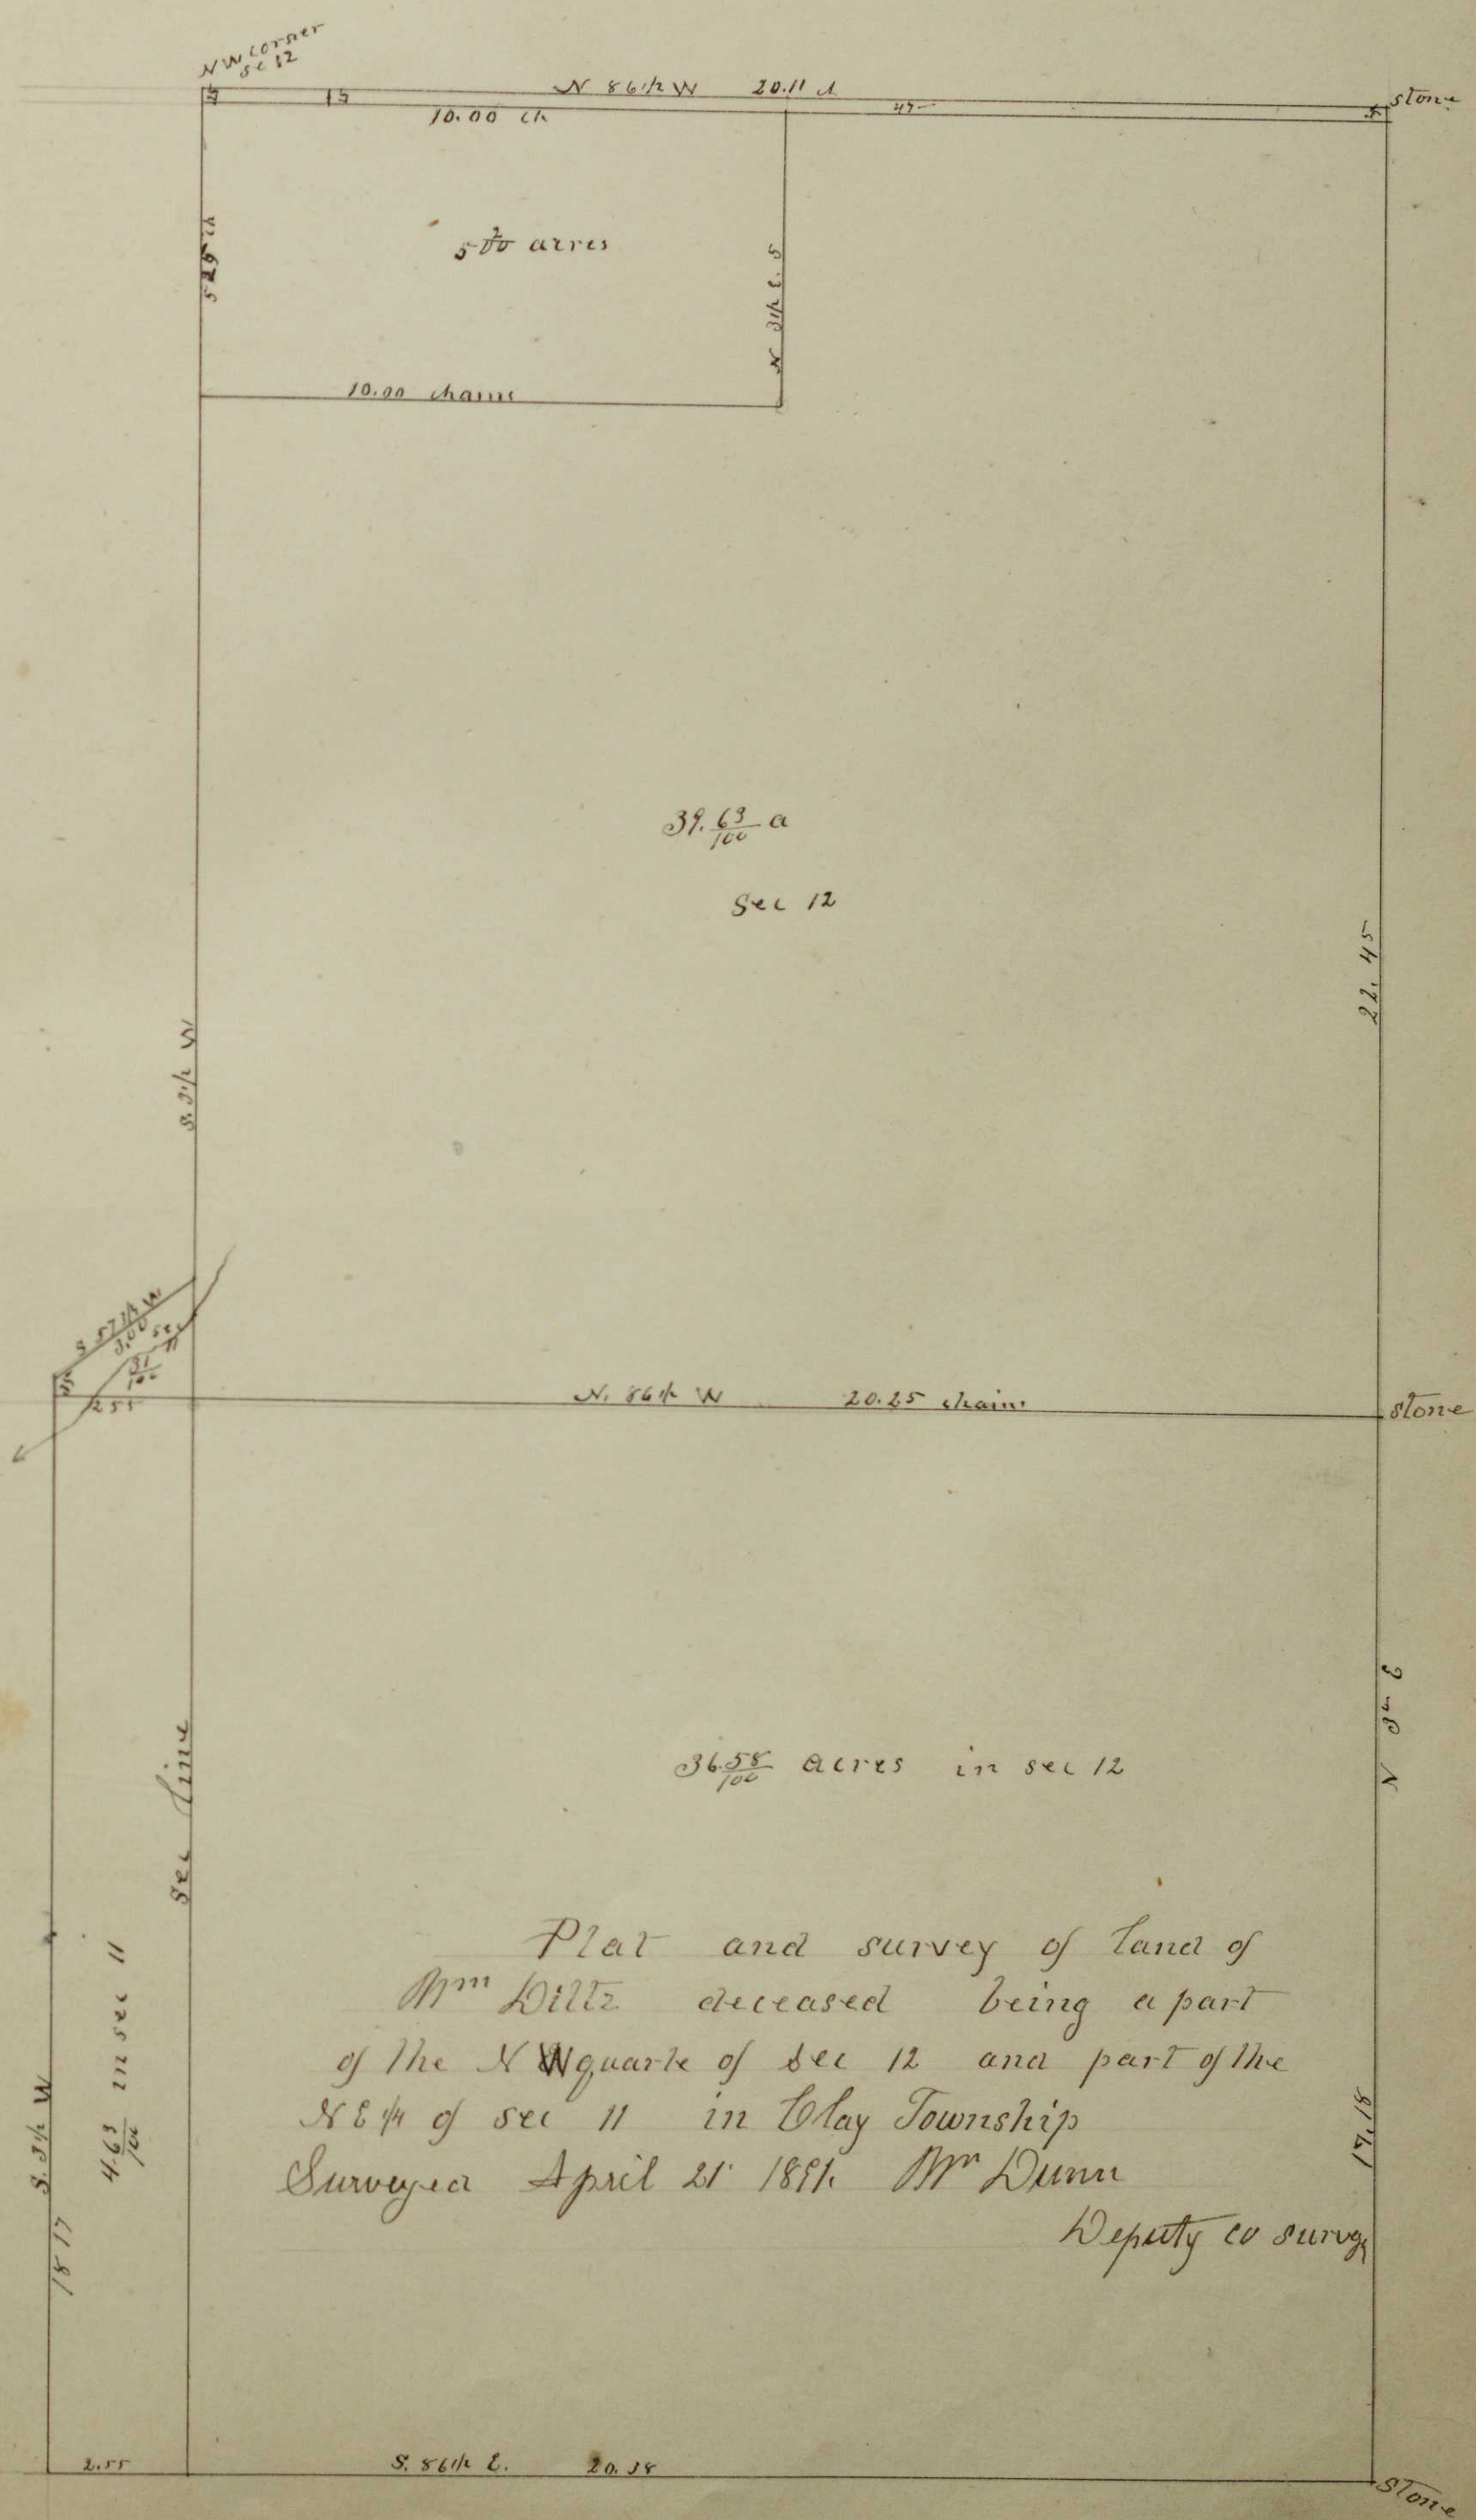

Plat and survey of land of
Mr Diltz deceased being a part
of the N W quarter of sec 12 and part of the
S E 1/4 of sec 11 in Clay Township
Surveyed April 21 1886 Mr Dunn
Deputy co surveyor

Newton Township

Brush Creek Township

North

Levenship Line

slake in
corner of fence

X 86 1/2 W S. 86 1/4 E 40.32 - ch
19 ch

81. $\frac{15}{100}$ acres NW $\frac{1}{4}$ Sec 15

Take

S. 3 1/2 W 20, 13.1 k

N. 864 E. 40.32 A.

81- $\frac{18}{100}$ SW $\frac{1}{4}$ sec 15

4 feet 2 1/2 in true
S 40 W 1/4

$\frac{5084W}{42.11}$
 $\frac{5084W}{42.11}$
 $\frac{5084W}{42.11}$

N. 34^o 42.11

35 $\frac{85}{100}$

28/12 1941

N. 66 1/2 E 25.80 ch

* Gum Tree 14" diam
on corner

S. 3 1/2 W 40-18 1/2 d



Township line.

Plat and Survey of
lands of Henry Leisure Deceased
being a part SW $\frac{1}{4}$ + NW $\frac{1}{4}$ of sec 15 Brush creek
^{Township} present Magnetic Mr. Dyer says
June 2 + 4th 1891

SE
SW
T 11

stone
corner of
1/4 sec 15
R 15


NW corner
SW 1/4 sec 4
SW 1/4 sec 24

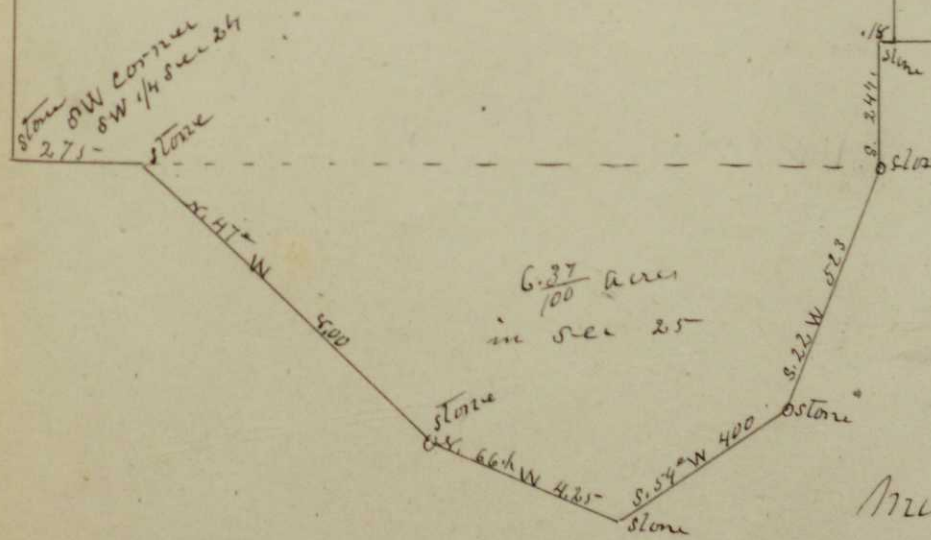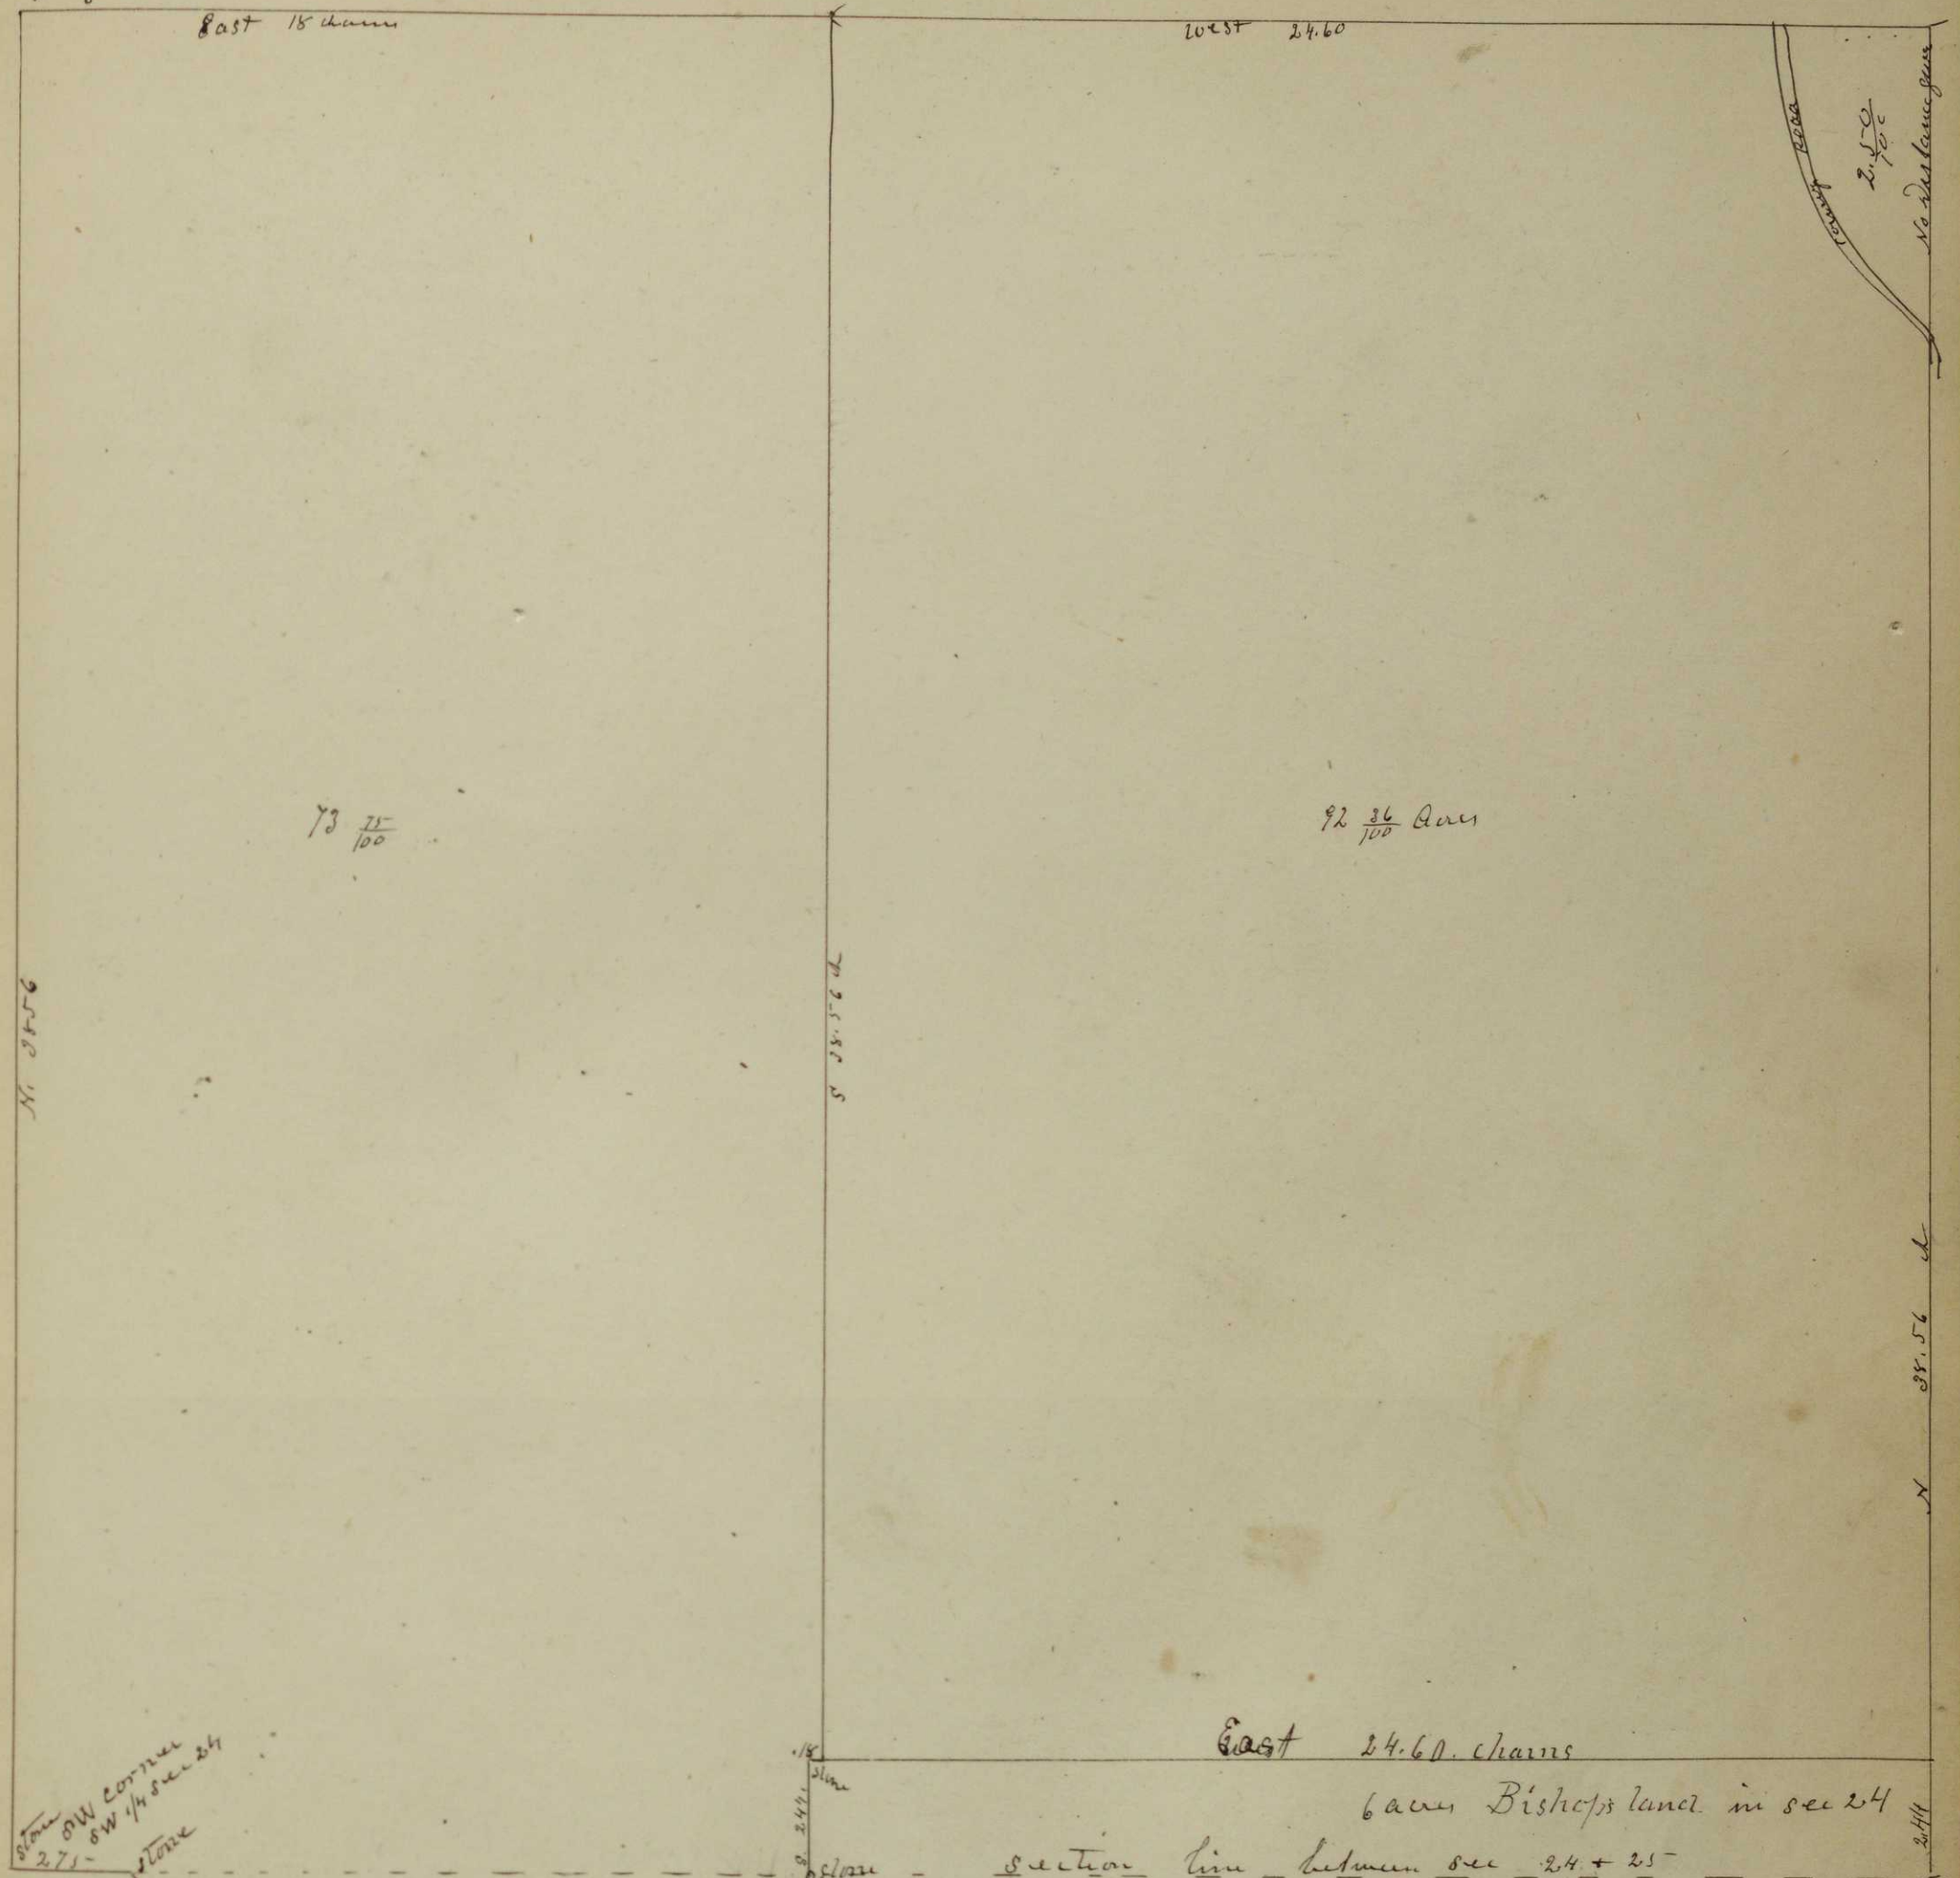


Plat + field notes of a survey of a
part of the SW 1/4 of sec 24, and a part of
NW 1/4 of sec 25 T 15 Range 14

Muskingum County Ohio The courses and
distances are all marked on their respective lines
The quantities are marked in acres + hundredths
Lands belong to John Baughman. Surveyed Aug 11. 1891
W. Dunn Dep. C.S.


stone
SW corner
SW 1/4 sec
24

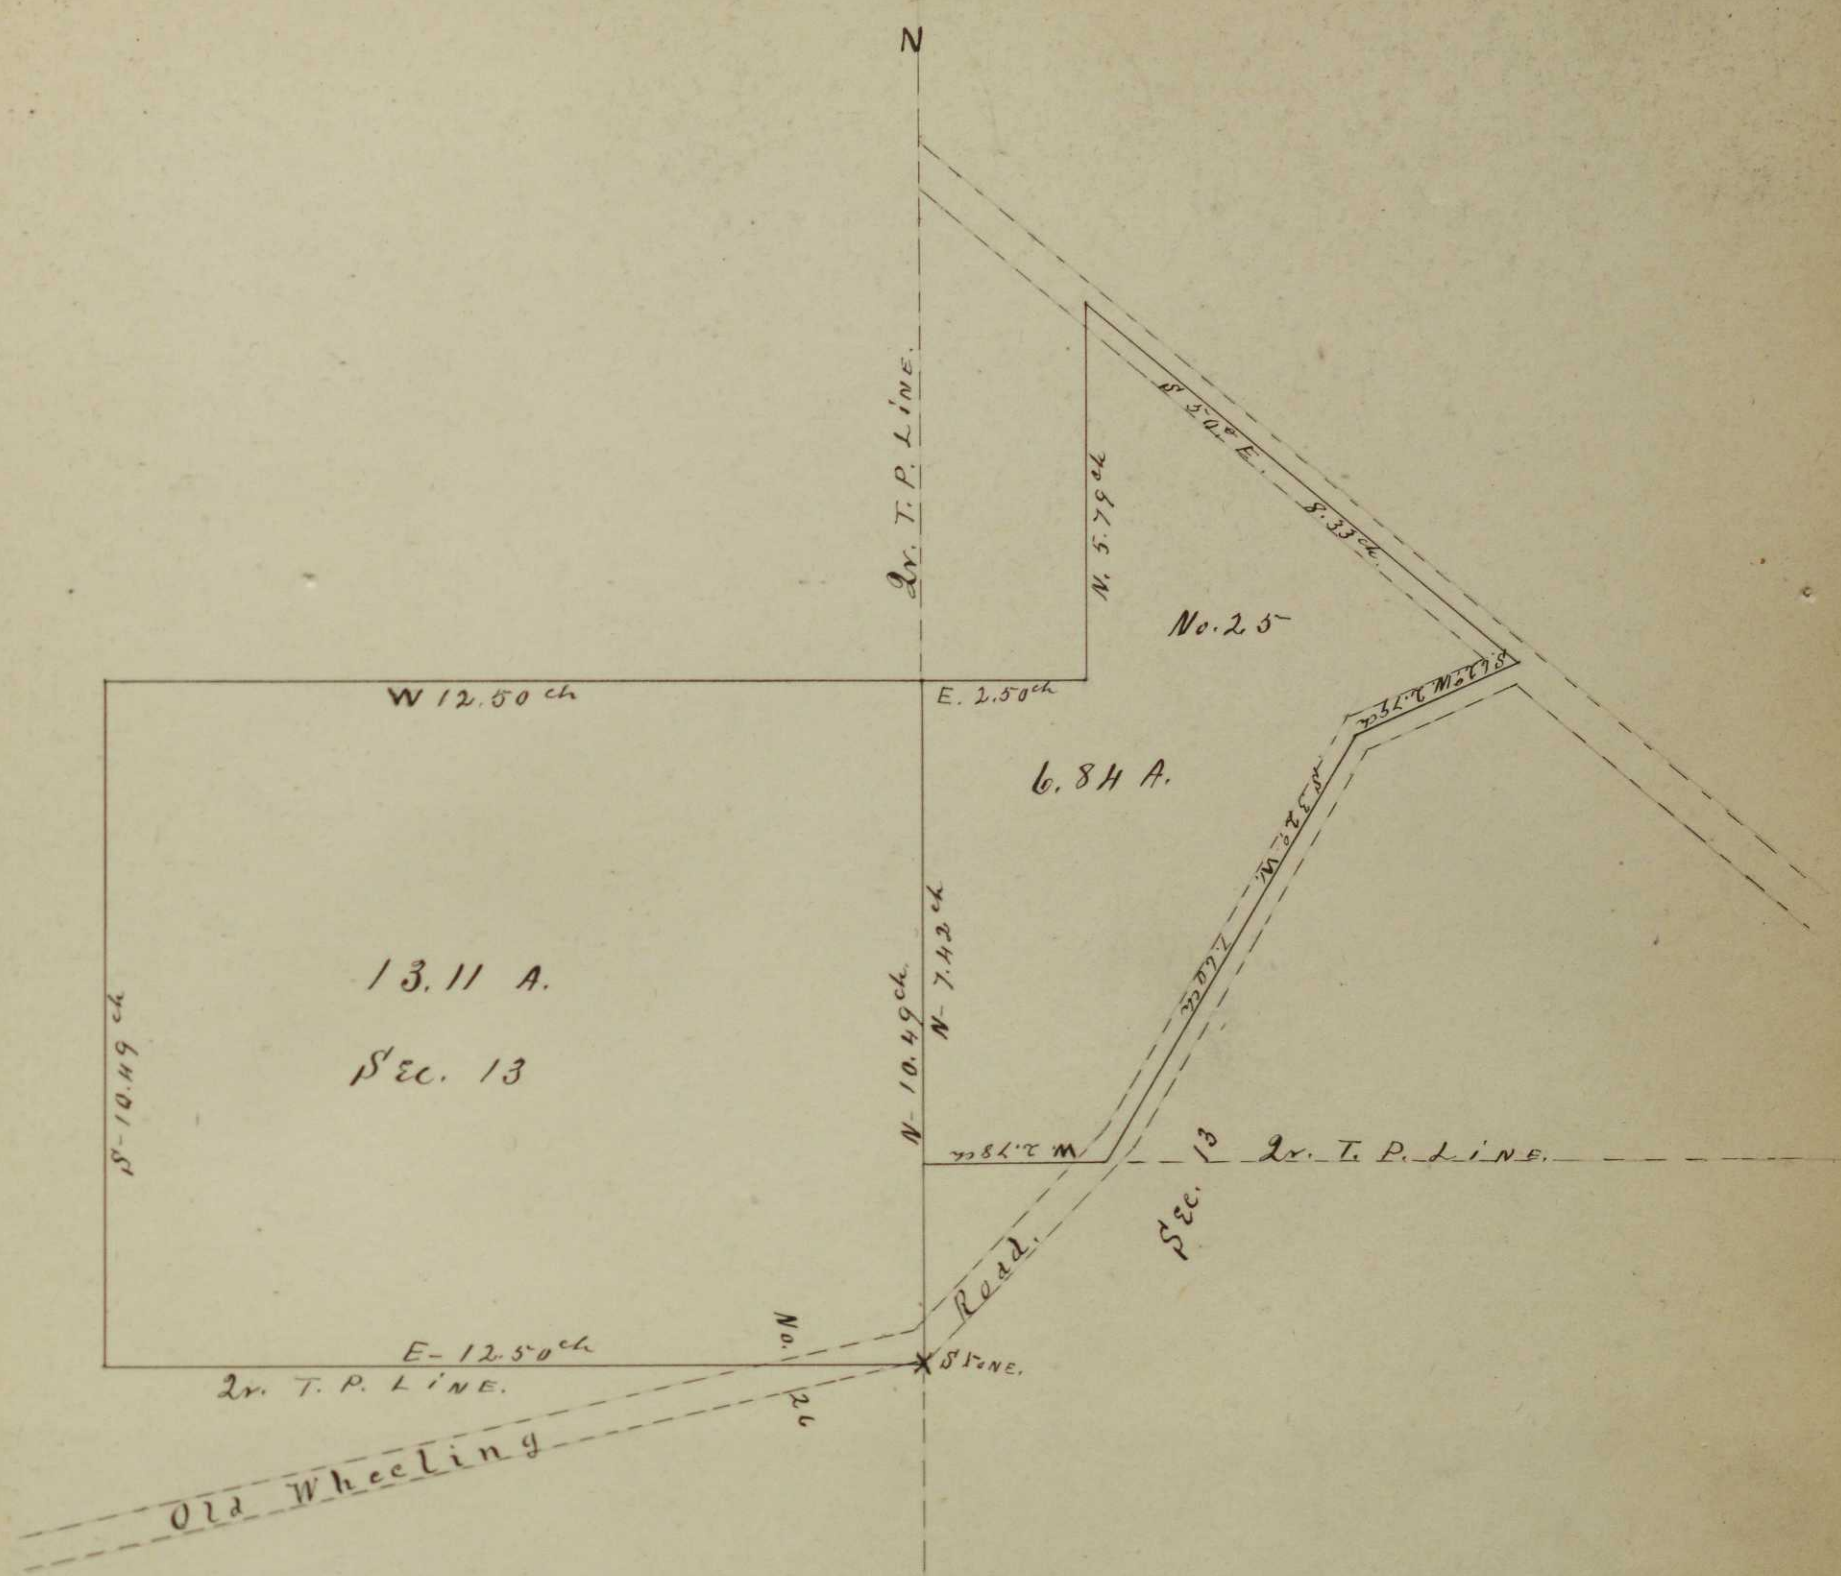

Survey of two tracts of Land for Joseph White.
First tract is a part of N.E. 1/4 Sec. 13, T. 1. R. 5. Containing 6.84 A.
The second tract is a part of N.W. 1/4 Sec. 13, T. 1. R. 5. U.S.M. Land.
Containing 13.11 A.
Surveyed Sept. 2nd 1891.
By R.A. Cunningham
Deputy.

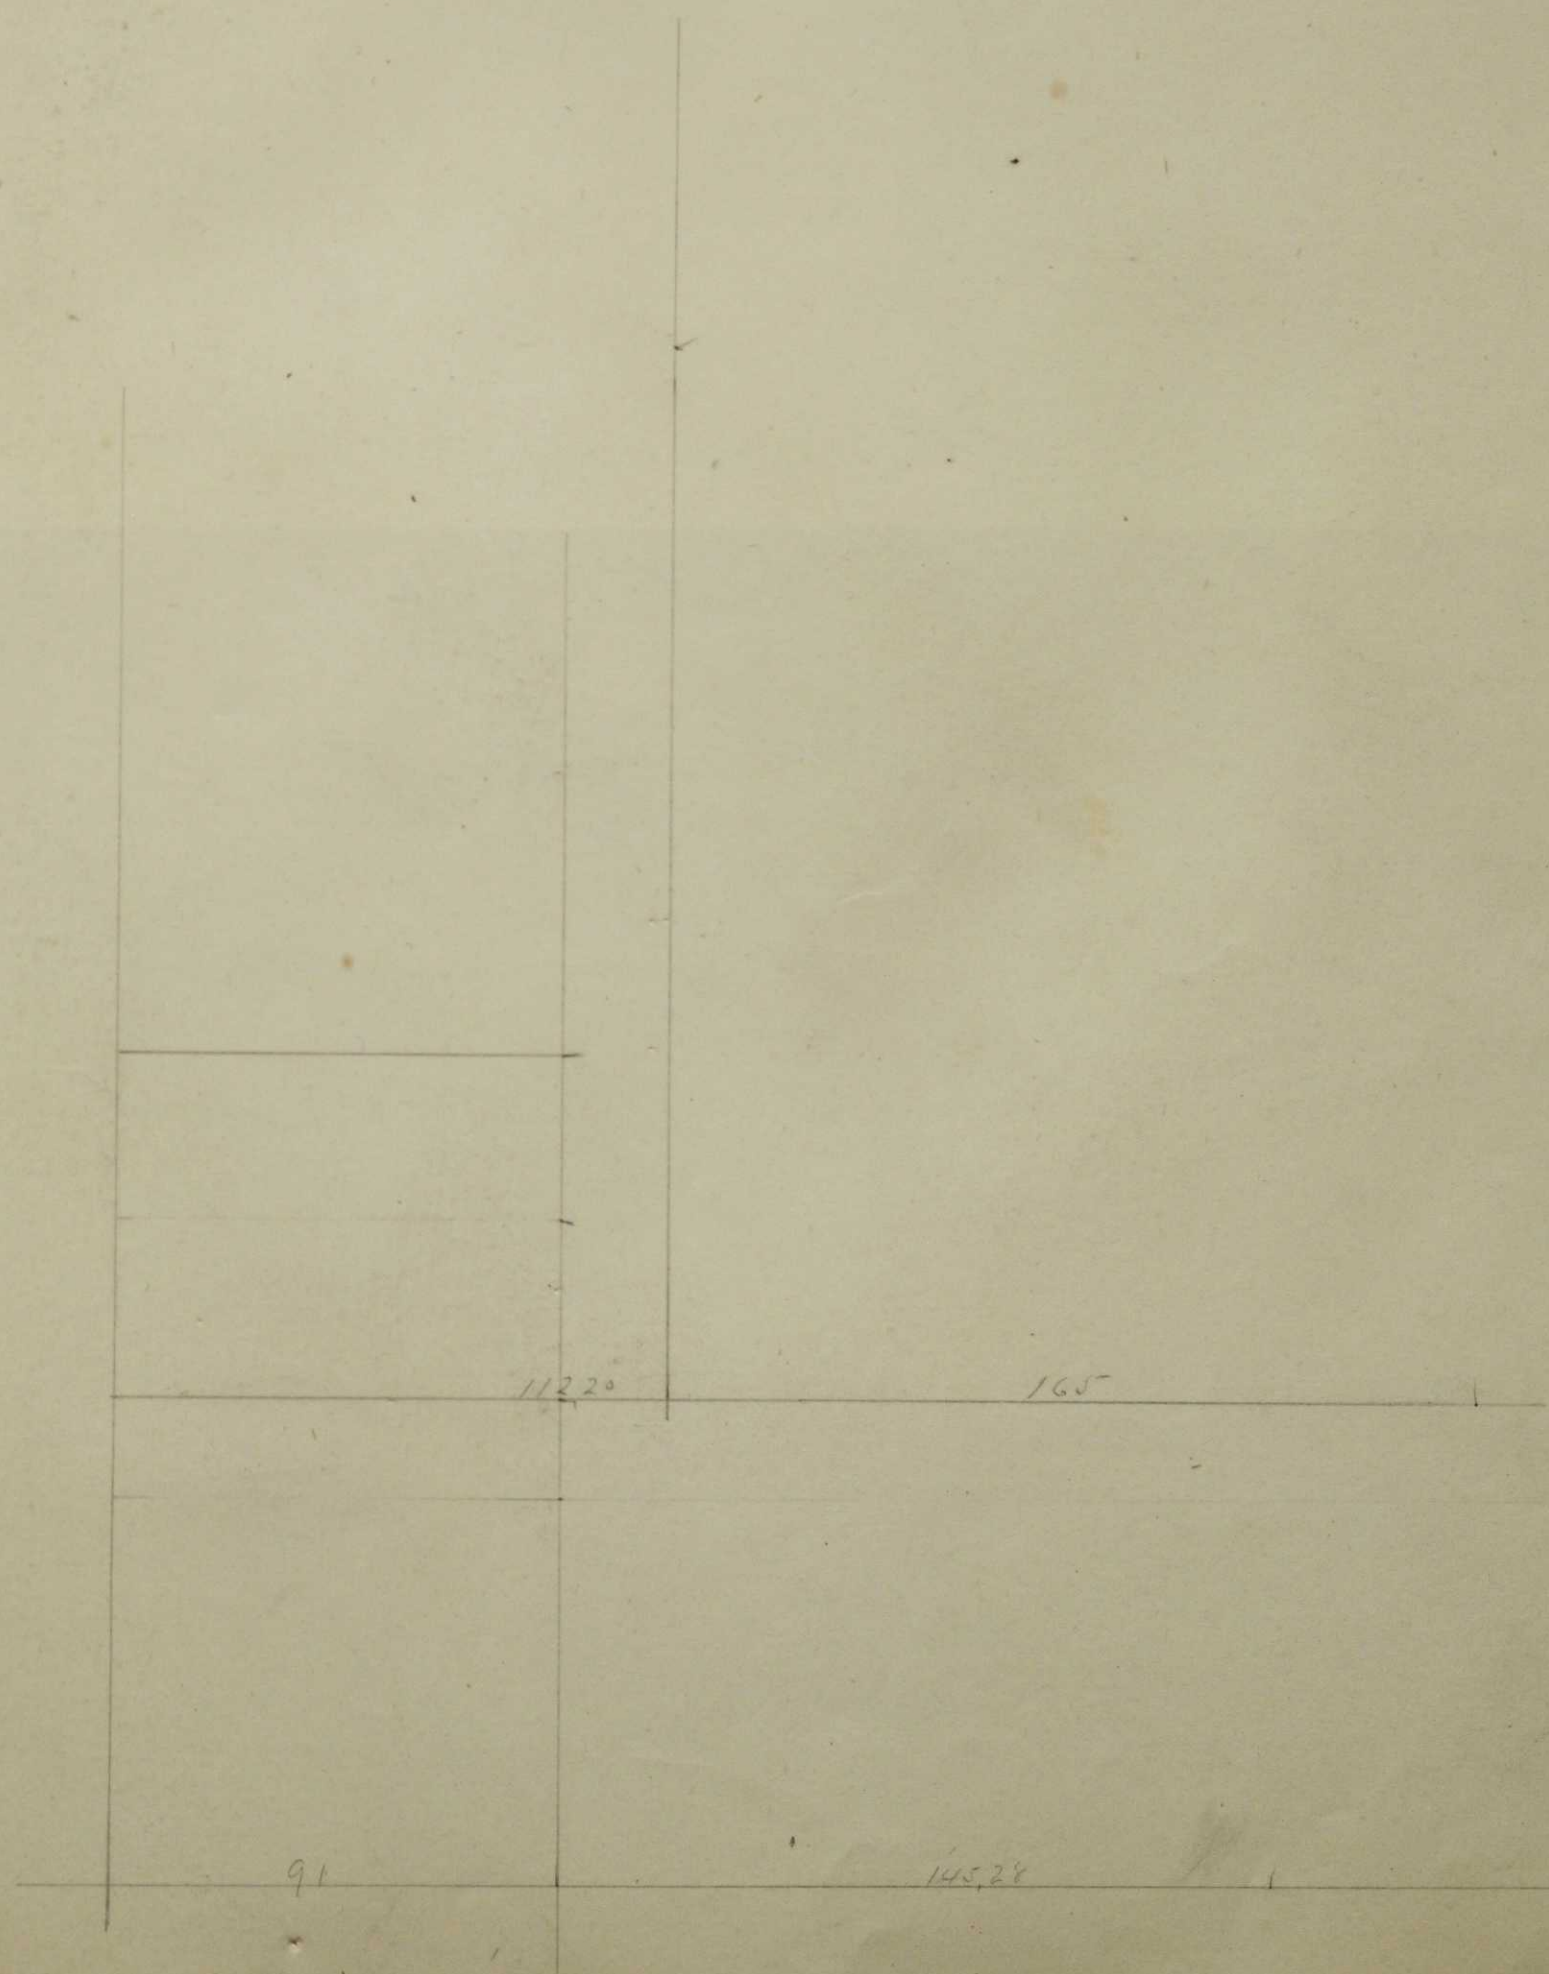

North

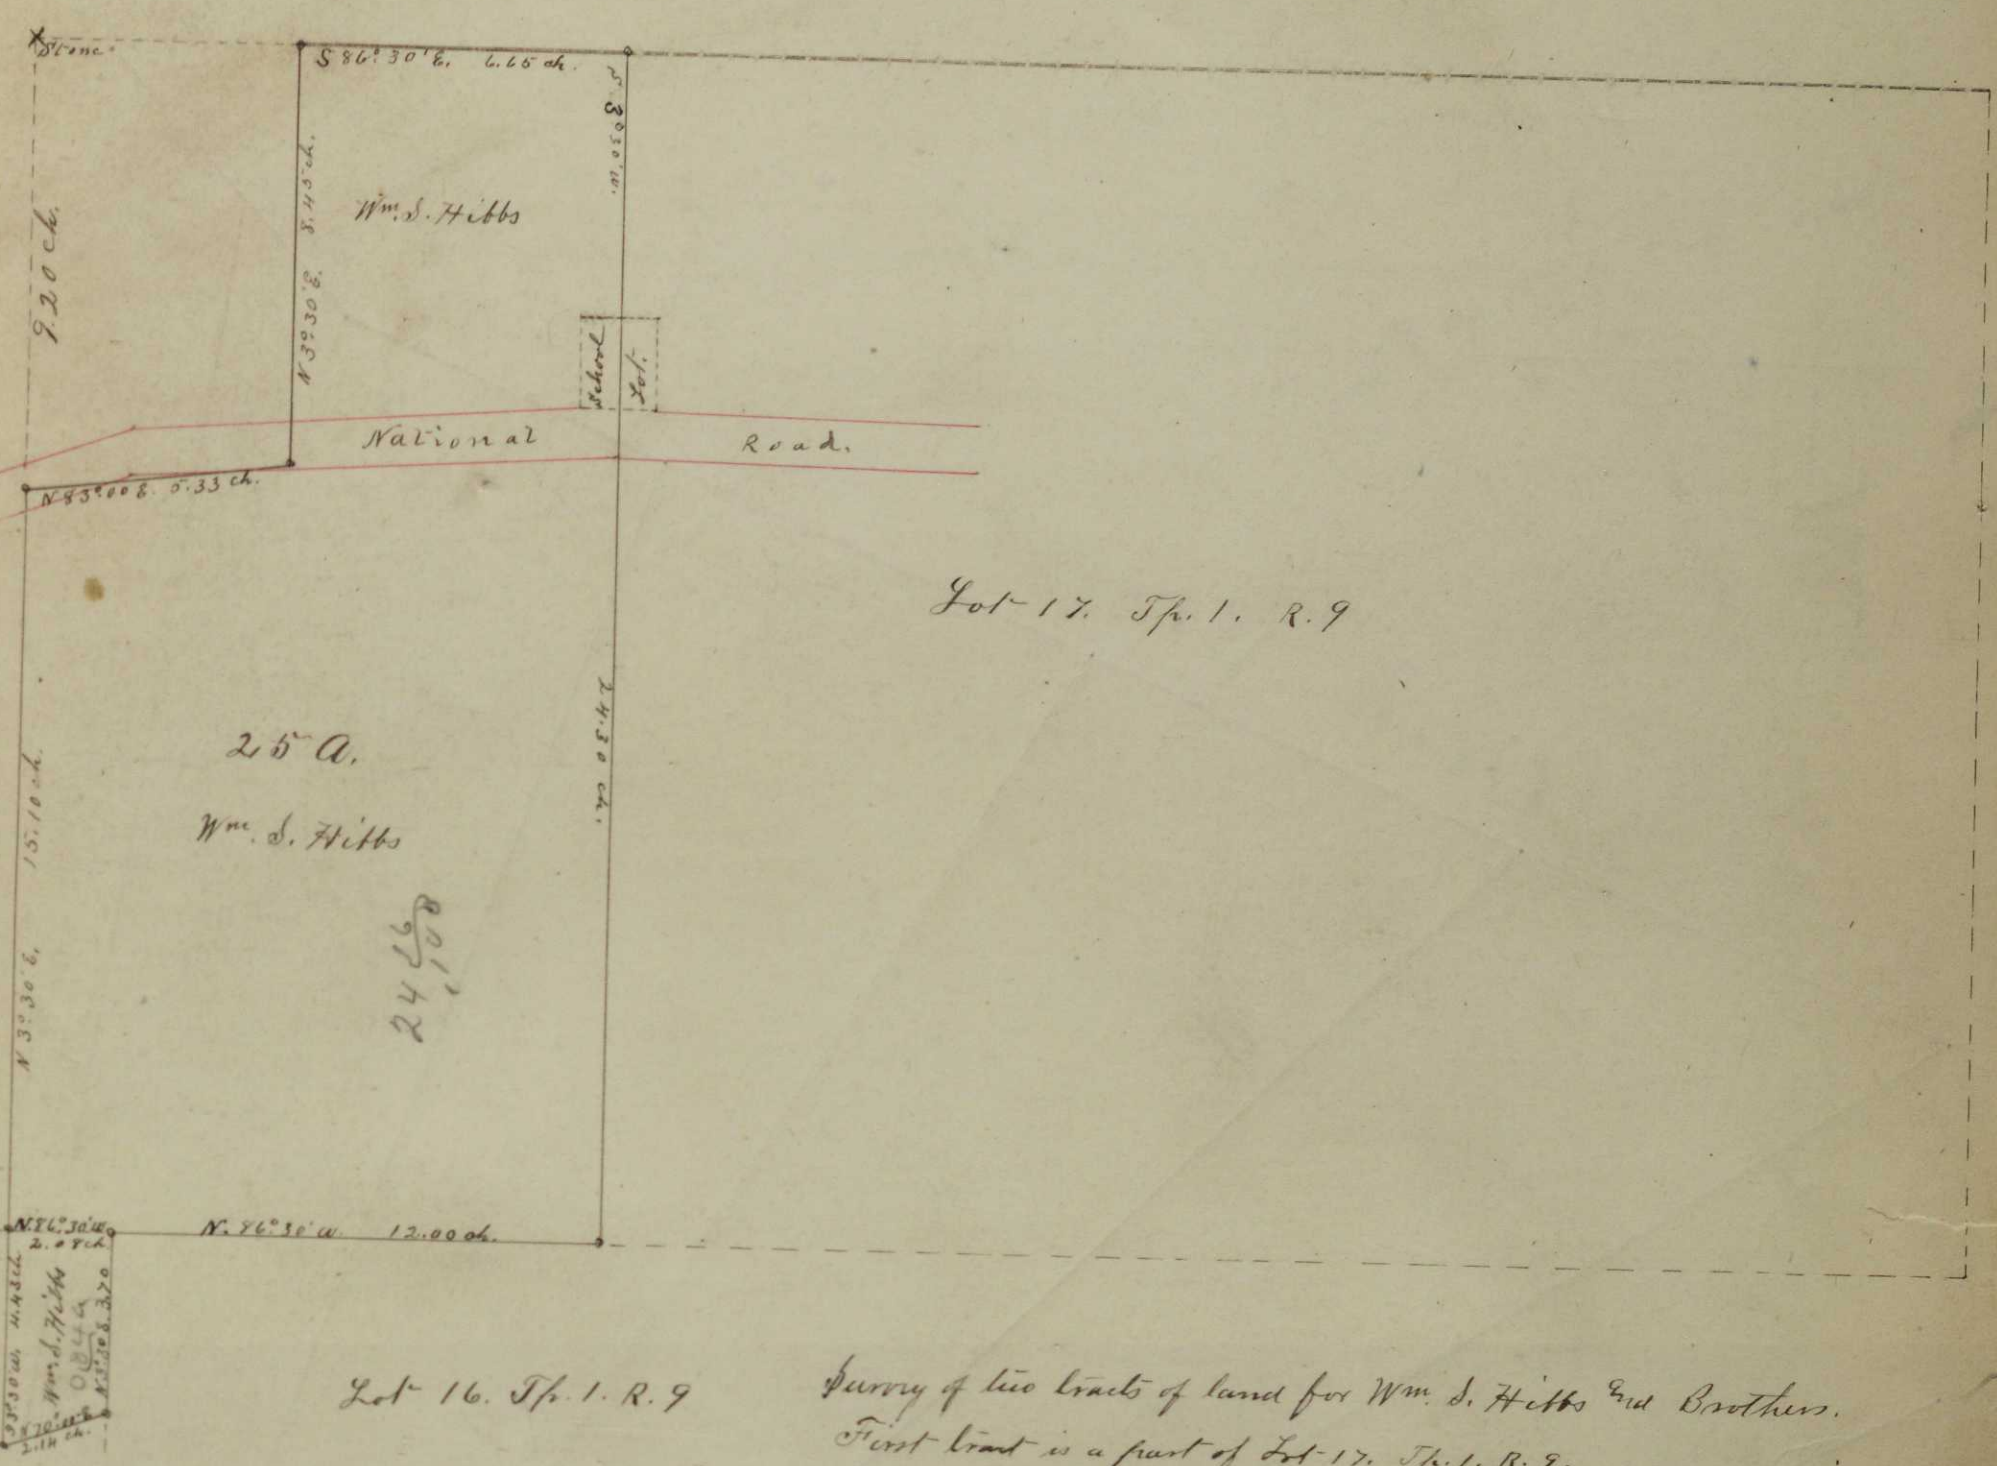

Lot 17. Tp. 1. R. 9

Lot 16. Tp. 1. R. 9

Survey of two tracts of land for Wm. S. Hibbs and Brothers.

First tract is a part of Lot 17. Tp. 1. R. 9.

Second " " " " " 31 " " " "

Surveyed Sep. 28th 1891.

By R. A. Cunningham, Deputy.

Lot 31. Tp. 1. R. 9

PLAT

of

Brown and Rutledges
Sub-division of Lots N^o 28, 29 and 30
Cliff-Wood Addition to
Zanesville Ohio

Scale 1 inch = 20 ft

Description See Page 128

Oak Street

N

W

Ave

Prospect

Stone

Stone

Stone

S 45 1/2° E 35.97'

S 21° NE 179.7'

N 71 3/4° E 140.35'

N 59 3/4° E 133.35'

N 44 1/2° E 134.75'

N 35° E 133.35'

N 33 1/2° E 124.75'


N 19° 40' E 124.75'

N 2 1/2° E 145'

N 2 1/2° E 145'

Note
See next page
for platting

I certify that the following Plat is correct showing the subdivision of
Lots 28, 29 & 30 Cliff-Wood Addition to Zanesville Ohio. The lines in Red denote
the original lot lines. Those in black the subdivision.
Surrendered Sept 15th 1890-
J.C. Connor
County Surveyor

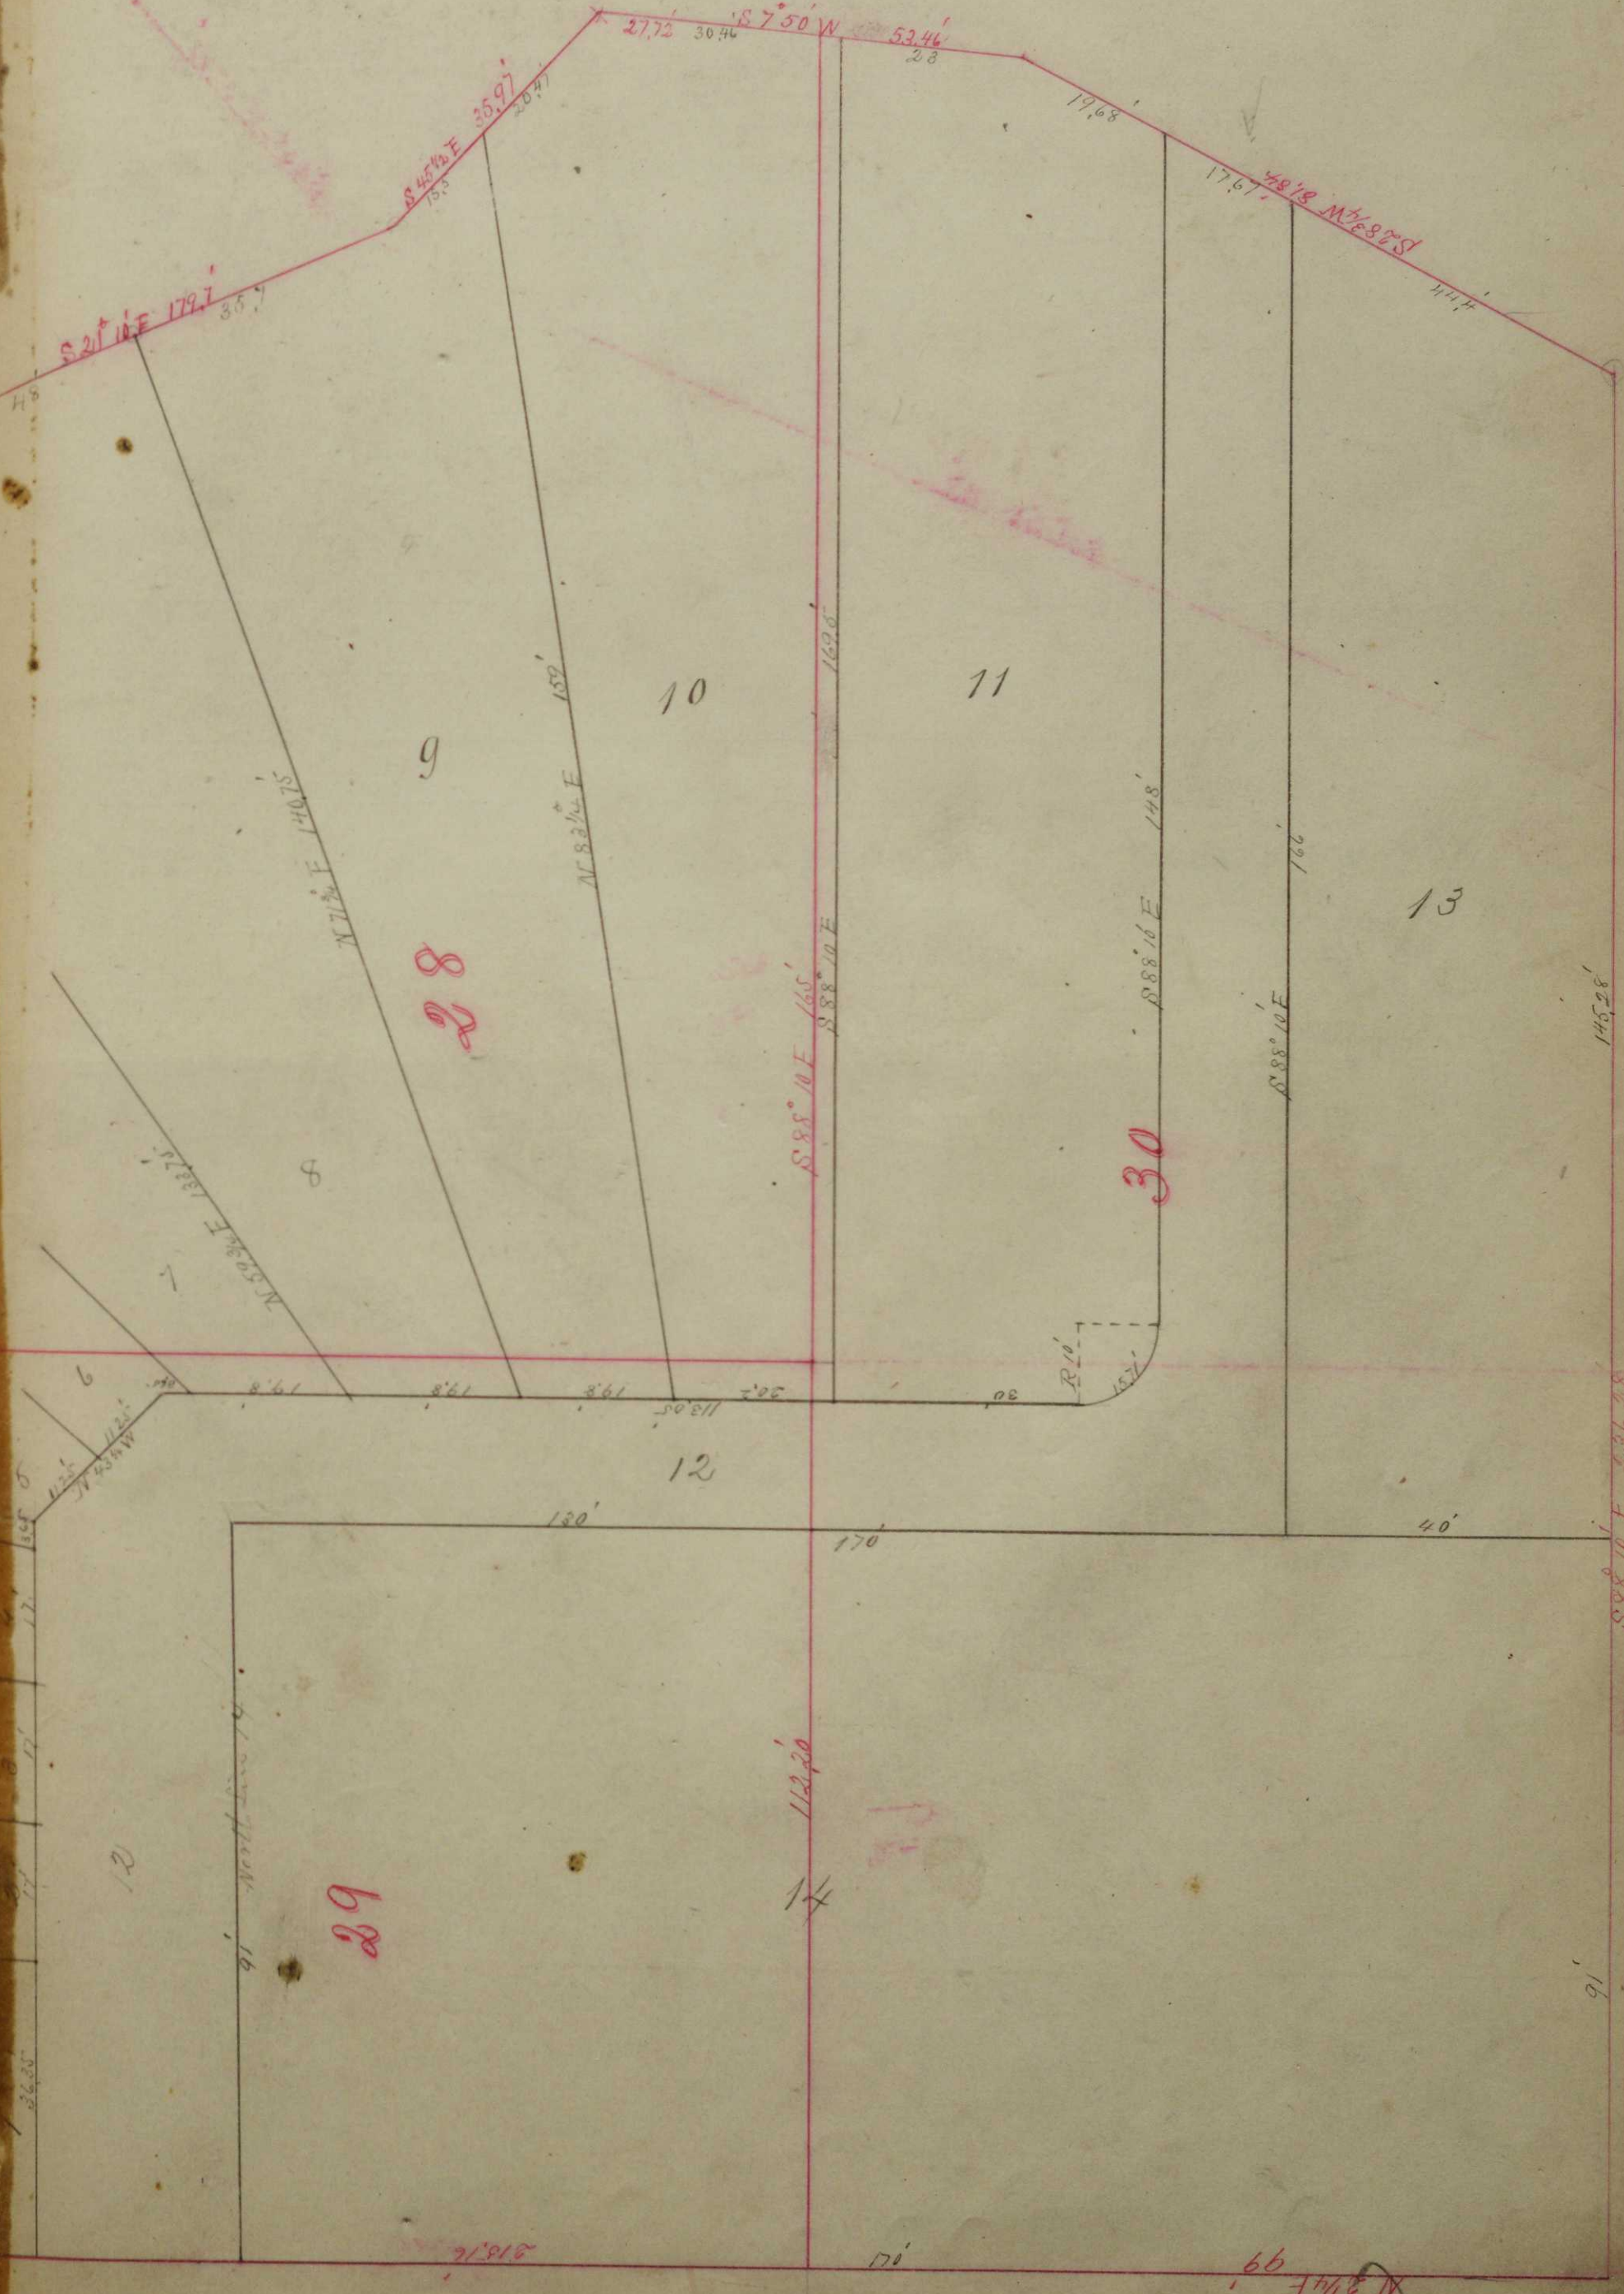



Description of Plat on Pages 126 & 127


We George Brown and William H. Rutledge proprietors do hereby certify that this plat correctly represents a Subdivision of Lots number 28, 29 & 30 in Cliff Wood Addition to the City of Zanesville Muskingum County Ohio and that said Subdivision is to be known as "Brown and Rutledge's Subdivision of Lots number 28, 29 and 30 of Cliff Wood Addition to the City of Zanesville Ohio"

Witness our hands this 9th day of October A.D. 1890
signed and acknowledged
in our presence
George Brown
William H. Rutledge
W. E. Helmick
J. C. Connors

State of Ohio Muskingum County S.S.
Be it remembered that on the 9th day of October A.D. 1890 before me the undersigned a Notary Public within and for said County and State personally came George Brown and William H. Rutledge and acknowledged the signing of the foregoing plat to be their voluntary act and deed
Given under my hand and Notarial Seal on the day aforesaid
Willie E. Helmick
Notary Public as aforesaid

Recorded October 24th 1891
J. C. Connors
County Surveyor

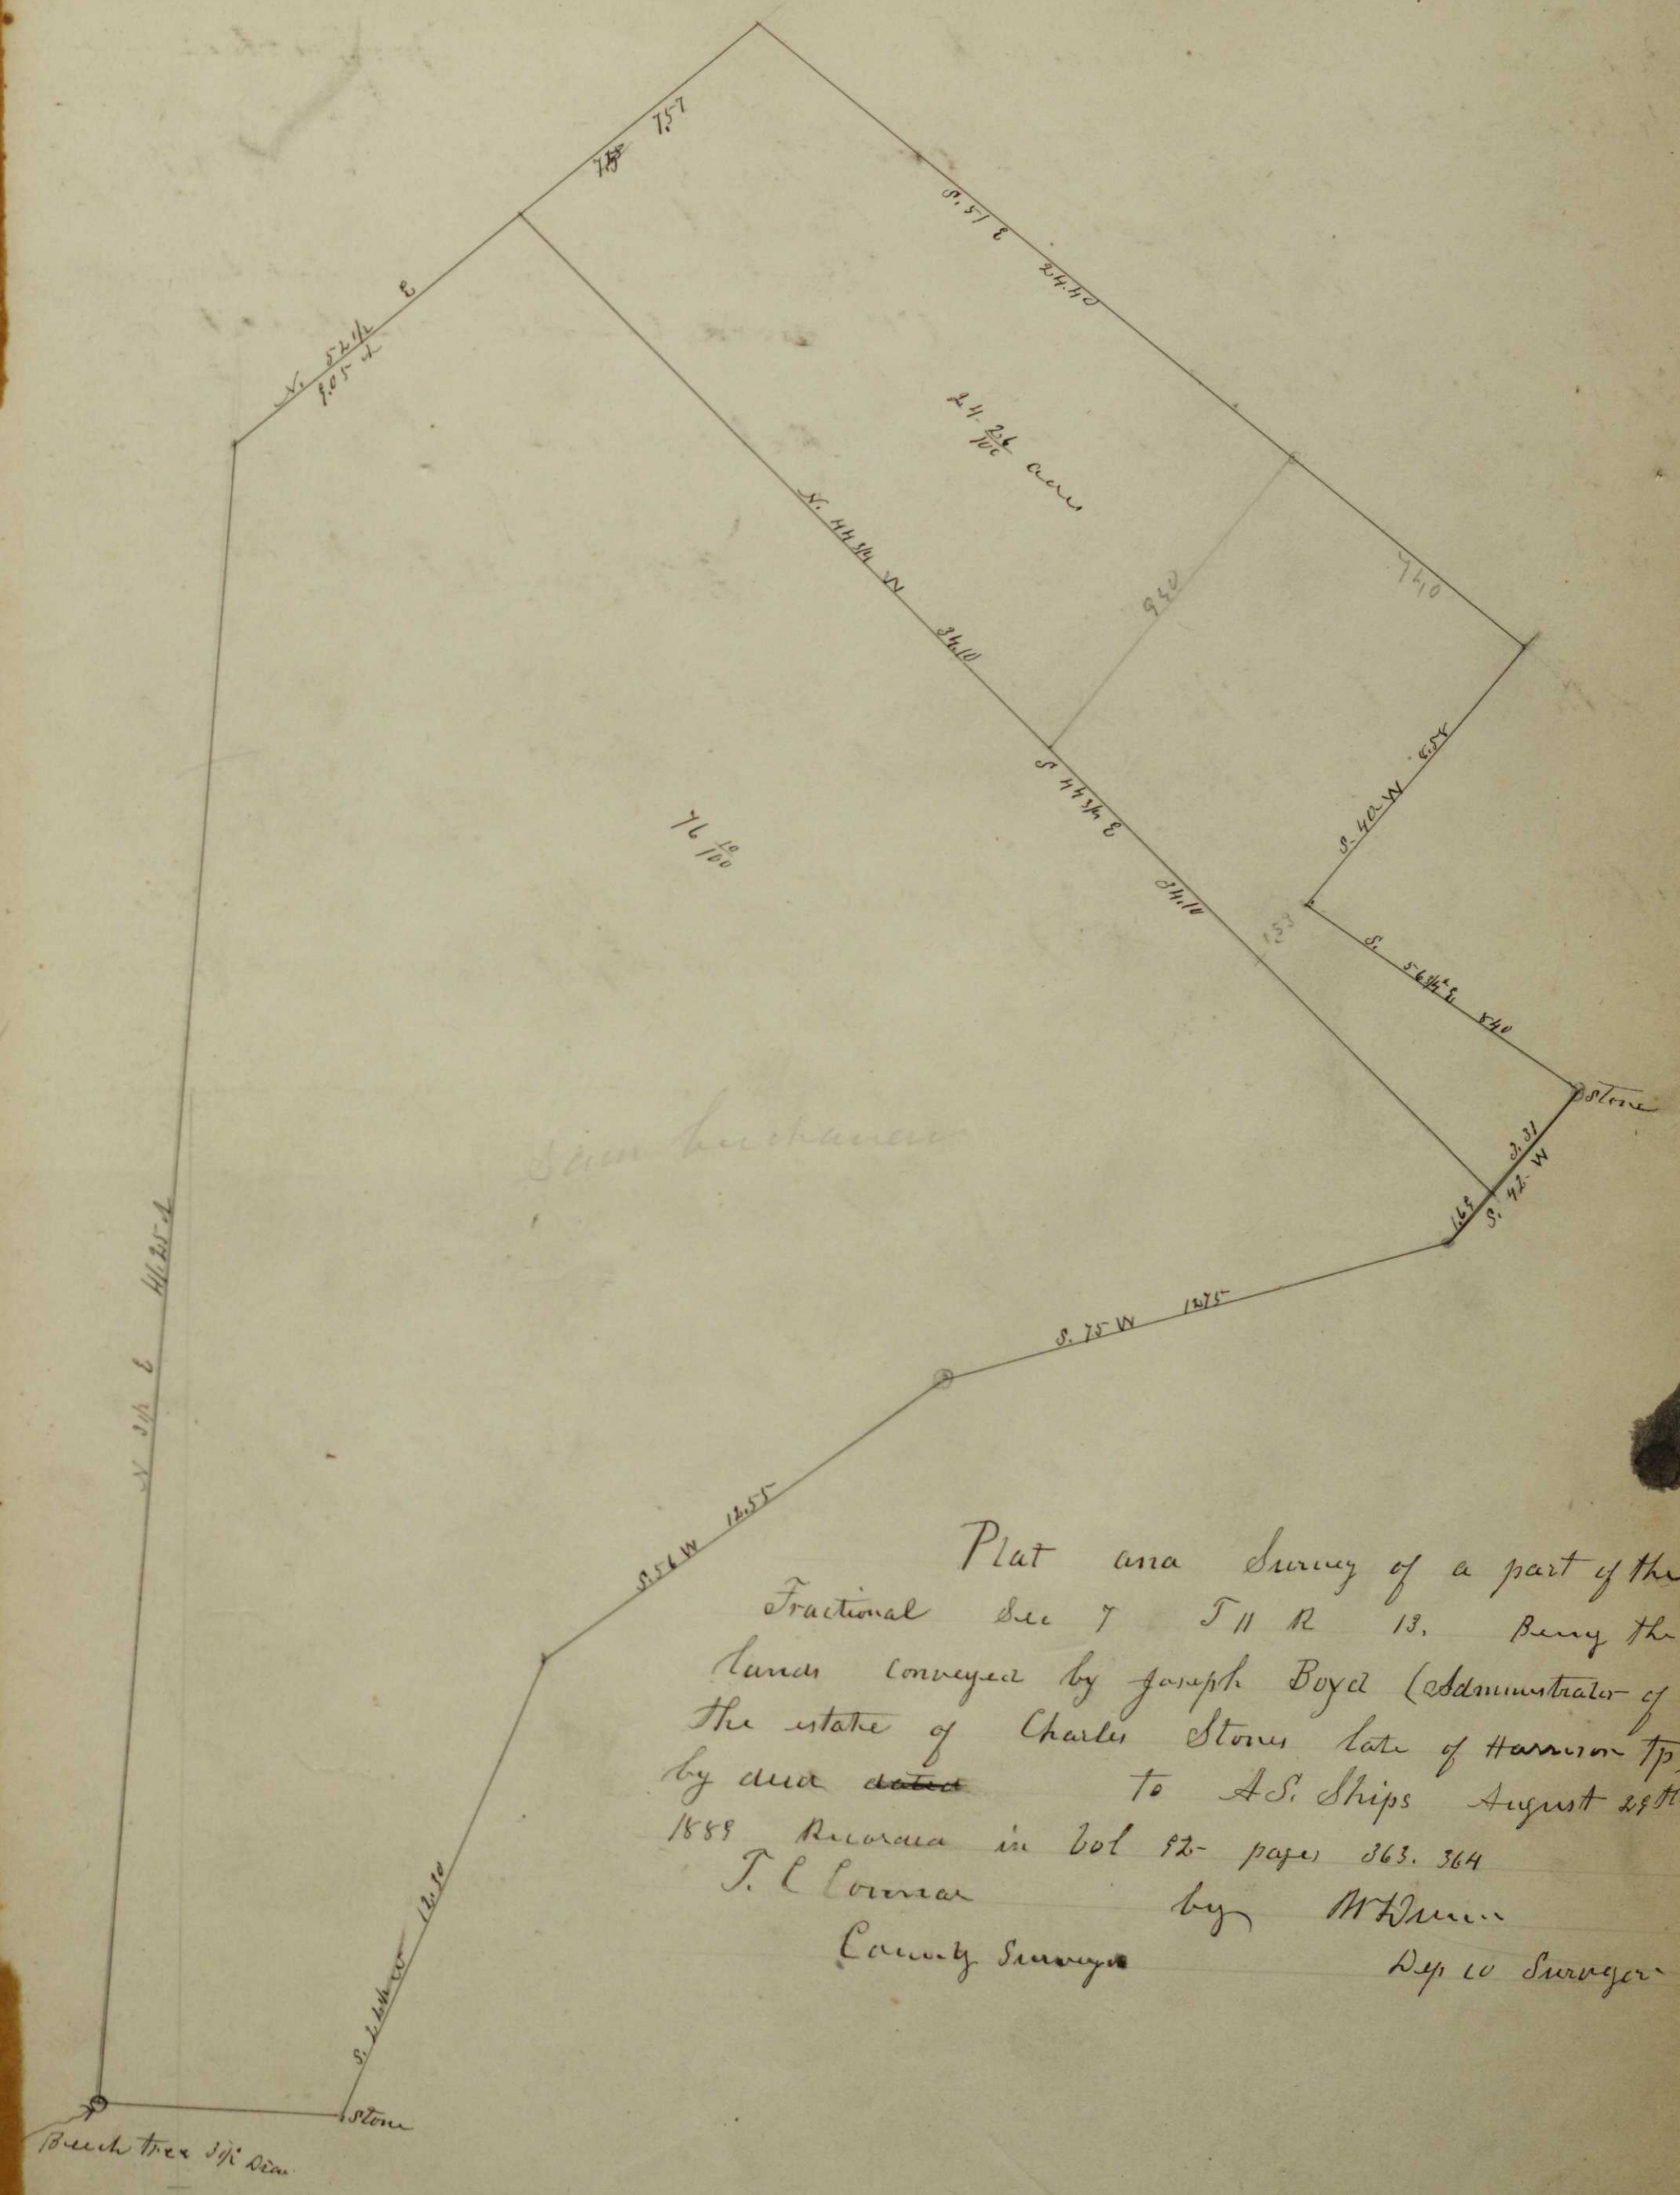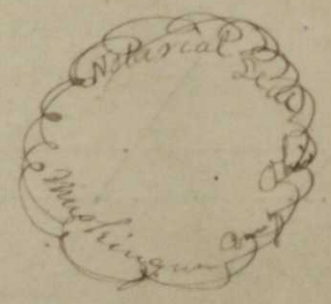

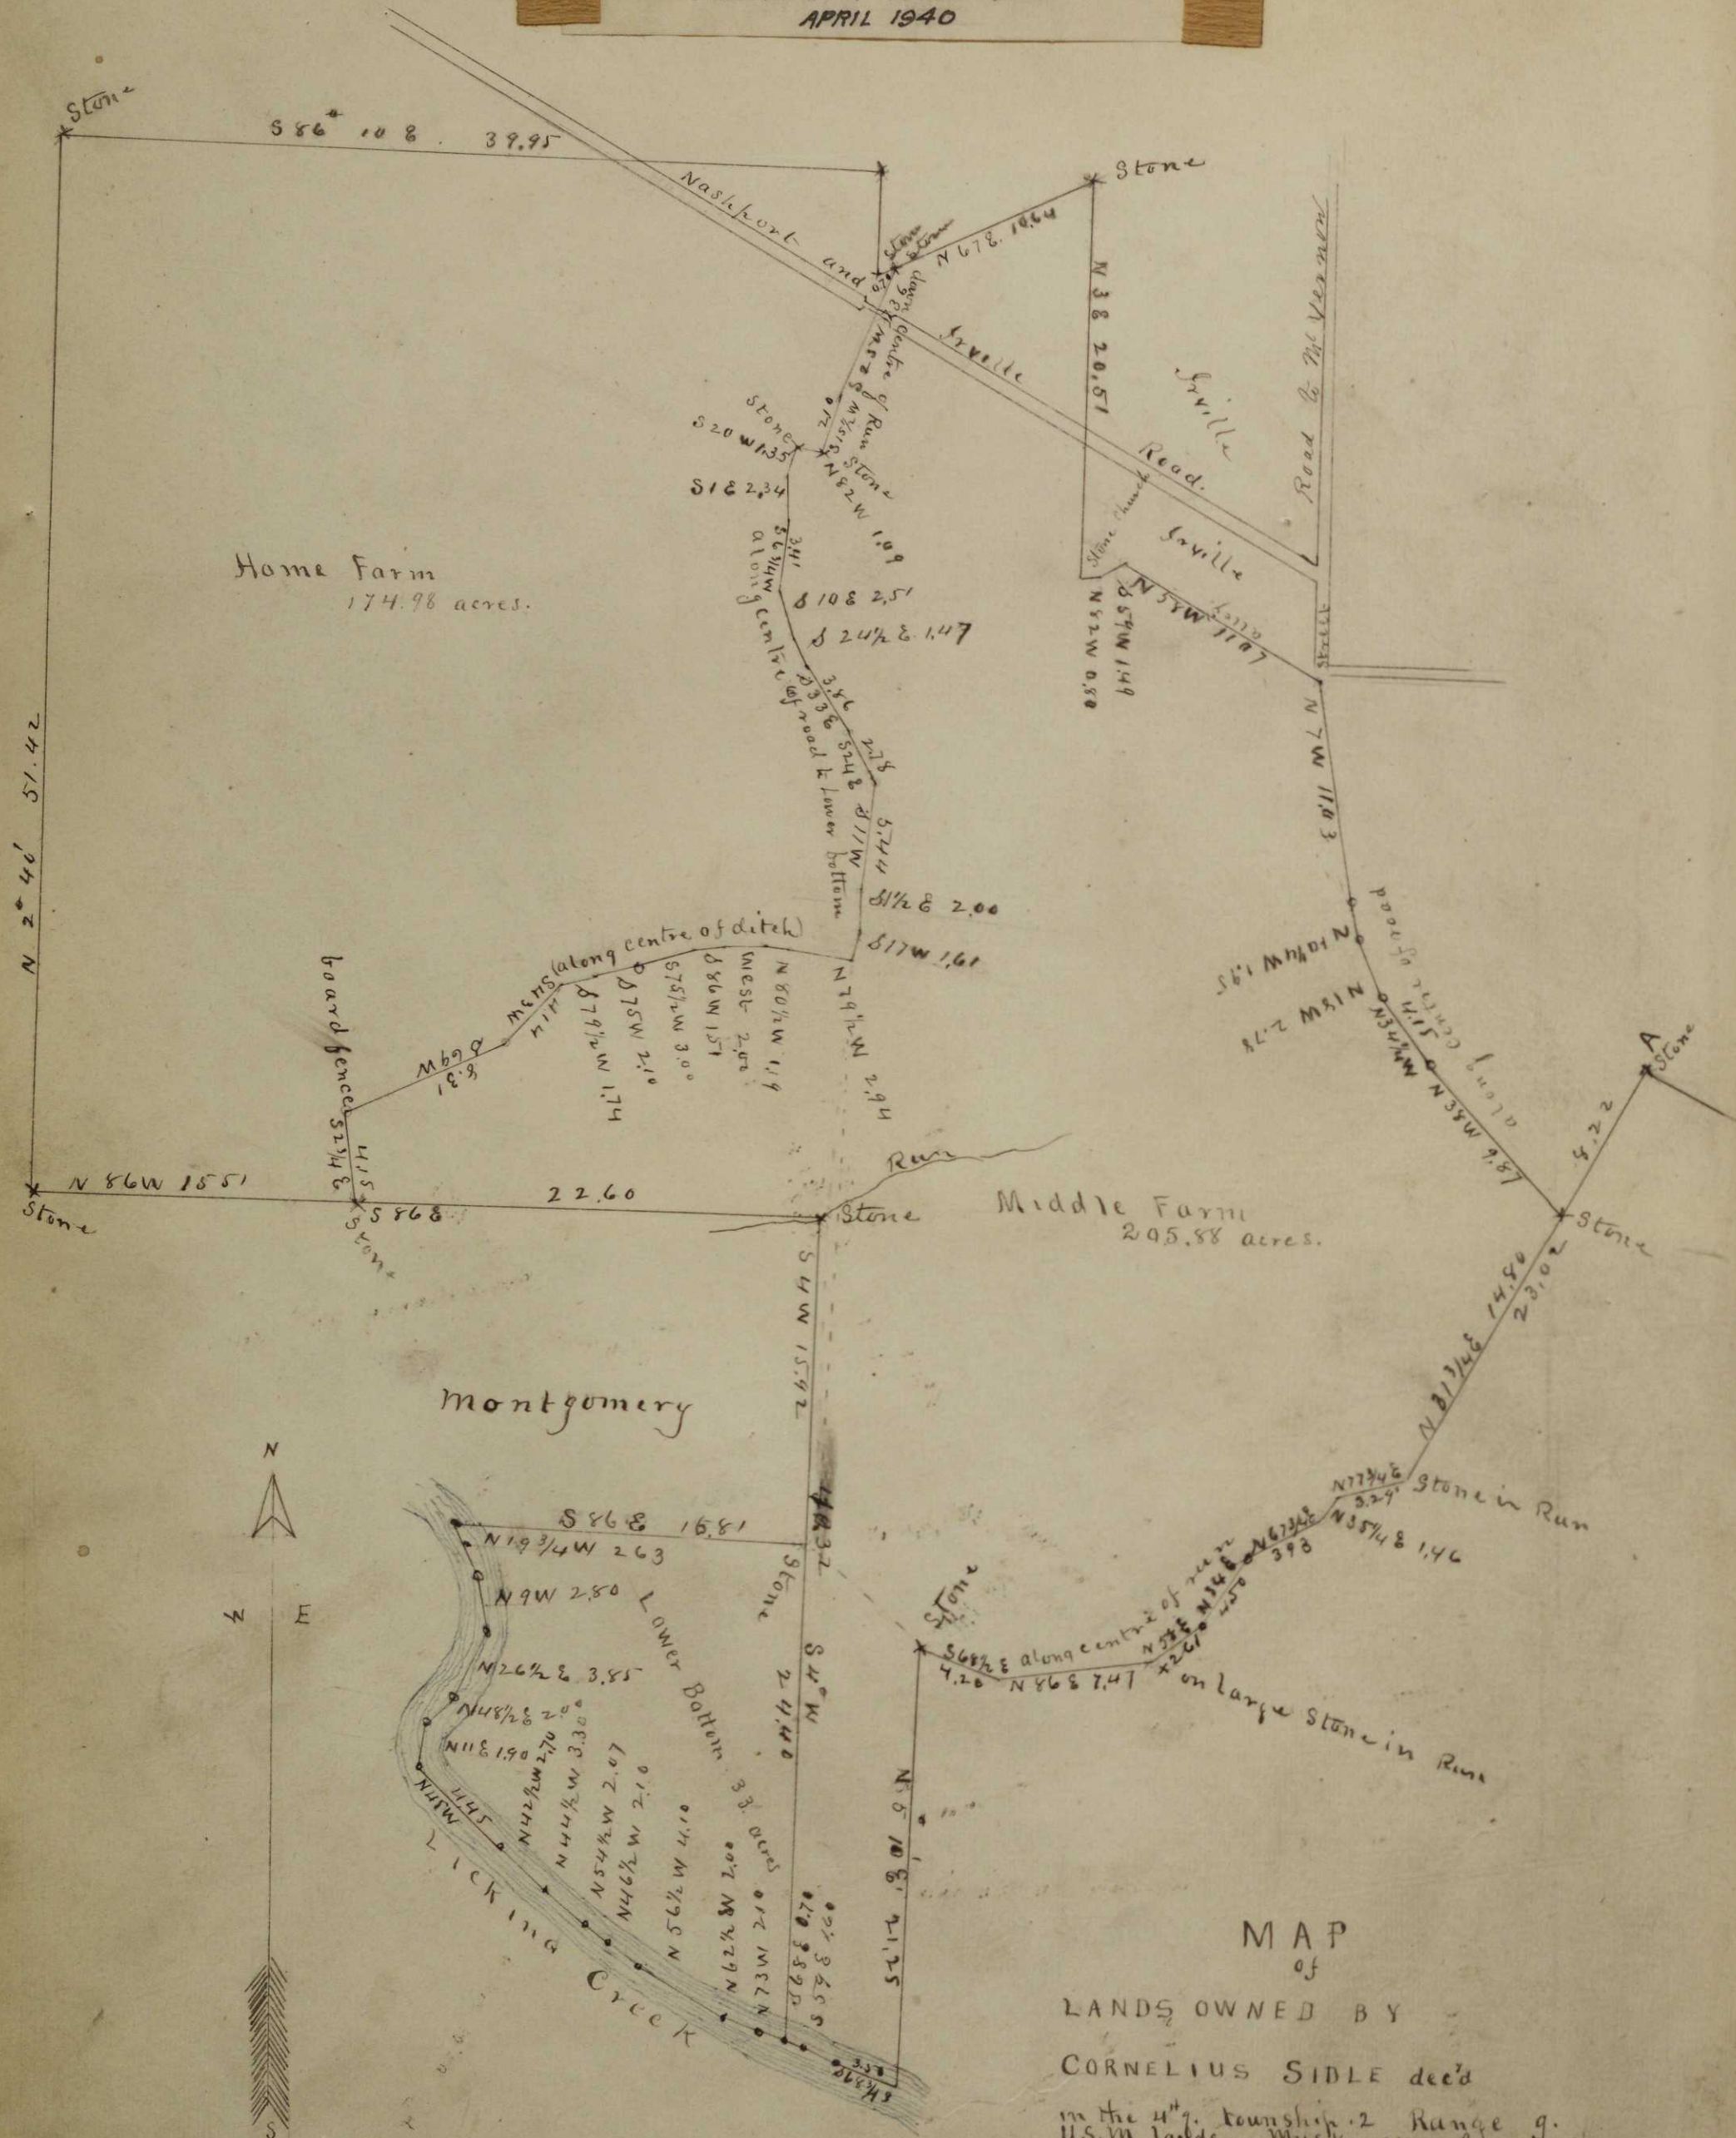

MAP
of
LANDS OWNED BY
CORNELIUS SIDLE dec'd


in the 4th. Township 2 Range 9.
U.S.M. lands Muskingum County, Ohio
as divided under the Will by Survey
November, 9th 1891.
Courses as recorded are the present
Magnetic Courses. Scale 8 chs = 1 inch


Scale 8 cks = 1 inch

Approved
J. C. Comman
County Surveyor.

A J Spaulding
Deft. County Surveyor.

 See Next page

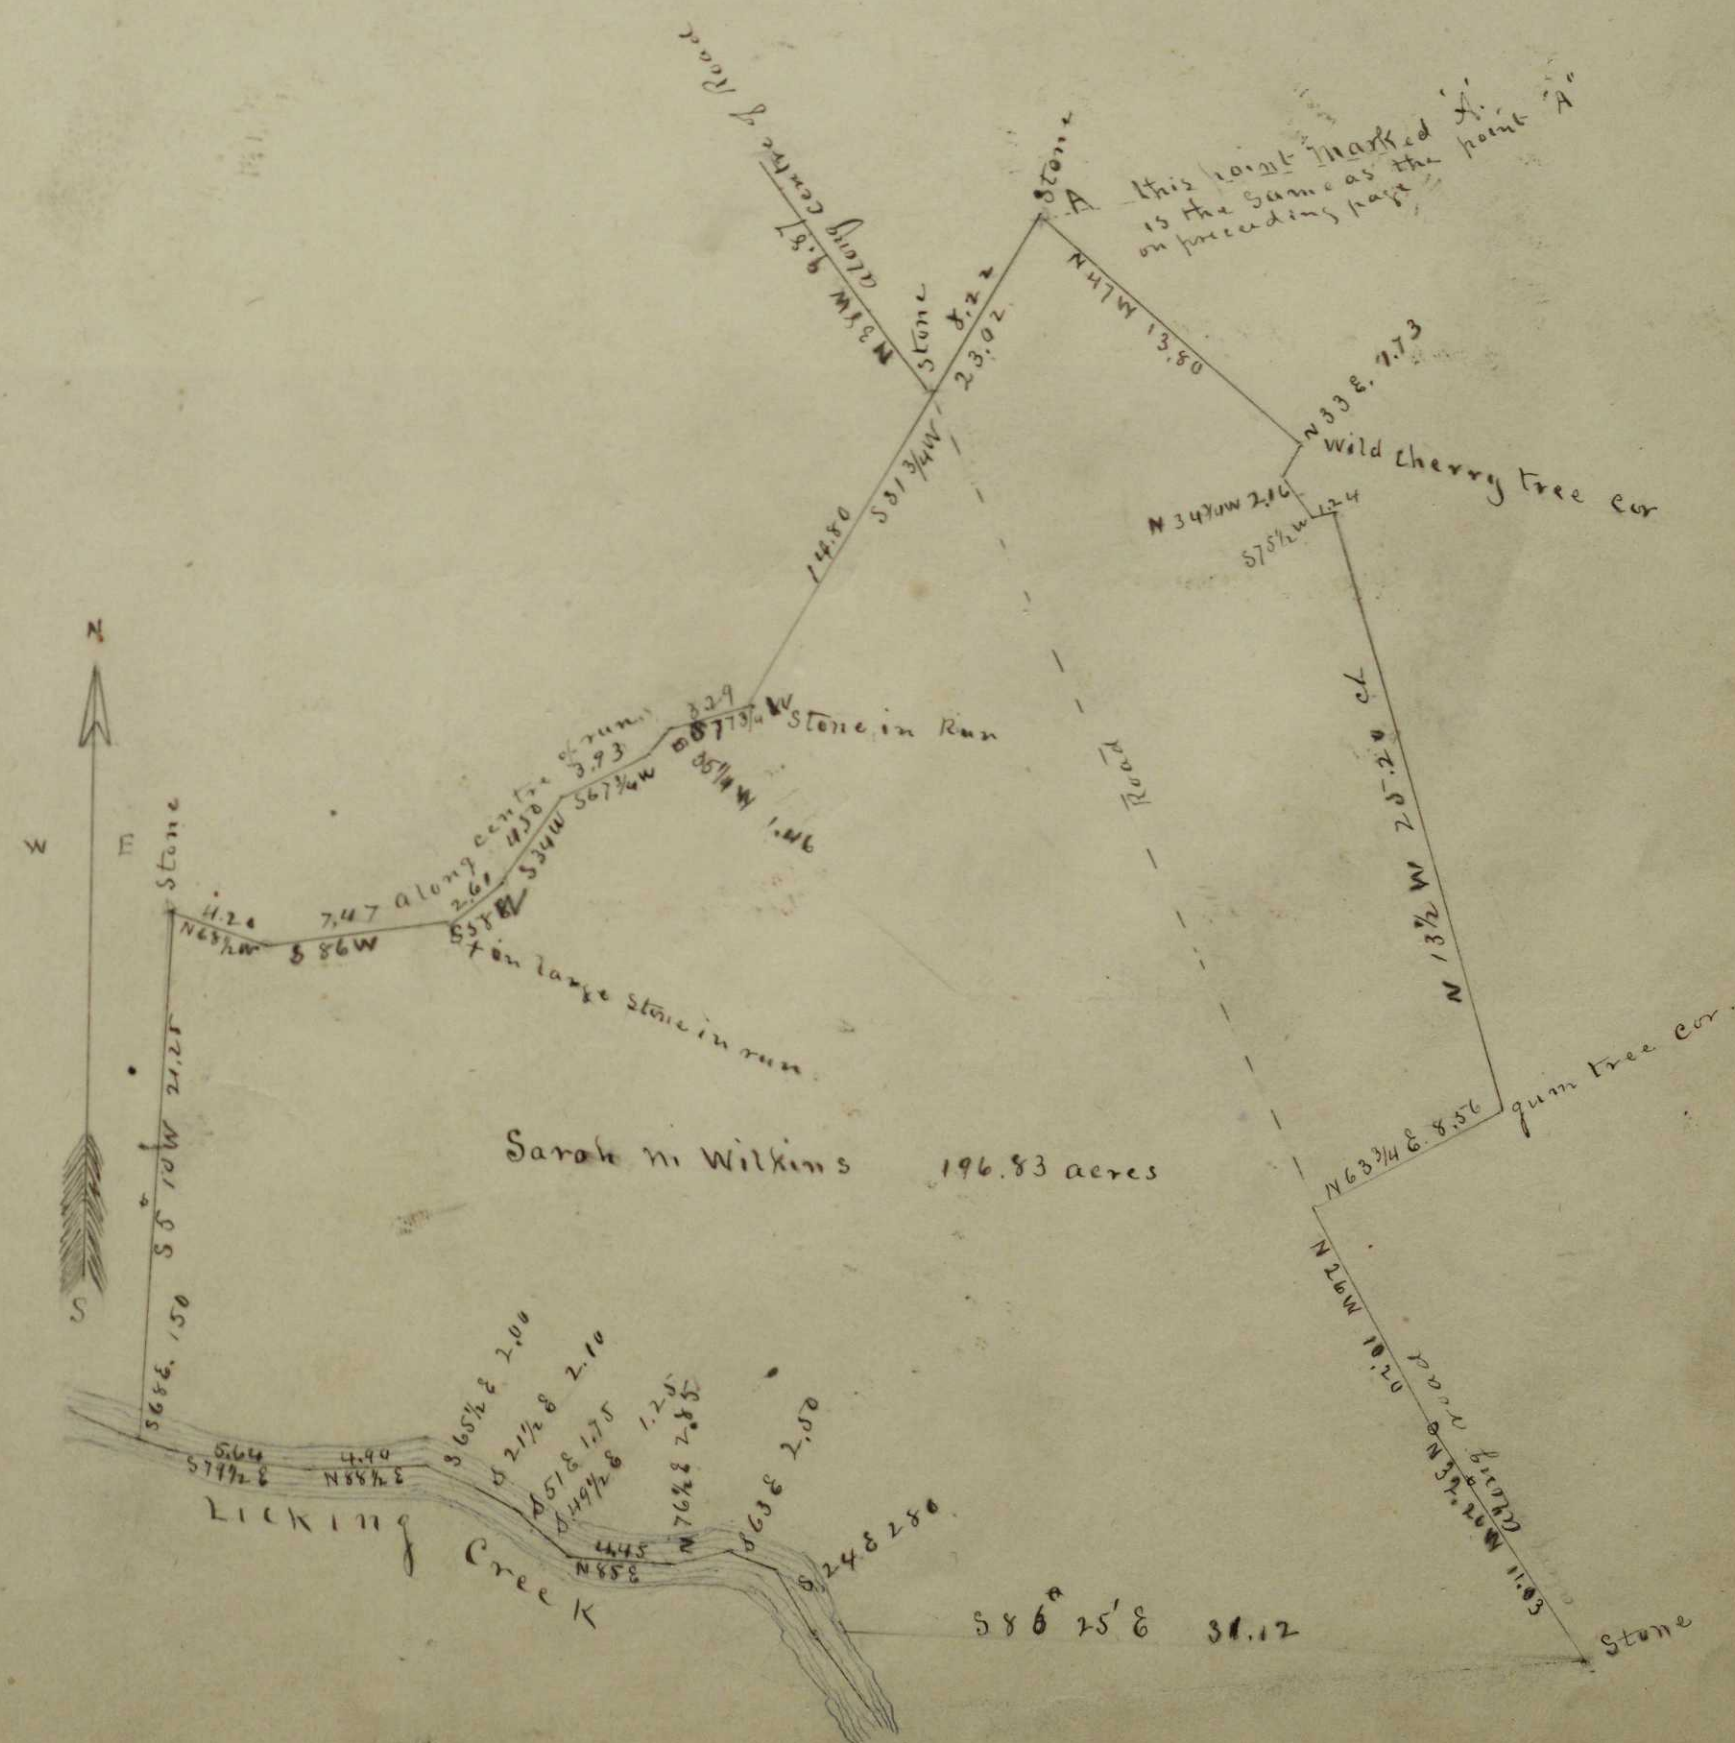

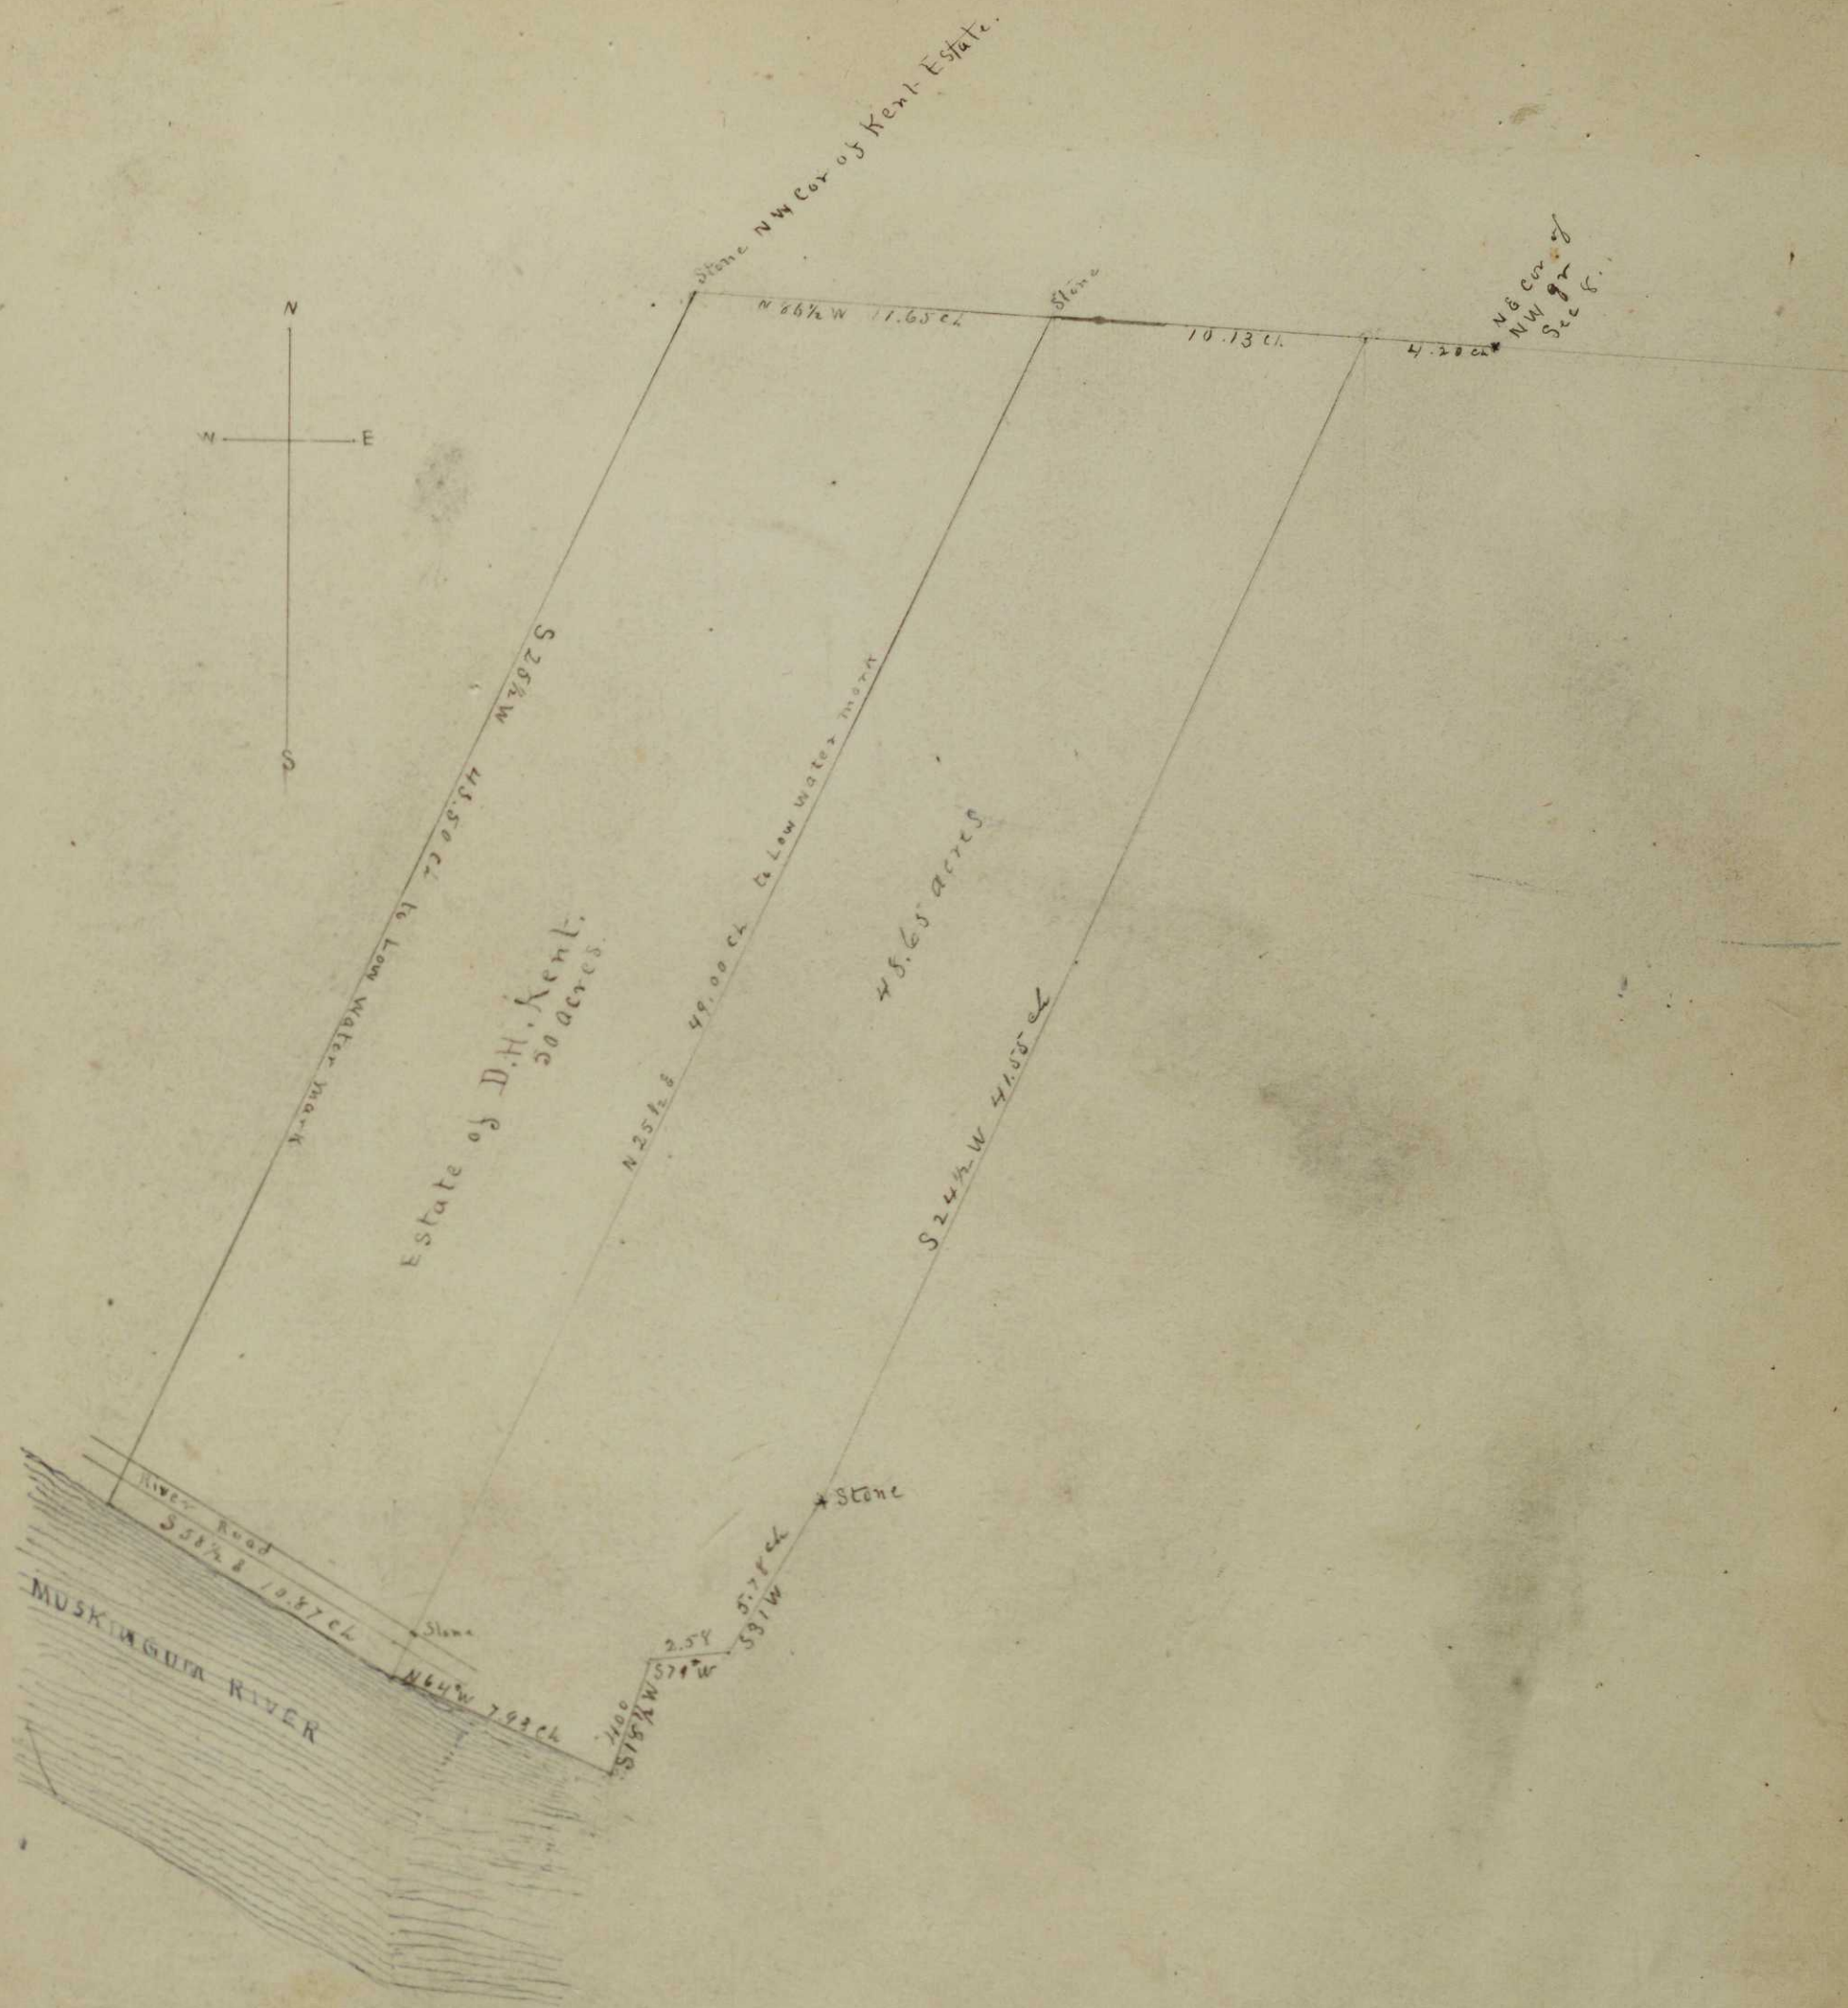

Survey of 50 acres off of the West Side of the Estate of D.H. Kent Deed
 Being a part of fractional Sec. 8. Township 12. Range 13. (Wayne Township)
 Muskingum County Ohio. Made at the instance of R H Gallagher
 Administrator of said Estate July 27th 1892.

Scale 6 ch = 1 inch.


Present Magnetic Courses.


Approved
W L M N

County Surveyor

A J Spaulding

Deft County Surveyor

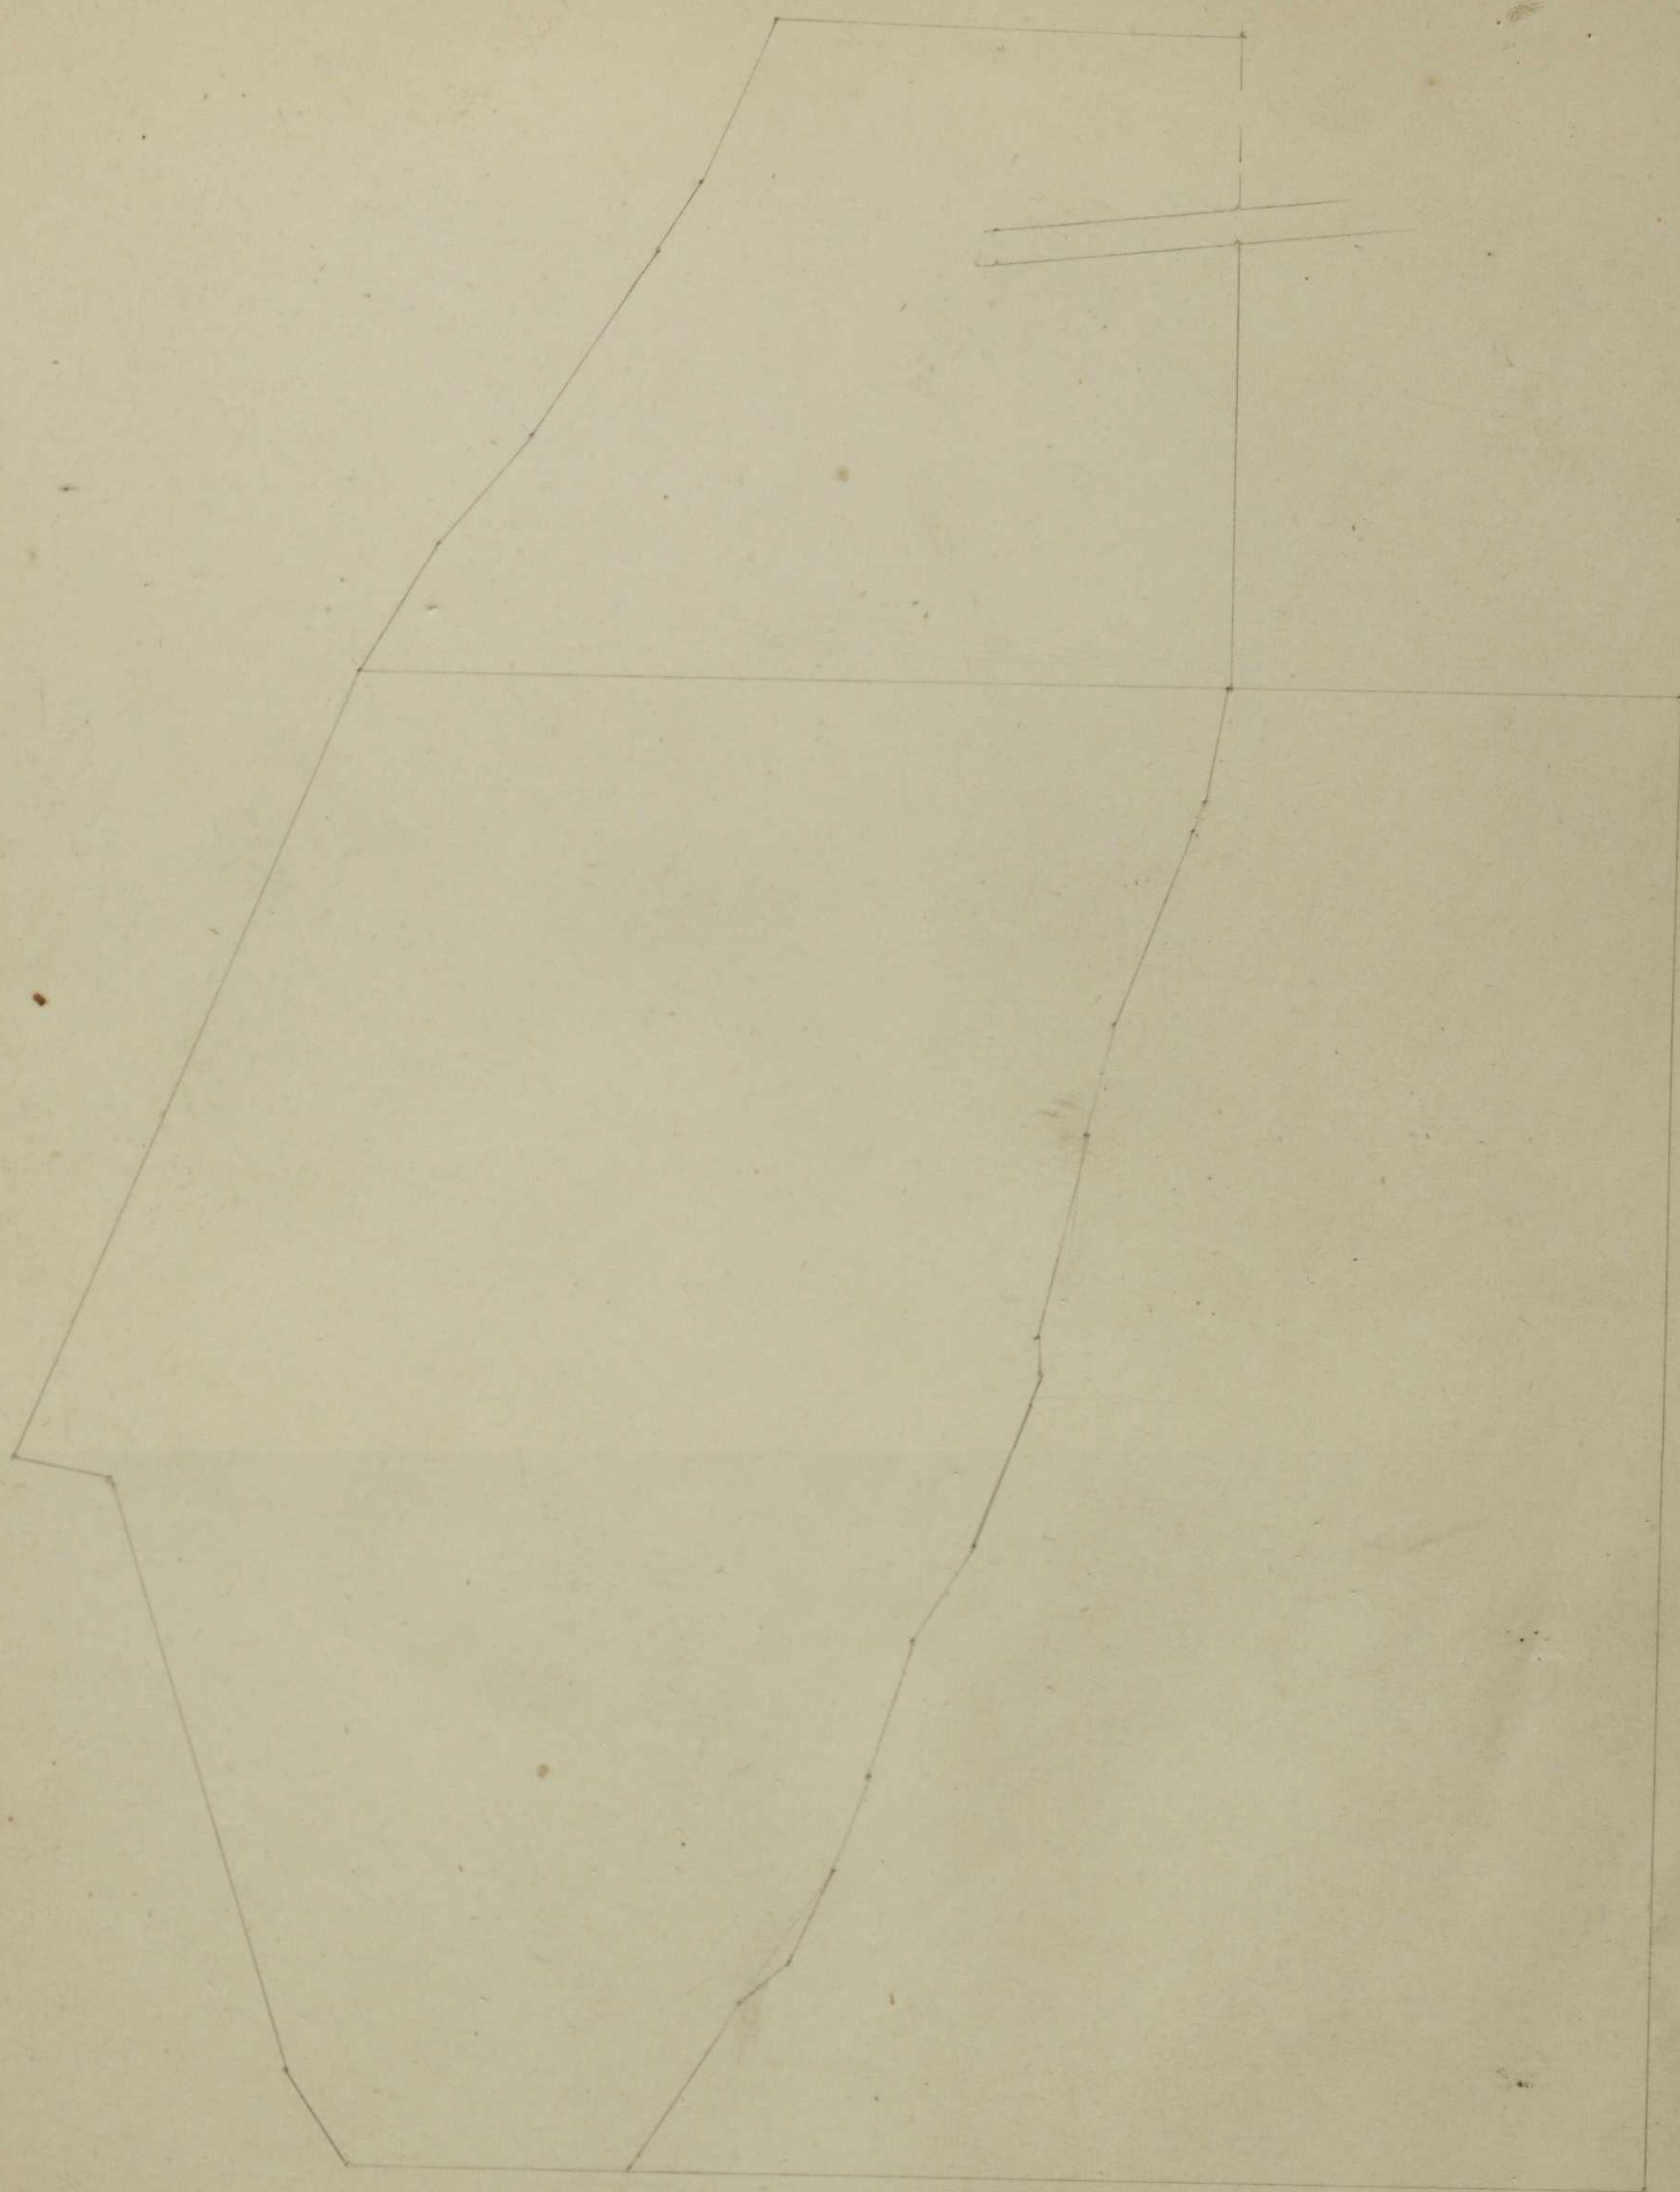

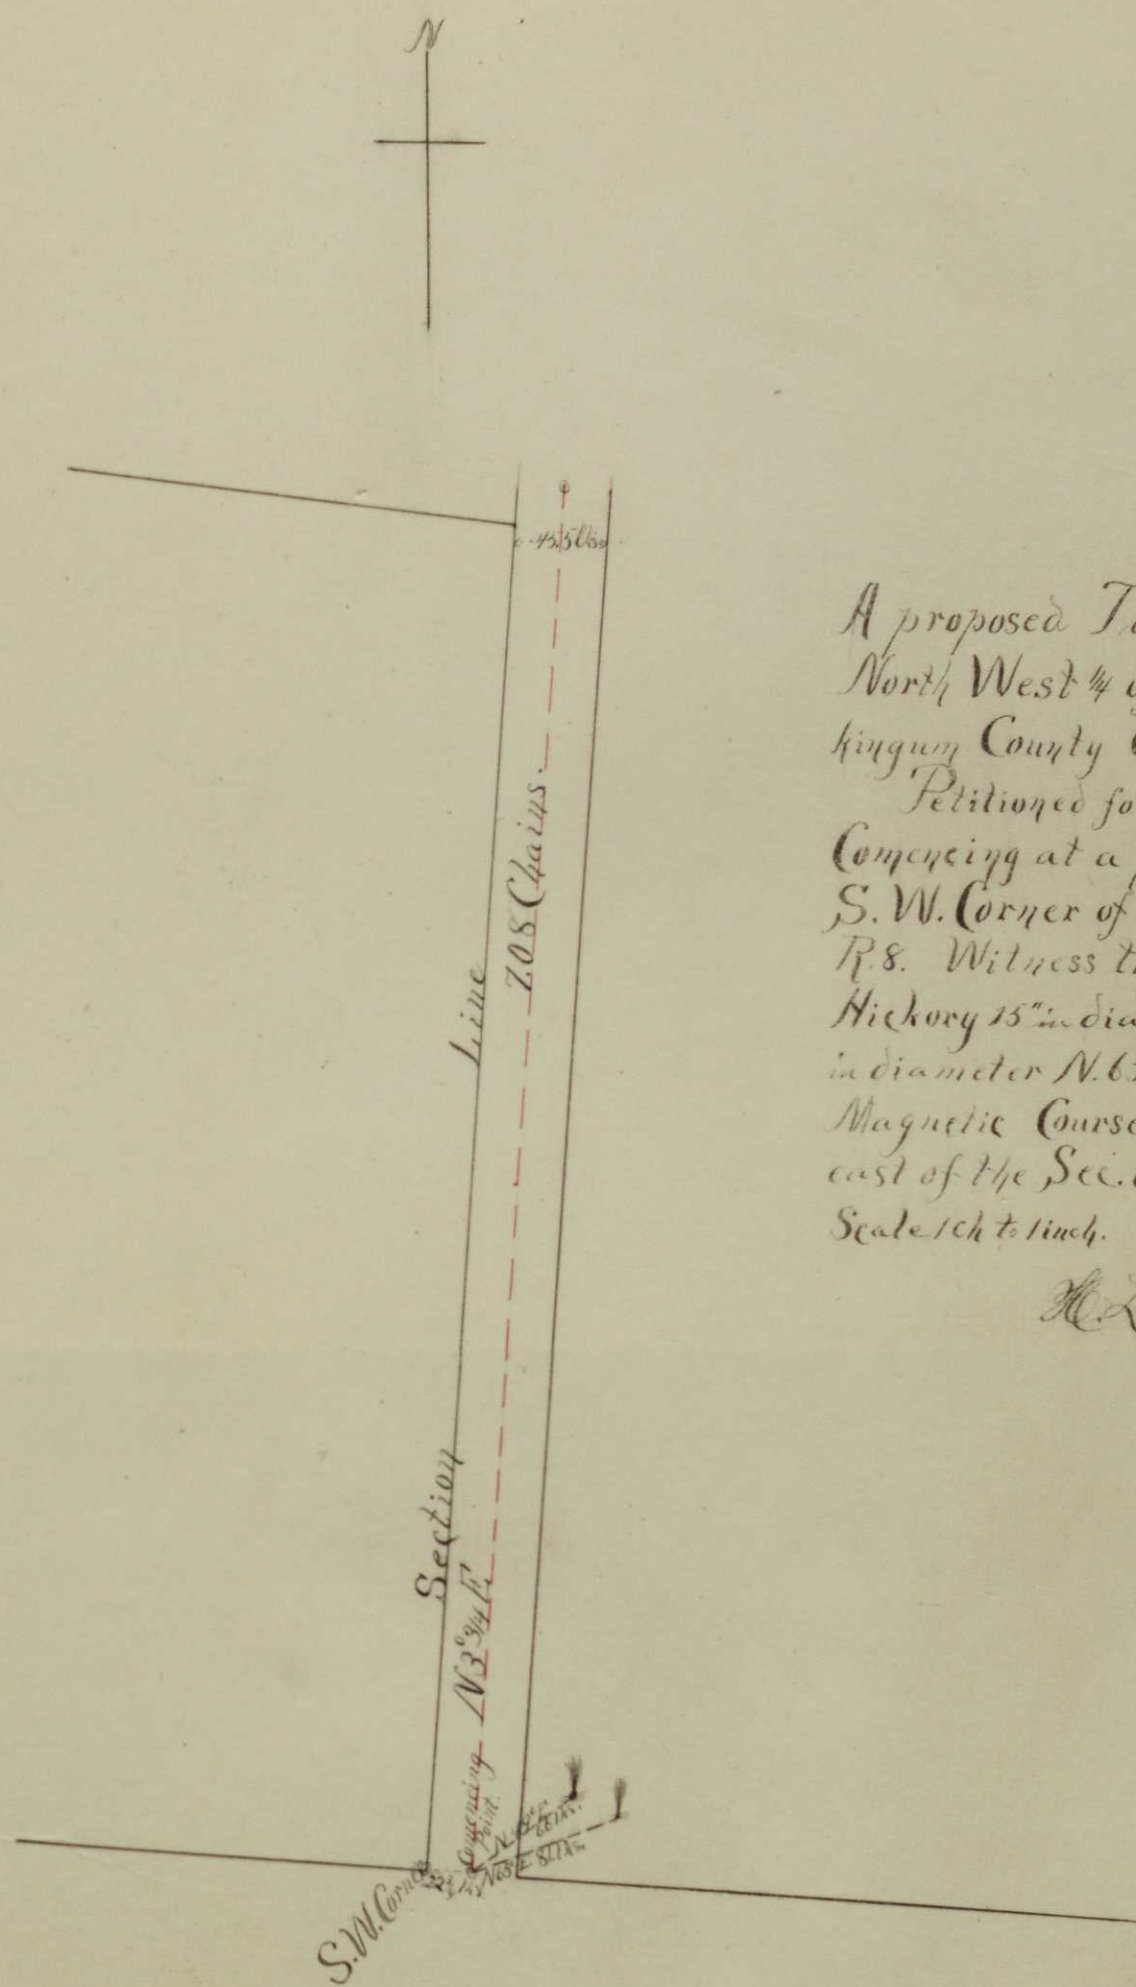

Plat of

A proposed Township Road Located in the North West $\frac{1}{4}$ of Sec. 4. Township 2. Range 8. Muskingum County Ohio.


Petitioned for by J. M. Lane, and others.

Commencing at a point 22 $\frac{1}{2}$ links East of the S. W. Corner of the N. W. Quarter of Sec. 4. T. 2 R. 8. Witness trees to said Commencing point Hickory 15" in diameter N 49° E 66 links Beech 12" in diameter N. 65 E. 81 links. Thence N 3 $\frac{3}{4}$ E Magnetic Course. 708 Chains to a point 22 $\frac{1}{2}$ links east of the Sec. line the end of said Road.

Scale 1 ch to inch.


Surveye March 17th 1893.


M. L. Connor Deft Surveyor.

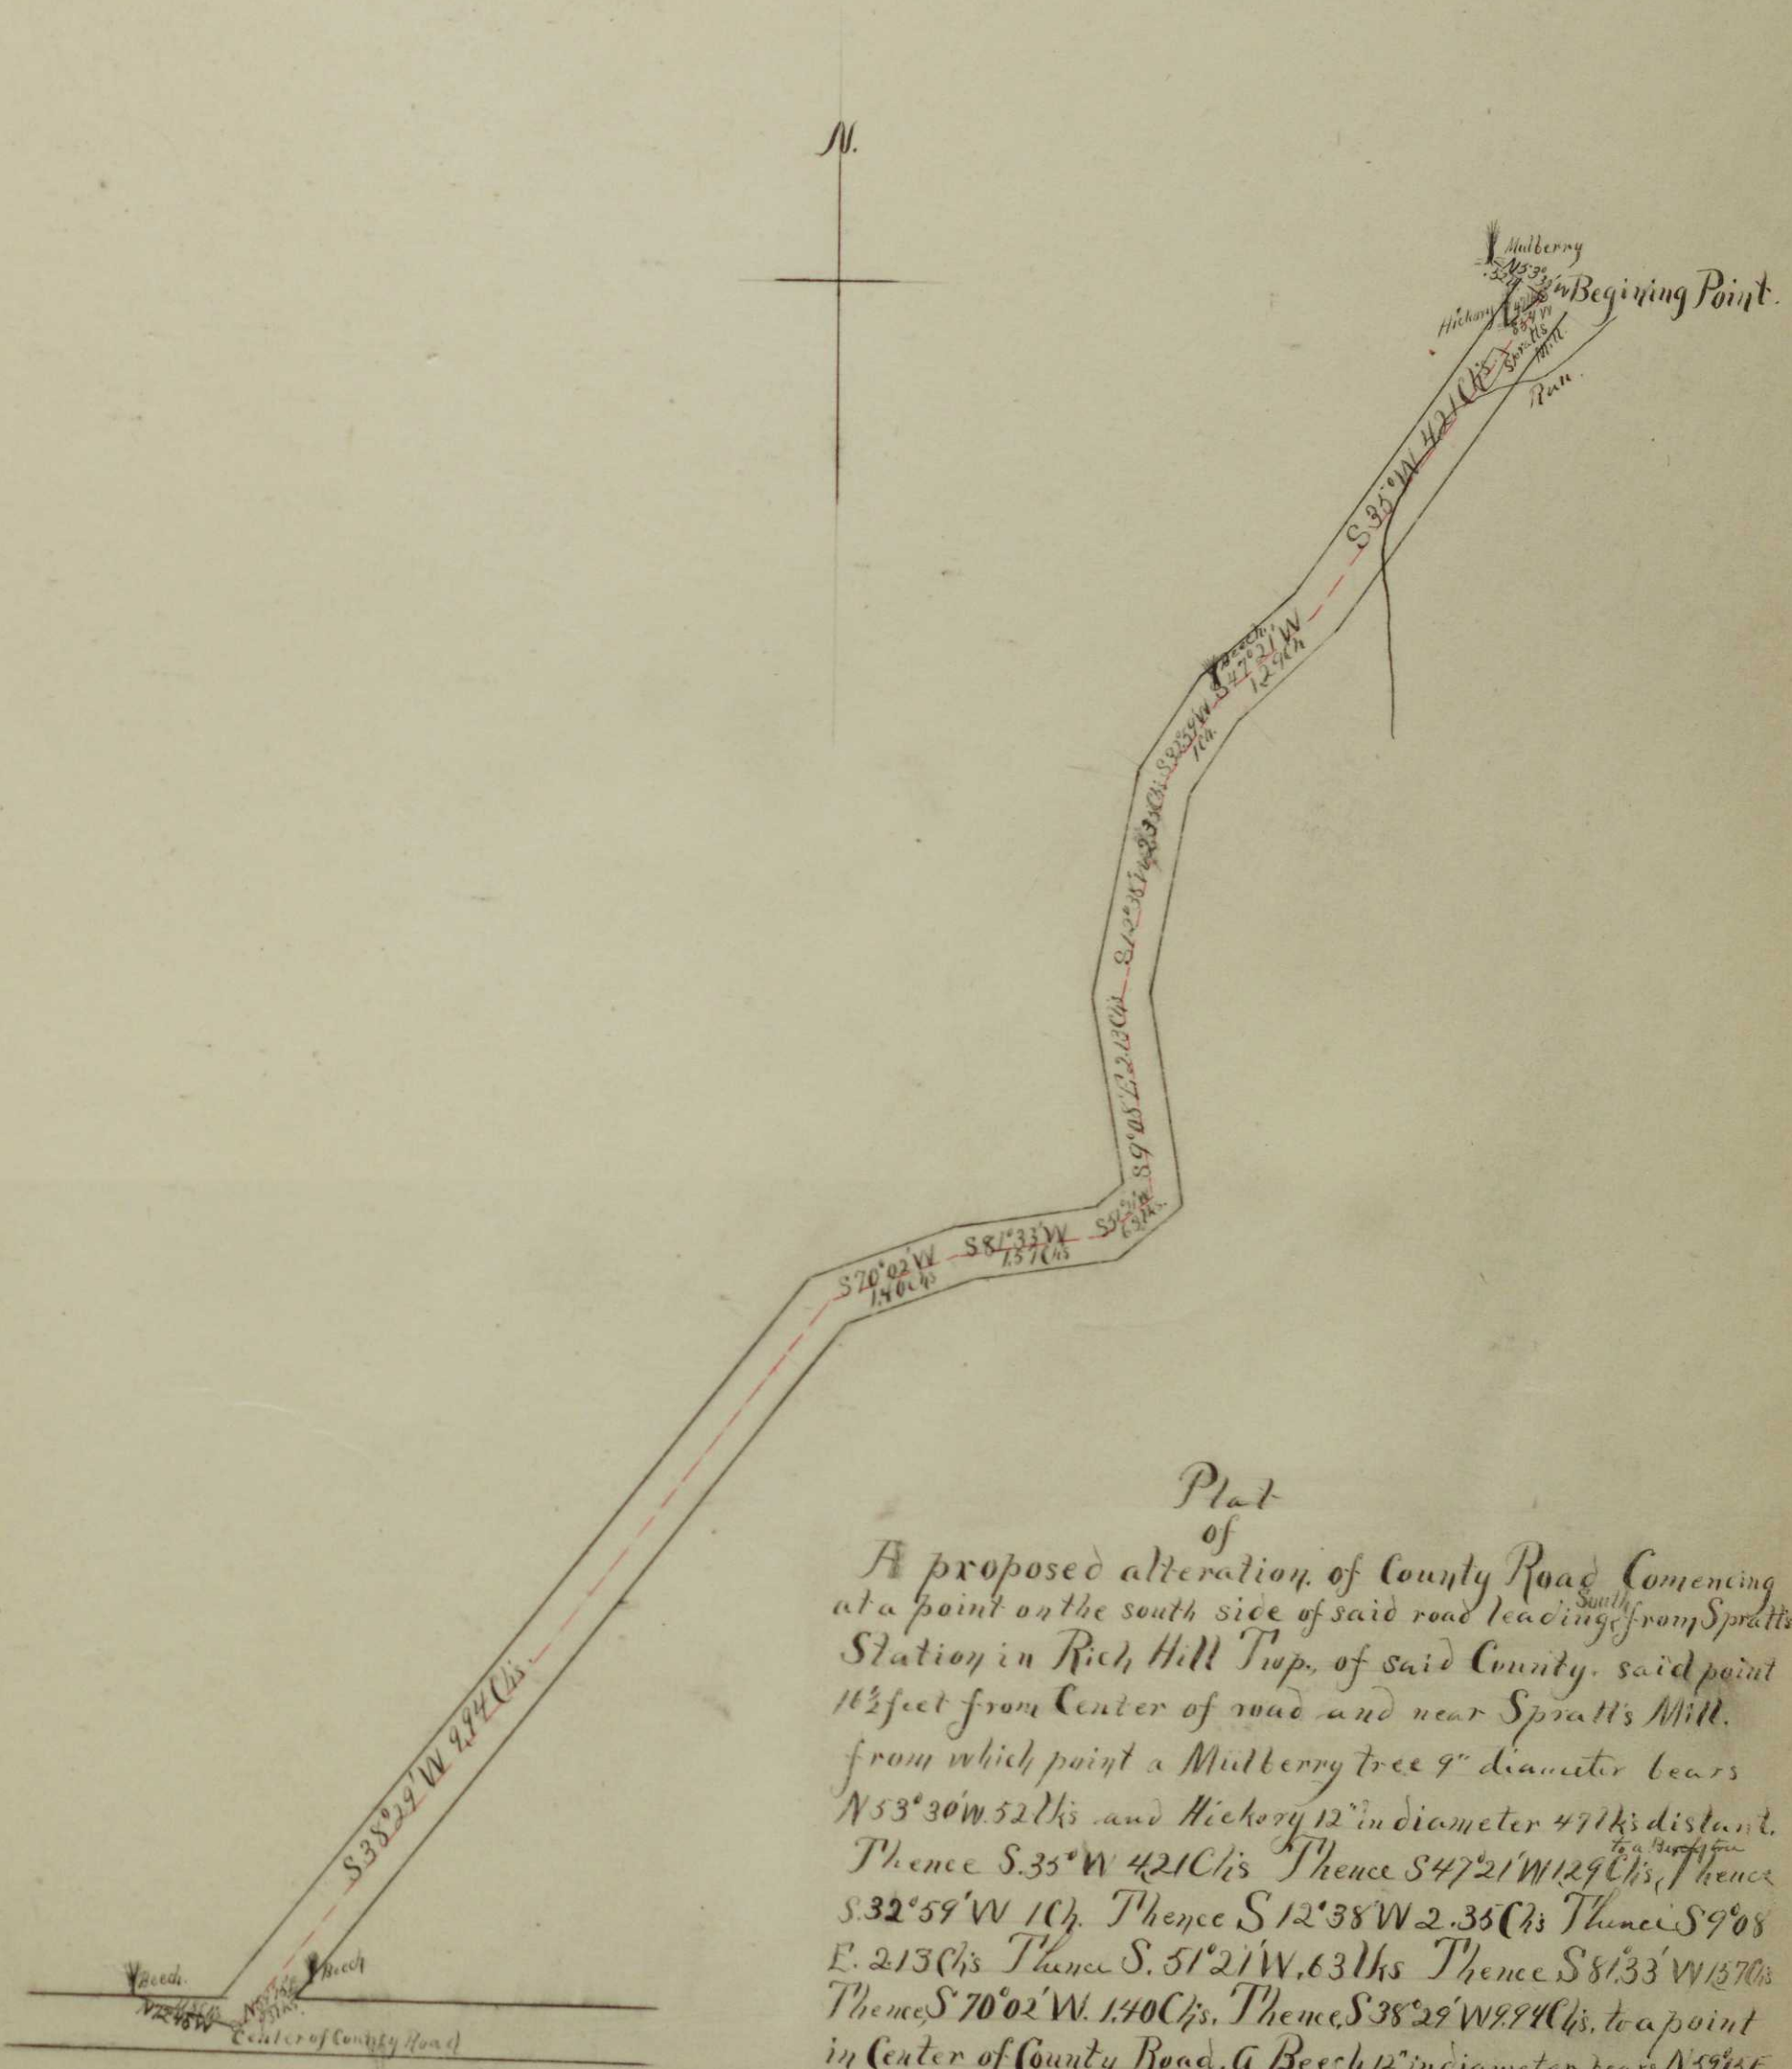

Plat
of
A proposed alteration of County Road Comencing
at a point on the south side of said road leading from Spratts
Station in Rich Hill Twp. of said County. said point
16 1/2 feet from Center of road and near Spratts Mill.
from which point a Mulberry tree 9" diameter bears
N 53° 30' W 52 Chs and Hickory 12" in diameter 47 Chs distant.
Thence S. 35° W 421 Chs Thence S 47° 21' W 129 Chs Thence
S 32° 59' W 10 Chs Thence S 12° 38' W 2.35 Chs Thence S 9° 08'
E. 2.13 Chs Thence S. 51° 21' W. 63 Chs Thence S 81° 33' W 157 Chs
Thence S 70° 02' W. 140 Chs. Thence S 38° 29' W 994 Chs. to a point
in Center of County Road. A Beech 12" in diameter bears N 59° 15' E.
93 links distant. also an other bears N 72° 45' W. 10" in diameter
118 Chs. Total Length 24 Chains and 54 links.

Scale 2 Chs = 1 inch. Surveyed April 4th 1893.
H. L. Camar Deft. Surveyor.

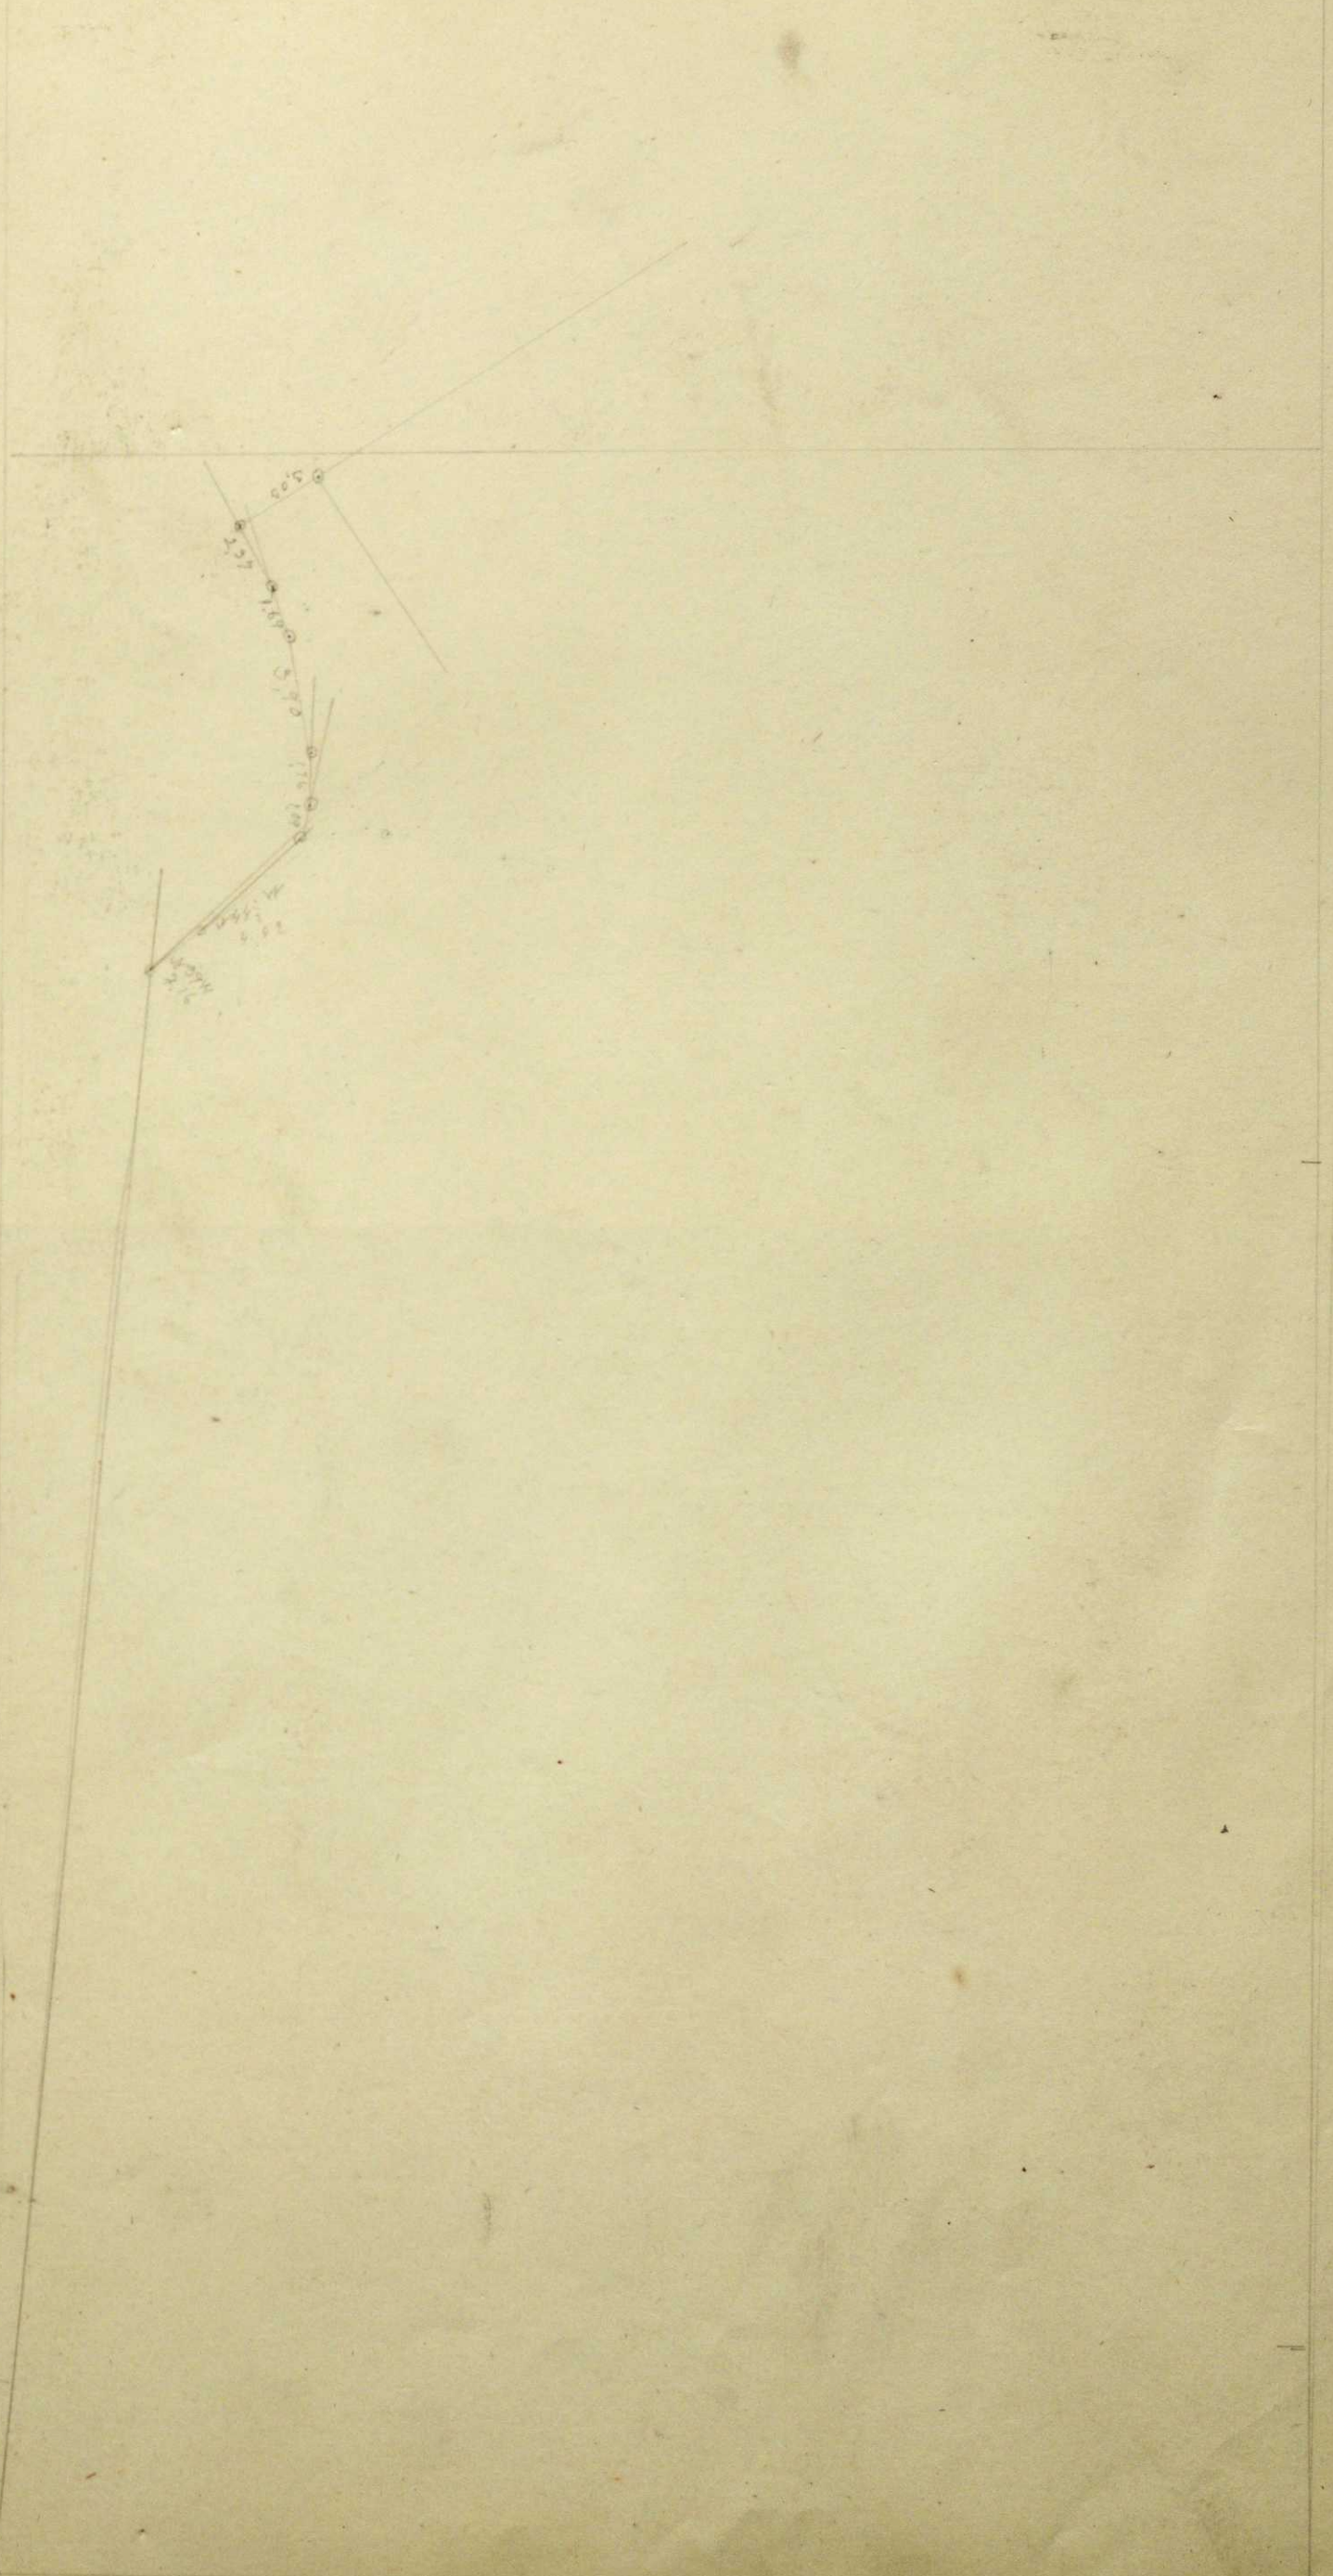


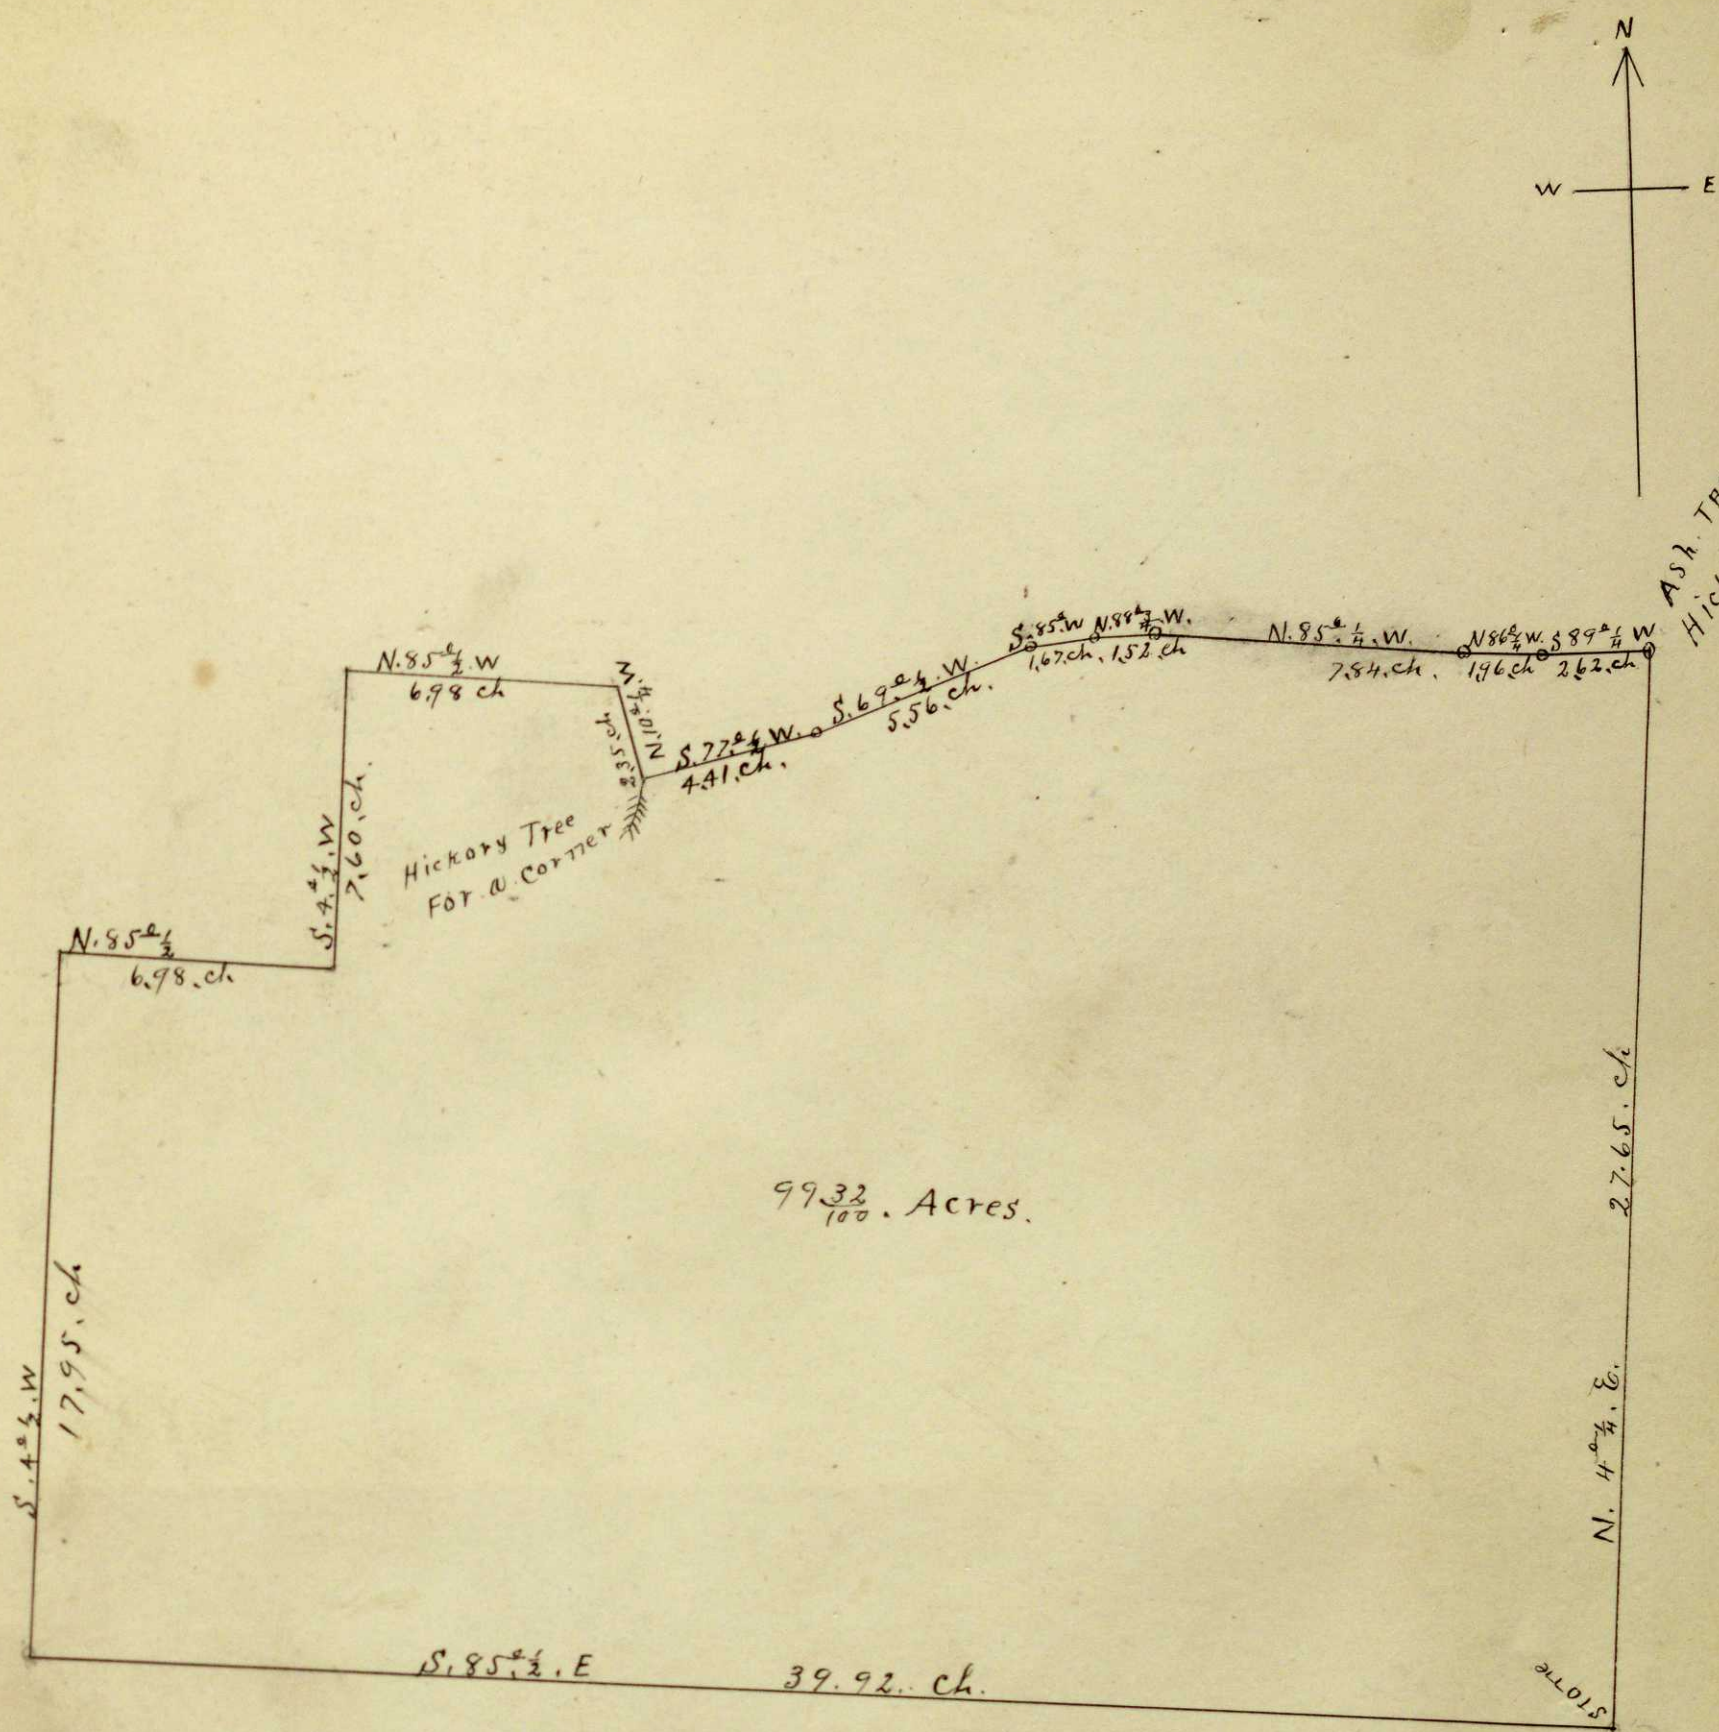

Survey of $99\frac{32}{100}$ Acres of Land off of The South Side
of The South West quarter of Section No 20. of Township
No. 2. of Range No. 5. of Highland Township, Muskingum
County Ohio and made at the instance of Thomas W. Denney
The present Owner of Said Land. Surveyed Sept 10th 1902
and Recorded Dec 26th 1902

County Surveyor

7. $\frac{43}{100}$ ACRES.

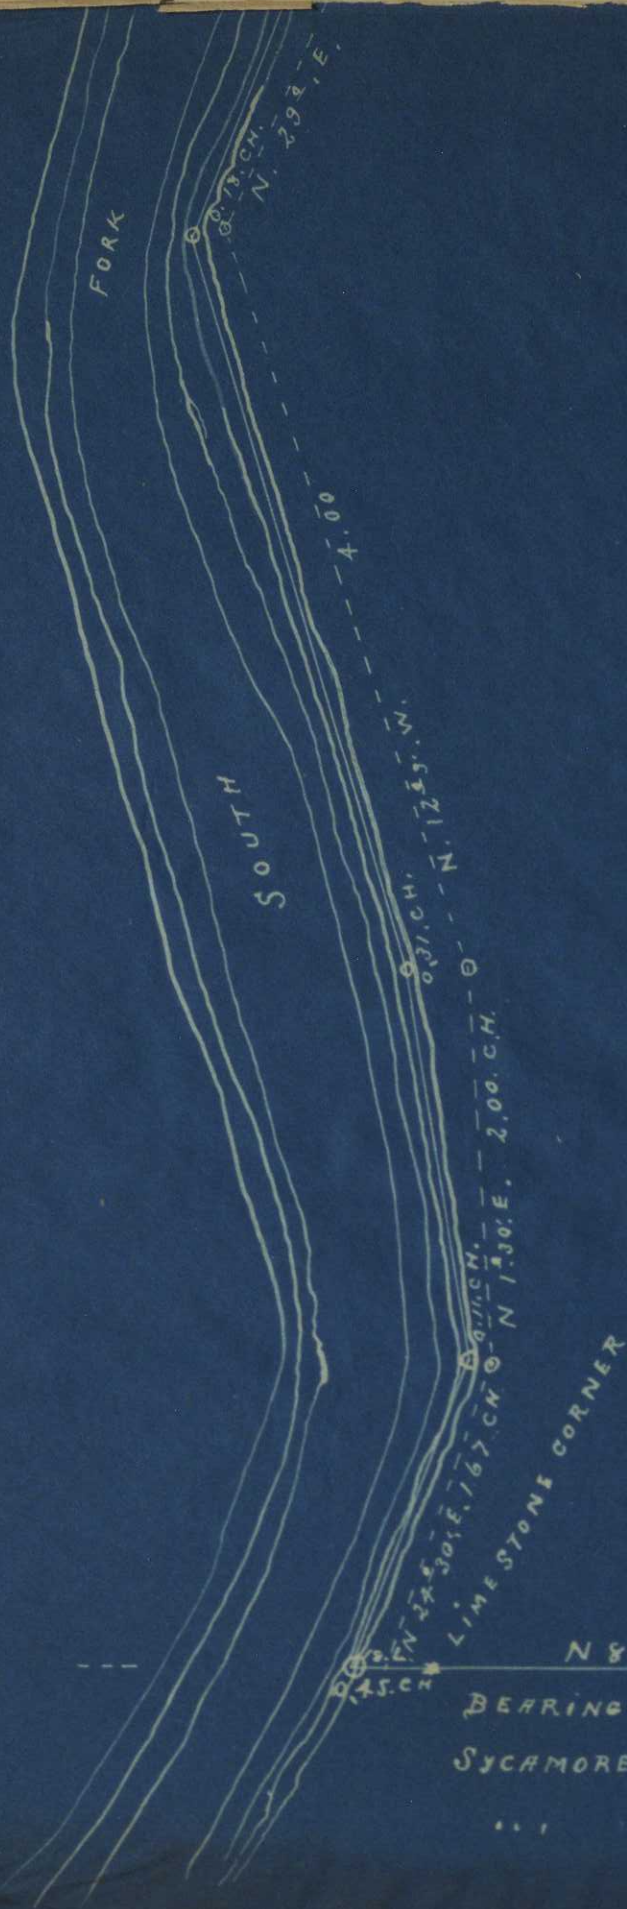


a Part of the S. E. qtr of Sect No. 27.

Muskingum County, Ohio. Surveyed for
Mrs Sarah. Reese, on March 22nd 1904 The
Courses are present Magnetic The Distances
are given in Chains and Decimals

SCALE OF PLAT 1" = 1. CHAIN.

L. West
County Surveyor

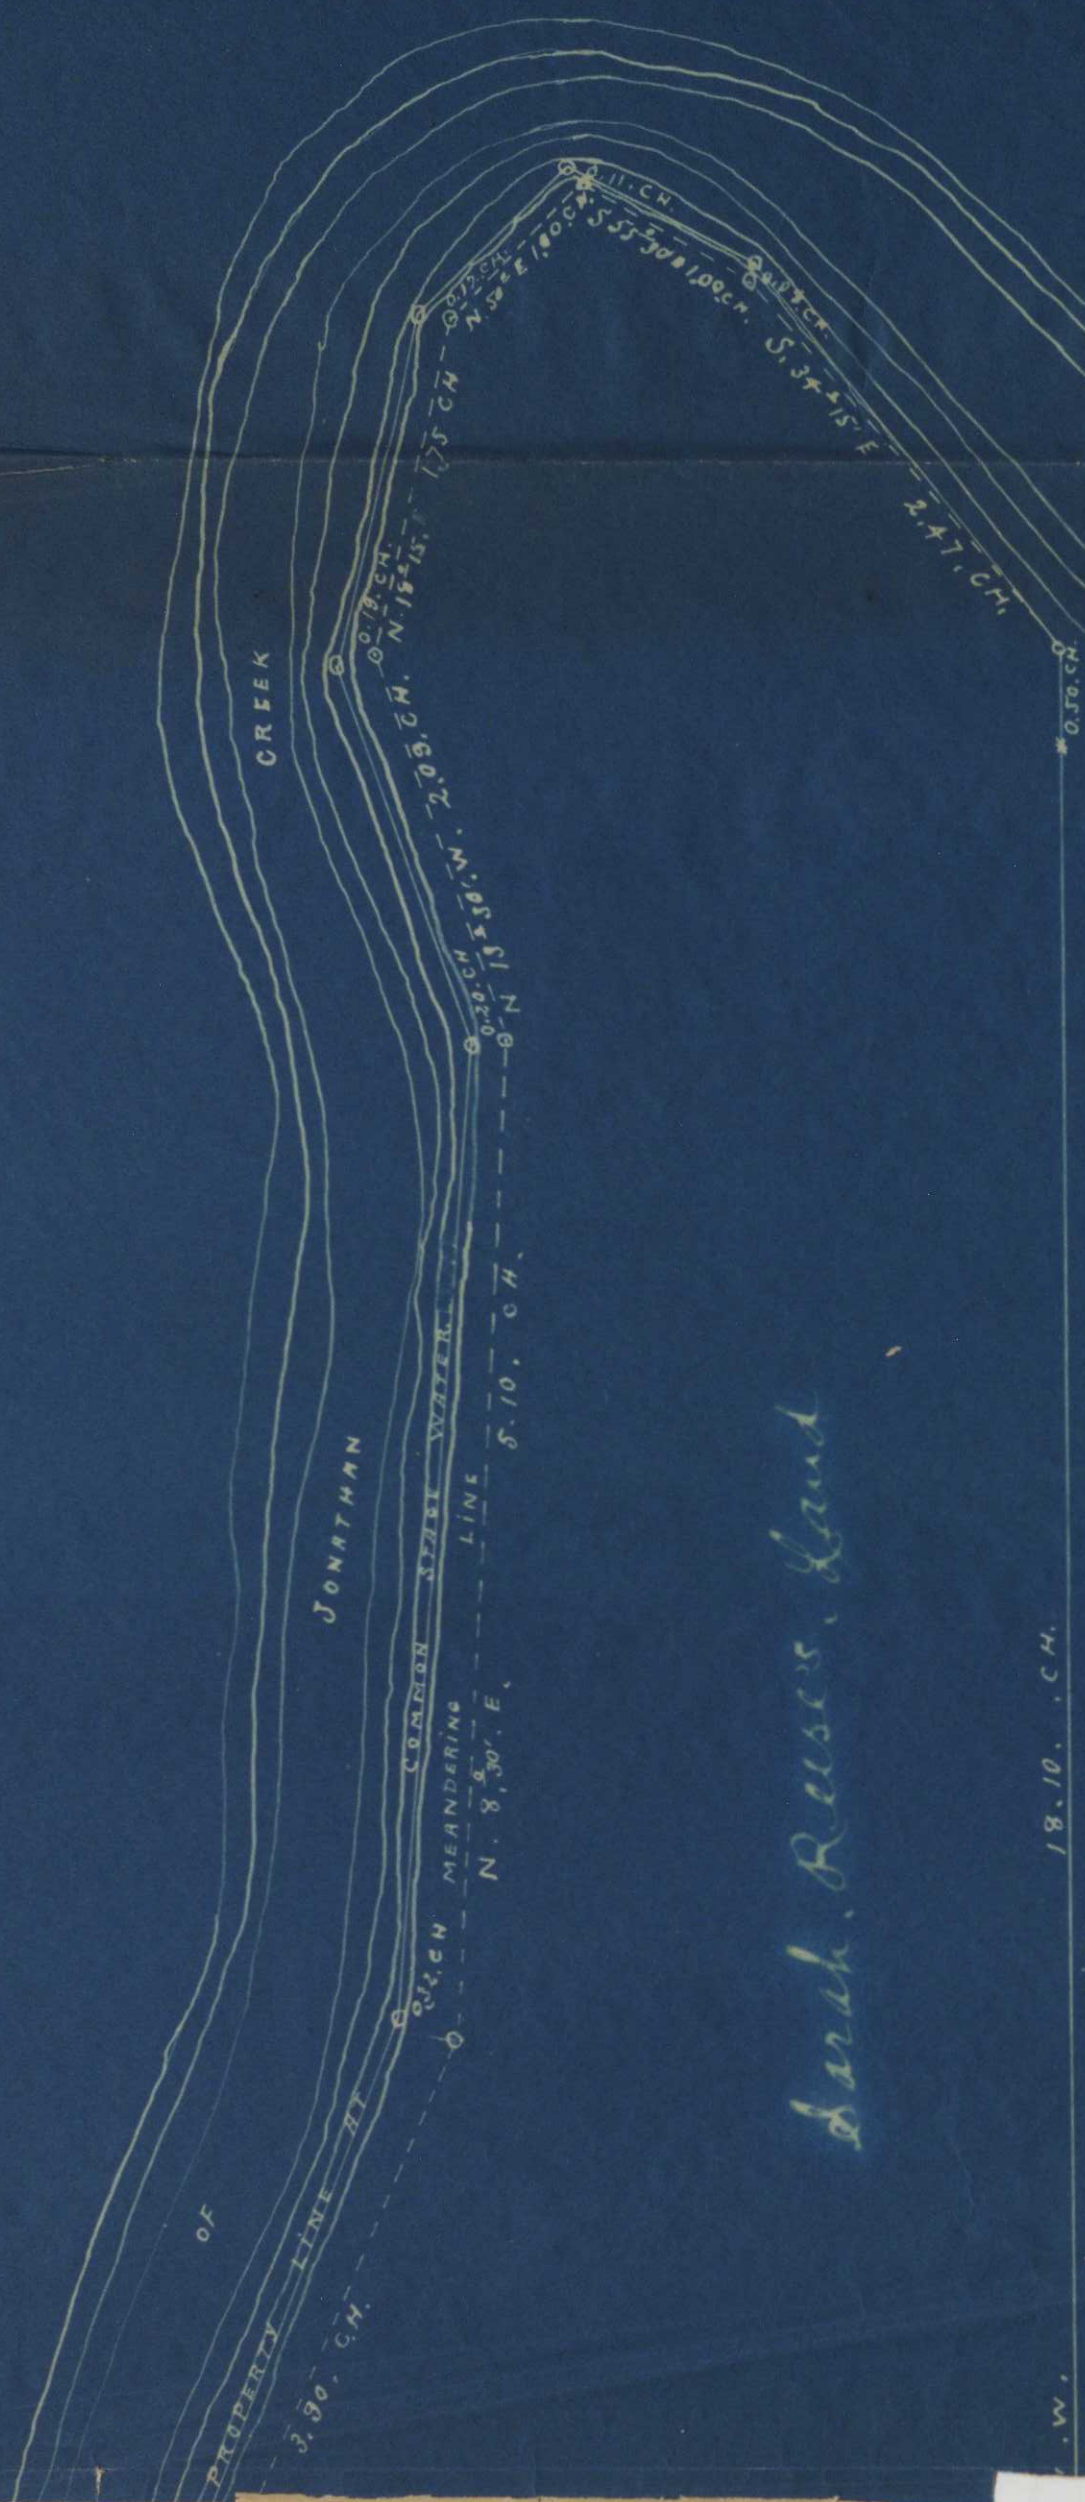

LIMESTONE CORNER
BEARING TREES
BUCKEY 10" DIA S. 73.01. E. 12. LINKS.
" 11. " " N 85.30. W. 20 " "



Sarah Reuser, Land

The Plat Hereon Constructed
Represents a piece or parcel of Land
Situated in the South East part of the
South East quarter of Section No 27
T. 15. R. 1. N. 1. W. 1. Township

Stone 586°-25'E 7.88 ch 88°31' 91°55'


4' Wp. Oak
579°E 17L.

Area 23.00 A.

PLAT
OF PART OF
THE SPILLMAN FARM
SURVEYED NOV. 20 & 21 '08.
By F. E. Withgott Dep. Co. Sur.
Scale 2 ch. = 1".
RICH-HILL T.P.

Note:- Centre Line of Road followed-
Original Road-Notes not at hand.

Stone 0.8 ft. W
West of Line
20.36 ch. N.
of Sec. Line Stone.

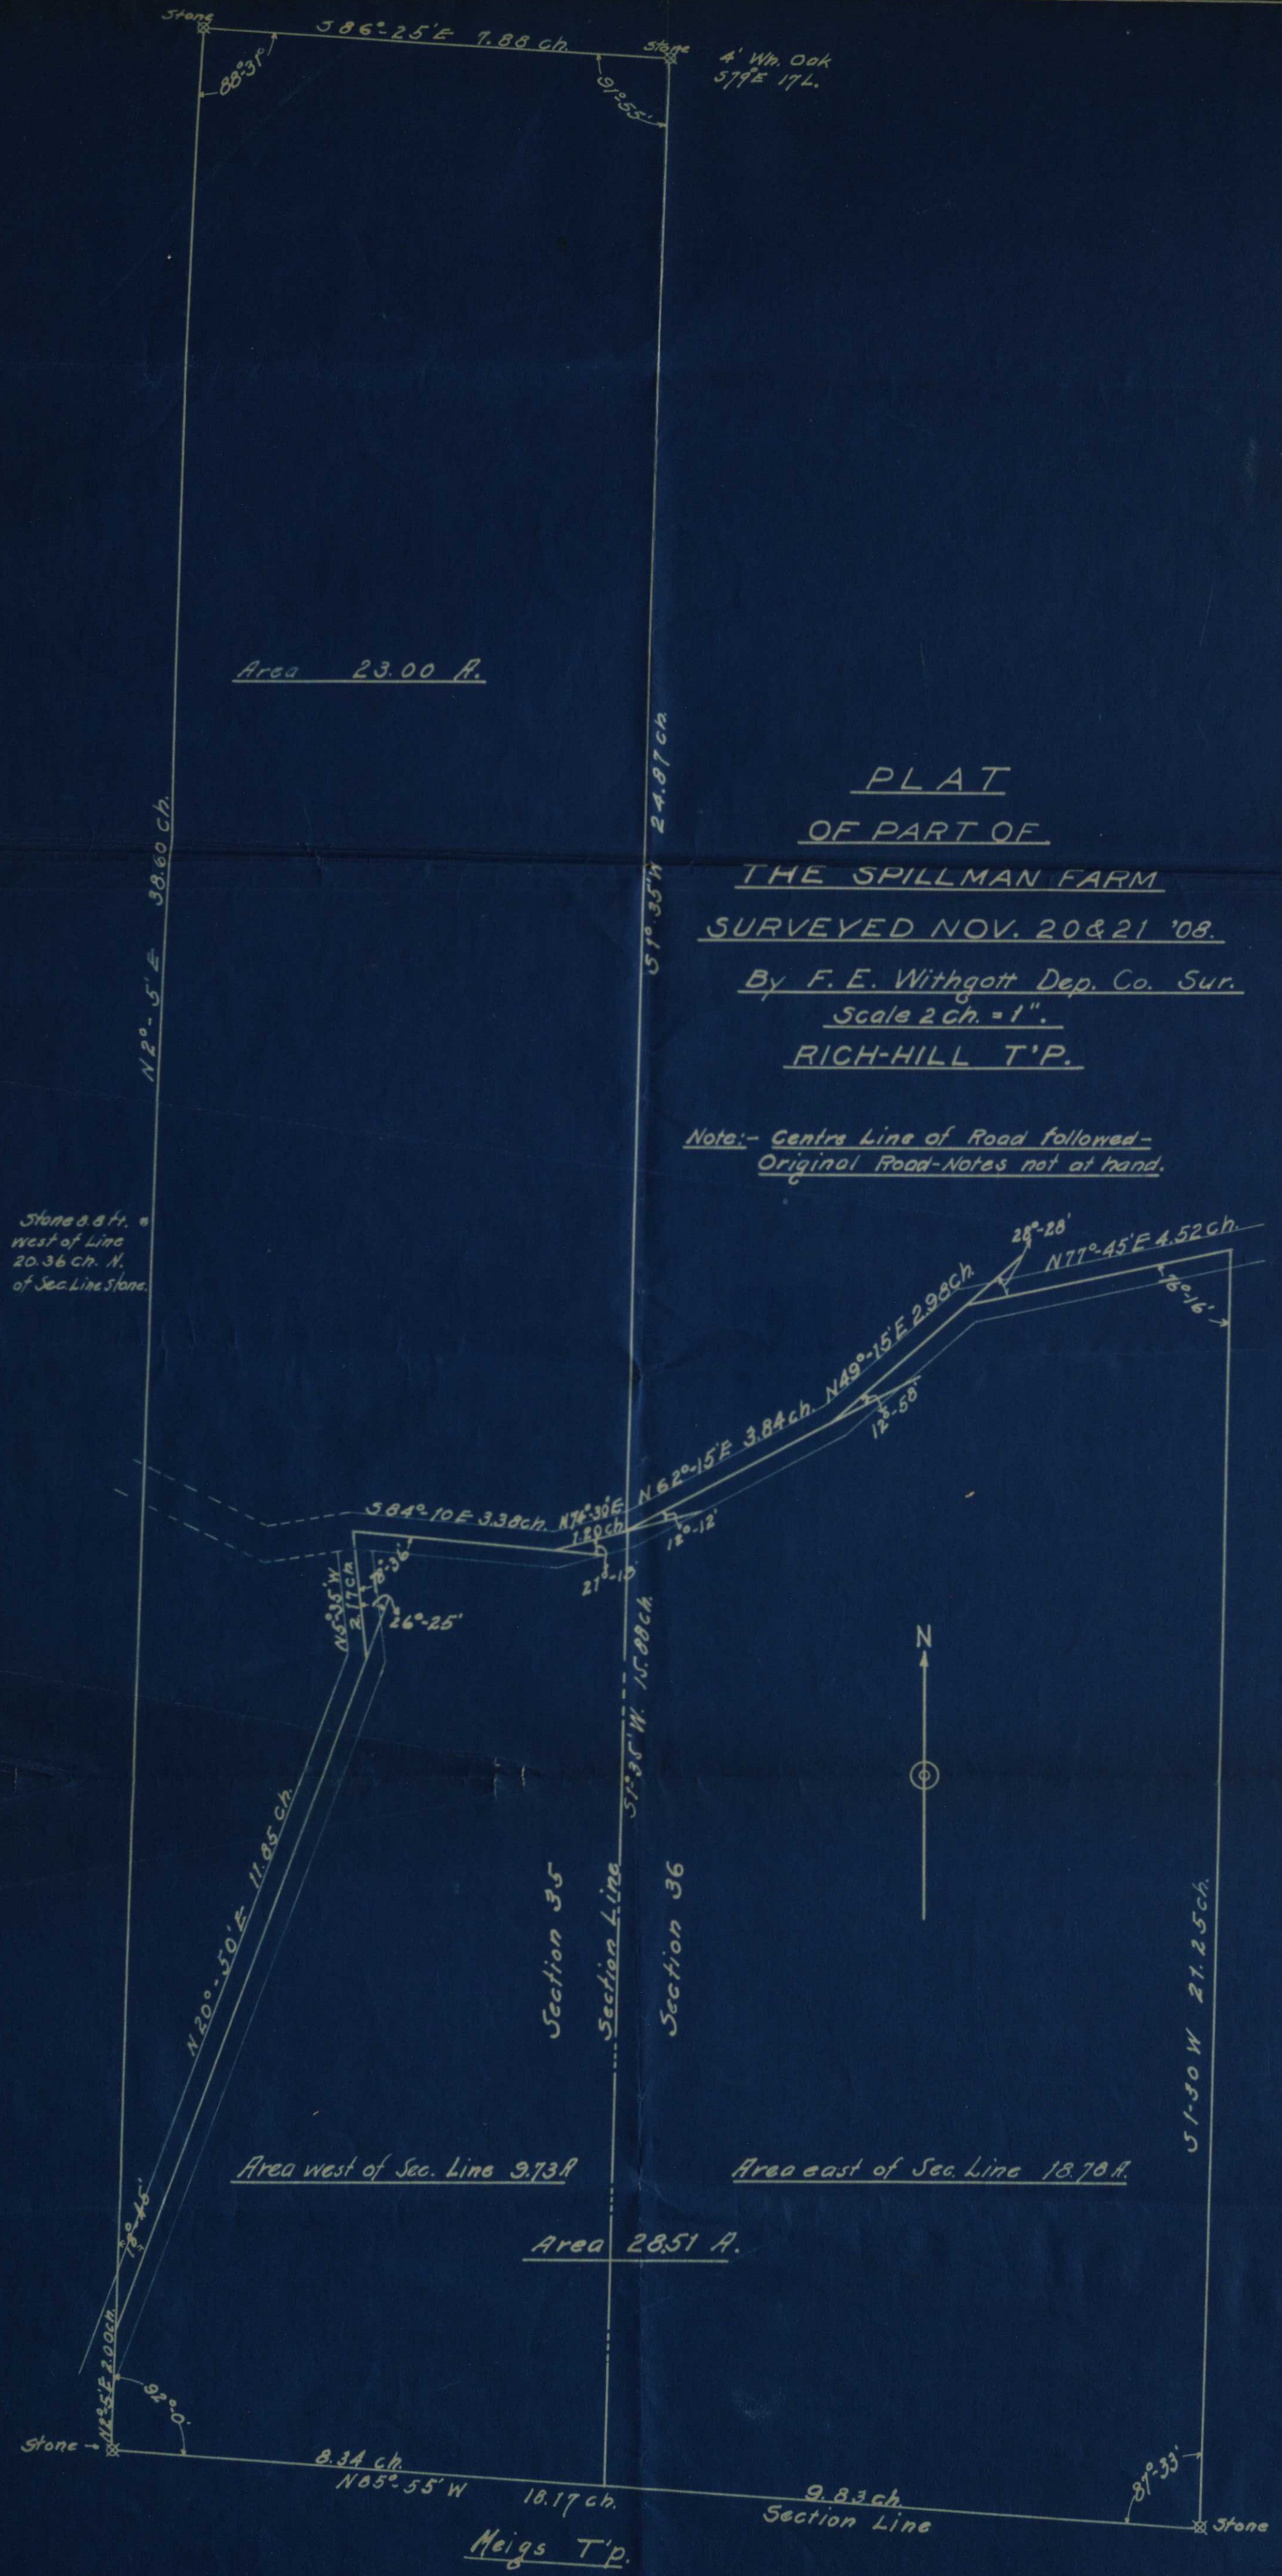

Area west of Sec. Line 9.73 A

Area east of Sec. Line 18.78 A

Area 28.51 A.

Meigs T.P.

Stone 13.2' E. of
N-E. Cor. Lot 57.

Frank E. Withgott

L. West.

PLAT OF
THREE LOTS
LAID OUT FOR
PHOEBE C. CHERRY
ROSEVILLE, OHIO.
SCALE 50' = 1" INCH.



485.8'

North.

66.0'

66.0'

132'

ALLEY 16'

120.1' North

47.0

3

589°-33' E

47.0

126.1' North

2

58.3

132' North

1

Stone

132.1' N 3-21 E

87°-06'

STREET 50'

ALLEY 16 1/2'

SECTION LINE

119' 90°-21'

Stone 47.4' 582°-23' E



47.4'

50.6' 587°-33' E

Stone

ATHENS ROAD.

Stone 132'
East of S-E. Cor. of
Old Corporation Line.
689.8 Ft. East of S-W. Cor. of S-W Qu.
of Section 3.

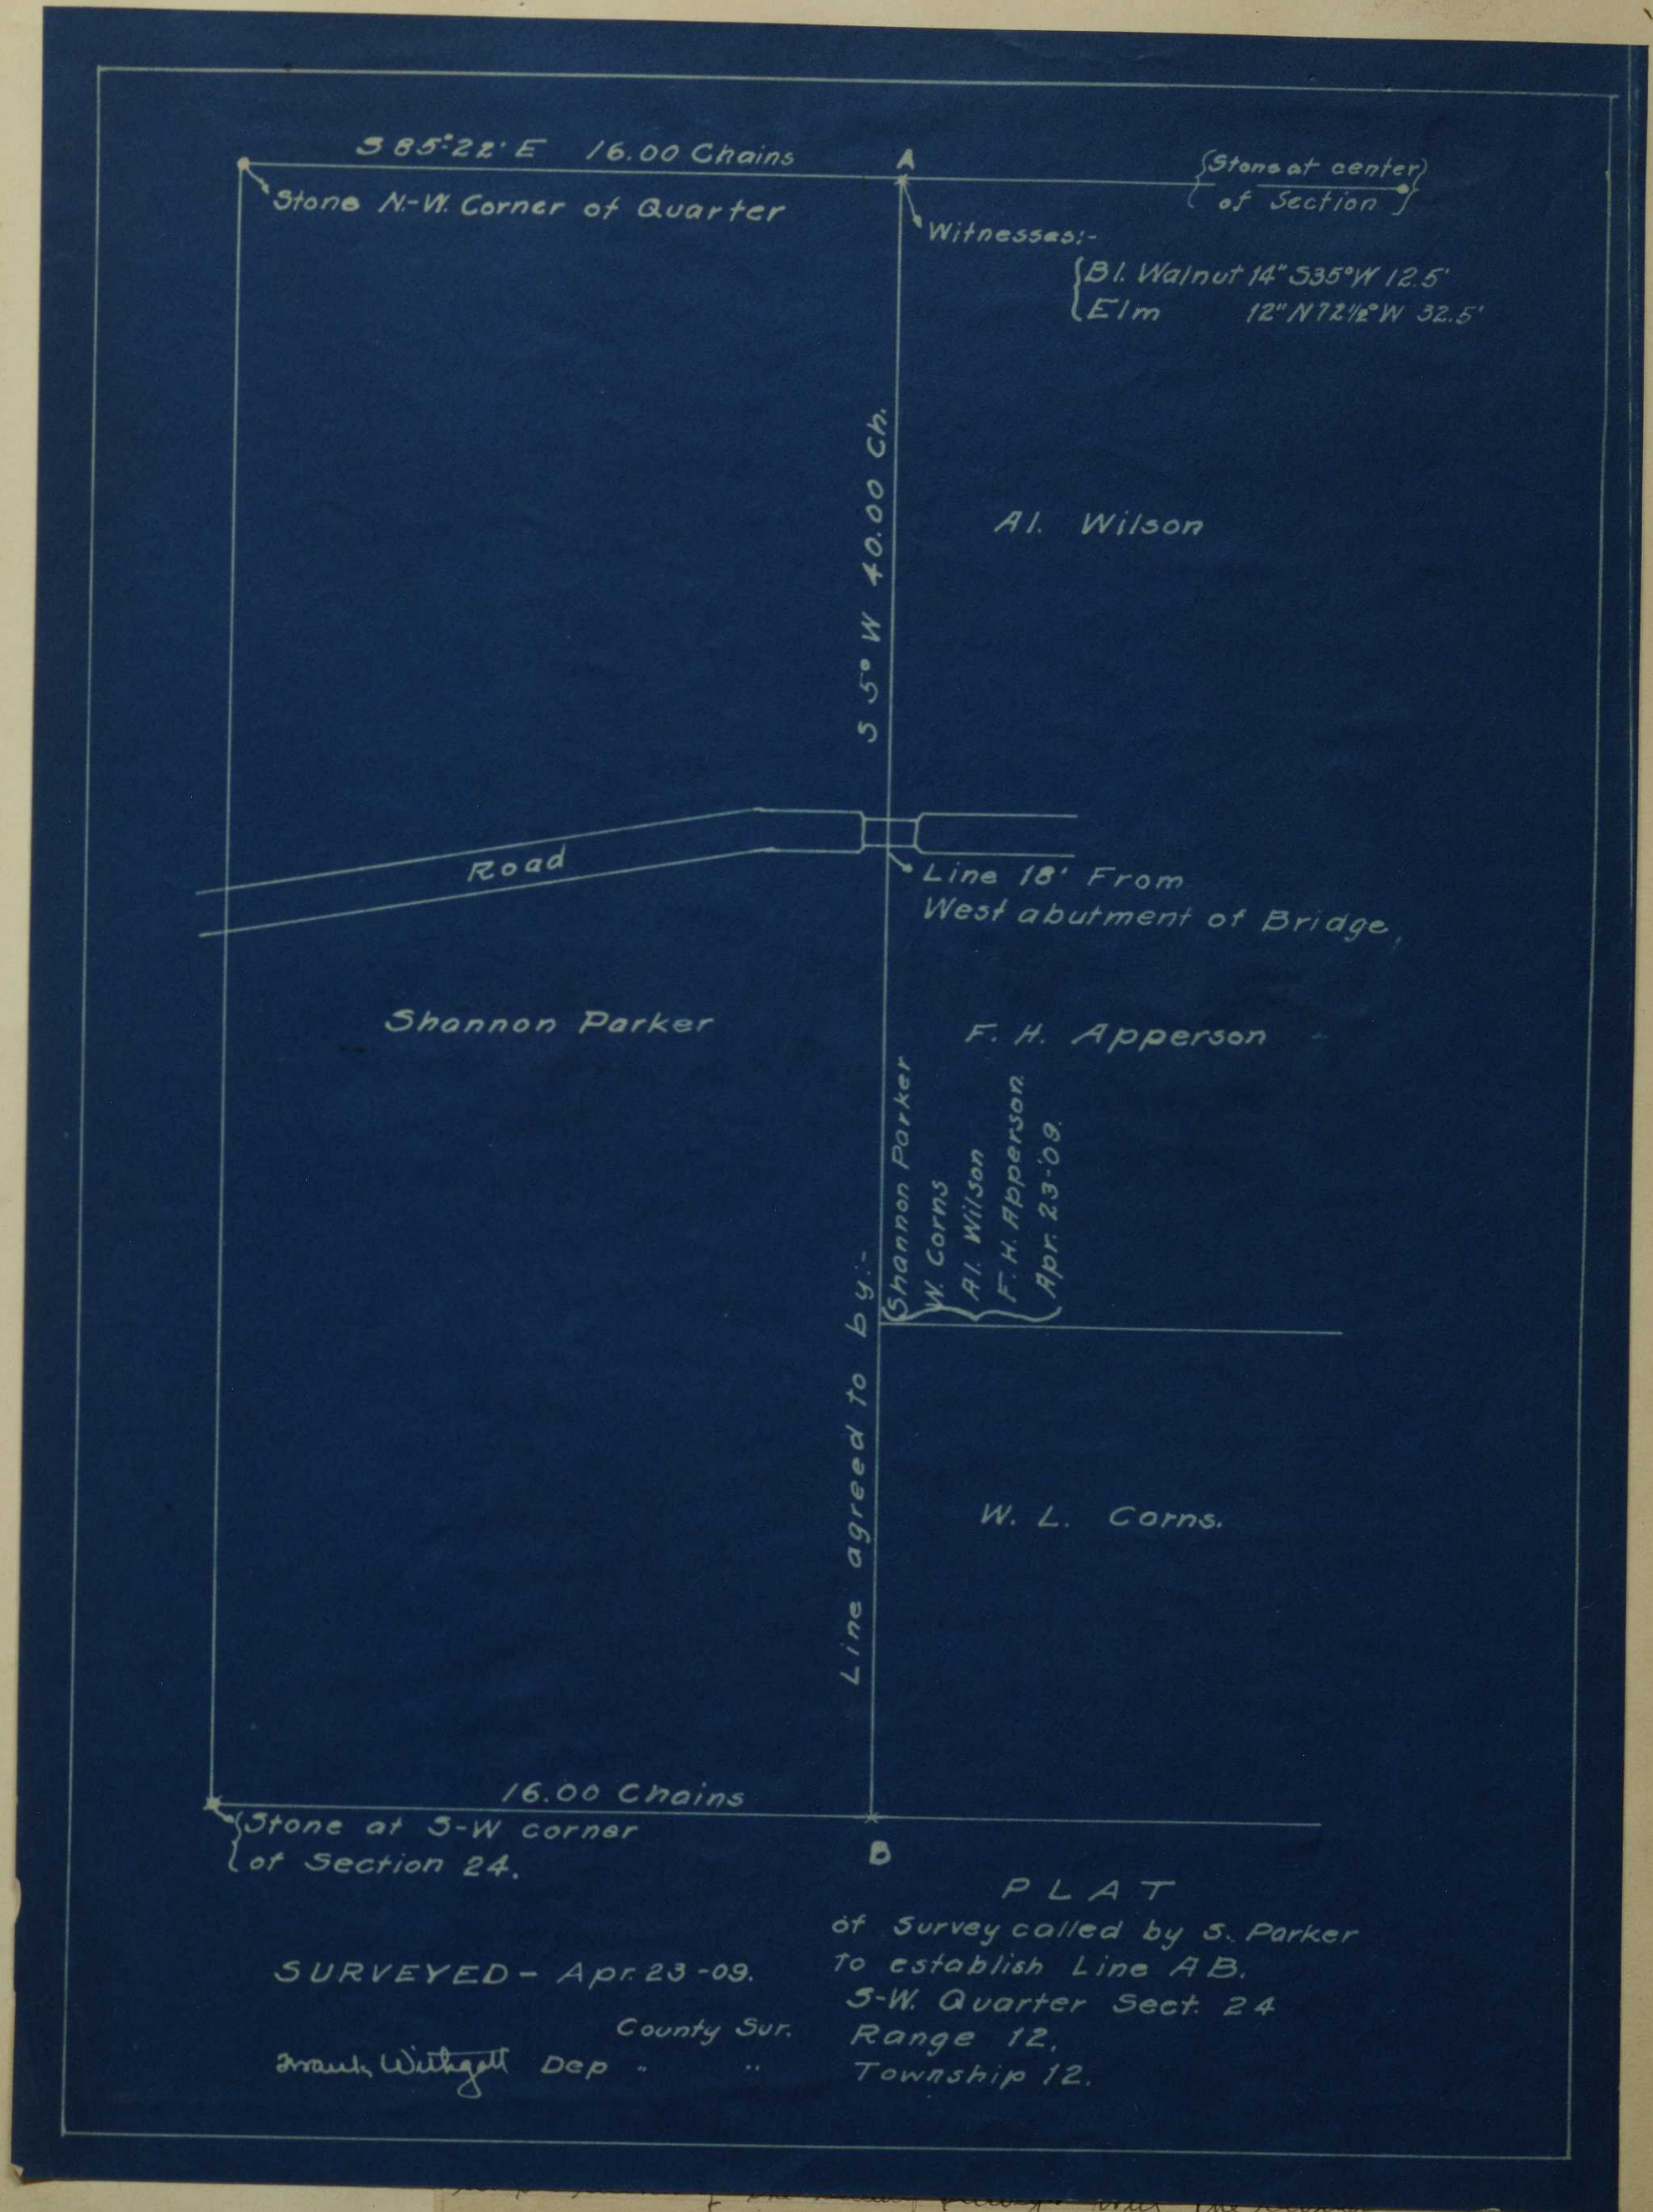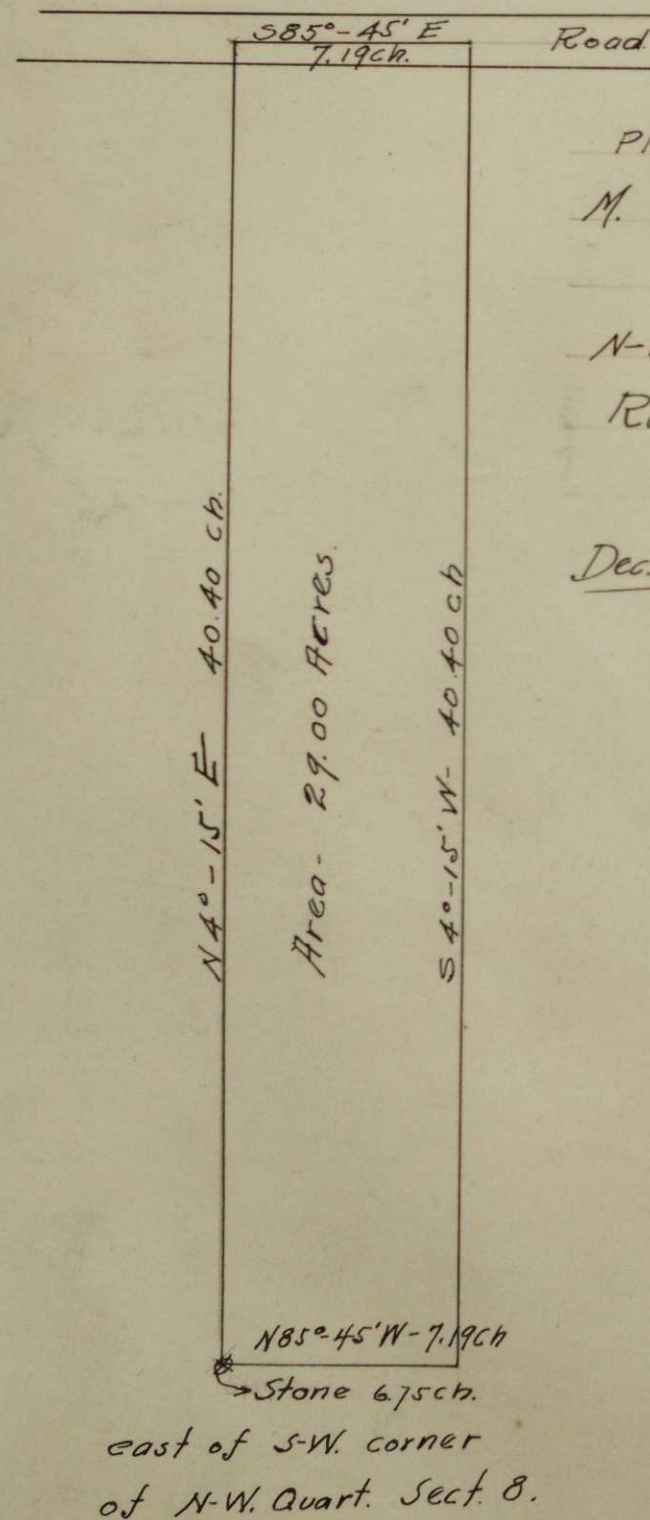

Plat of said survey and a certified copy of said
plat and of this agreement shall be made
by said Frank E. Withgott, Deputy Surveyor and

585°-45' E
7.19 ch Road

N 4°-15' E 40.40 ch

Area - 29.00 Acres

S 4°-15' W 40.40 ch

N 85°-45' W - 7.19 ch

Stone 675 ch.
east of S.W. corner
of N.W. Quart. Sect. 8.

Plat of Survey made for
M. W. Spencer, Muskingum T'p.
Land situated in the
N.W. Quarter of Section 8,
Range 8 - Township 2, U. S. Mil. Lands.
L. West Co. Surveyor.

Dec. - 10 - 1908

AGREEMENT

Notice is hereby given that an agreement is entered into this twenty third ⁽²³⁾ day of April nineteen hundred and nine, whereby we the undersigned do hereby agree in good faith to except as the established line between ~~the~~ the line surveyed this twenty third (23) of April nineteen hundred and nine by Frank E. Withgott, Deputy County Surveyor of Muskingum County. Said line is forty ⁽⁴⁰⁾ chains long and lies sixteen chains east of the West boundary line of South-west quarter of section twenty four (24), Range Twelve (12), and Township twelve (12) in the District of Jewessville and lies parallel to said West boundary line.

This Article of Agreement shall be recorded in the records of the County Surveyor with the recorded plat of said survey and a certified copy of said plat and of this agreement shall be made by said Frank E. Withgott, Deputy Surveyor and

mailed to each of the undersigned with
in two (2) weeks from the date of this
agreement.

We the undersigned further agree that
within eighteen months from this twenty
third day of April nineteen hundred and nine
we will voluntarily place our fences on
the above line as staked out by said
F. E. Withgall, Deputy Surveyor

In witness whereof we the undersigned
subscribe our names this twenty third day
of April nineteen hundred and nine

Witnesses;

Frank E. Withgall Dep. Surveyor

Jacob Schell Head Chairman

Reas. Chairman

Alex. McArthur

W. S. Parker

Walter Corns


Ch. H. Apperson

H. A. Wilson

Survey and Plat of School Lot,
District No. 2, Clay Township, Muskingum Co., O.
Bearings are present Magnetic. Distances are
in Feet and tenths of feet.

Surveyed May 6, 1909.


County Surveyor.

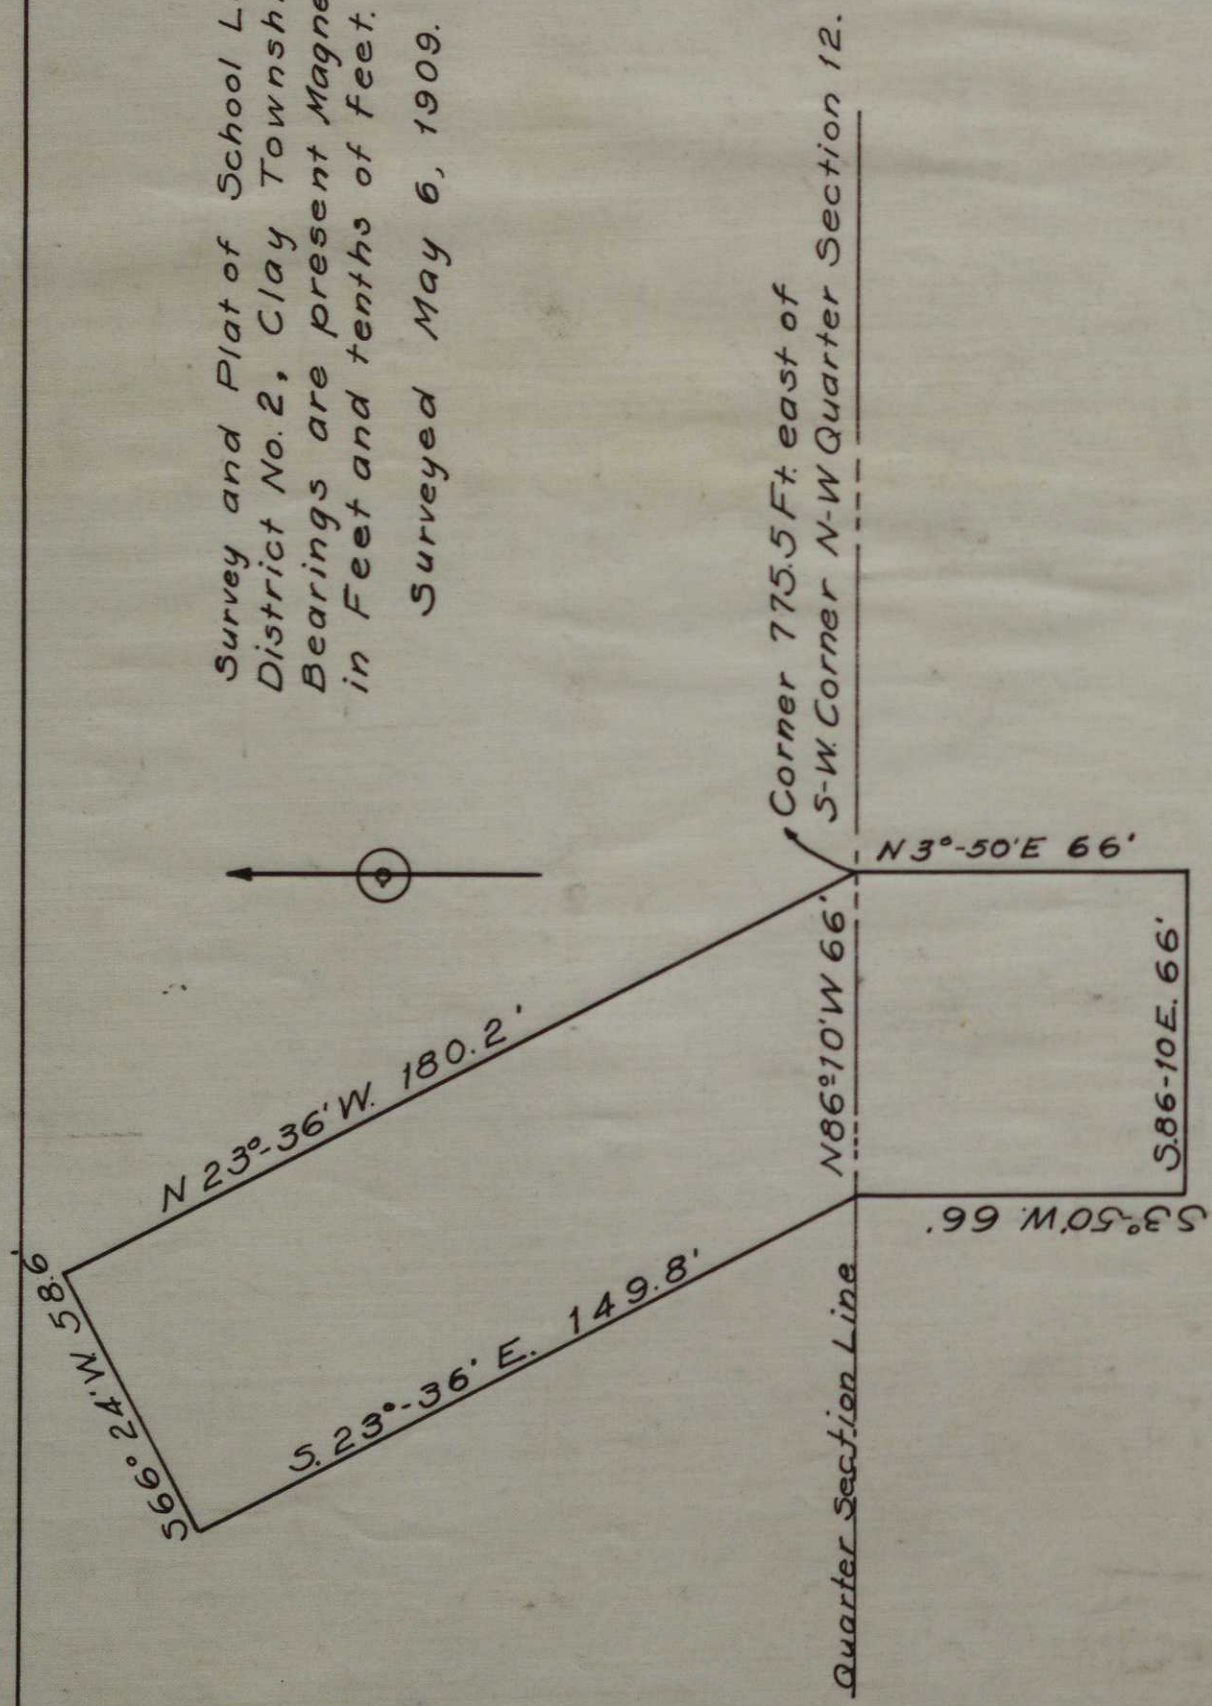

Survey and Plat of School Lot,
District No. 1, Clay Township, Muskingum Co., O.
Bearings are present Magnetic. Distances
are in Feet and tenths of feet.

Surveyed May 28 1909.

County Surveyor.

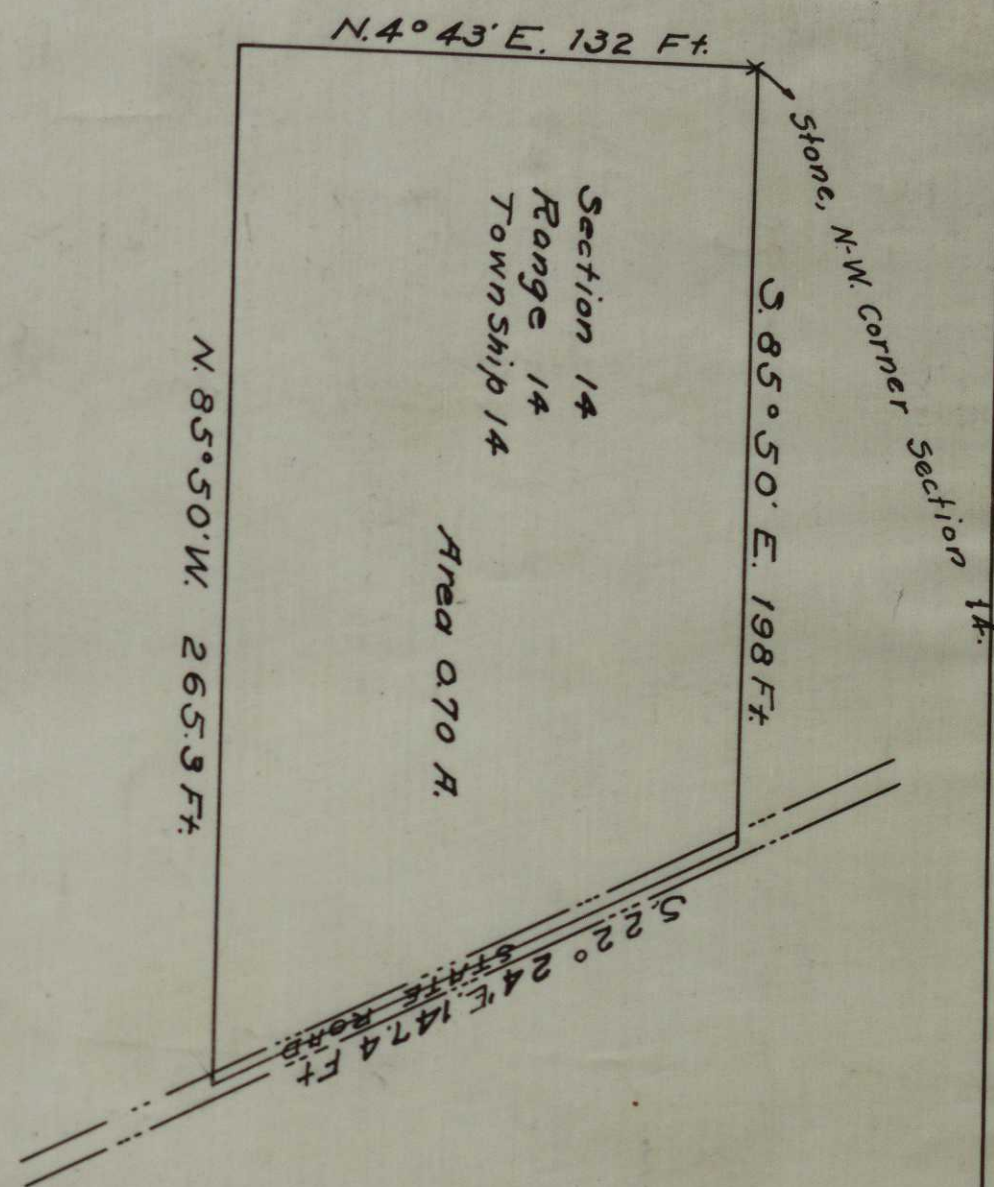

I hereby certify that the above plat of New
Concord Cemetery situated in Union Township
Muskingum County and State of Ohio. It being
parts of the N.W. & S.W. $\frac{1}{4}$ s of Sec. 1 and the N.E.
& S.E. $\frac{1}{4}$ s of Sec. 2. T. 1 R. 5 and bounded and
described as one tract as shown by the plat.
The size of the lots and width of streets and
alleys are marked on the plat in feet and
hundredths of a foot. The Sections are
designated by the letters A. B. C. D. & E.
Stones were planted at the points designated
on the plat. The part in the N.W. $\frac{1}{4}$ of Sec. 1
contains 0.3% of an acre. The S.W. $\frac{1}{4}$ - 0.5% of an acre.
The S.E. $\frac{1}{4}$ of Sec. 2 contains 0.1% of an acre and
the N.E. $\frac{1}{4}$ - 0.18% of an acre. Surveyed Nov. 16th 1898

J. C. Connor C. E.

Surveyor



D. Y. GEDDES
County Surveyor

F. E. WITHGOTT
Deputy County Surveyor

County Surveyor's Office
Muskingum County

Zanesville, Ohio.

Depositions of Arthur Taylor, Union Tp.

- Q. Who placed the stone in the intersection of the fence lines between the 88 acre tract and the 63 acre tract so called and the south line of both tracts?
- A. My grandfather.
- Q. Who told you that your grandfather had placed the stone just referred to at this particular point?
- A. My brother. Measured 63 acres west of stone.
- Q. How long has this fence been here?
- (Note: The fence in question is the existing fence line between the property of Arthur Taylor and the Home Property.)
- A. I could not tell.
- Q. How long do you know of a fence being here?
- A. Thirty five years.
- Q. How long has the fence been in place along the west side of the garden?
- A. Ever since the house (meaning homestead) was built.
- Q. Referring to the stone at the south east corner of the so-called 88 acre tract, how do you know that this stone is the corner?
- A. Mr Wallace told me.
- Q. How long has this stone been taken and considered as a corner?
- A. All of my life.

The above depositions are the true statements of Arthur Taylor, of Union Tp., Muskingum County, O. sworn to before me, D. Y. Geddes, County Surveyor in and for said County.

October 5, 1909.

D. Y. Geddes
.....
County Surveyor.

Witness:

Frank Withgott
.....

J. R. TANNER, C. E.
CONSULTING ENGINEER
MASONIC TEMPLE


DESIGN AND CONSTRUCTION
OF
WATER WORKS AND SEWERAGE DISPOSAL PLANTS,
ELECTRIC LIGHT AND POWER SYSTEMS,
IRON, STEEL AND CONCRETE WORK.

ZANESVILLE, OHIO

Sworn Statement:
The stake at the North West corner of lot 41, Fair Oaks Add. to the City of Zanesville, O. has been known to be and has been recognized by me to be the corner of said lot 41 for the past 18 years.

Flora Thompson
C. W. Thompson

On Aug. 27, 1910 the above stake was replaced by an iron pin set by me in the presence of C. W. Thompson
J. R. Tanner

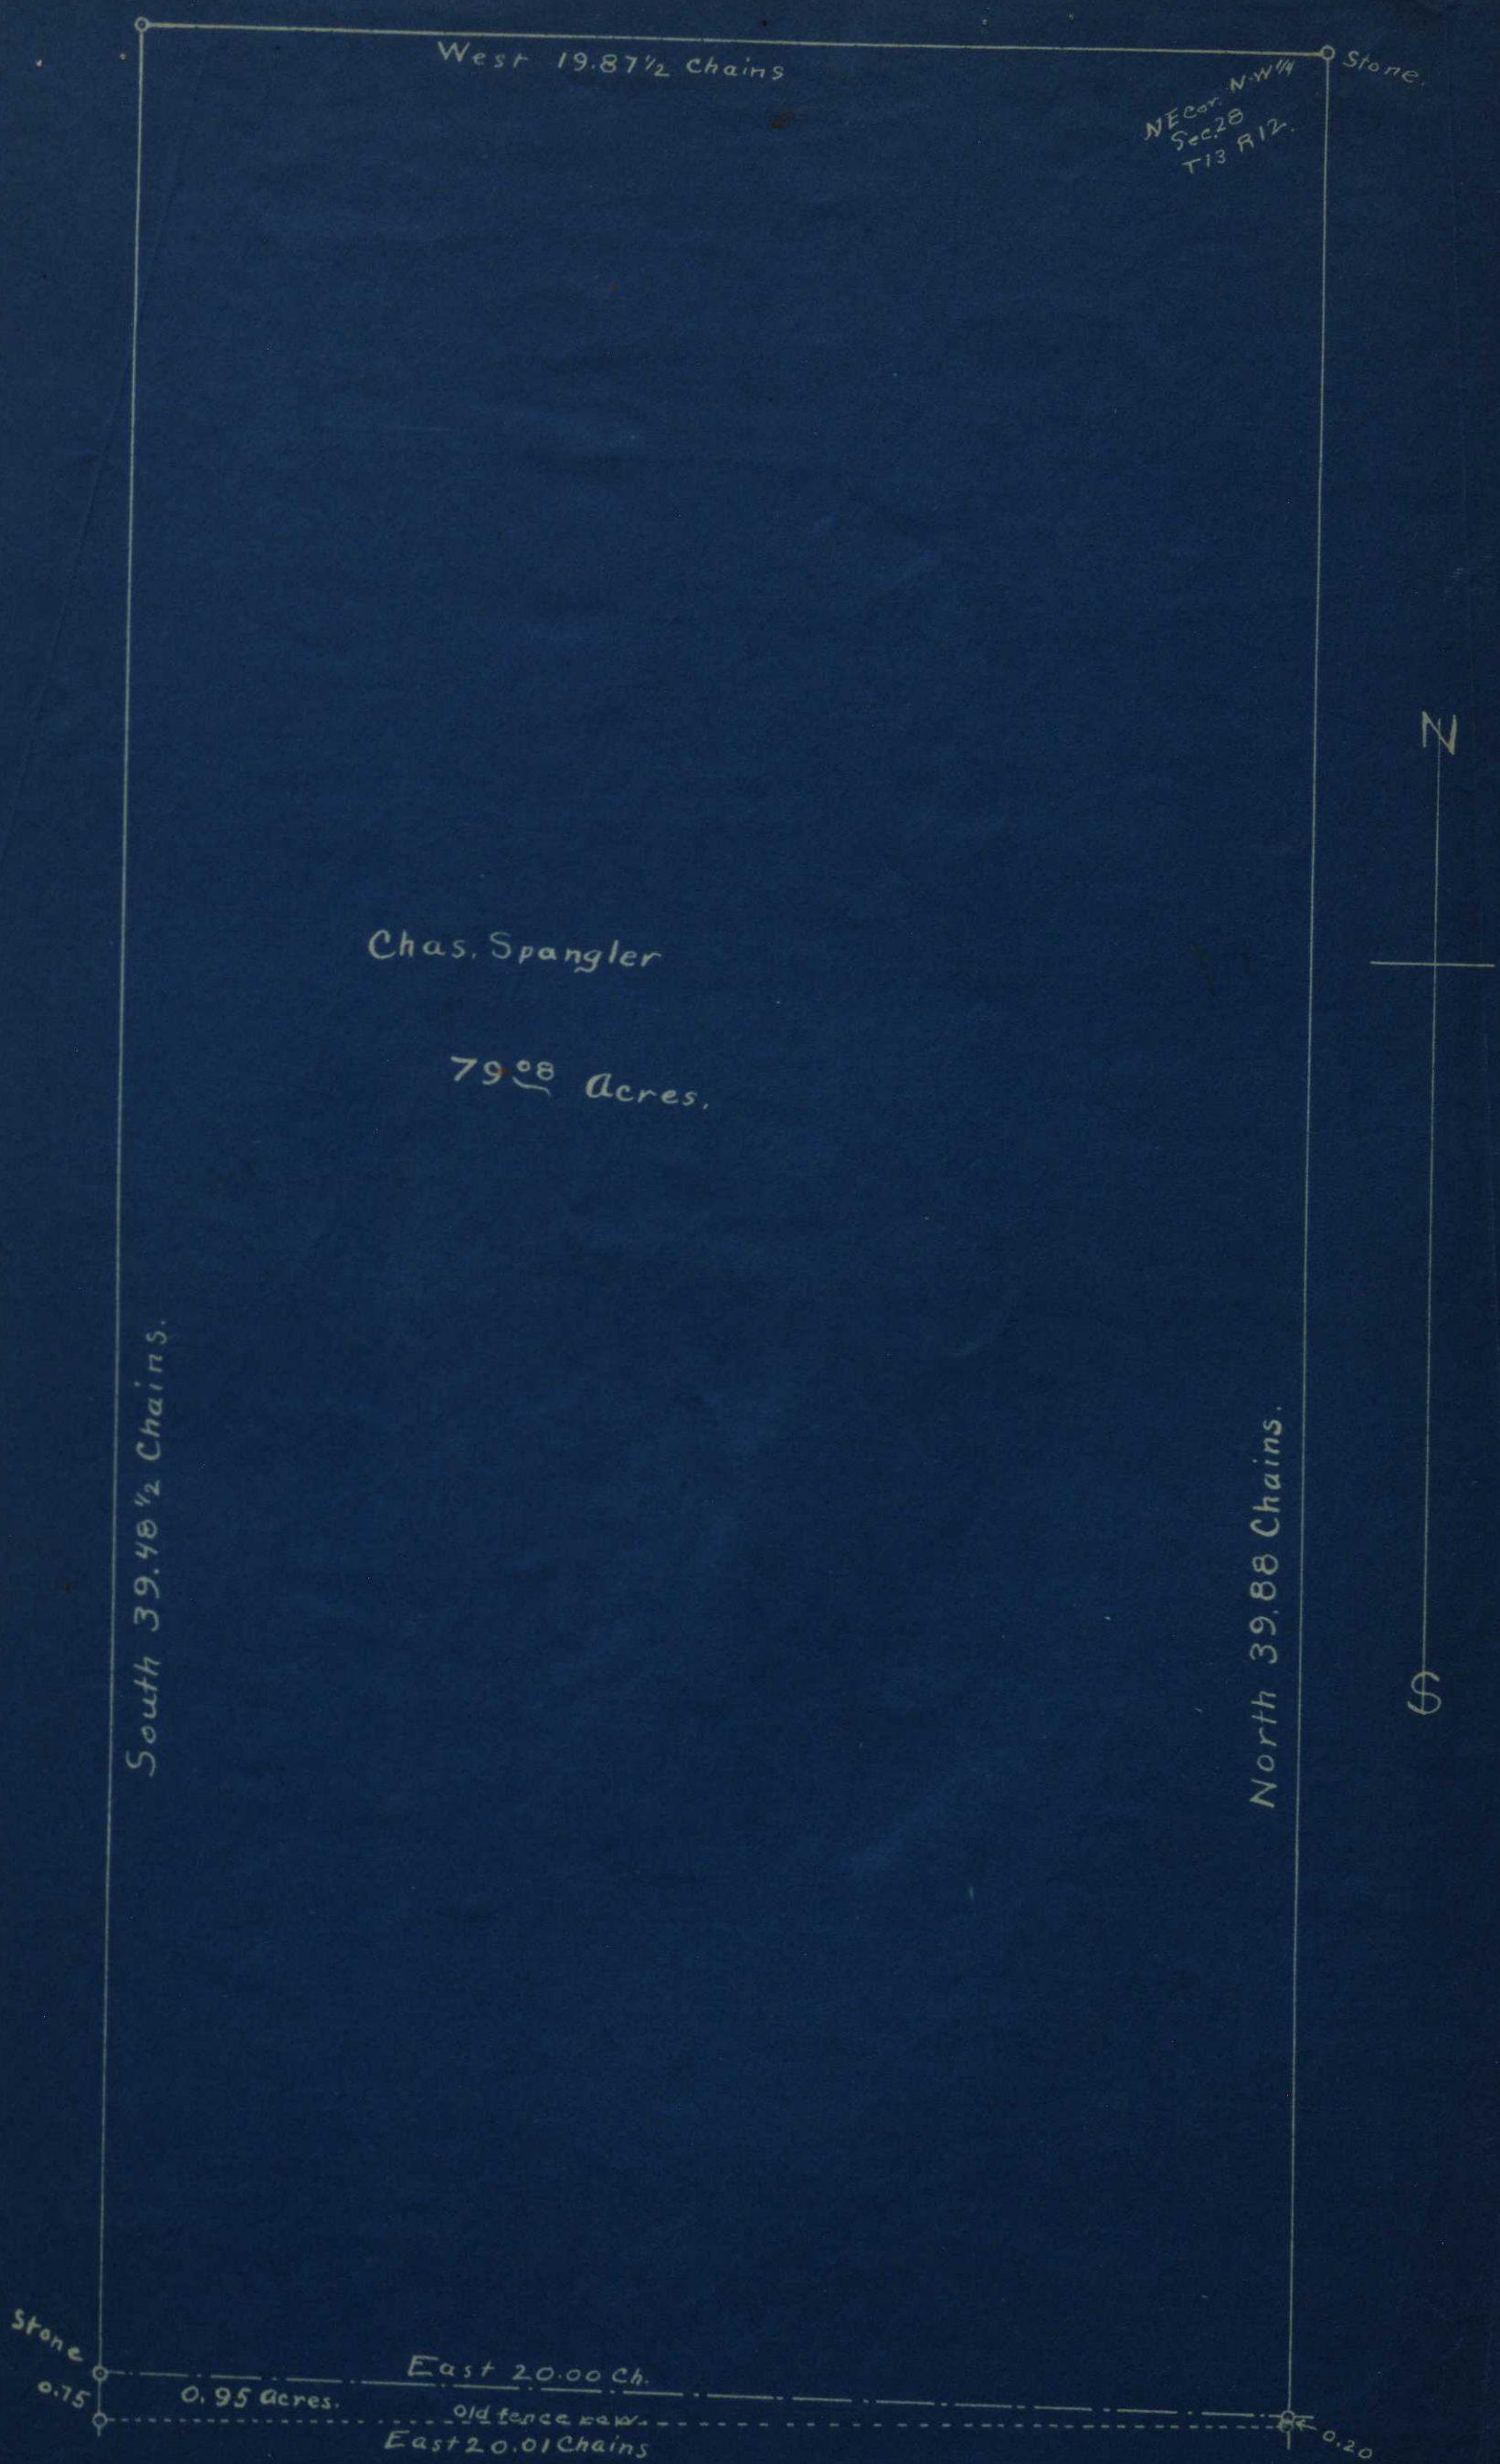

NE Cor. N.W. 1/4
Sec. 28
T13 R12.

N


S

Survey made May Ninth at the instance of Chas. Spangler, being of a certain tract of land situated in the Northwest quarter of Sec. 28 Tp. 13 and Range 12, Salt Creek Twp, Muskingum County, Ohio.

J. O. R. Fisher,
Surveyor.

1910

M. S. Conagher.

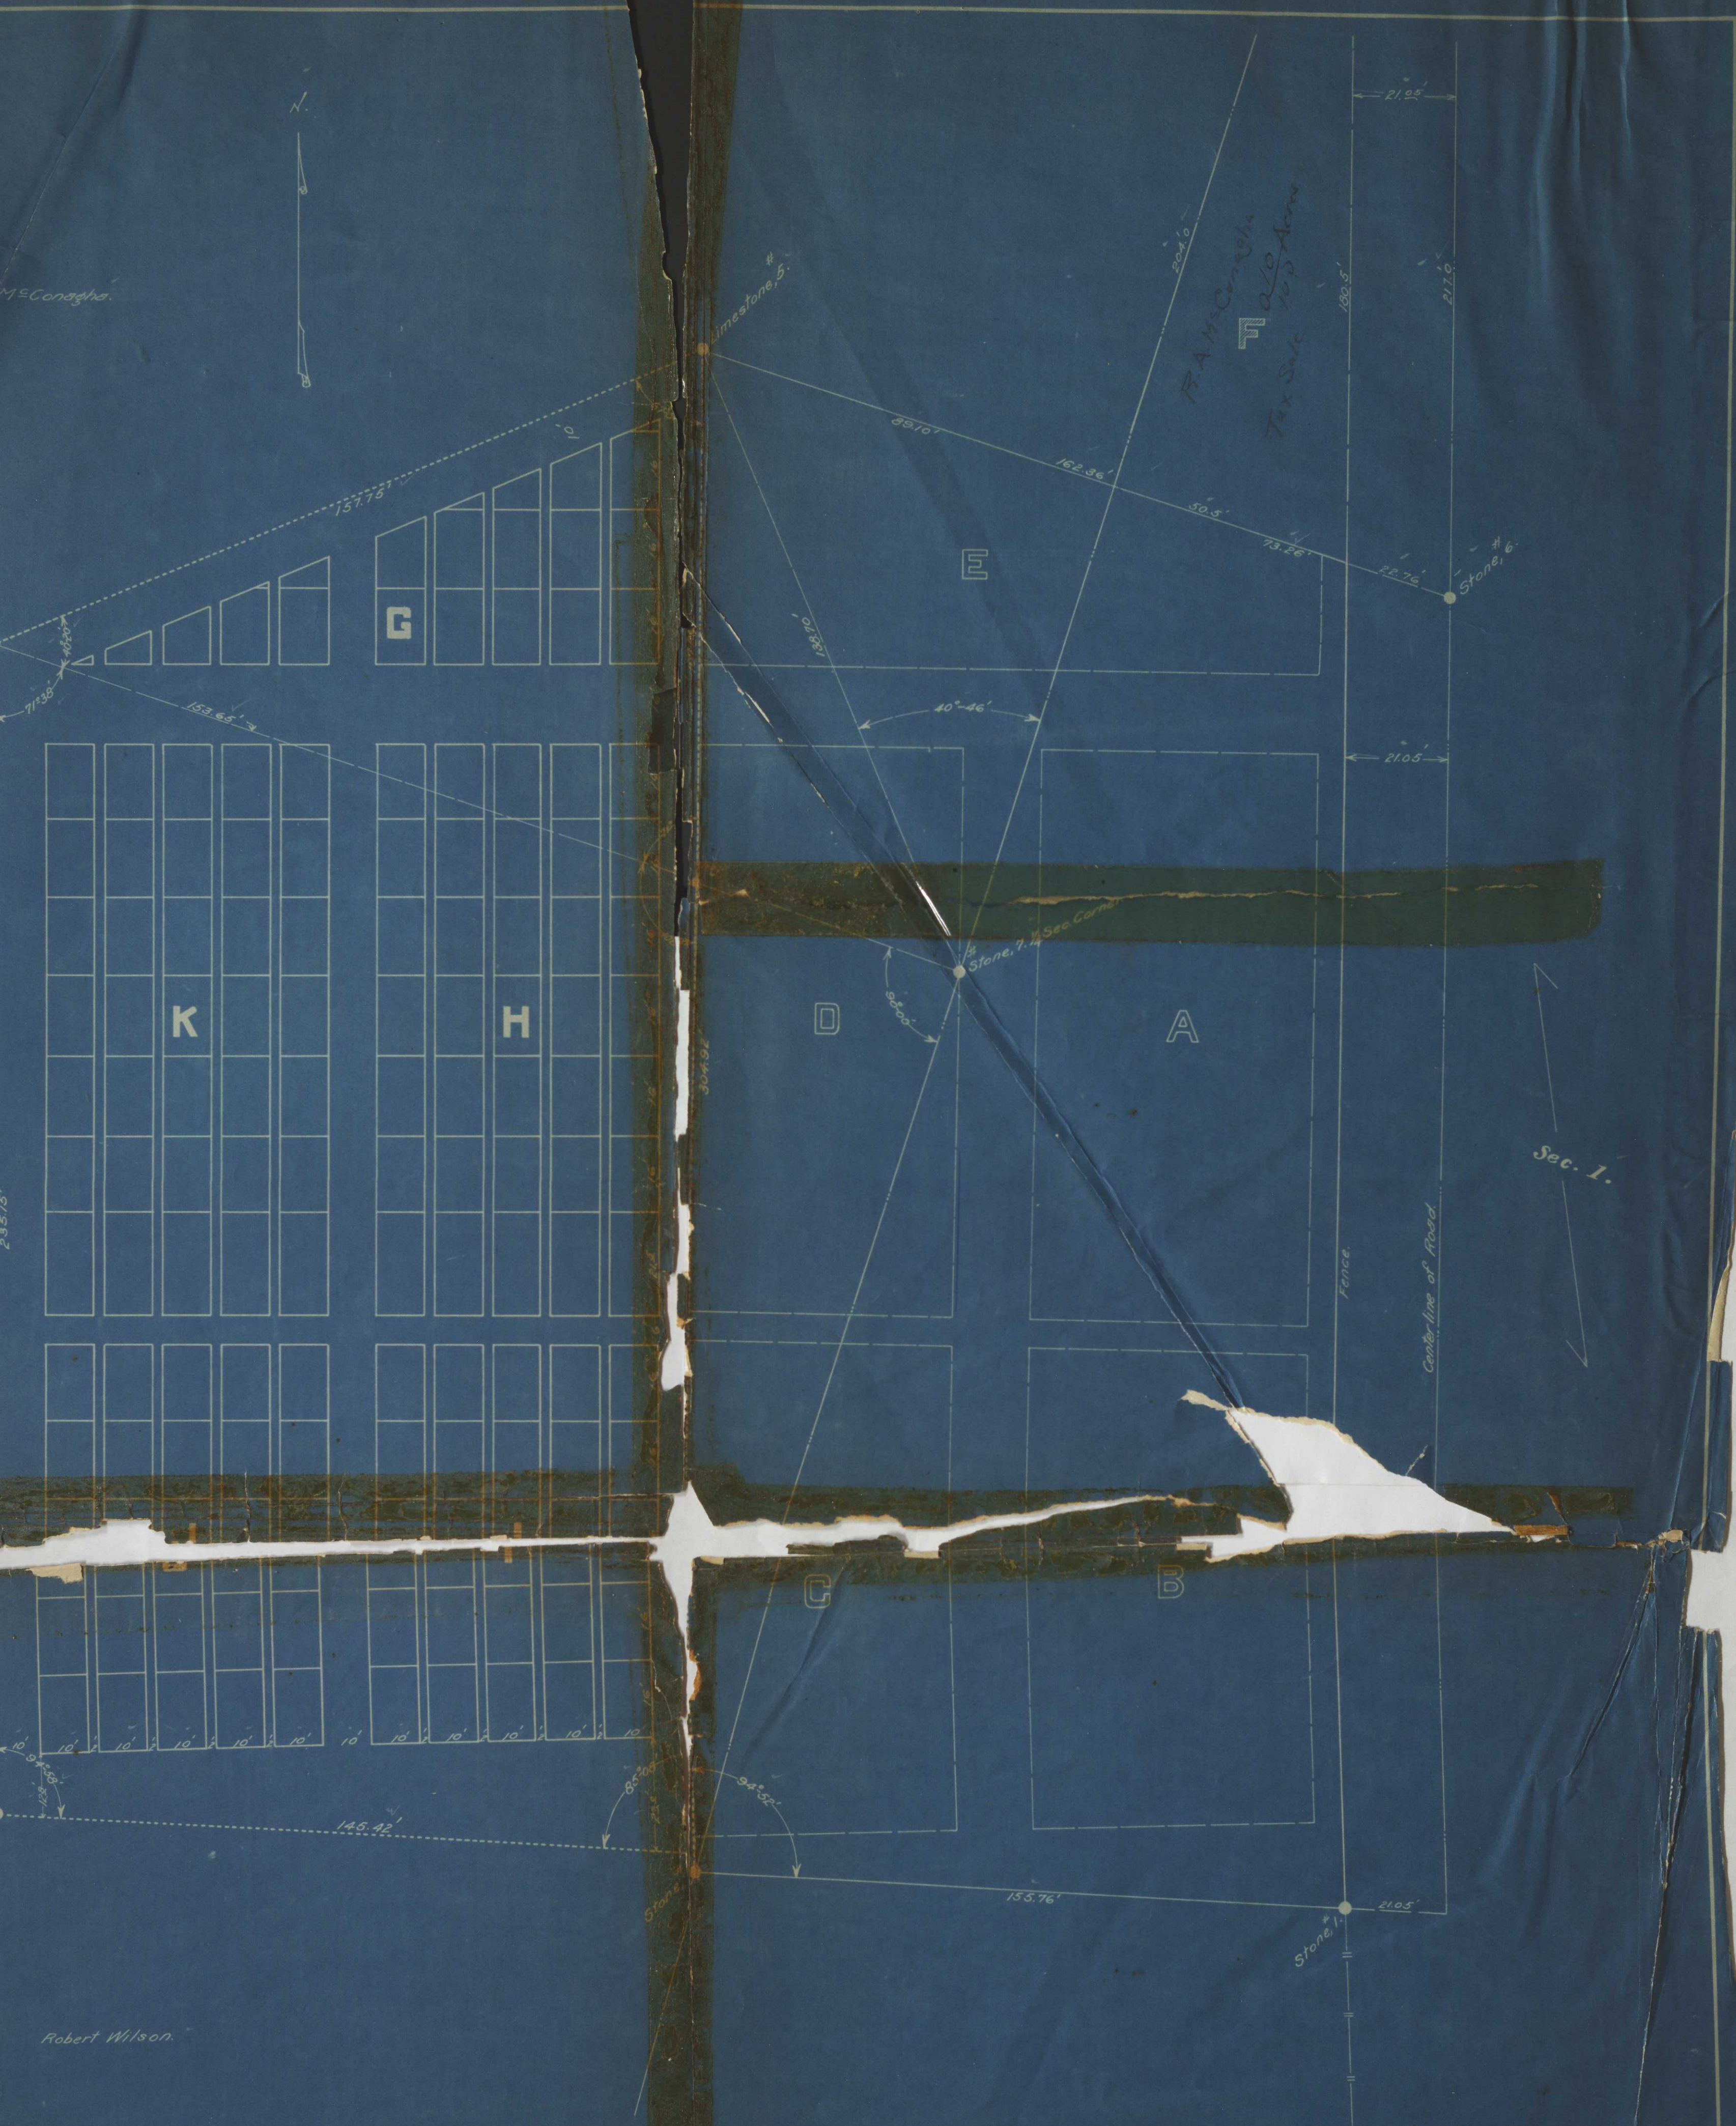

Robert Wilson.

PLAT

Showing
of Property

The Incorporation of New Concord Cemetery Ass'n.
New Concord Ohio.

CONCORD CEMETERY

MUSKINGUM COUNTY

OHIO

Scale 20 ft = 1 in



Know All Men by these presents that we
President and Secretary of the New Concord
Cemetery Association of Muskingum County in the State
of Ohio, set forth that the above Map or Plat of the New
Concord Cemetery shows the manner in which said
Cemetery is laid off into Lots, Streets, Walk and Alleys
That said Cemetery is situated in and being parts of the
N.W. 1/4 of Sec 1 and the N.E. & S.E. 1/4s of Sec. 2 of T. 1 R. 5
in the County of Muskingum & State of Ohio. In witness whereof
we have hereunto set our hands as officers of said Board of Trustees
of said Cemetery Association on this day of 1895

President
Secretary

The State of Ohio } ss.
Muskingum County }

Before me
a Notary Public in and for said County
personally came
President and Secretary of the
Board of Trustees of the New Concord Cemetery
and acknowledged the signing of the above
statement to be their voluntary act and deed
In witness whereof I have subscribed my
name and affixed my seal Notarial this
day of 1895

Notary Public

I hereby certify that the above plat of New
Concord Cemetery situated in Union Township
Muskingum County and State of Ohio. It being
parts of the N.W. & S.W. 1/4s of Sec. 1 and the N.E.
& S.E. 1/4s of Sec. 2 T. 1 R. 5 and bounded and
described as one tract as shown by the plat
The size of the Lots and width of streets and
alleys are marked on the plat in feet and
hundredths of a foot. The Sections are
designated by the letters A, B, C, D, E.
Stones were planted at the points designated
on the plat. The part in the N.W. 1/4 of Sec. 1
contains 0.375 of an acre. The S.W. 1/4 - 0.5625 of an acre.
The S.E. 1/4 of Sec. 2 contains 0.4375 of an acre and
the N.E. 1/4 - 0.4375 of an acre. Surveyed Nov. 15th 1895

J. C. Cornman C.E.
Surveyor

E


A

B

C

D

155.76'

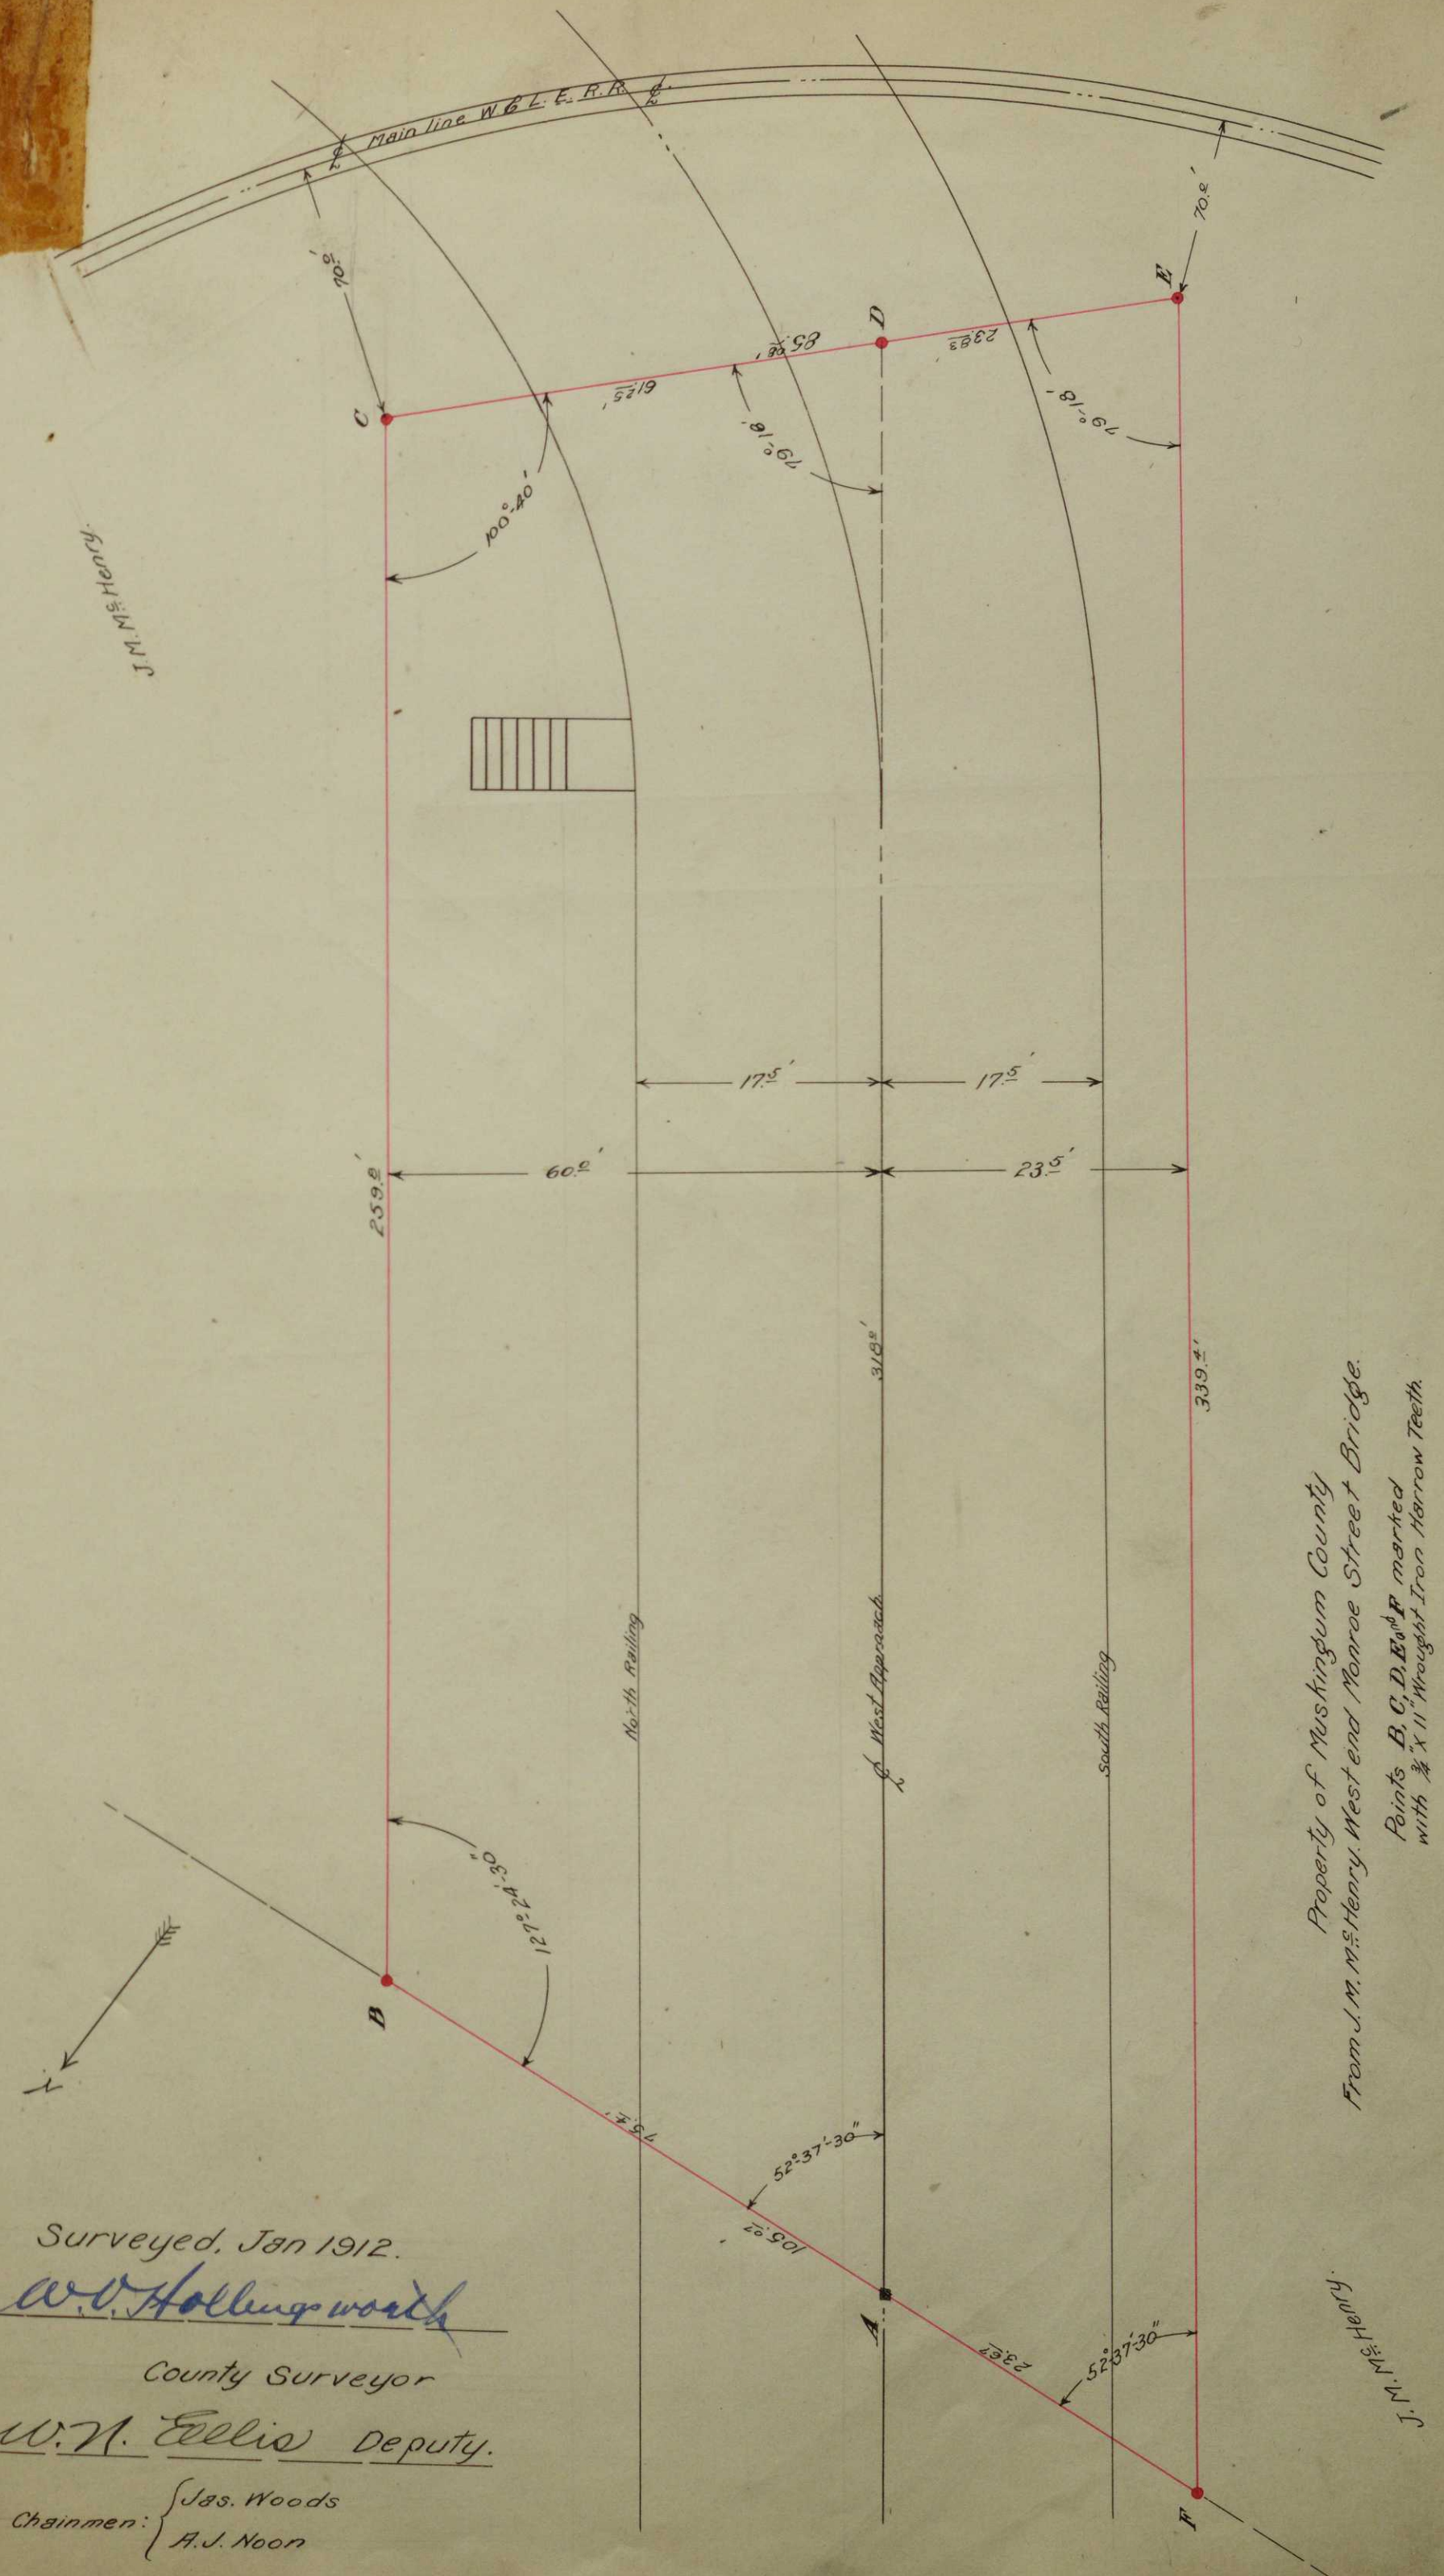

Surveyed, Jan 1912.

W. V. Hollingsworth

County Surveyor

W. H. Ellis Deputy.

Chainmen: { Jas. Woods
A. J. Noon


Property of Muskingum County
From J. M. McHenry, West end Monroe Street Bridge.

Points B, C, D, E, nd F marked
with $\frac{3}{4}$ " X 11" Wrought Iron Harrow Teeth.

Notes in book No 11, p 34-35. January 1912.

A true copy of plat made by T.C. Connor, C.E.
for J.M. McHenry Surveyed Sept 7th. 1910.

Copied by *W.O. Hollingworth*
County Surveyor

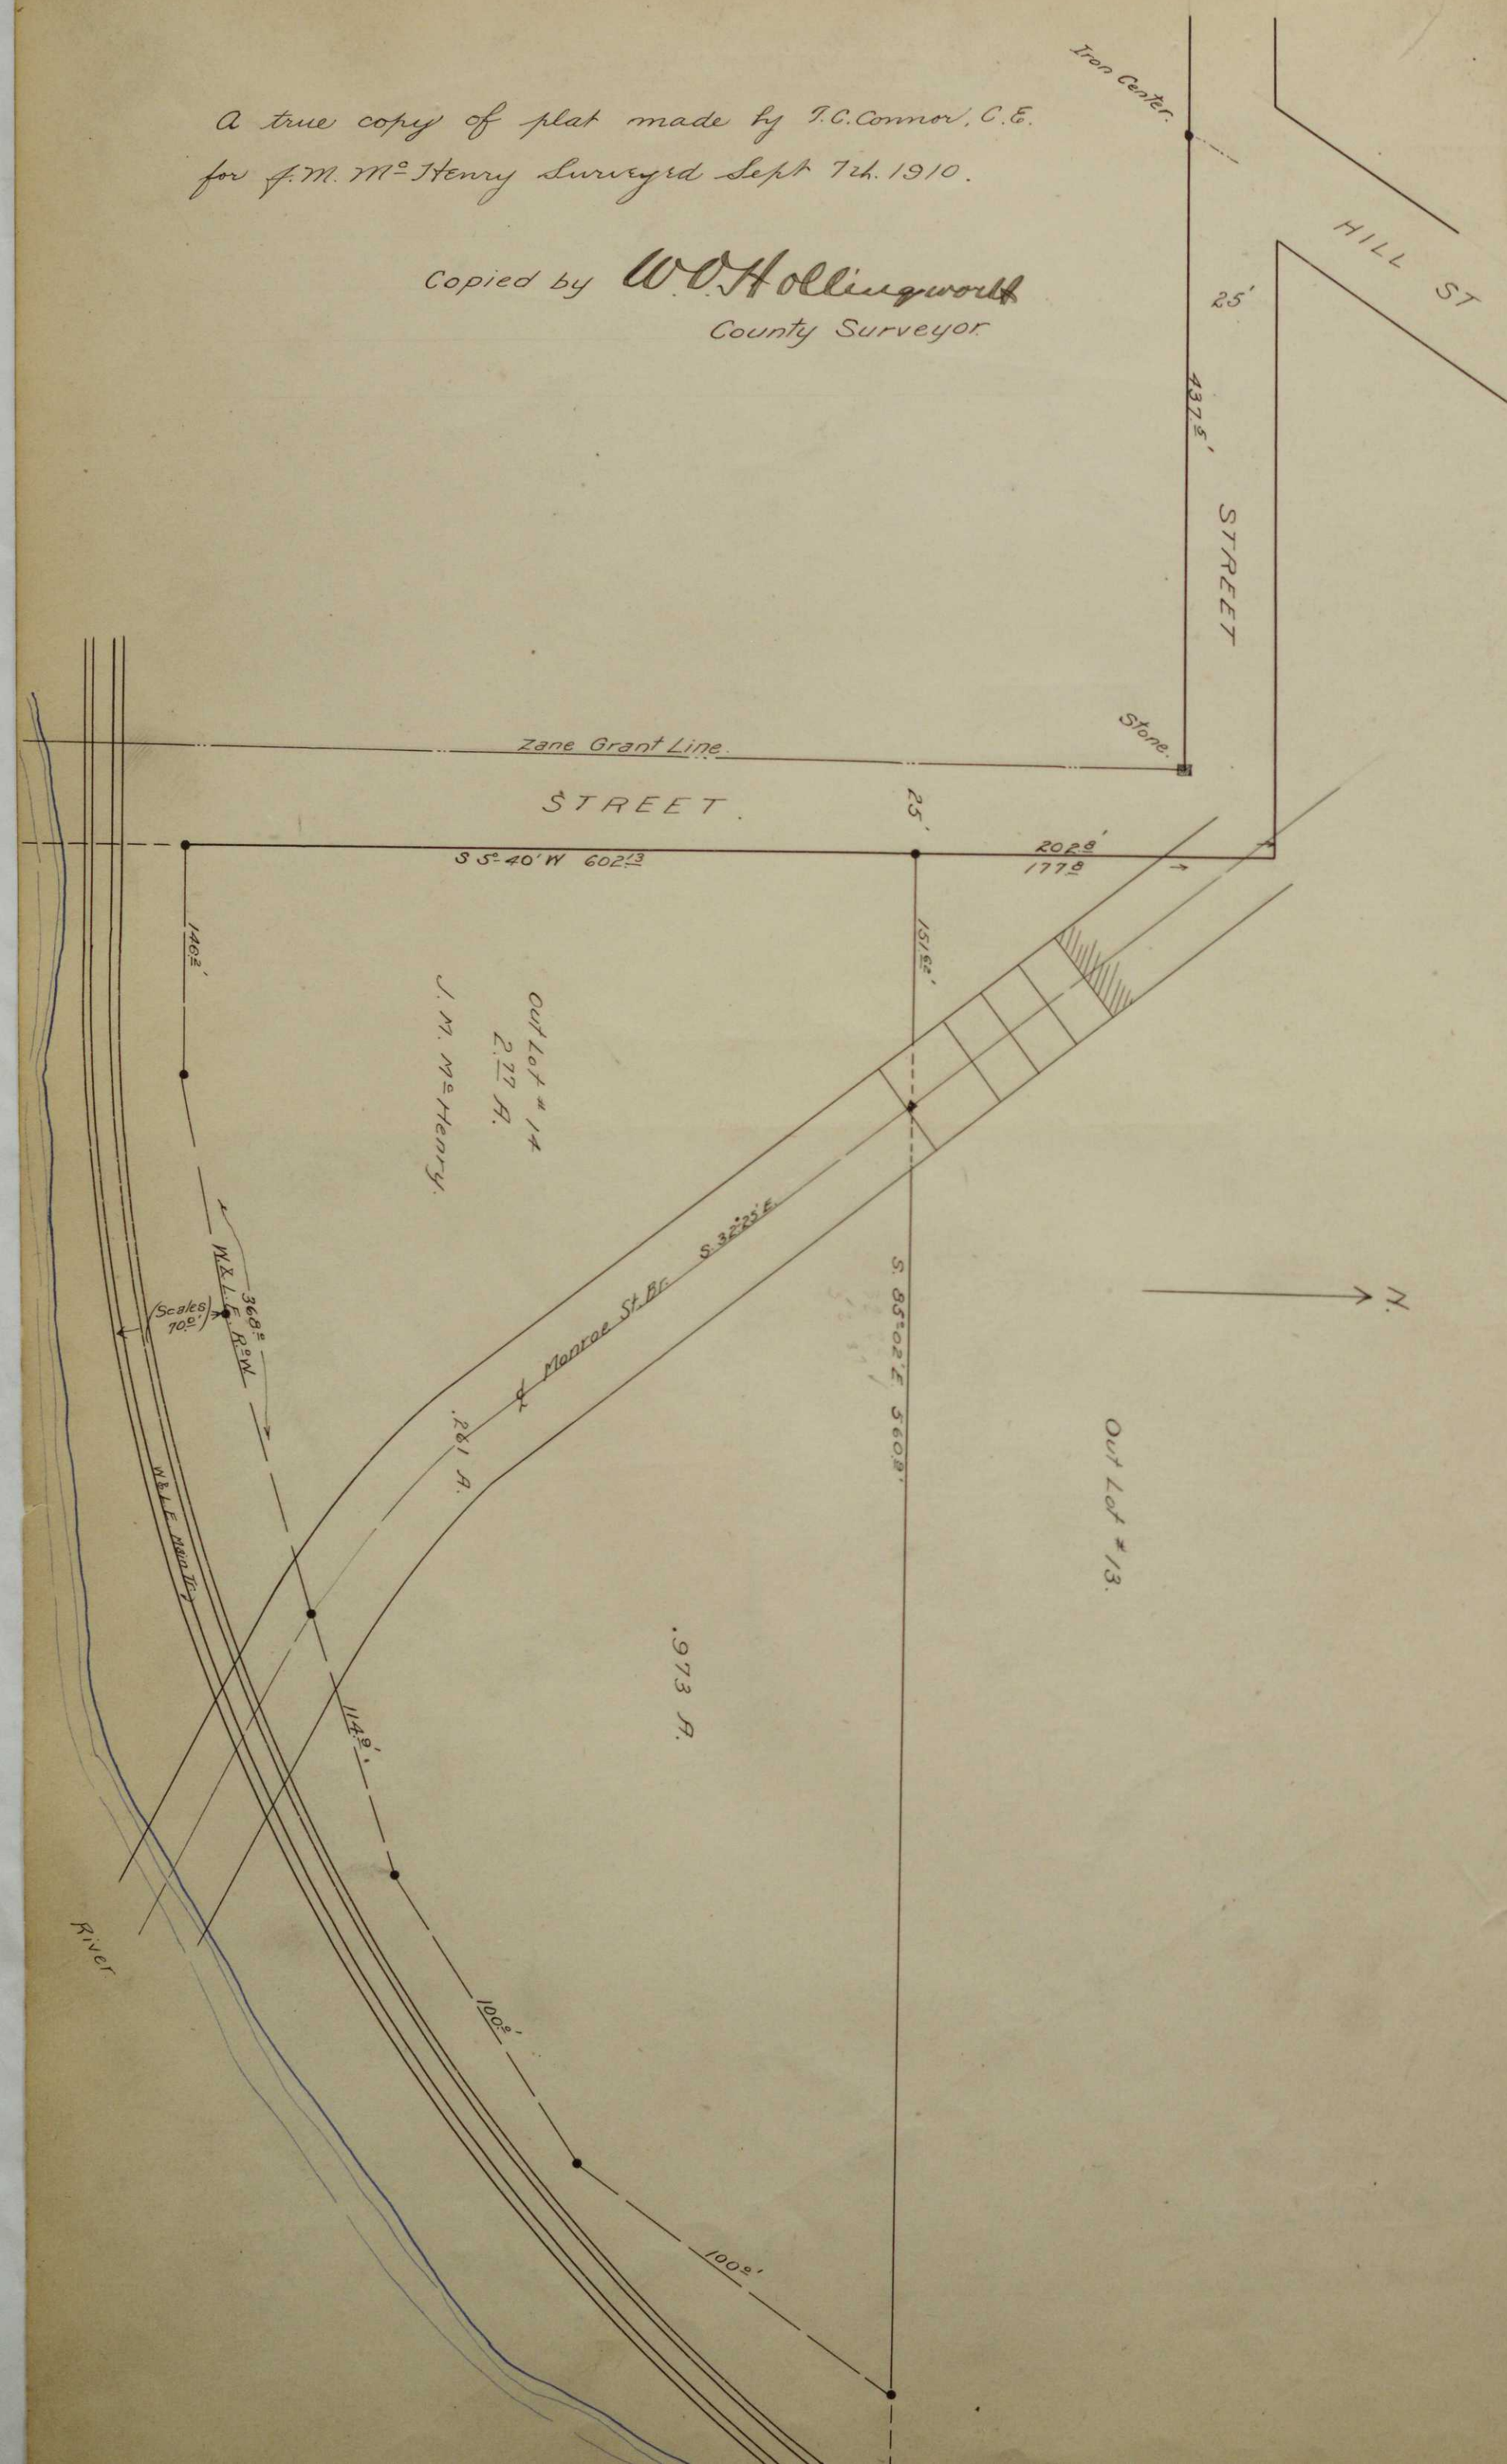

Methods used in determination of center line of Court alley on encroachment of Fifth St. Bridge

on the properties of Rosa Hiller and Frank T. Haney. January 29, 1912.

From Potters alley to Fourth St. P. S. B. Co. 126-77 ✓

Kerkers Sub. width of Fourth St. and Potters alley N 341 -

Stone at South boundary Marples River Bot. addition 16-128 and 13- 369 -


Width of Court House frontage 155-237 -

Book 1-161 gives 138 feet from Fifth St. to Court alley -

From Fourth St. to Court alley 138 feet K 602 -


Actual measurement at Jail 138 feet -

Actual measurement at Market House Surveyors Record 3 page 167 ✓

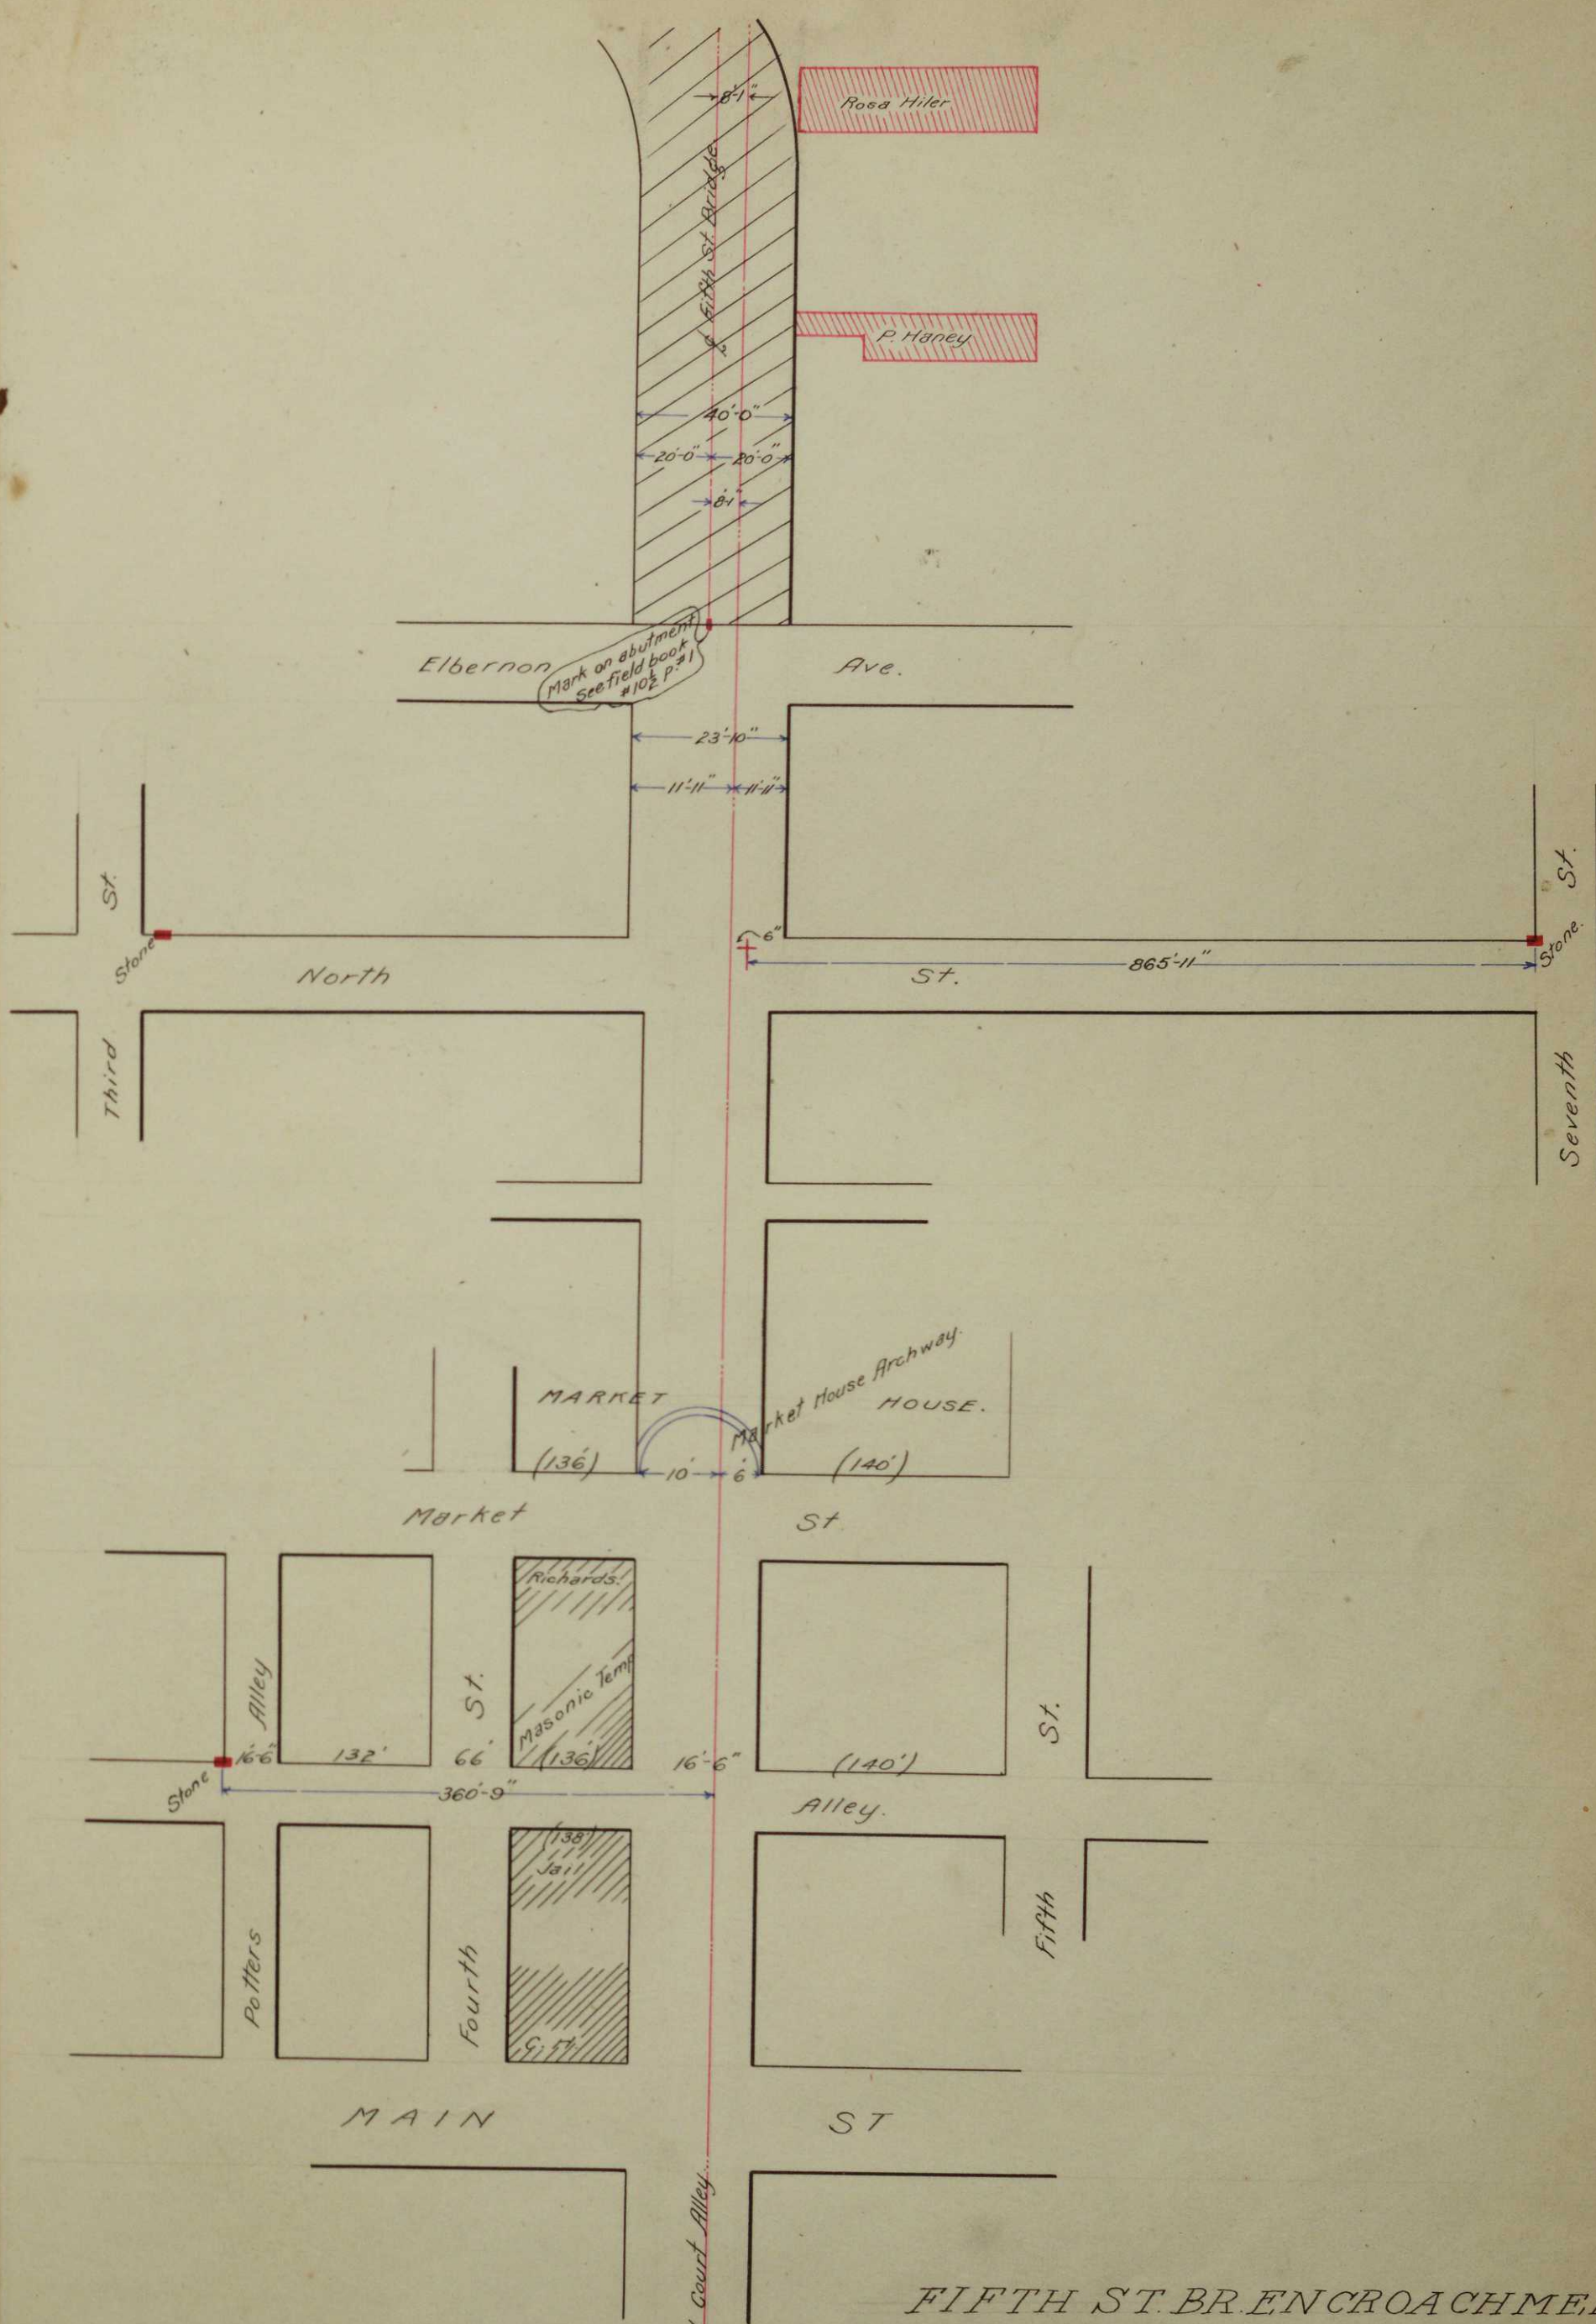


FIFTH ST. ENCROACHMENT.
Relative to the property of Rosa Hiler and
~~Frank T.~~ Patrick Haney, fronting on Fifth Street, and
backing on Court Alley; January 26th 1912.


W. H. Hough County Surveyor, *W. H. Ellis* Deputy.
Assistants, *J. T. Woods*, *A. J. Noon*.

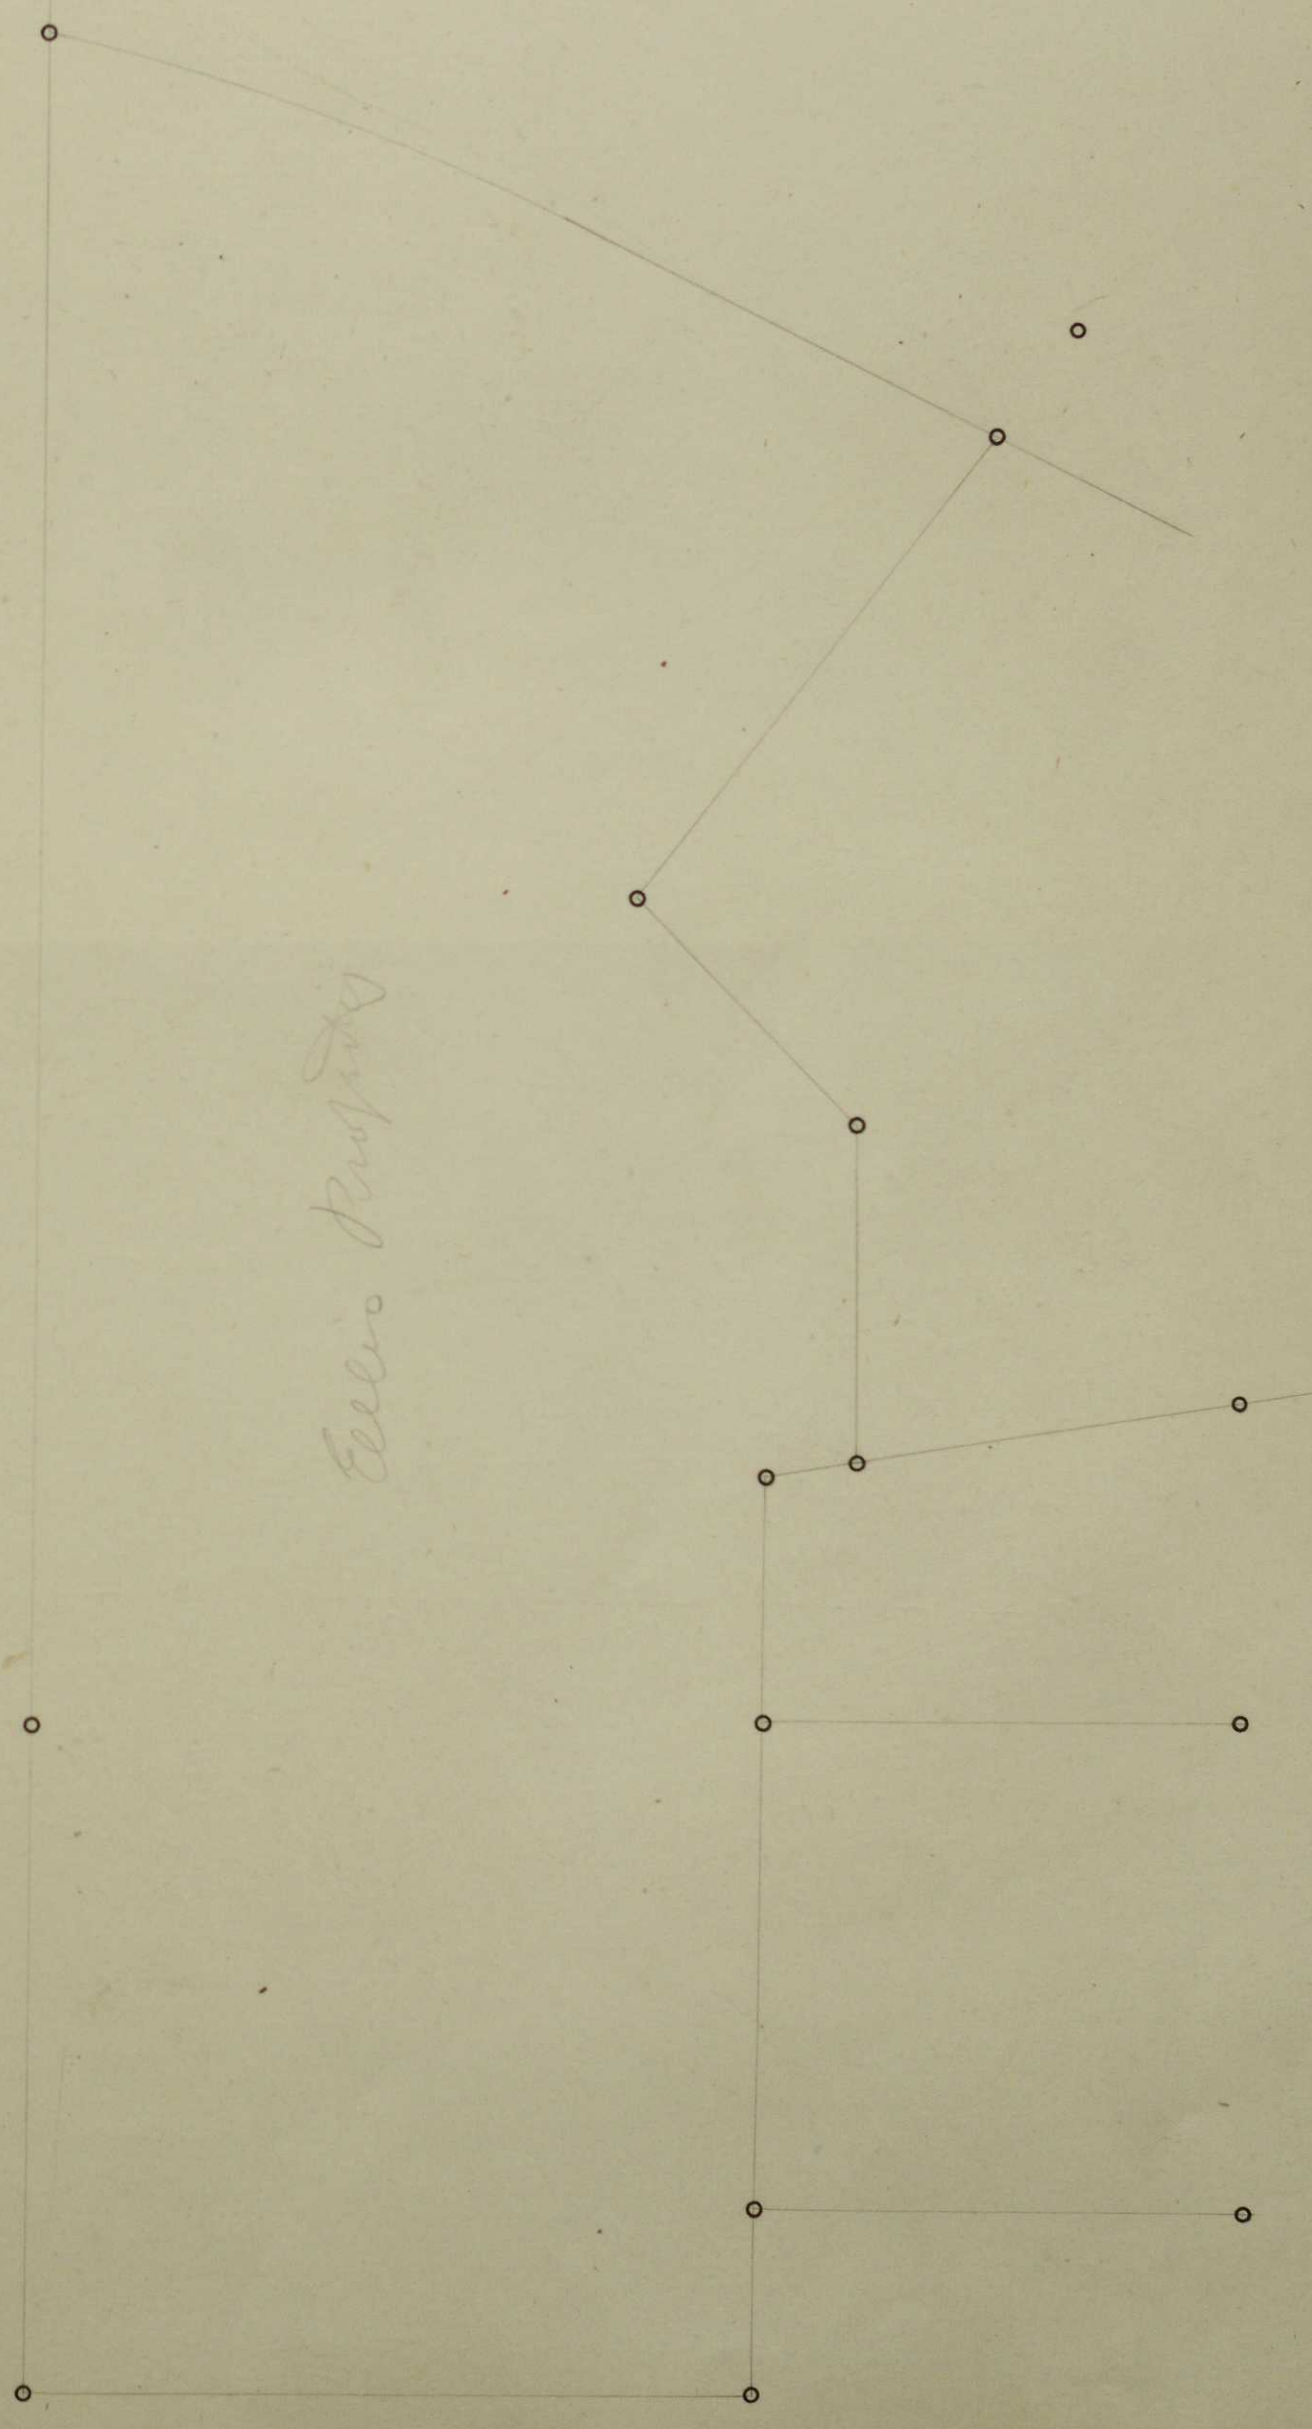

Exterior Perspective

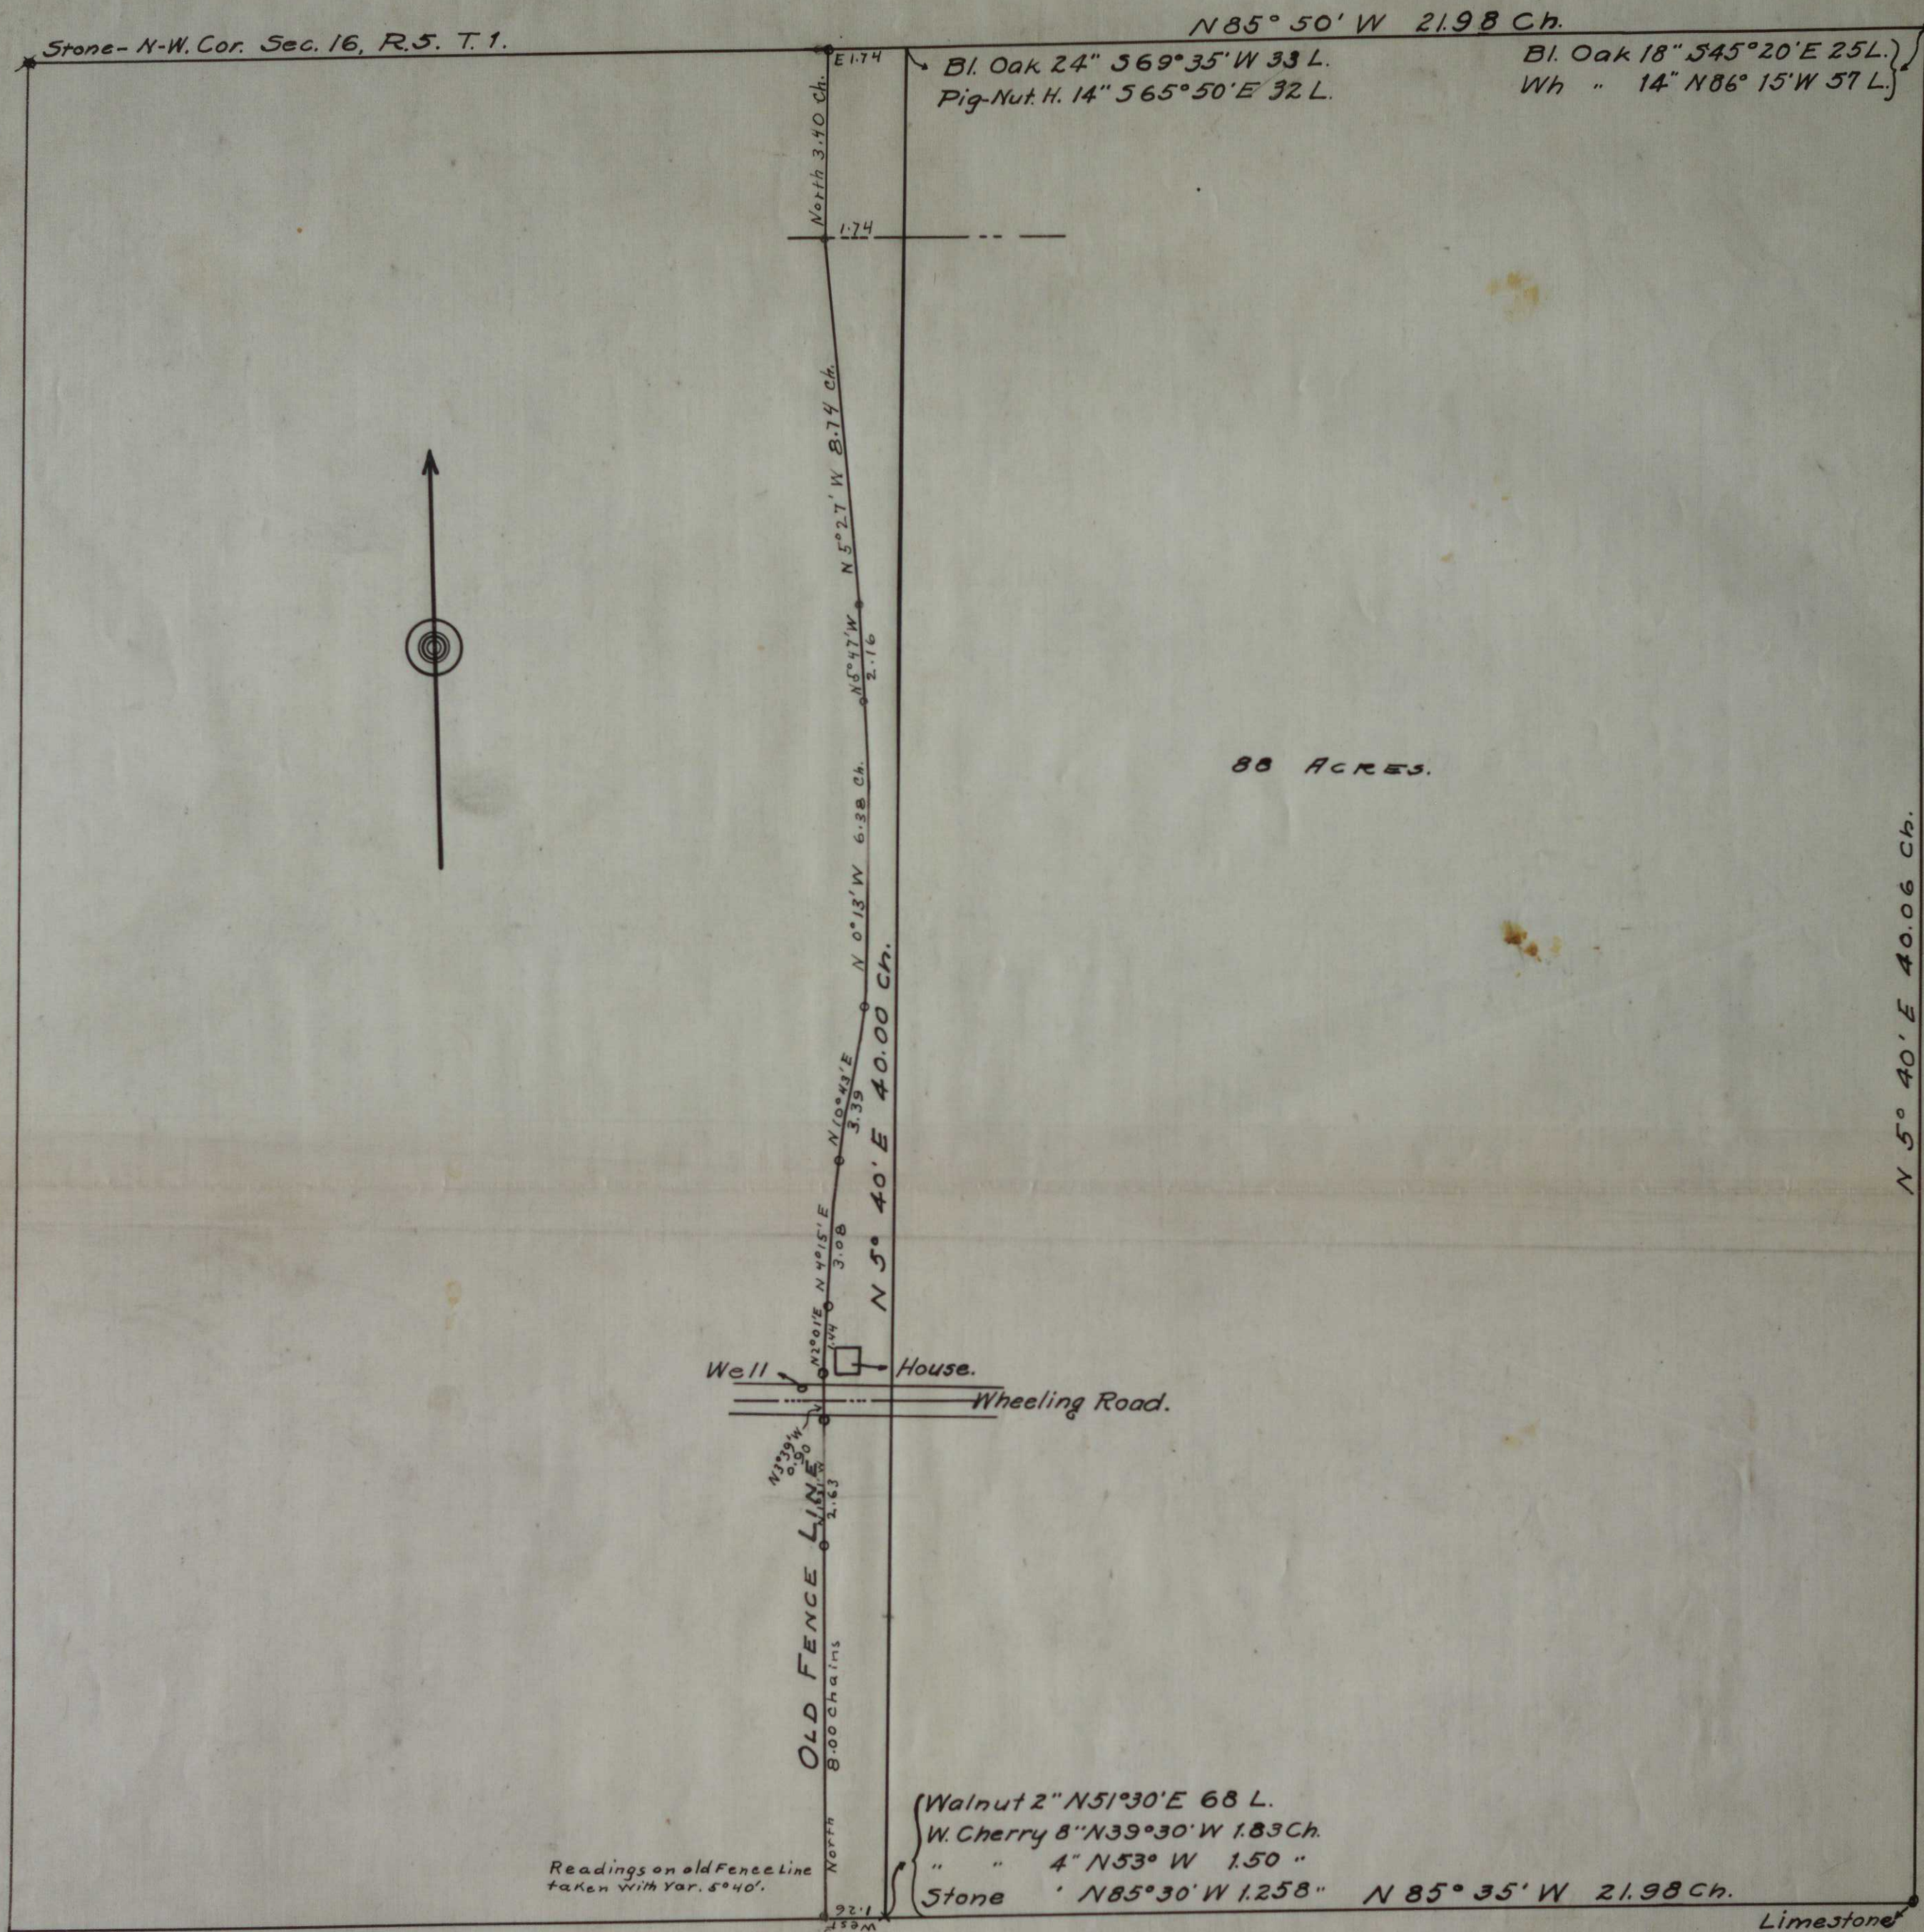


PLAT
OF
SURVEY OF 88A.
OF
THE THOS. TAYLOR FARM
UNION TOWNSHIP
SURVEYED
SEPT. 30 & OCT. 5 '09.
By *J. H. H. H.*
SURVEYOR
MUSKINGUM Co.

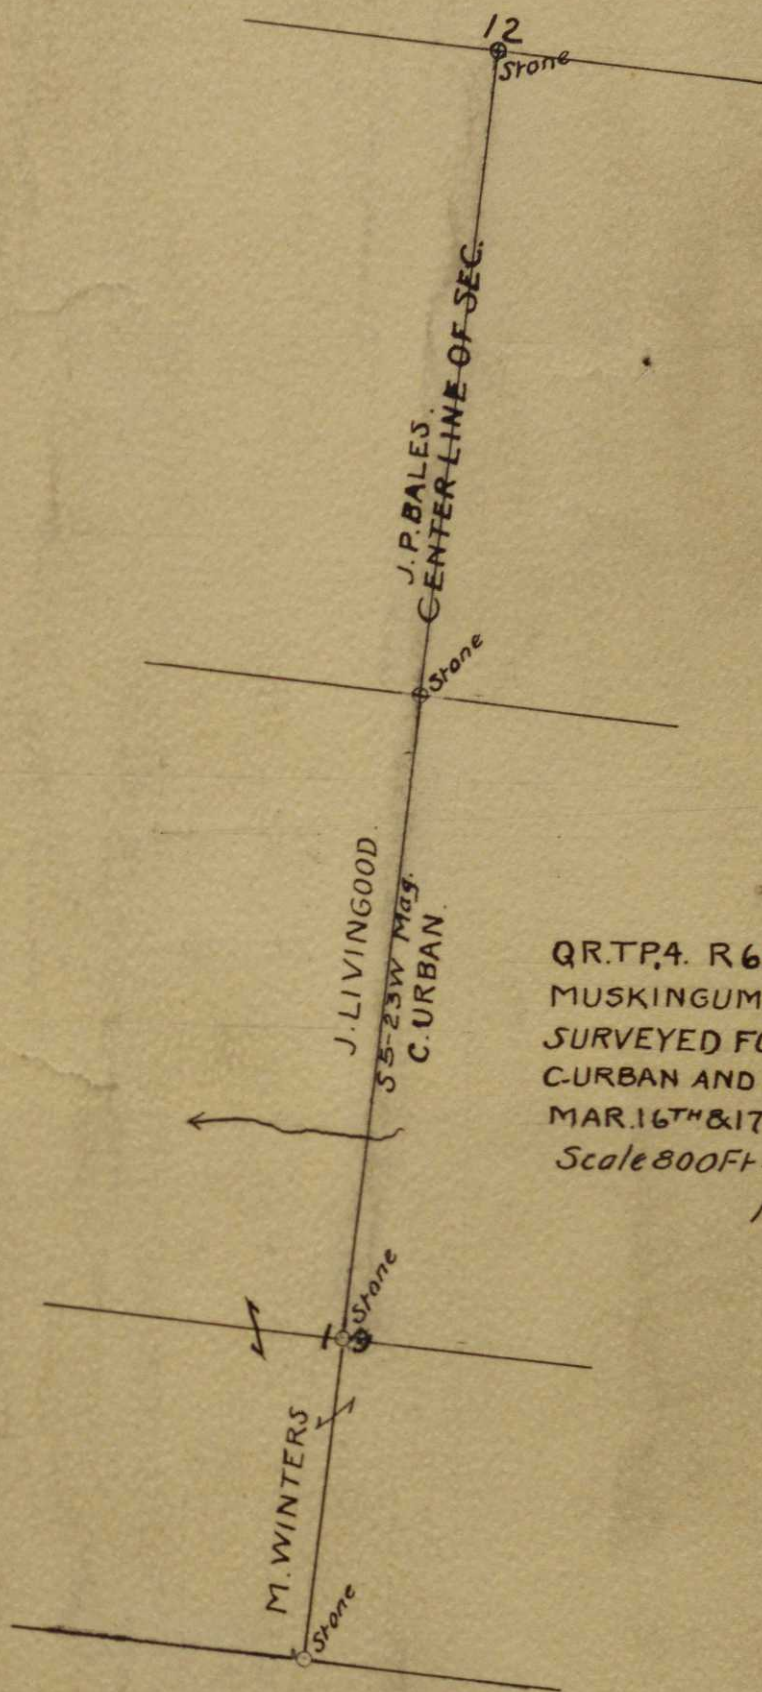

QR. TP. 4. R. 6. T. P. 1. PERRY TP.
 MUSKINGUM COUNTY OHIO.
 SURVEYED FOR J. LIVINGOOD
 C. URBAN AND M. WINTERS.
 MAR. 16TH & 17TH 1922.
 Scale 800 Ft = 1 In.


H. L. Connor
 Dept County Surveyor.

VILLAGE OF PHILO
MUSKINGUM COUNTY
SCALE 1"=20' DEC. 1929
SURVEYED BY H.L. CONNAR
DEP. CO. SURVEYOR

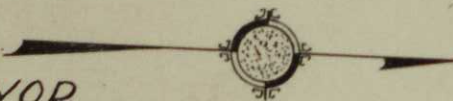

Musk. Co. Surveyor

H.L. Connor.
Deputy Co. Surveyor, Musk. Co

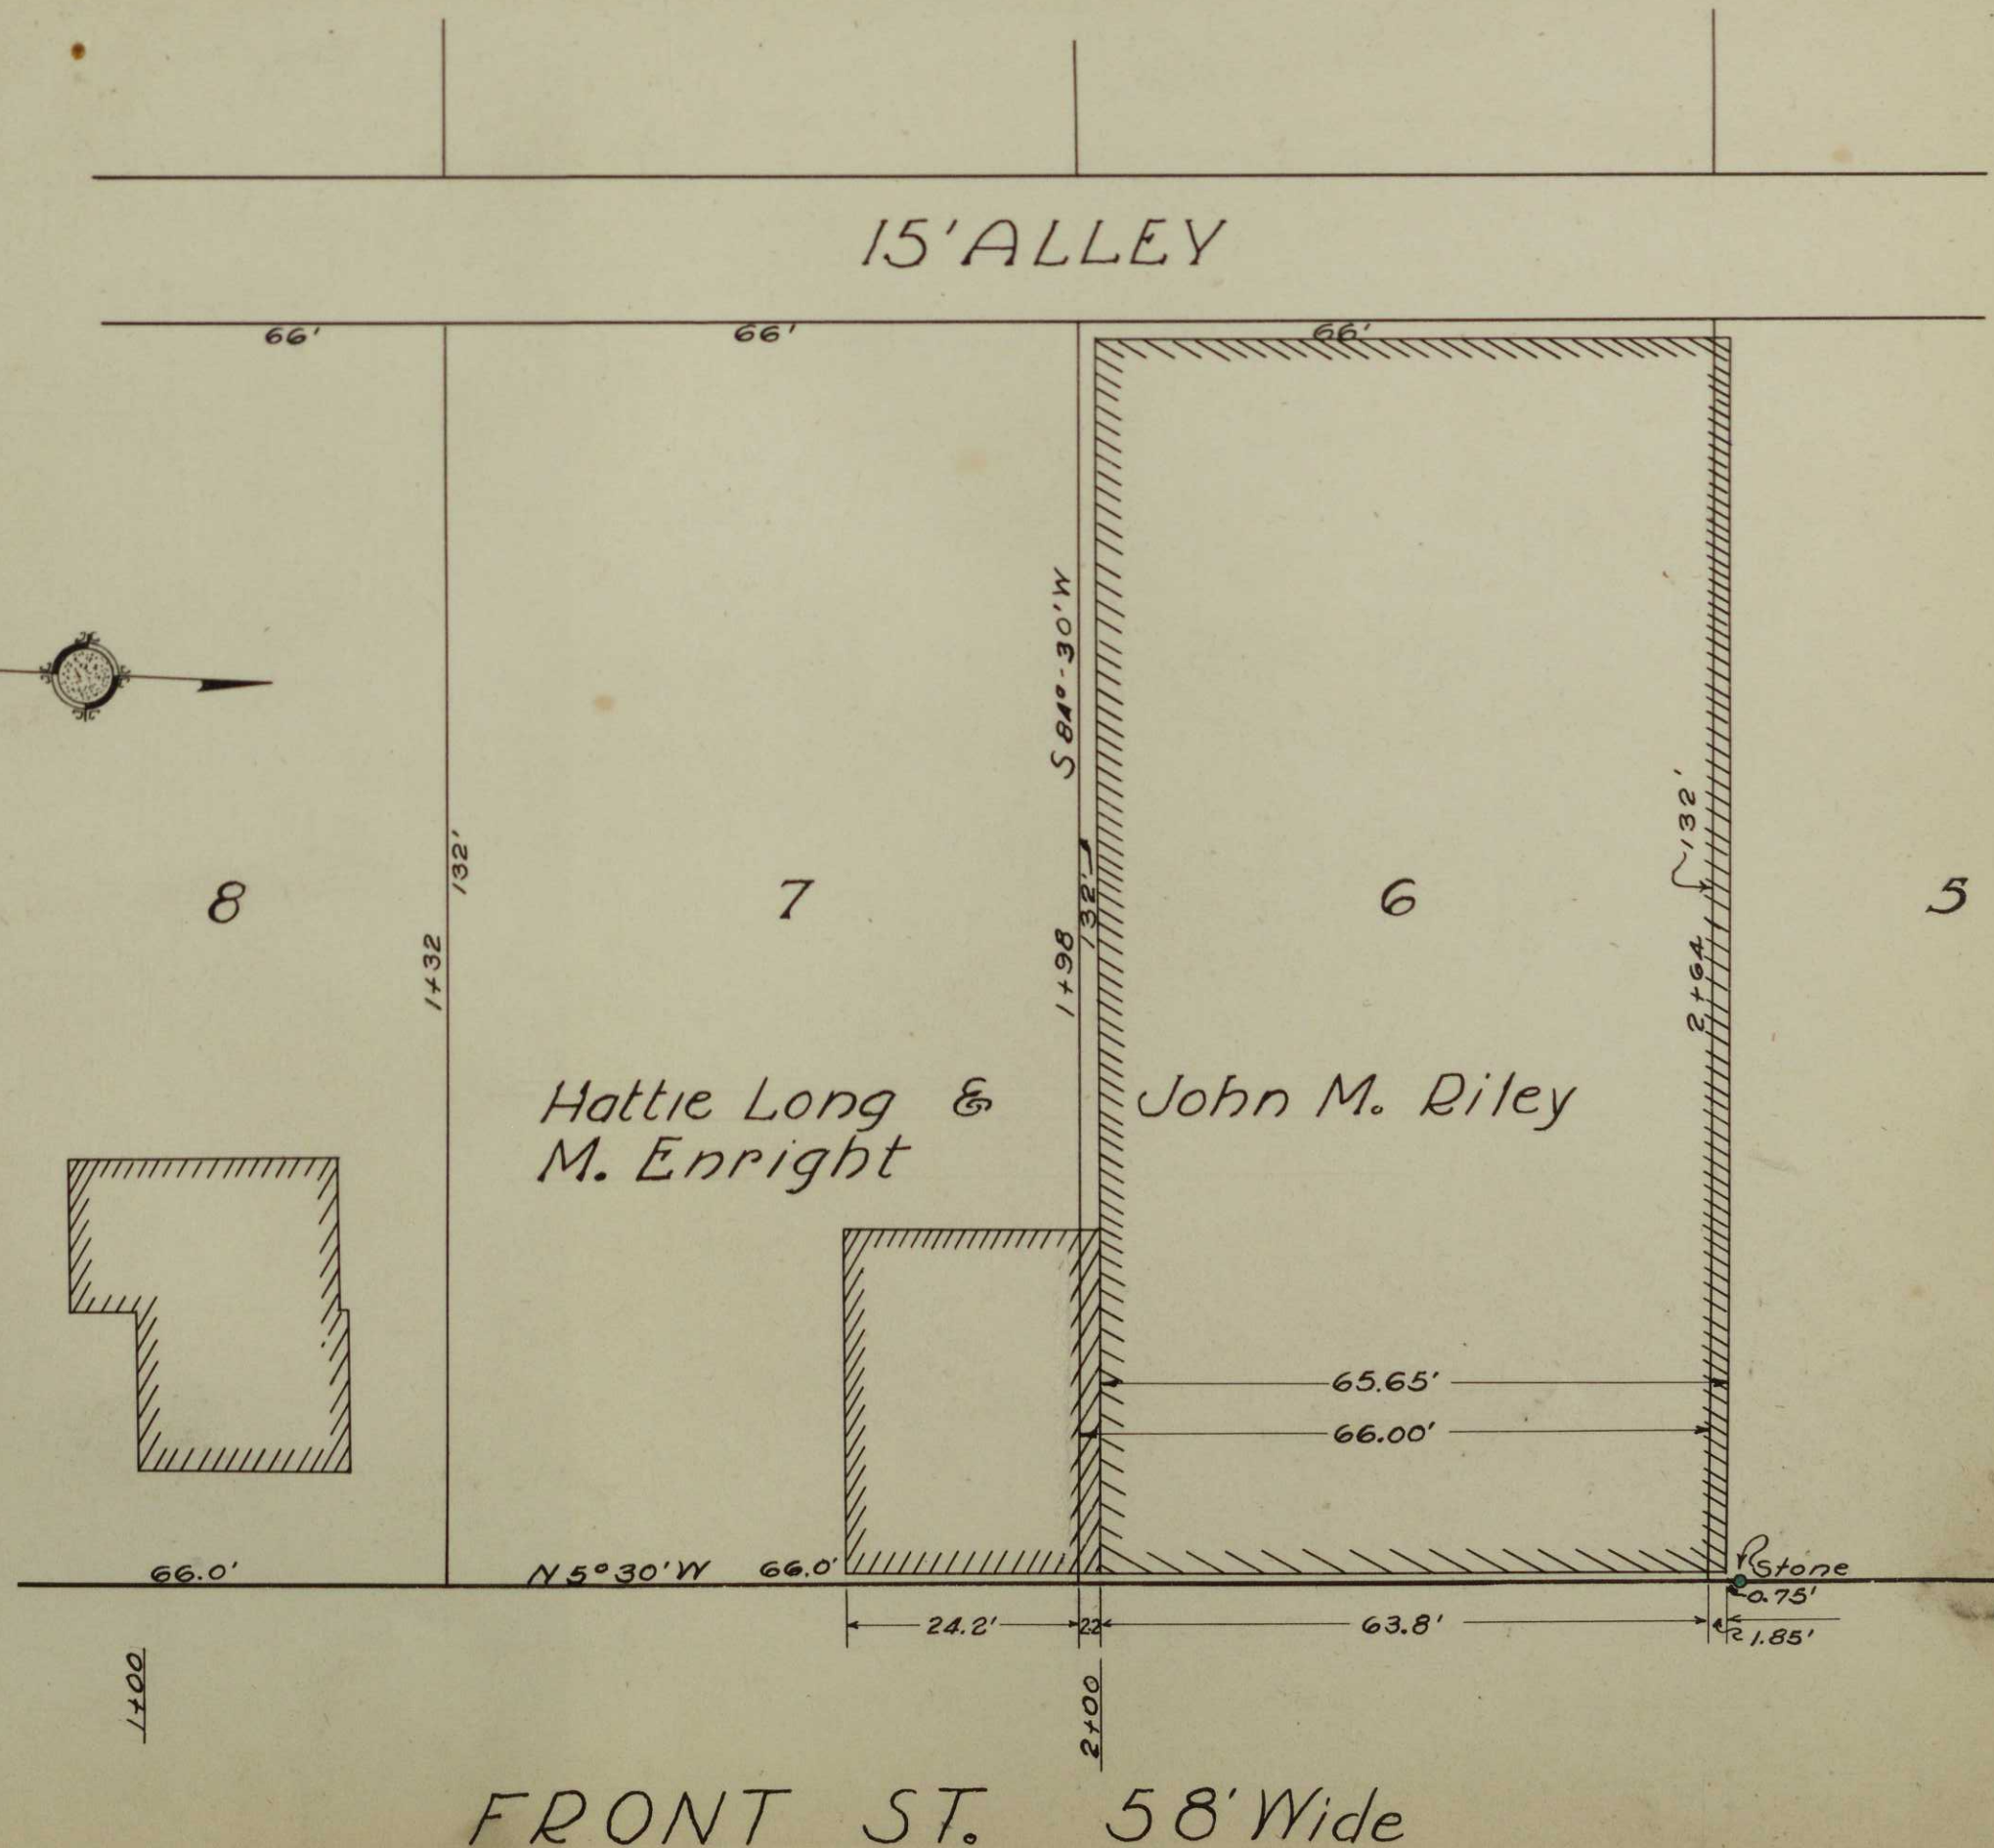

FRONT ST. 58' Wide

INDEX

W O N T O E
T. 3. R. 5.

P E R R Y
T. 1. R. 6.

Gr. Tp	Sec	Lot	Or	out Lot	for Whom Surveyed	Date	Page	Gr. Tp	Sec	Lot	Or	out-Lot	for Whom Surveyed	Date	Page
3rd					M E Crane	1887	109	2	6		S.W.		John C Hoain	1886	15
								3rd					M E Crane	1891	109
											SW 1/4		Eliza Wynn deane	1891	107

INDEX

SALEM

T 2

R 6

ADAMS

T 3

R 6

Gr	Tr	Sec	Lot	Gr	out Lot	For whom	Surveyed	Date	Page	Gr	Tr	Sec	Lot	Gr	out Lot	For whom	Surveyed	Date	Page
										3		17		6 1/2		North Wincanier	1887	20	

[illegible]

INDEX

MADISON

T 2 . R 7

T 3 . R 7

Qr.	Tp.	Sec	Lot	Qr.	out Lot	For Whom Surveyed	Date	Page	Qr.	Tp.	Sec	Lot	Qr.	out Lot	For Whom Surveyed	Date	Page
3				SW cor		John Crattree Estate	1887	23									
3				"		Nathan Kelly "	"	23									

T 3 . R 8

INDEX

FALLS

T I. R VIII

T I. R VIII.

Qr	Tp	Sec	Lot	Qr	out Lot	For whom Surveyed	Date	Page	Qr	Tp	Sec	Lot	Qr	out Lot	For whom Surveyed	Date	Page
2.			2			Elyah Ray	1886	2	1			9	SW		Peter Goaver	1886	6
1			1	N 8		James Malwerk	1887	26	2						Widow. Dower. Peter Fisher	1887	16
1		Section 1+2+3				New County Road	1889	49	3+4						Dillon Falls mill property	1891	123

INDEX

MUSKINGUM

T II . R VII. T II . R VIII.

Gr.	Tp.	Sec	Lot	Gr	out Lot	For whom Surveyed.	Date	Page.	Gr.	Tp.	Sec	Lot	Gr	out Lot	For whom Surveyed	Date	Page
3rd						A S Miller	1891	107	2		5		NW		John Spencer.	1889 Sep 12	59.
									2		5		SW		" "	" "	"
									4		11		SE		Owen Vandenburg	1890 Sep 30	103
									1			10			" "	"	103

INDEX

CASS ^{and} JEFFERSON
T III R VII T III R V III

Ar. Tr.	Sec	Lot	Ar	^{out} Lot	For whom Surveyed	Date	Page	Ar. Tr.	Sec	Lot	Ar	^{out} Lot	For whom Surveyed	Date	Page
	^{between} 15+20				new county Road	1889	50	3		⁹ 19			J. H. McCann	1886	13
2	4+5				Simkins Morton	1880	101			47			Robt + Frank Lemert	1889	31

R XV

[illegible]

INDEX

MEIGS
T XII . R XI.

RICH HILL
T XIII . R XI.

Gr.	Tp.	Sec	Lot	Gr	out Lot	For whom Surveyed	Date	Page	Gr	Tp.	Sec	Lot	Gr	out Lot	For whom Surveyed	Date	Page
2	4			SE		Thomas Mintier	1886	5	2	4			SE		Thomas Mintier	1886	5
									11	27			NE		James Lyon to H.B. Hickman	1887	18
									2	16			S.W		V. S. Elliott to J. Roy.	1887	24
									35				SE		Petty & White		149
									36				SW		" . . .	1908	149

BLUE ROCK
T XII R XII

SALT CREEK
T X III R XII

[illegible]

INDEX

HARRISON

T XII . R XII . T XI . R XIII .

Dr.	To	Sec	Lot	Dr	out Lot	For Whom Surveyed	Date	Page	Dr.	To	Sec	Lot	Dr	out Lot	For Whom Surveyed	Date	Page
2		4+5 84.9				Howard Proctor (Adm)	1886	7									
						Eng. Office	1894										

T X R XIII

T XIII R XII

INDEX

BRUSH CREEK

T X . R XIII.

T XI . R XIII.

Ar.	Tp.	Sec.	Lot.	Ar.	out Lot.	For whom Surveyed.	Date	Page.	Ar.	Tp.	Sec.	Lot.	Ar.	out Lot.	For whom Surveyed.	Date	Page.
2		17		NW.		Balser Veiterick	1886	1	1		12		NE		Valentine Eschman & D Hoch	1887	19
											7				Sam Buchanan		128

INDEX

WAYNE

T XI

R XIII

T XII

R XIII

Ar	Tp	Sec	Lot	Ar	out Lot	For Whom Surveyed	Date	Page	Ar	Tp	Sec	Lot	Ar	out Lot	For Whom Surveyed	Date	Page
									2	8		SE			Saml W Ginner + NW corner	1887	21
															Downer + Sons Co	1889	79
															RH Gallagher adm of Estate		
															DH Kent	1892	135

T XIII

R XII

INDEX

Newton

NEWTON

T XV. R XIV.

T XVII. B XV.

[illegible]

INDEX

SPRINGFIELD

T XVI. R XIV. T XV. R XIV.

Ar.	Tr.	Sec	Lot.	Ar.	out Lot.	For Whom Surveyed.	Date	Page	Ar.	Tr.	Sec	Lot.	Ar.	out Lot.	For Whom Surveyed	Date	Page.
4		15				John Leedy Chas Urban	1886	11									

T XI R XIII T XII R XIII

INDEX

CLAY

T XIV R XIV

Ar.	Tr.	Sec	Lot	Ar	out Lot	For whom Surveyed.	Date	Page.	Ar.	Tr.	Sec	Lot	Ar	out Lot	For whom Surveyed.	Date
1		3		NW		Kildow Hse.	1887	19								
		1472				Mr Dultz deceased	1881	111								
1		3		S 2W		Phoebe C. Cherry	1909	150								
		12		NW		Clay Sp. Board of Educ.	1909	154								
		14		"		" " " "	"	155								