
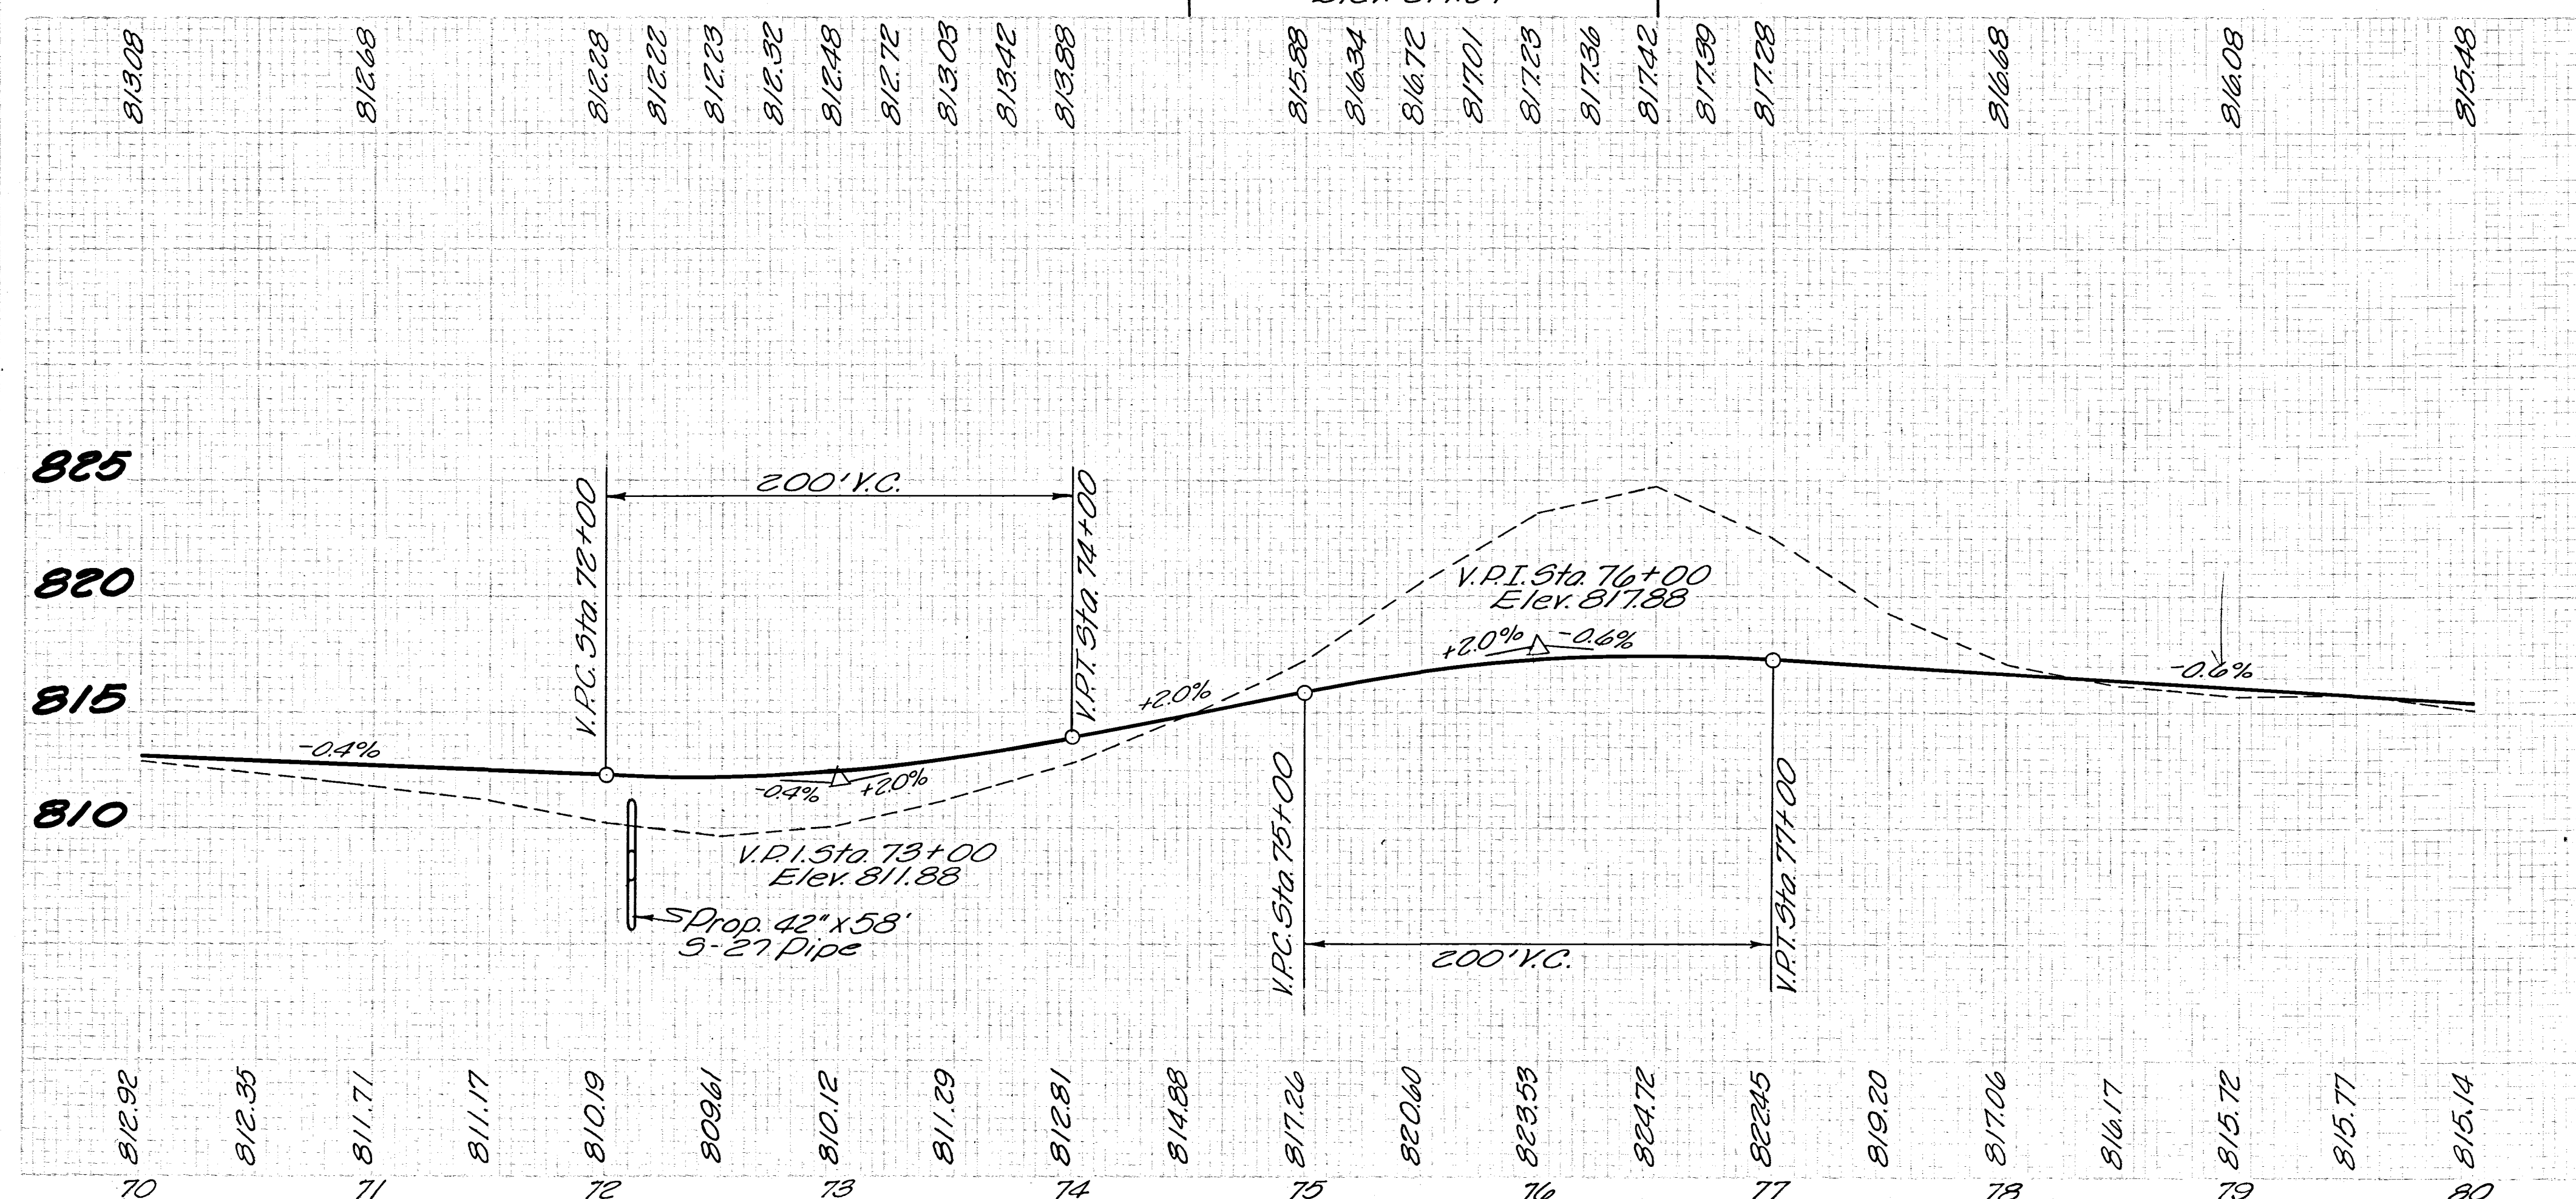


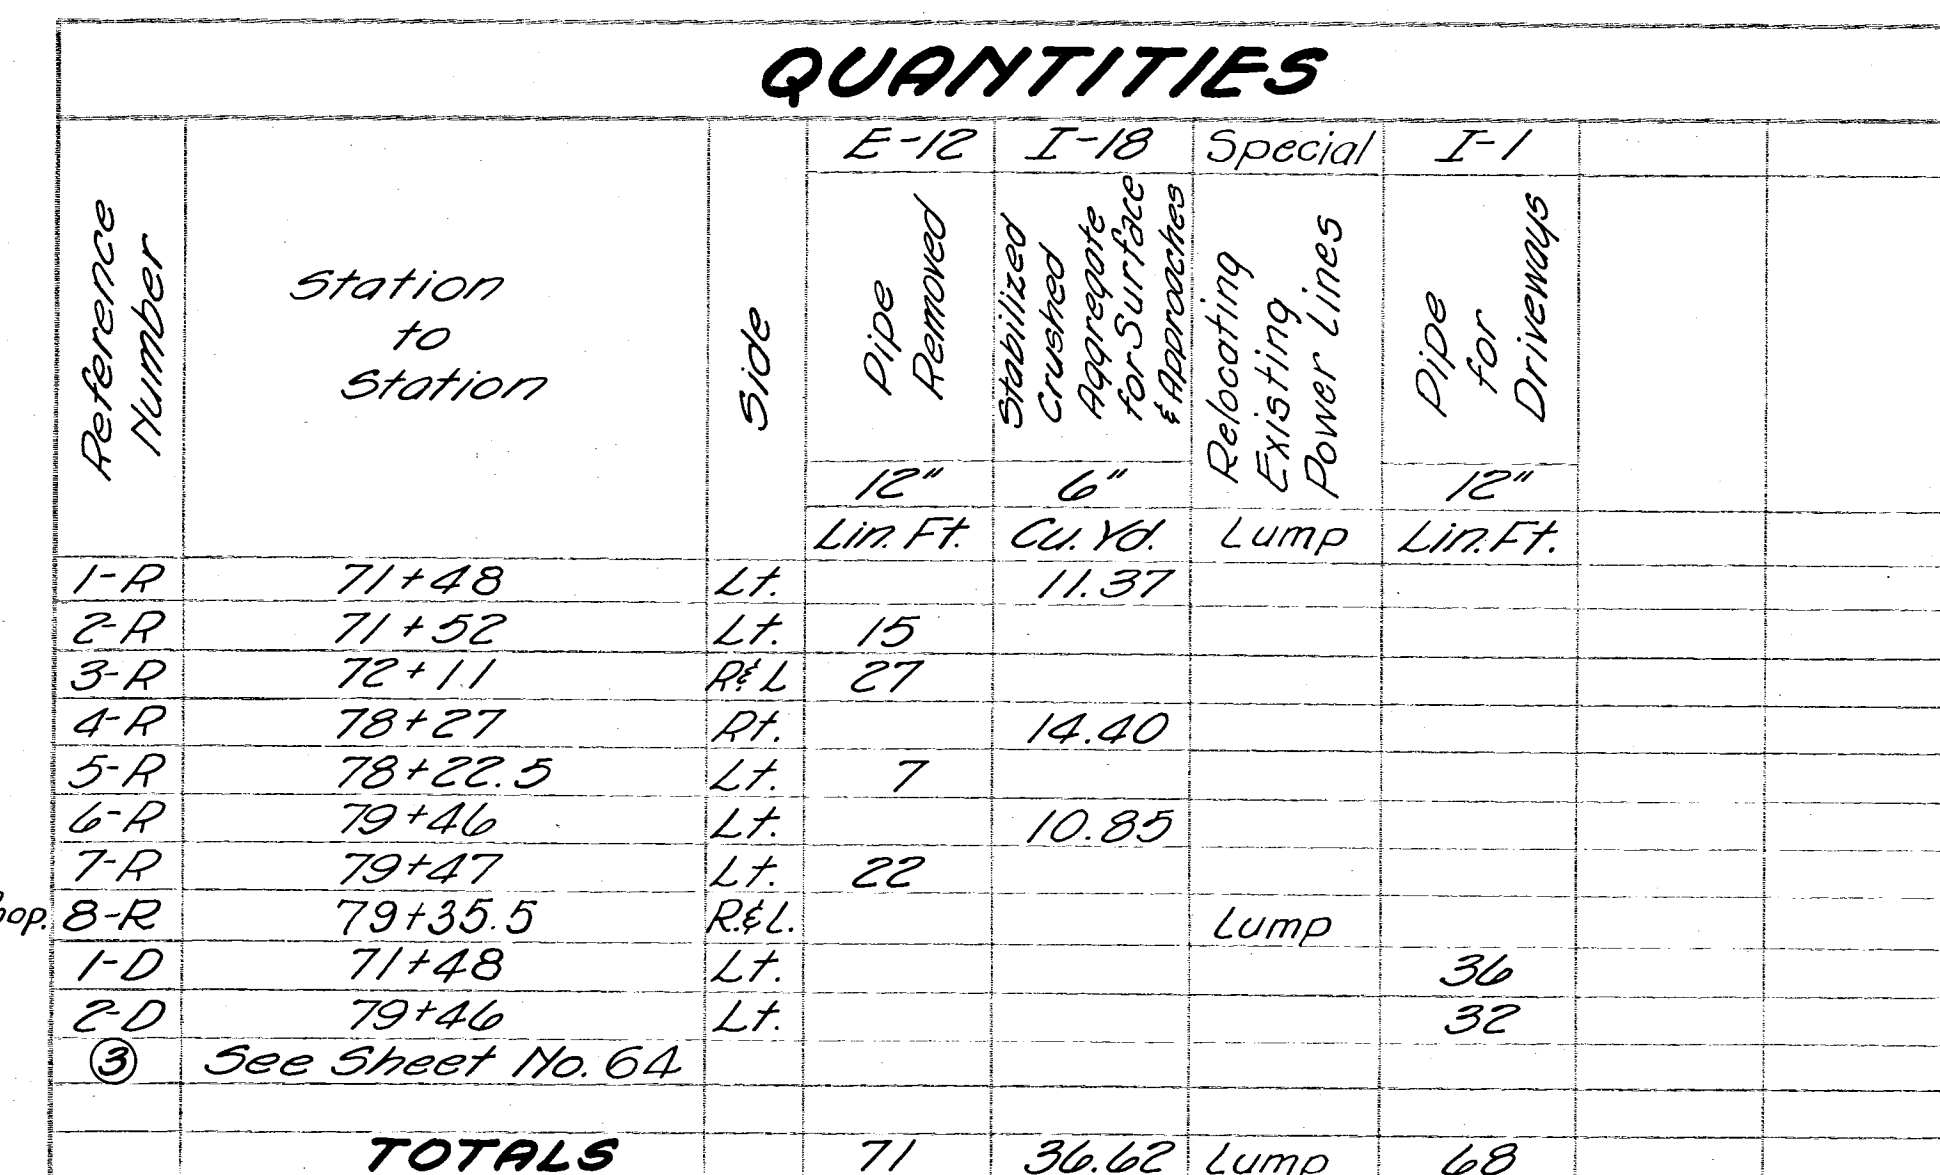

3/23/62		AS	CONSTRUCTED	H. F. K
REVISION	DATE	DESCRIPTION		BY
U. S. ARMY ENGINEER DISTRICT, HUNTINGTON CORPS OF ENGINEERS HUNTINGTON, W. VA.				
DRAWN BY: <i>WIC</i>		LICKING RIVER DILLON RESERVOIR PROJECT		
TRACED BY:		RELOCATION OF MUSKINGUM COUNTY ROAD NO. 8 MC-8-4 & MT-408-1 MC-8-1 & MC-408-1		
CHECKED BY: <i>F. H. B.</i>		DATE: NOVEMBER 1959		
SUBMITTED BY: <i>Elmer S. Barrett</i>		APPROVED: <i>Steven Malenchuk</i>		
ELMER S. BARRETT ASSOCIATES		COL. C. E. DISTRICT ENGINEER		
RECOMMENDED BY: <i>James J. Kane</i>		DATE: NOVEMBER 1959		
CHIEF ENG. DIV.		SCALE: <i>HORIZ. 1"=50'</i> VERT. <i>1"=5'</i>		
ELMER S. BARRETT ASSOCIATES CONSULTING ENGINEERS CHILLICOTHE, OHIO		SPEC. NO. DRAWING NUMBER 027F UD 14-68 //		
SHEET		11 OF 83		

WORK AS CONSTRUCTED **PLAN & PROFILE - STA. 70+00 TO STA. 80+00**