


RALPH R. CROSS


LICKING TWP.
QR. TP. 3 T. 2 N. R. 9 W.

DROP CURVE DATA
D.I. Sta. 87+39.54
 $\Delta = 7^{\circ}36'00''$ L.
D = 3^{\circ}00'
R = 1909.86'
T = 126.85'
L = 253.33'
E = 4.21'

ISOLA F. STEEN

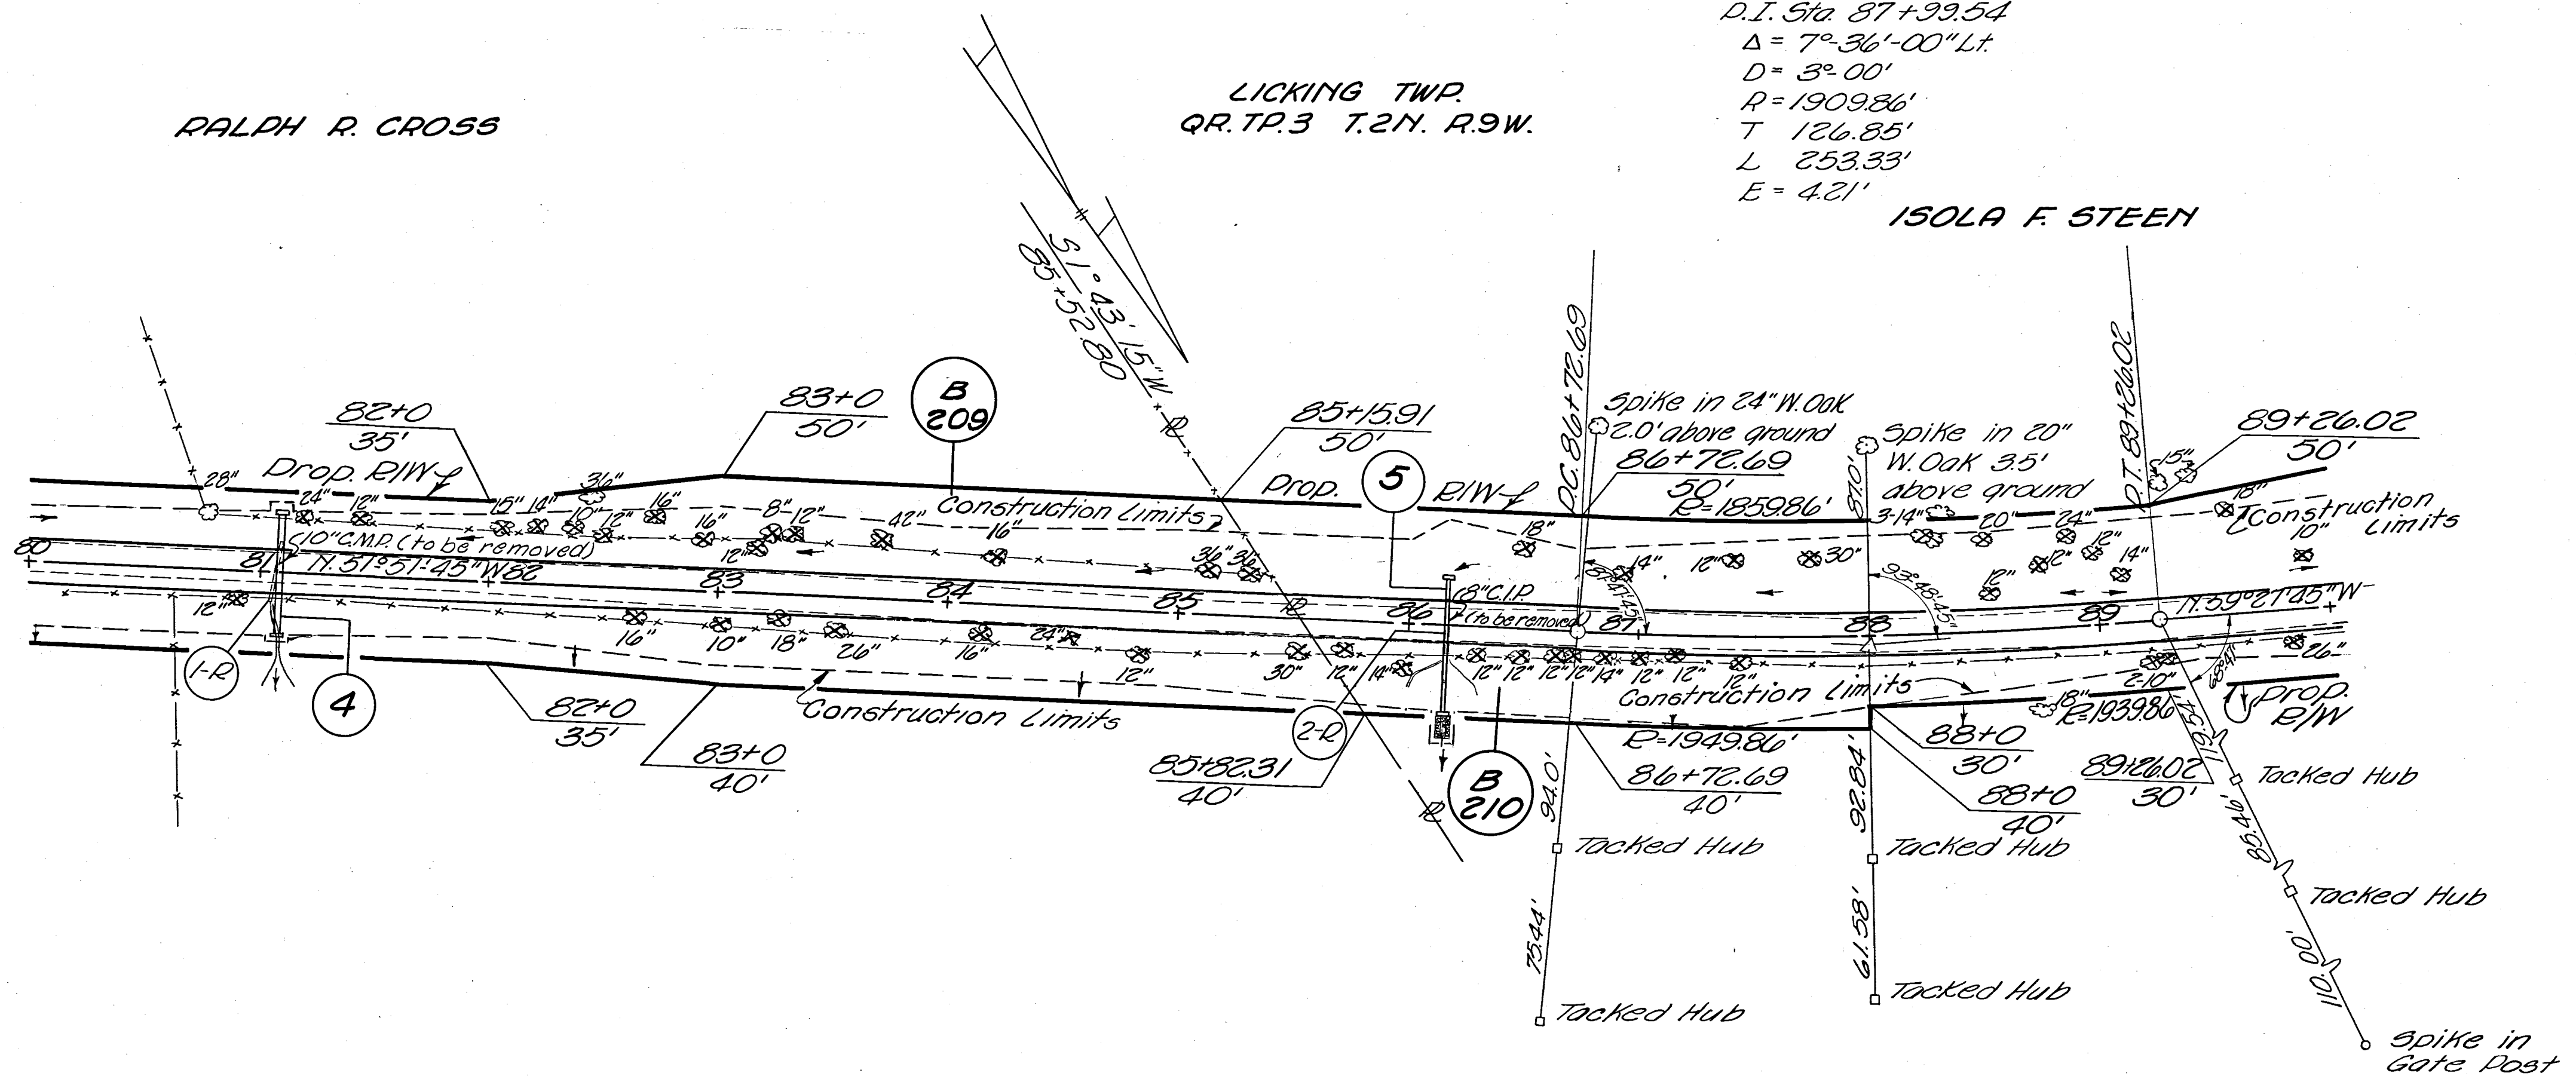

QUANTITIES					
Reference Number	Station to Station	Side	E-12		
			Pipe Removed		
1-R	81+07	R/L	26		
2-R	86+16	R/L	24		
4	See Sheet No. 64				
5	See Sheet No. 65				
TOTALS			24	26	

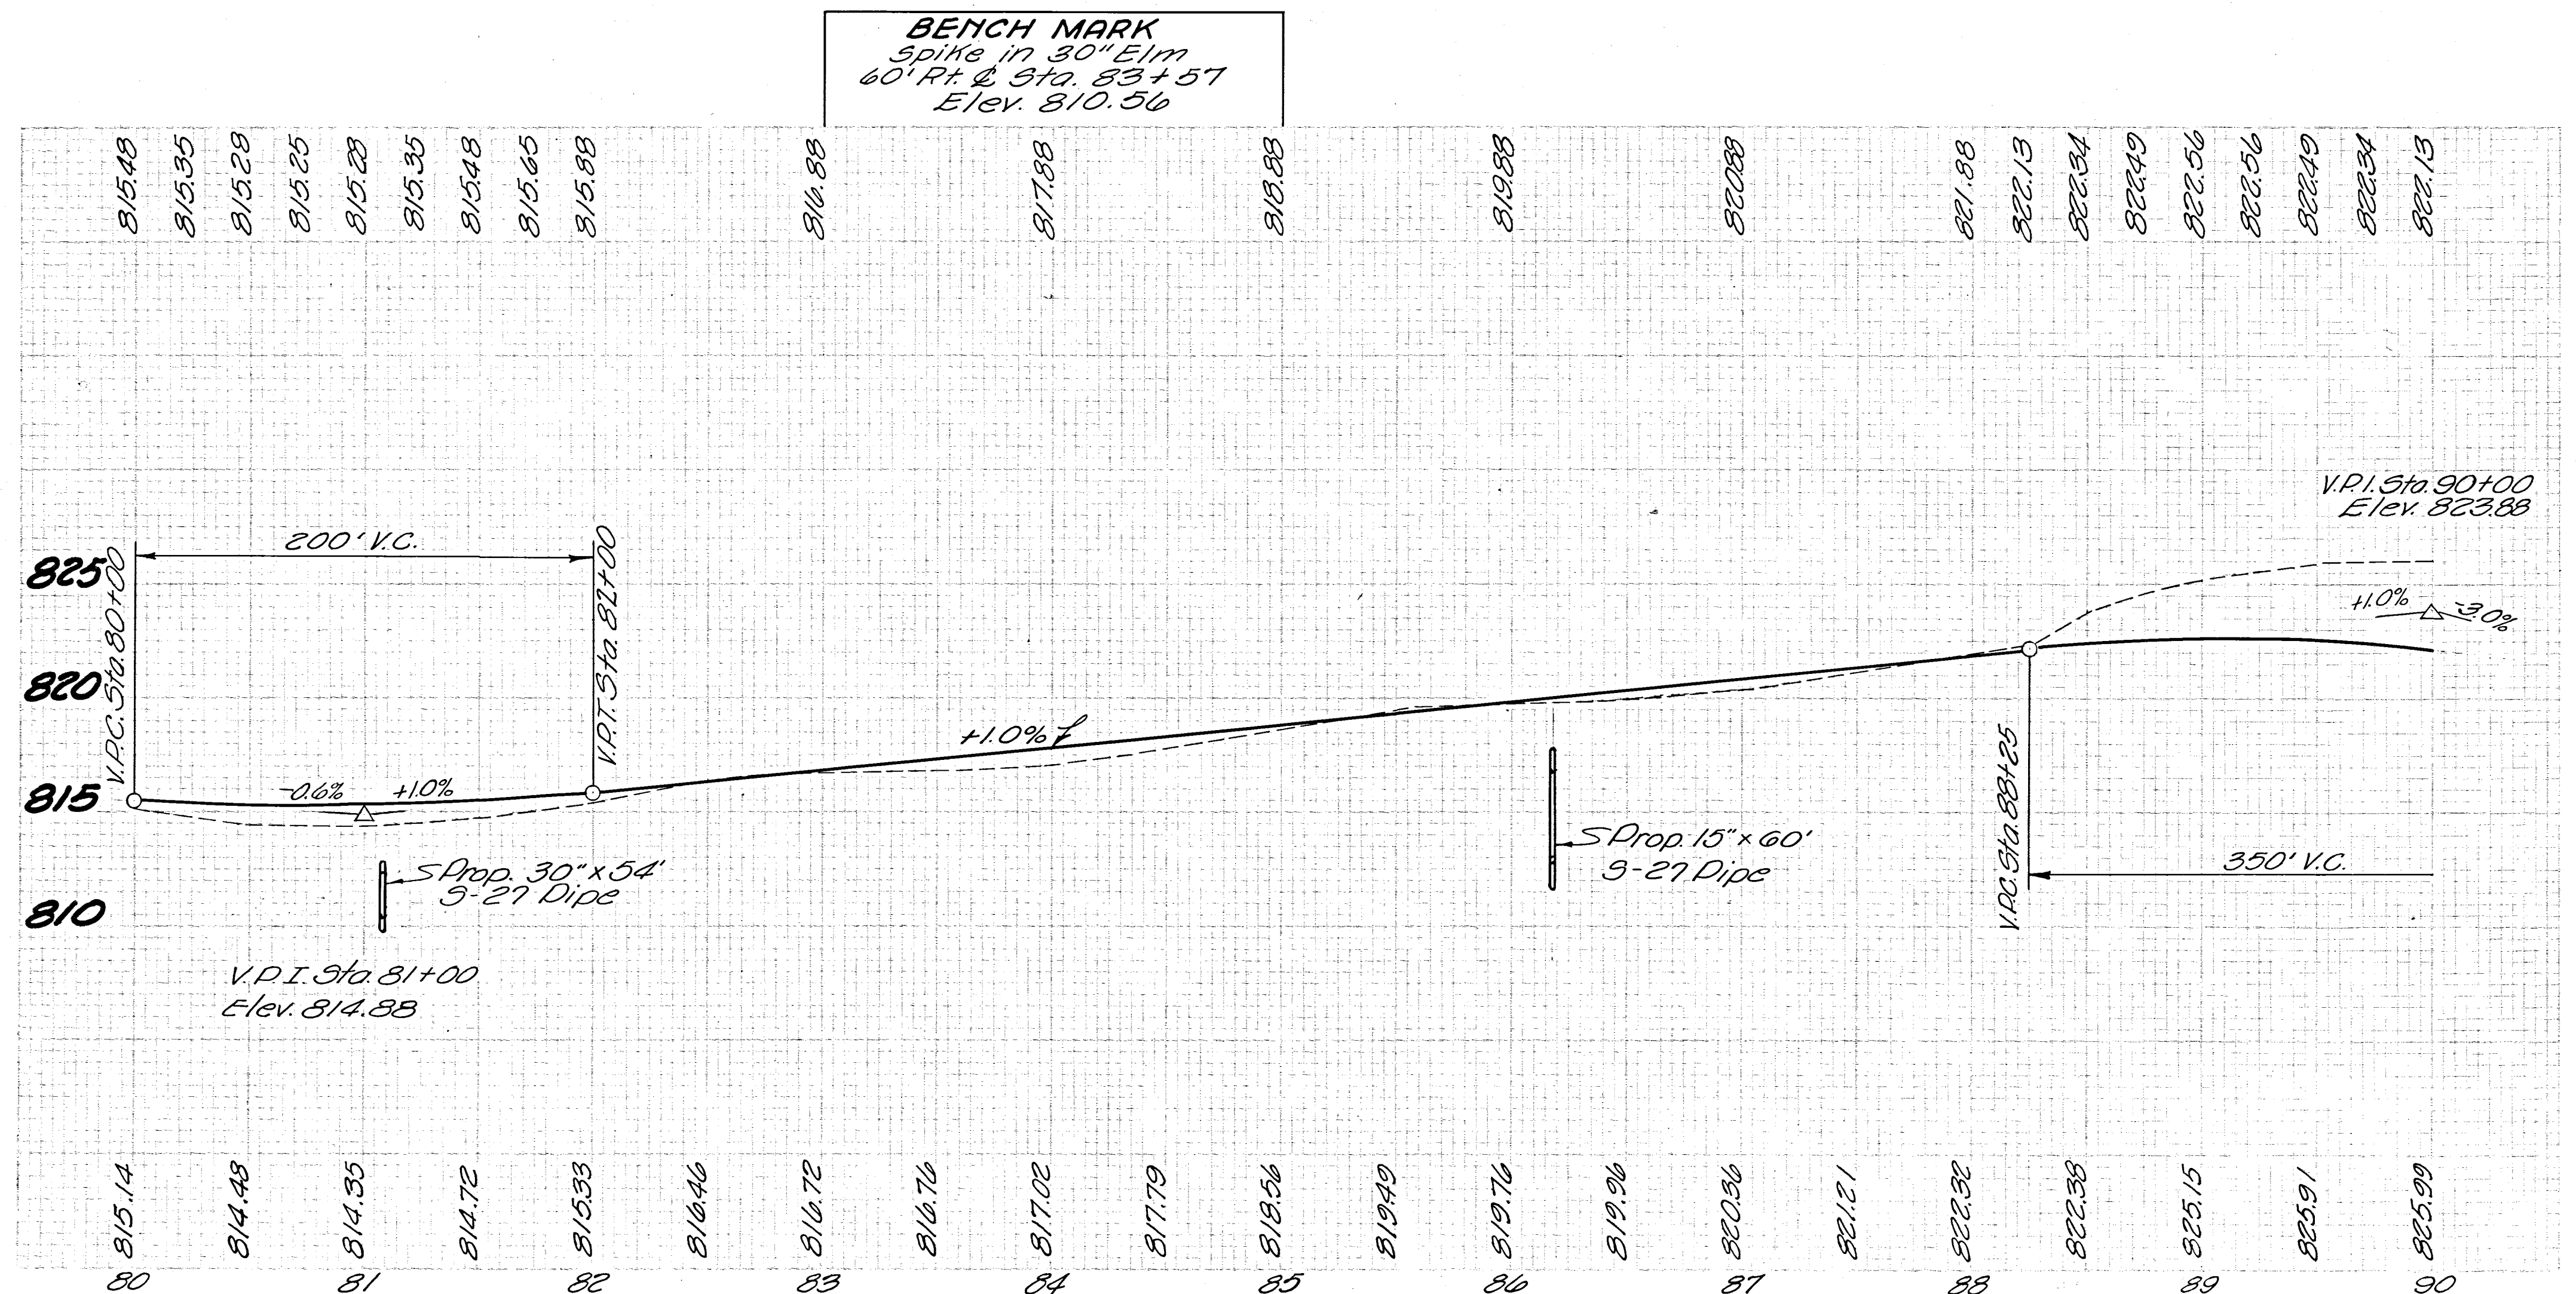

REVISION	DATE	AS CONSTRUCTED	DESCRIPTION	H.F.K. BY
	3/23/62			
U. S. ARMY ENGINEER DISTRICT, HUNTINGTON CORPS OF ENGINEERS HUNTINGTON, W. VA.				
DRAWN BY: WIC		LICKING RIVER DILLON RESERVOIR PROJECT		
CHECKED BY: F.H.A.		RELOCATION OF MUSKINGUM COUNTY ROAD NO. 8 MC-8-4 & MT-408-1 MC-8-1 & MC-408-1		
SUBMITTED BY: Elmer S. Barrett		APPROVED: Steven M. Leitch COL. C.E., DISTRICT ENGINEER		
ELMER S. BARRETT ASSOCIATES CHILLICOTHE, OHIO		DATE: NOVEMBER 1959		
SCALE: HORIZ. 1"=50'		SPEC. NO. 027f-UD14-68/12		
		SHEET 12 OF 83		