


SCHEMATIC PLAN

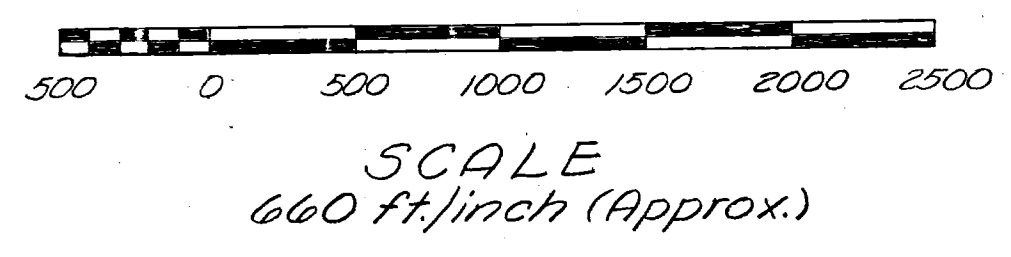

*NOTE--
Symbol at left designates
land which is available for borrow
pits, and is owned by the United
States of America. Borrow pits
made in this area shall be at the
direction of the Contracting Officer.*

CURVE DATA
 CONNECTION EXISTING C.R. #8 Rt. E Sta. 54+27.60
 P.I. Sta. 4+44.42
 $\Delta = 36^{\circ} 35' 20''$ LT. $T = 118.39'$
 $D_c = 16^{\circ} 00'$ $L = 228.68'$
 $R = 353.10'$ $E = 13.06'$

				H.F.K.
	3/23/62	AS CONSTRUCTED		BY
REVISION	DATE	DESCRIPTION		
U. S. ARMY ENGINEER DISTRICT, HUNTINGTON CORPS OF ENGINEERS HUNTINGTON, W. VA.				
DRAWN BY: <i>W.D.J.</i>	LICKING RIVER DILLON RESERVOIR PROJECT			
TRACED BY: <i>edk.</i>	RELOCATION OF MUSKUMGUM COUNTY RD. NO.8 MC-8-4 & MT-408-1 MC-8-1 & MC-408-1			
CHECKED BY: <i>F.H.S.</i>				
SUBMITTED BY: <i>Elmer S Barrett</i>				
ELMER S. BARRETT ASSOCIATES				
RECOMMENDED: <i>Jamary Janner</i>	APPROVED: <i>Steven Malenchuk</i>	DATE: NOVEMBER 1959		
CHIEF ENG. DIV.	COL. C.E. DISTRICT ENGINEER			
ELMER S. BARRETT ASSOCIATES CONSULTING ENGINEERS CHILLICOTHE, OHIO	SCALE: 1" = 660'	SPEC. NO.		
	DRAWING NUMBER 0271-UD 14-68/2			
	SHEET 2 OF 83			

WORK AS CONSTRUCTED *SCHEMATIC PLAN*