

LICKING TWP.
S.G. & IVA M. RAMSEY Q.R. TR 2 T. 2 N. R. 9 W.


FED. RD. DIVISION 2 STATE OHIO PROJECT 23 83

MUSKINGUM COUNTY
COUNTY ROAD NO. 8

QUANTITIES

Reference Number	Station to Station	Side	I-15 Wire Wire Type (2 Tape) or Wire Cable Type (2 Cables) Guard Rail	Lin. Ft.
1-R	199+00 to 200+00	Lt.		100
2-R	197+50 to 200+00	Rt.		250
(14)	See Sheet No. 71			
TOTALS				350

BENCH MARK
P.K. in 30" Stump
130' Pt. & Sta. 197+10
Elev. 760.73

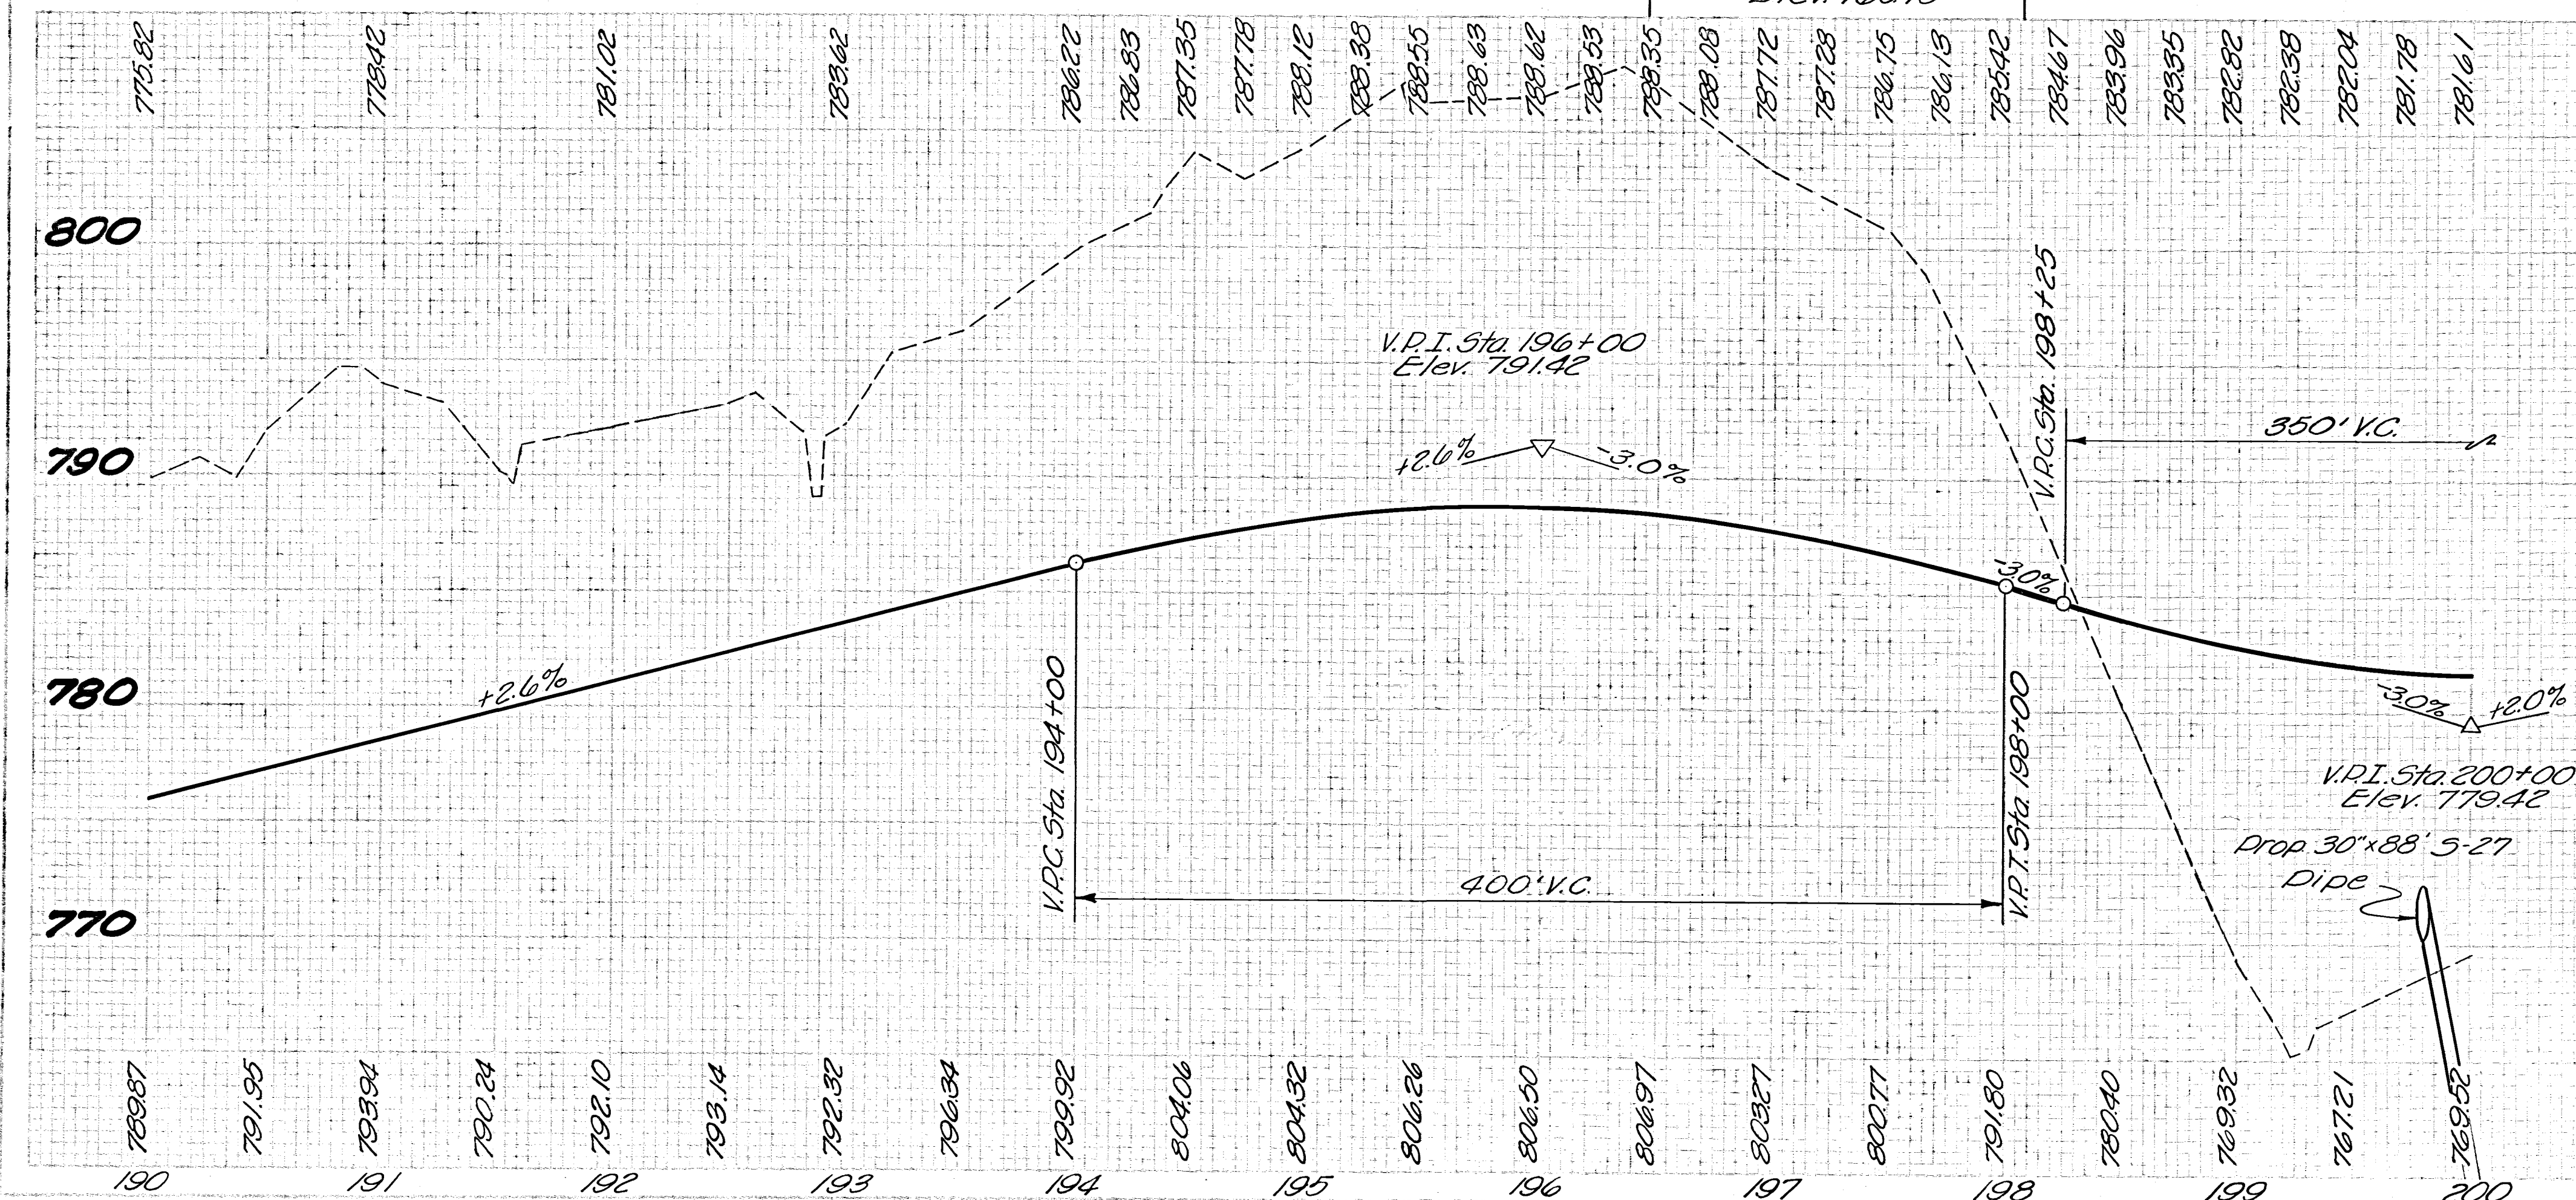

WORK AS CONSTRUCTED PLAN & PROFILE - STA. 190+00 TO STA. 200+00

REVISION	DATE	DESCRIPTION	H.F.K. BY
	3/23/62	AS CONSTRUCTED	
U. S. ARMY ENGINEER DISTRICT, HUNTINGTON CORPS OF ENGINEERS HUNTINGTON, W. VA.			
DRAWN BY: EER		LICKING RIVER DILLON RESERVOIR PROJECT	
TRACED BY:		RELOCATION OF MUSKINGUM COUNTY ROAD NO. 8 MC-8-4 & MT-408-1 MC-8-1 & MC-408-1	
CHECKED BY: FHS		APPROVED: Steven Malench DATE: NOVEMBER 1959	
SUBMITTED BY: Elmer S. Barrett Associates		ELMER S. BARRETT ASSOCIATES CONSULTING ENGINEERS CHILLICOTHE, OHIO	
RECOMMENDED: Chief Eng. Div.		SCALE: HORIZ. 1"=50' VERT. 1"=5' SPEC. NO. 027 f-UD14-68/ 23 SHEET 23 OF 83	