


Seeding	End Sq. Width Yds.
44	572
59	728
72	744
62	628
51	533
45	644
71	567
31	433
47	617
64	583
41	

Sta. 60+00

100 80 60 40 20 0 20 40 60

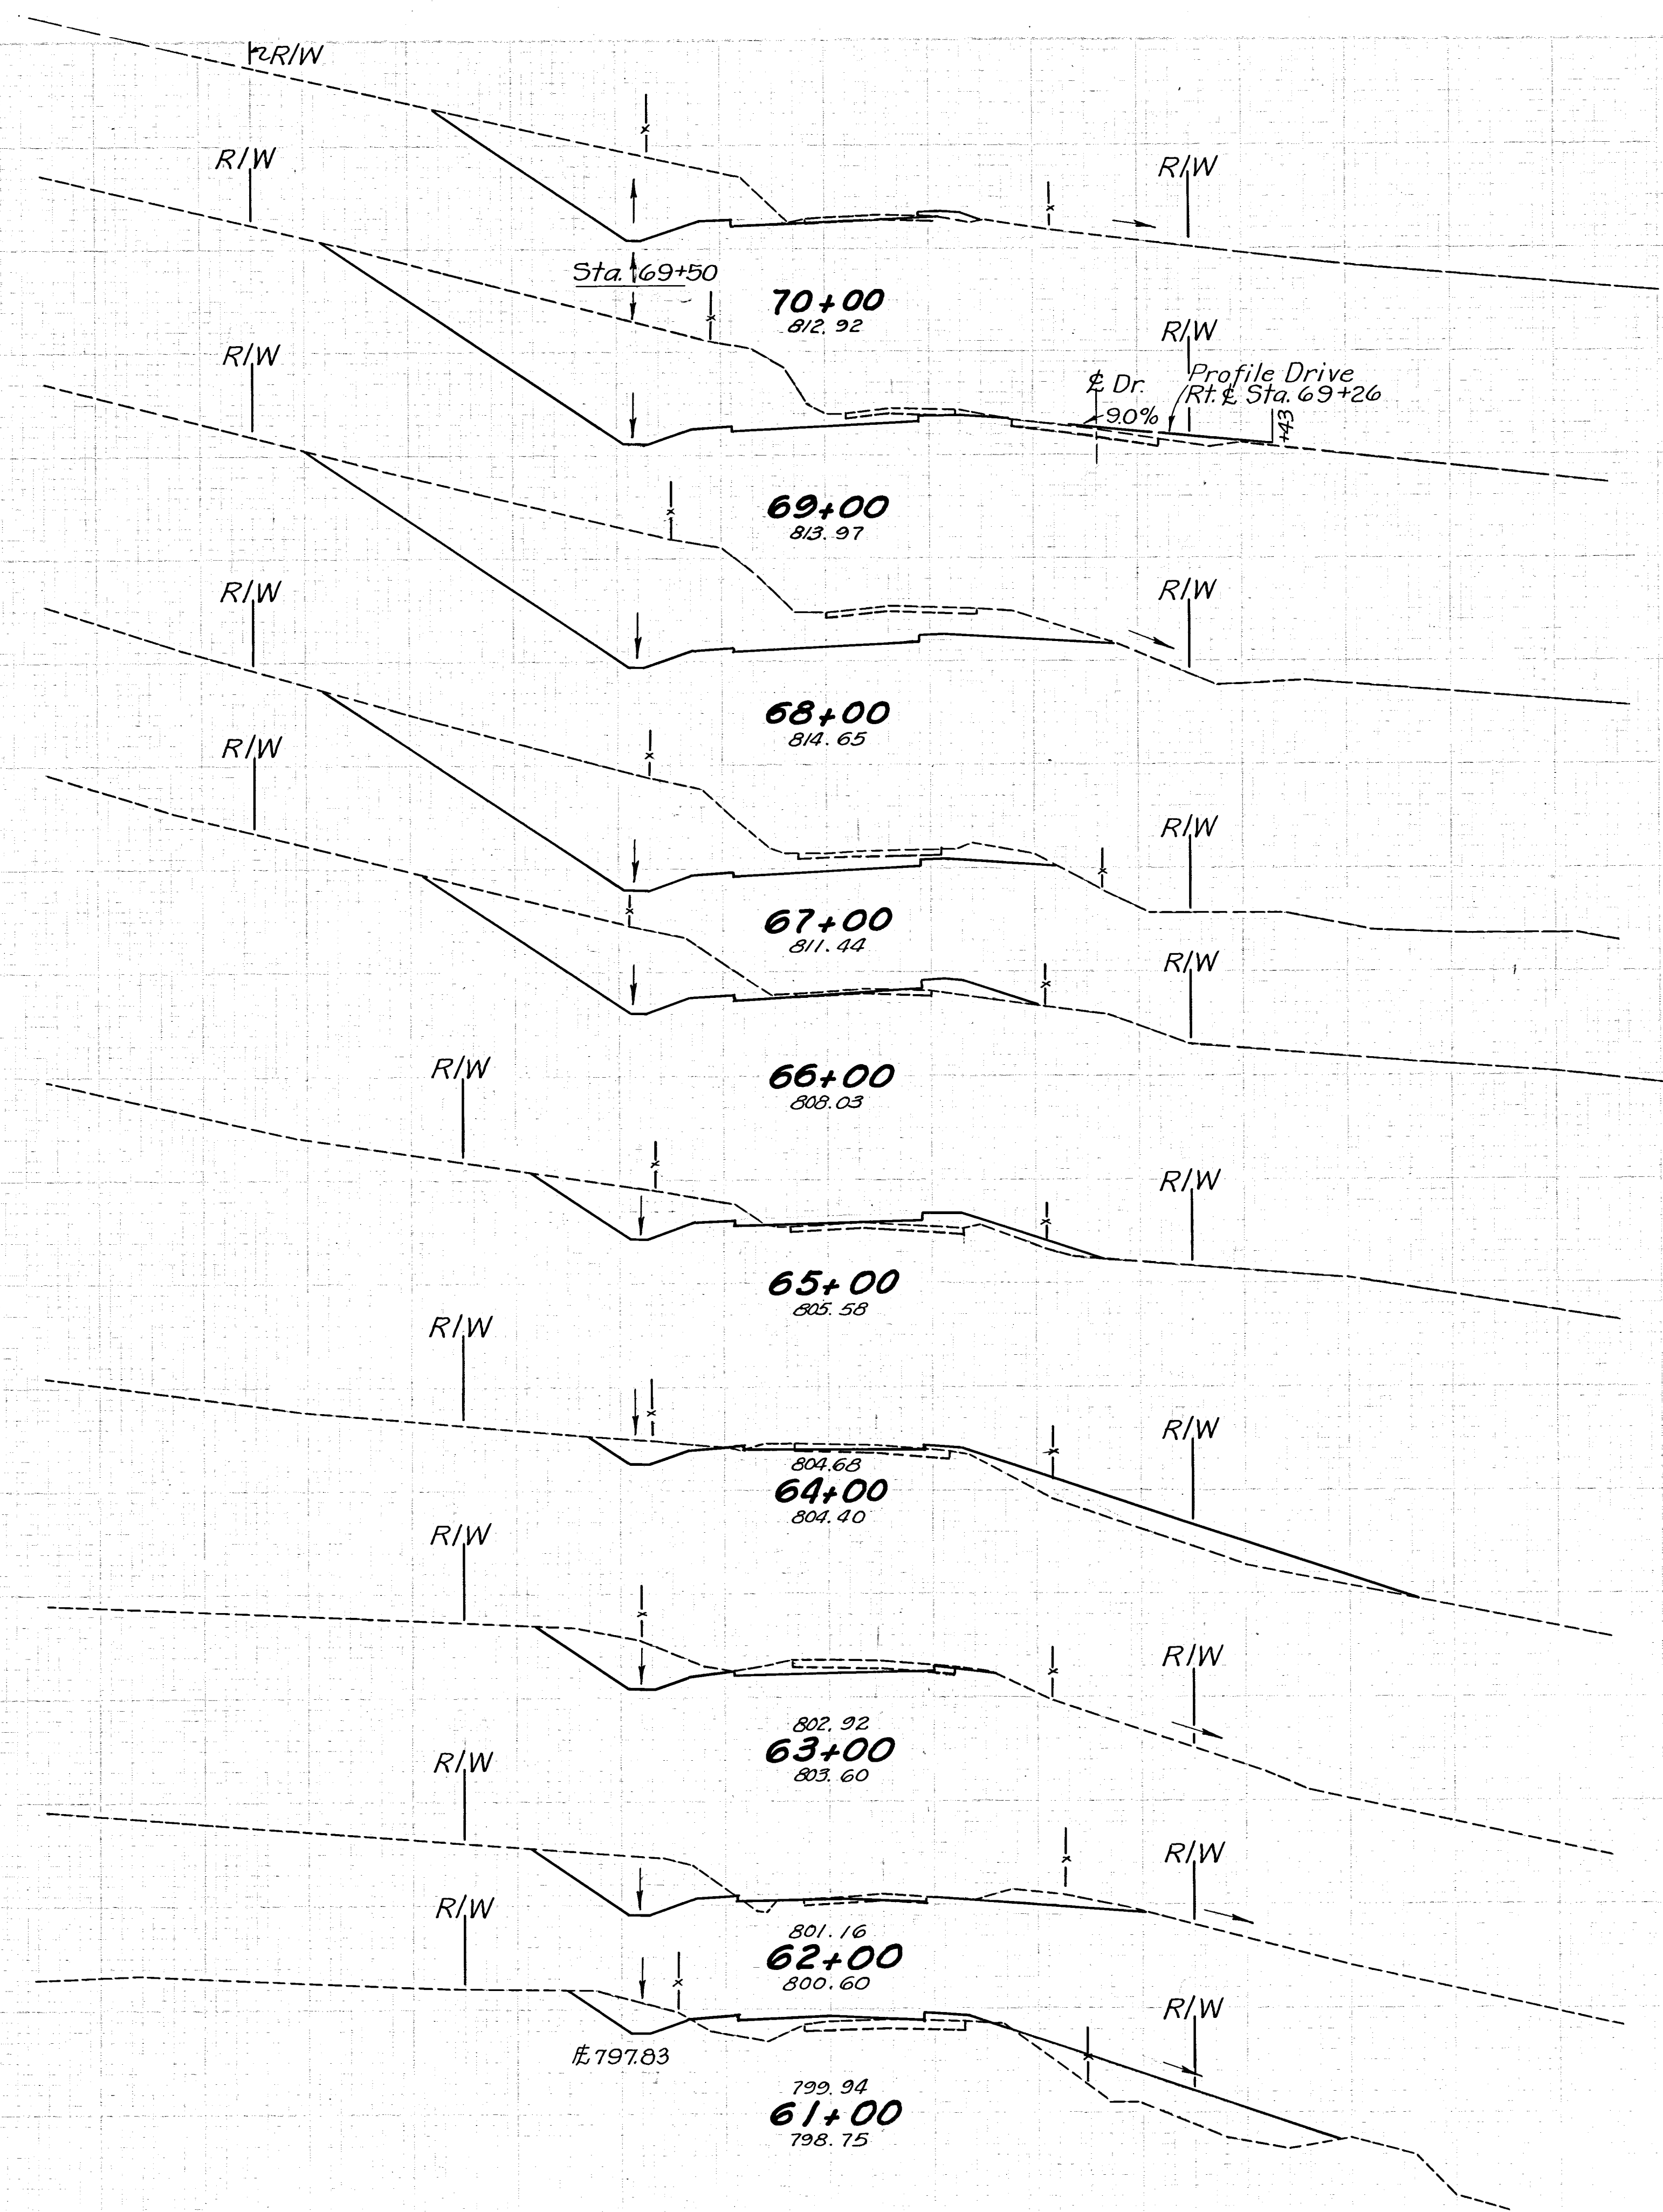

Sta. 60+00

WORK AS CONSTRUCTED

End Area		Volume	
Cut	Fill	Cut	Fill
165	3		
		10	
		957	6
352	0		
		1459	0
436	0		
		1391	0
315	0		
		850	19
154	10		
		404	54
64	19		
		157	169
21	72		
		78	224
21	49		
		198	94
86	2		
		200	193
22	102		
		235	189
105	0		

REVISION	DATE	DESCRIPTION	BY
	3/23/62	AS CONSTRUCTED	H.F.K.
U. S. ARMY ENGINEER DISTRICT, HUNTINGTON CORPS OF ENGINEERS HUNTINGTON, W. VA.			
LICKING RIVER DILLON RESERVOIR PROJECT RELOCATION OF MUSKINGUM COUNTY ROAD NO. 8			
M C- 8- 4 & MT- 408- 1 M C- 8- 1 & MC- 408- 1			
DATE: NOVEMBER 1959			
DRAWN BY: WIC		CHECKED BY: F.H.D.	
SUBMITTED BY: Elmer S. Barrett		APPROVED: Steven Malovich	
RECOMMENDED BY: Elmer S. Barrett		COL. C.E. DISTRICT ENGINEER	
CHIEF ENG. DIV.		SCALE: 1"=10'	
ELMER S. BARRETT ASSOCIATES CONSULTING ENGINEERS CHILLICOTHE, OHIO		SPEC. NO. DRAWING NUMBER 027f-UD 14-68/26	
SHEET 26 OF 83			

STA. 61+00 To STA. 70+00