


Seeding	End Sq. Width Yds.
35	
439	
44	
656	
74	
894	
87	
828	
62	
528	
33	
439	
46	
522	
48	
433	
30	
411	
44	

Sta. 70+00

100 80 60 40 20 0 20 40 60 80

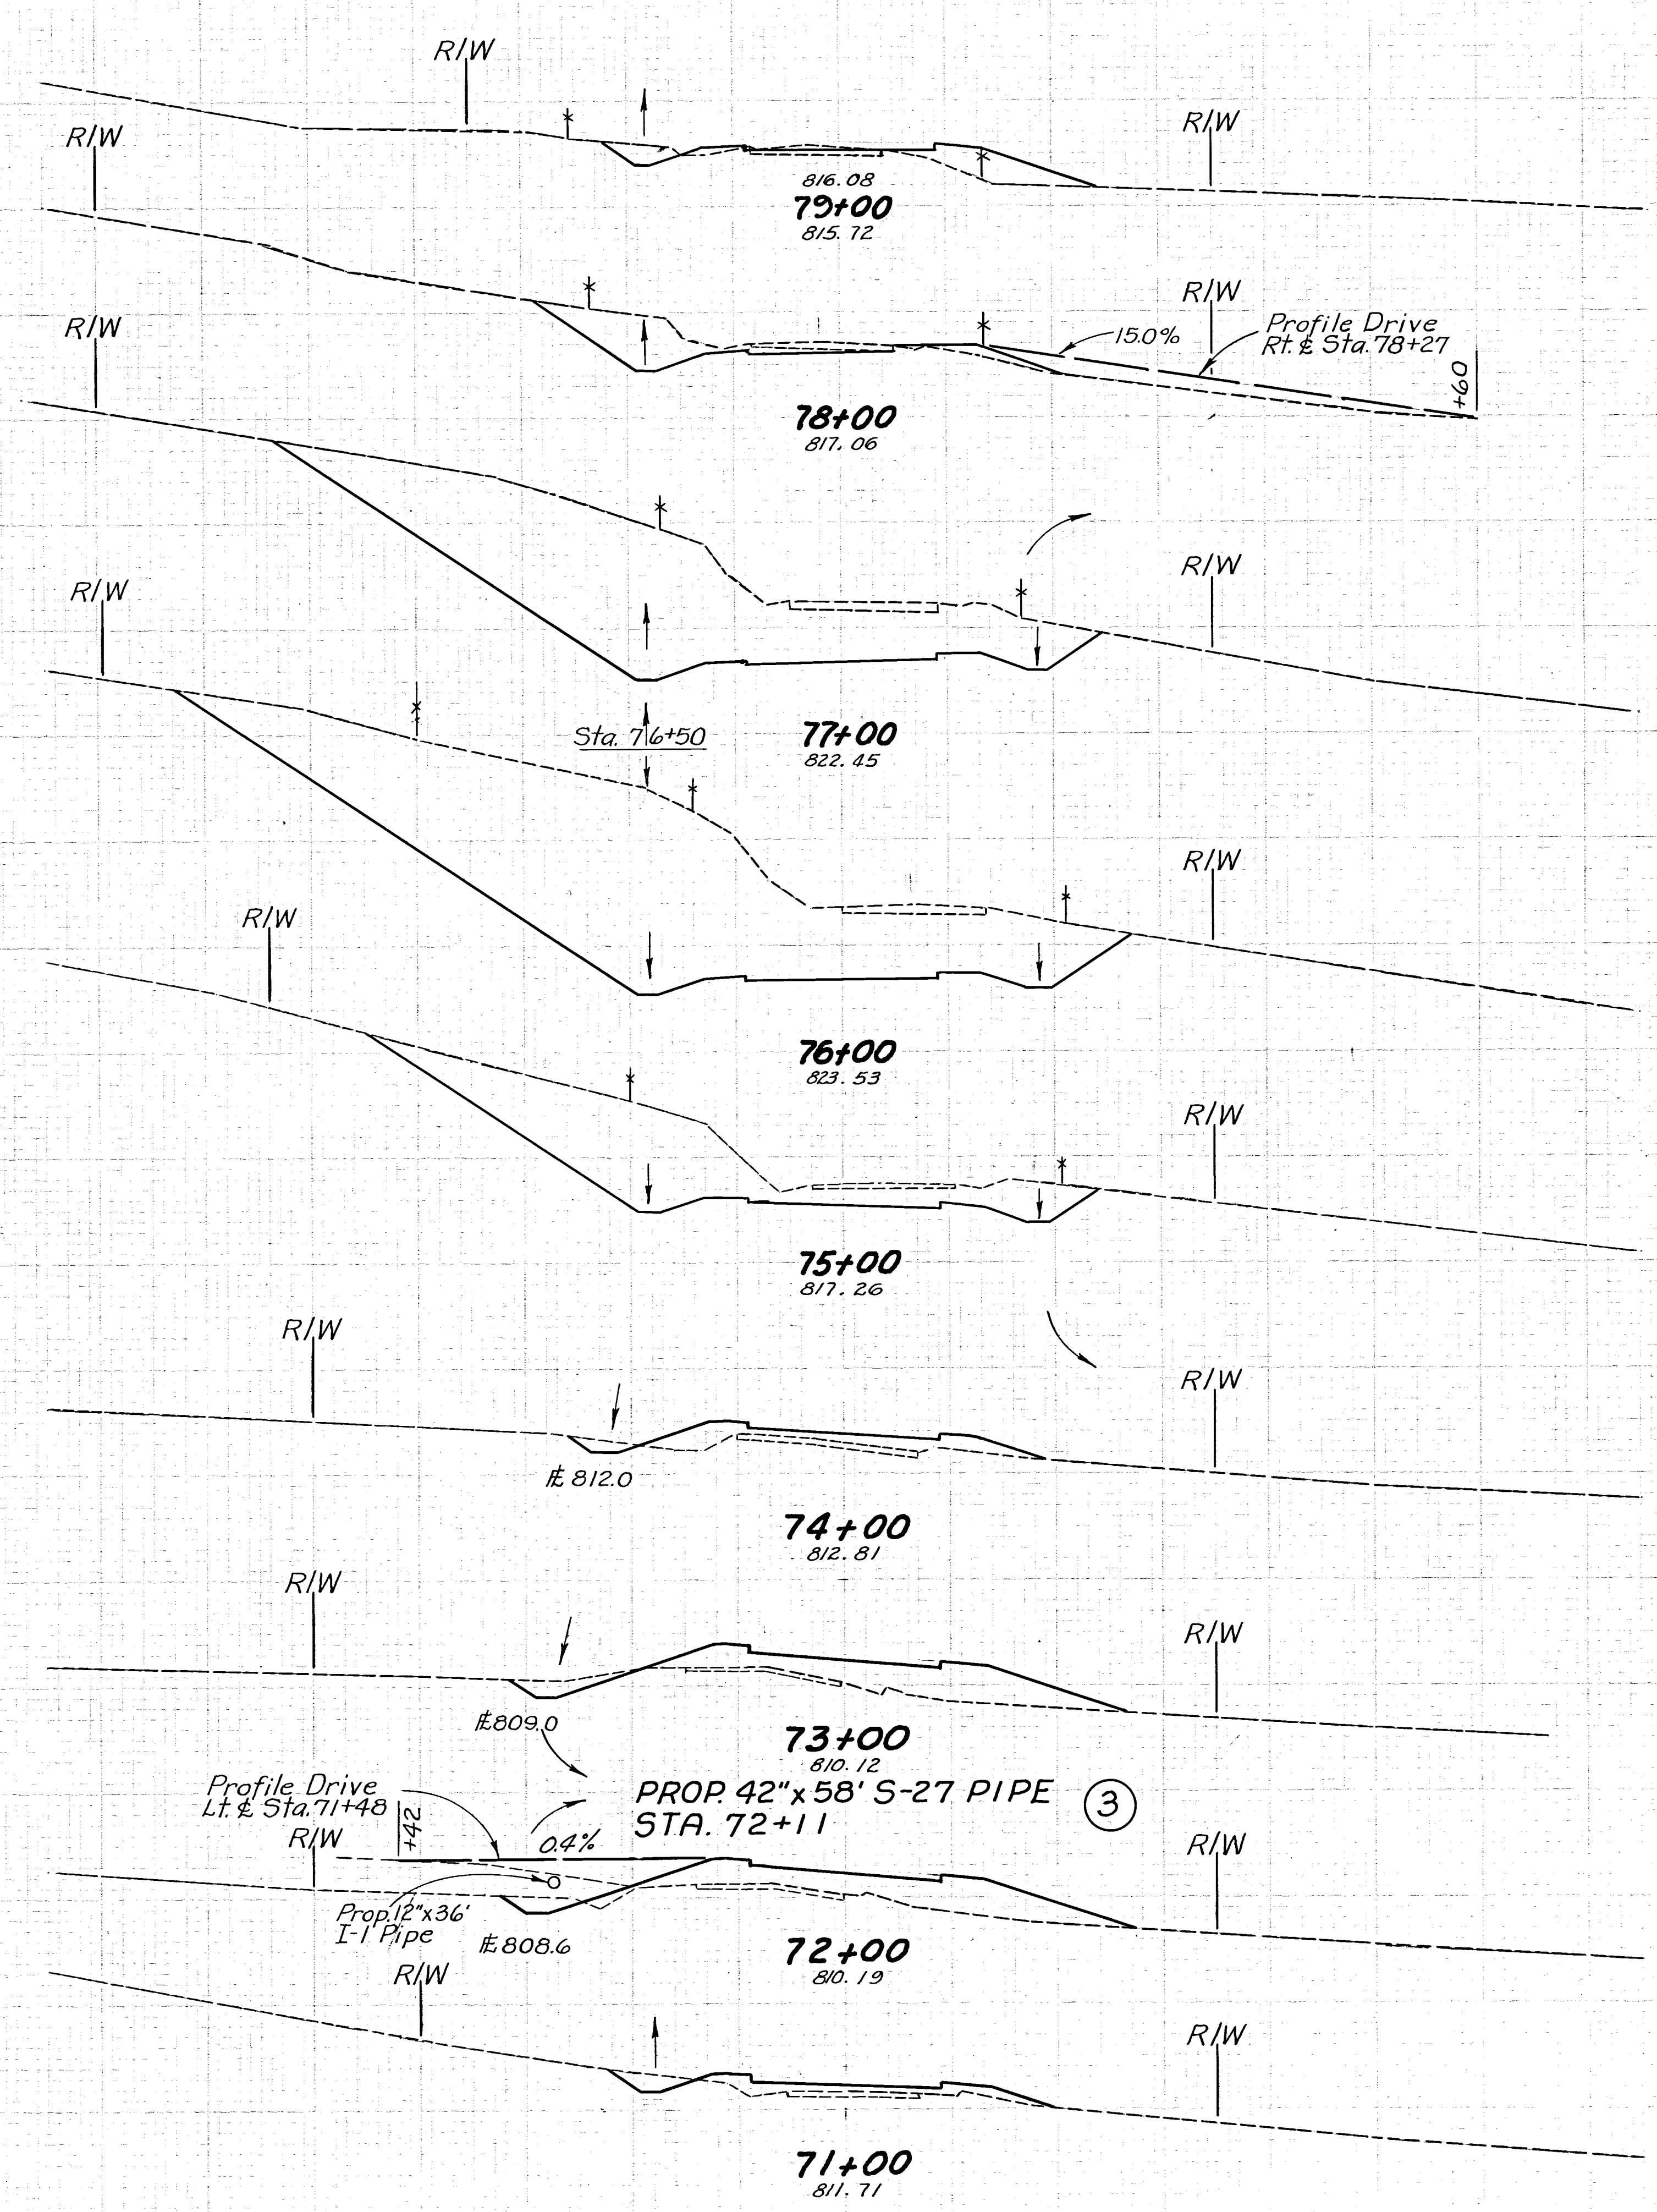

Drive Rt. & Sta. 78+27

Drive Lt. & Sta. 71+48

Sta. 70+00

WORK AS CONSTRUCTED STA. 71+00 To STA. 79+00

End Area		Volume	
Cut	Fill	Cut	Fill
10	34		
		143	81
			25
67	10		
		1124	19
540	0		
		2491	0
805	0		
		1991	0
270	0		
		509	91
5	49		
		30	276
11	100		
		31	
		33	369
7	99		
		26	233
7	27		
		319	56
165	3		

27
83
**MUSKINGUM COUNTY
COUNTY ROAD NO. 8**

REVISION	DATE	DESCRIPTION	BY
	3/23/62	AS CONSTRUCTED	H.F.K.
U. S. ARMY ENGINEER DISTRICT, HUNTINGTON CORPS OF ENGINEERS HUNTINGTON, W. VA.			
DRAWN BY: WIC TRACED BY: CHECKED BY: <i>[Signature]</i> SUBMITTED BY: <i>[Signature]</i> ELMER S. BARRETT ASSOCIATE RECOMMENDED BY: <i>[Signature]</i> CHIEF ENG. DIV.		LICKING RIVER DILLON RESERVOIR PROJECT RELOCATION OF MUSKINGUM COUNTY ROAD NO. 8 MC-8-4 & MT- 408-1 MC-8-1 & MC- 408-1 APPROVED: <i>[Signature]</i> DATE: NOVEMBER 1959 COL. C. E. DISTRICT ENGINEER	
ELMER S. BARRETT ASSOCIATES CONSULTING ENGINEERS CHILLICOTHE, OHIO		SCALE: 1"=10' SPEC. NO. DRAWING NUMBER 0271-UD 14-68/27 SHEET 27 OF 83	