


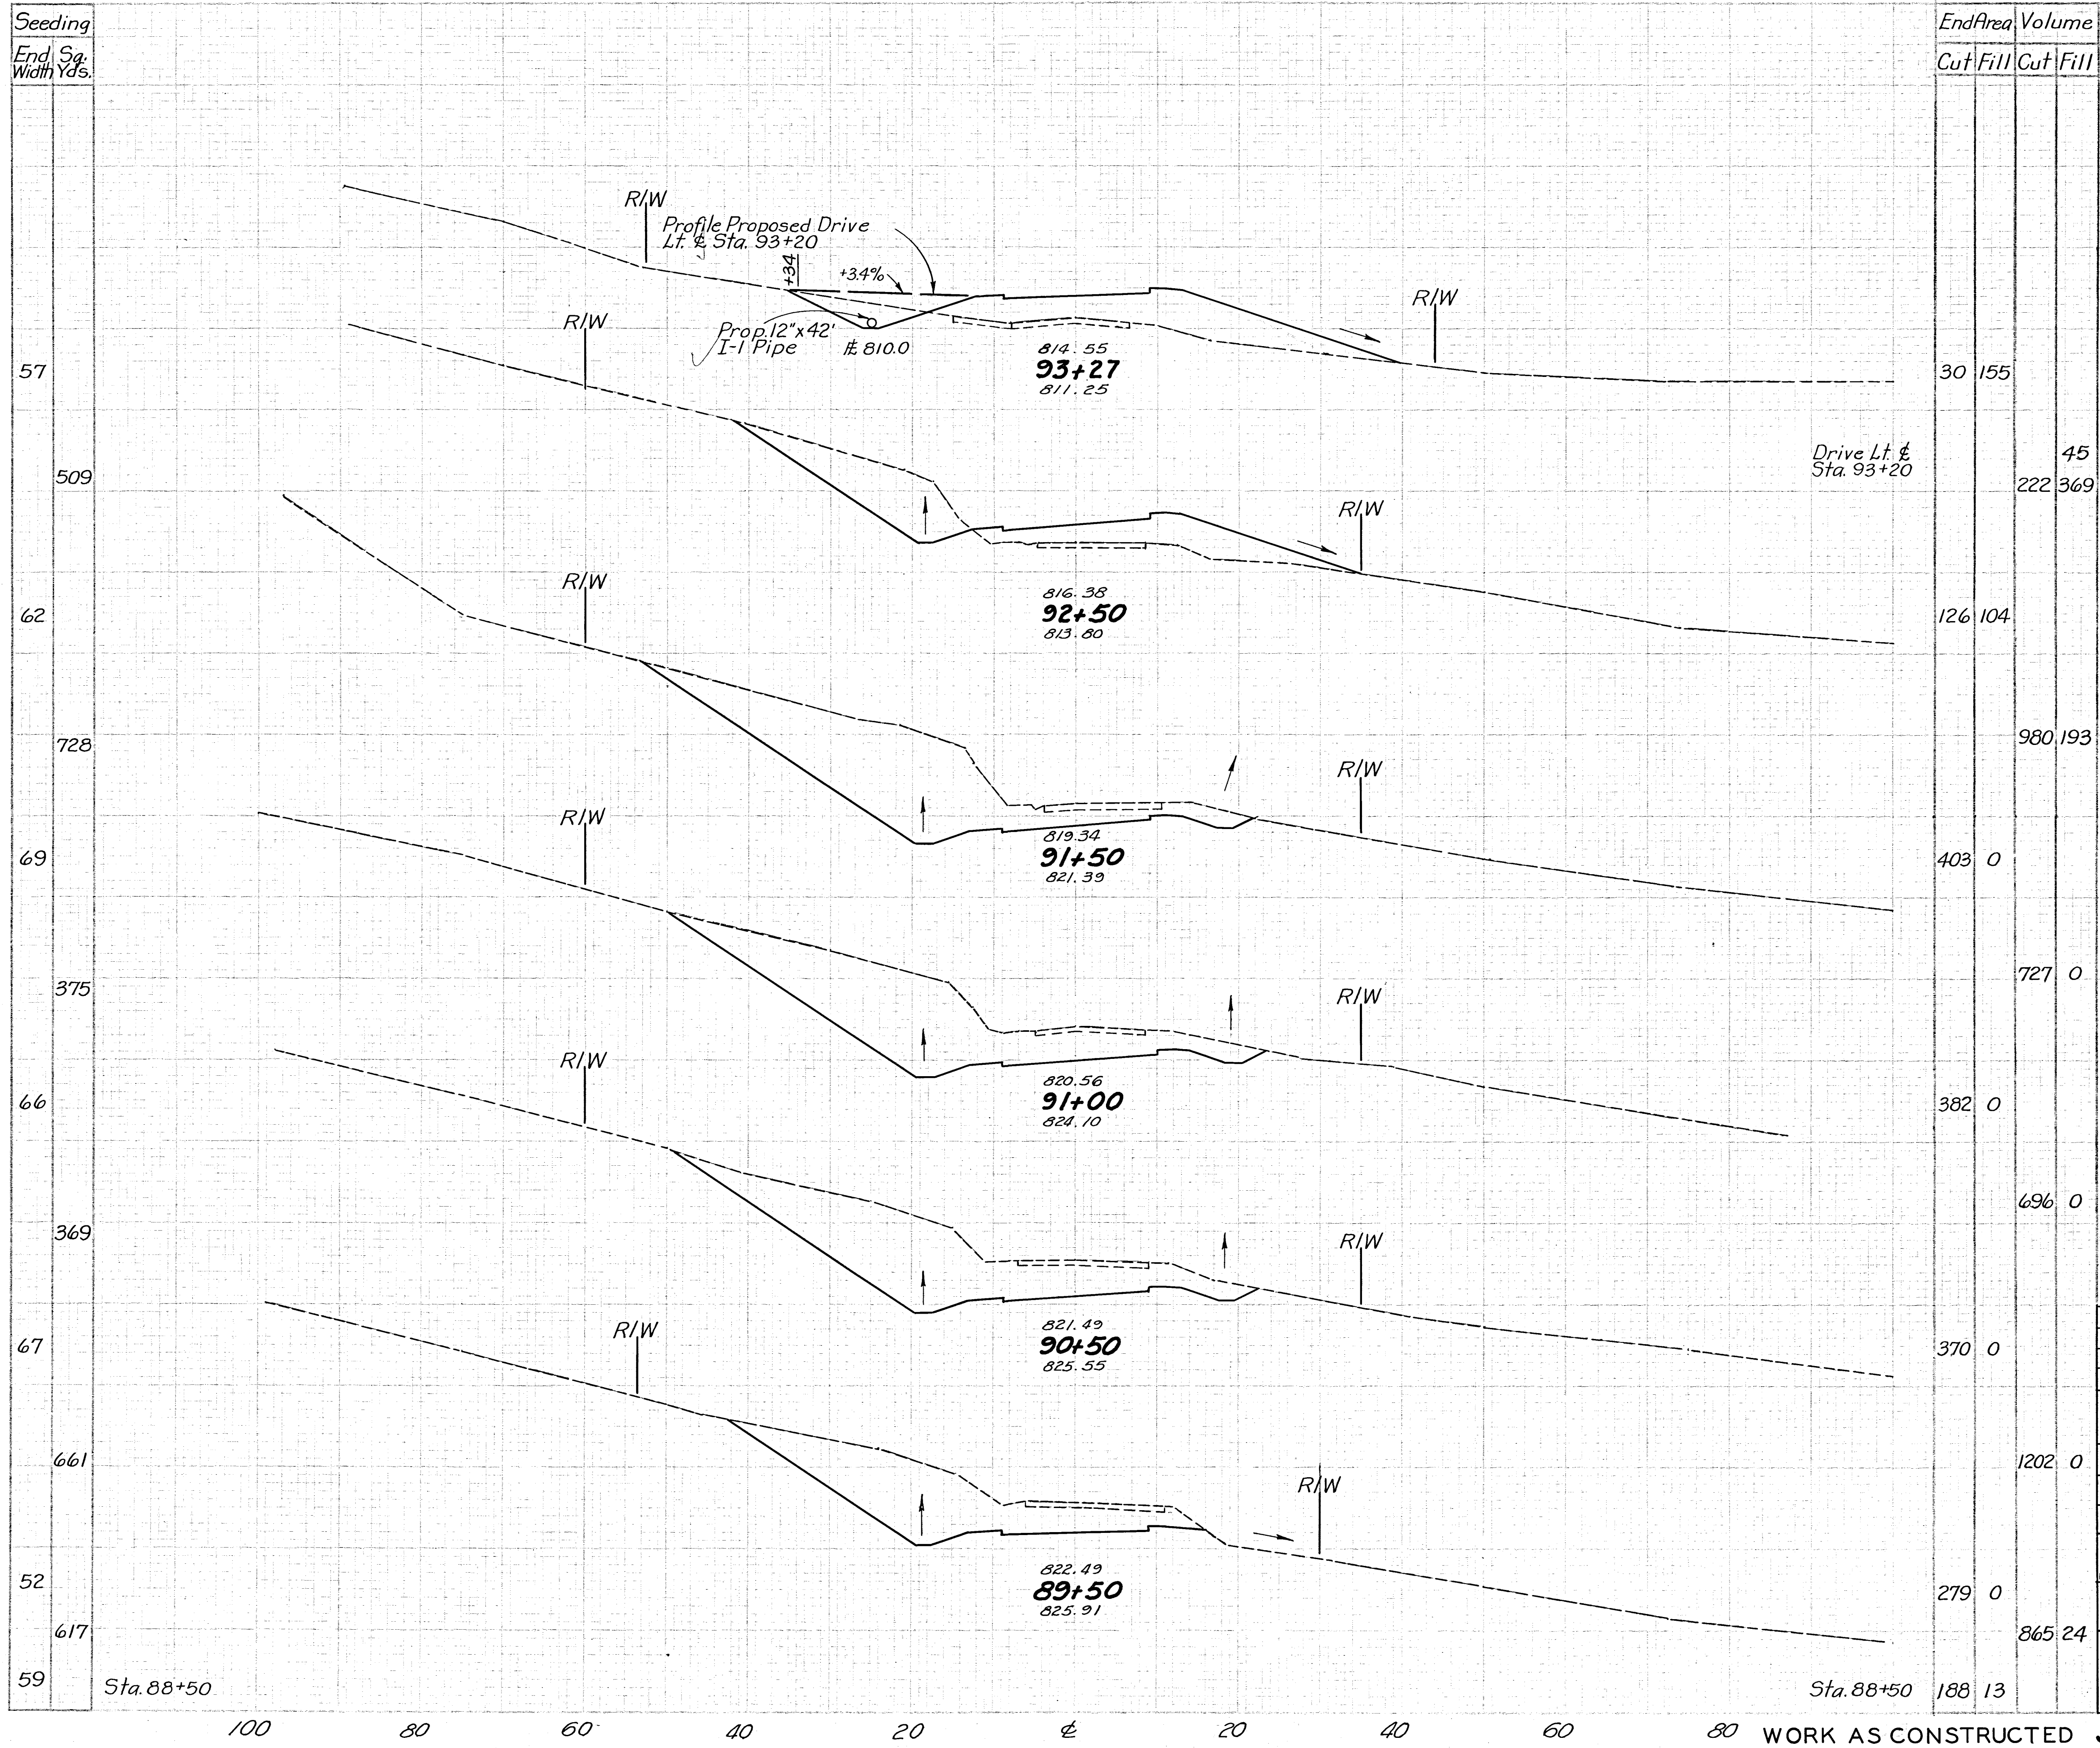

**MUSKINGUM COUNTY
COUNTY ROAD NO. 8**

29
83

REVISION	DATE	DESCRIPTION	BY
	3/23/62	AS CONSTRUCTED	H.F.K.
U. S. ARMY ENGINEER DISTRICT HUNTINGTON CORPS OF ENGINEERS HUNTINGTON, W. VA.			
DRAWN BY: WIC		LICKING RIVER DILLON RESERVOIR PROJECT	
TRACED BY:		RELOCATION OF MUSKINGUM COUNTY ROAD NO. 8	
CHECKED BY: FHL		MC-8-4 & MT-408-1 MC-8-1 & MC-408-1	
SUBMITTED BY: Elmer S. Barrett Associates		APPROVED: Steven Malenich	
RECOMMENDED: Elmer S. Barrett Associates		DATE: NOVEMBER 1959	
CHIEF ENG. DIS		COL. C. E. DISTRICT ENGINEER	
ELMER S. BARRETT ASSOCIATES CONSULTING ENGINEERS CHILLICOTHE, OHIO		SCALE: 1"=10' DRAWING NUMBER 027-UD 14-68/29 SHEET 29 OF 83	

STA. 89+50 To STA. 93+27