


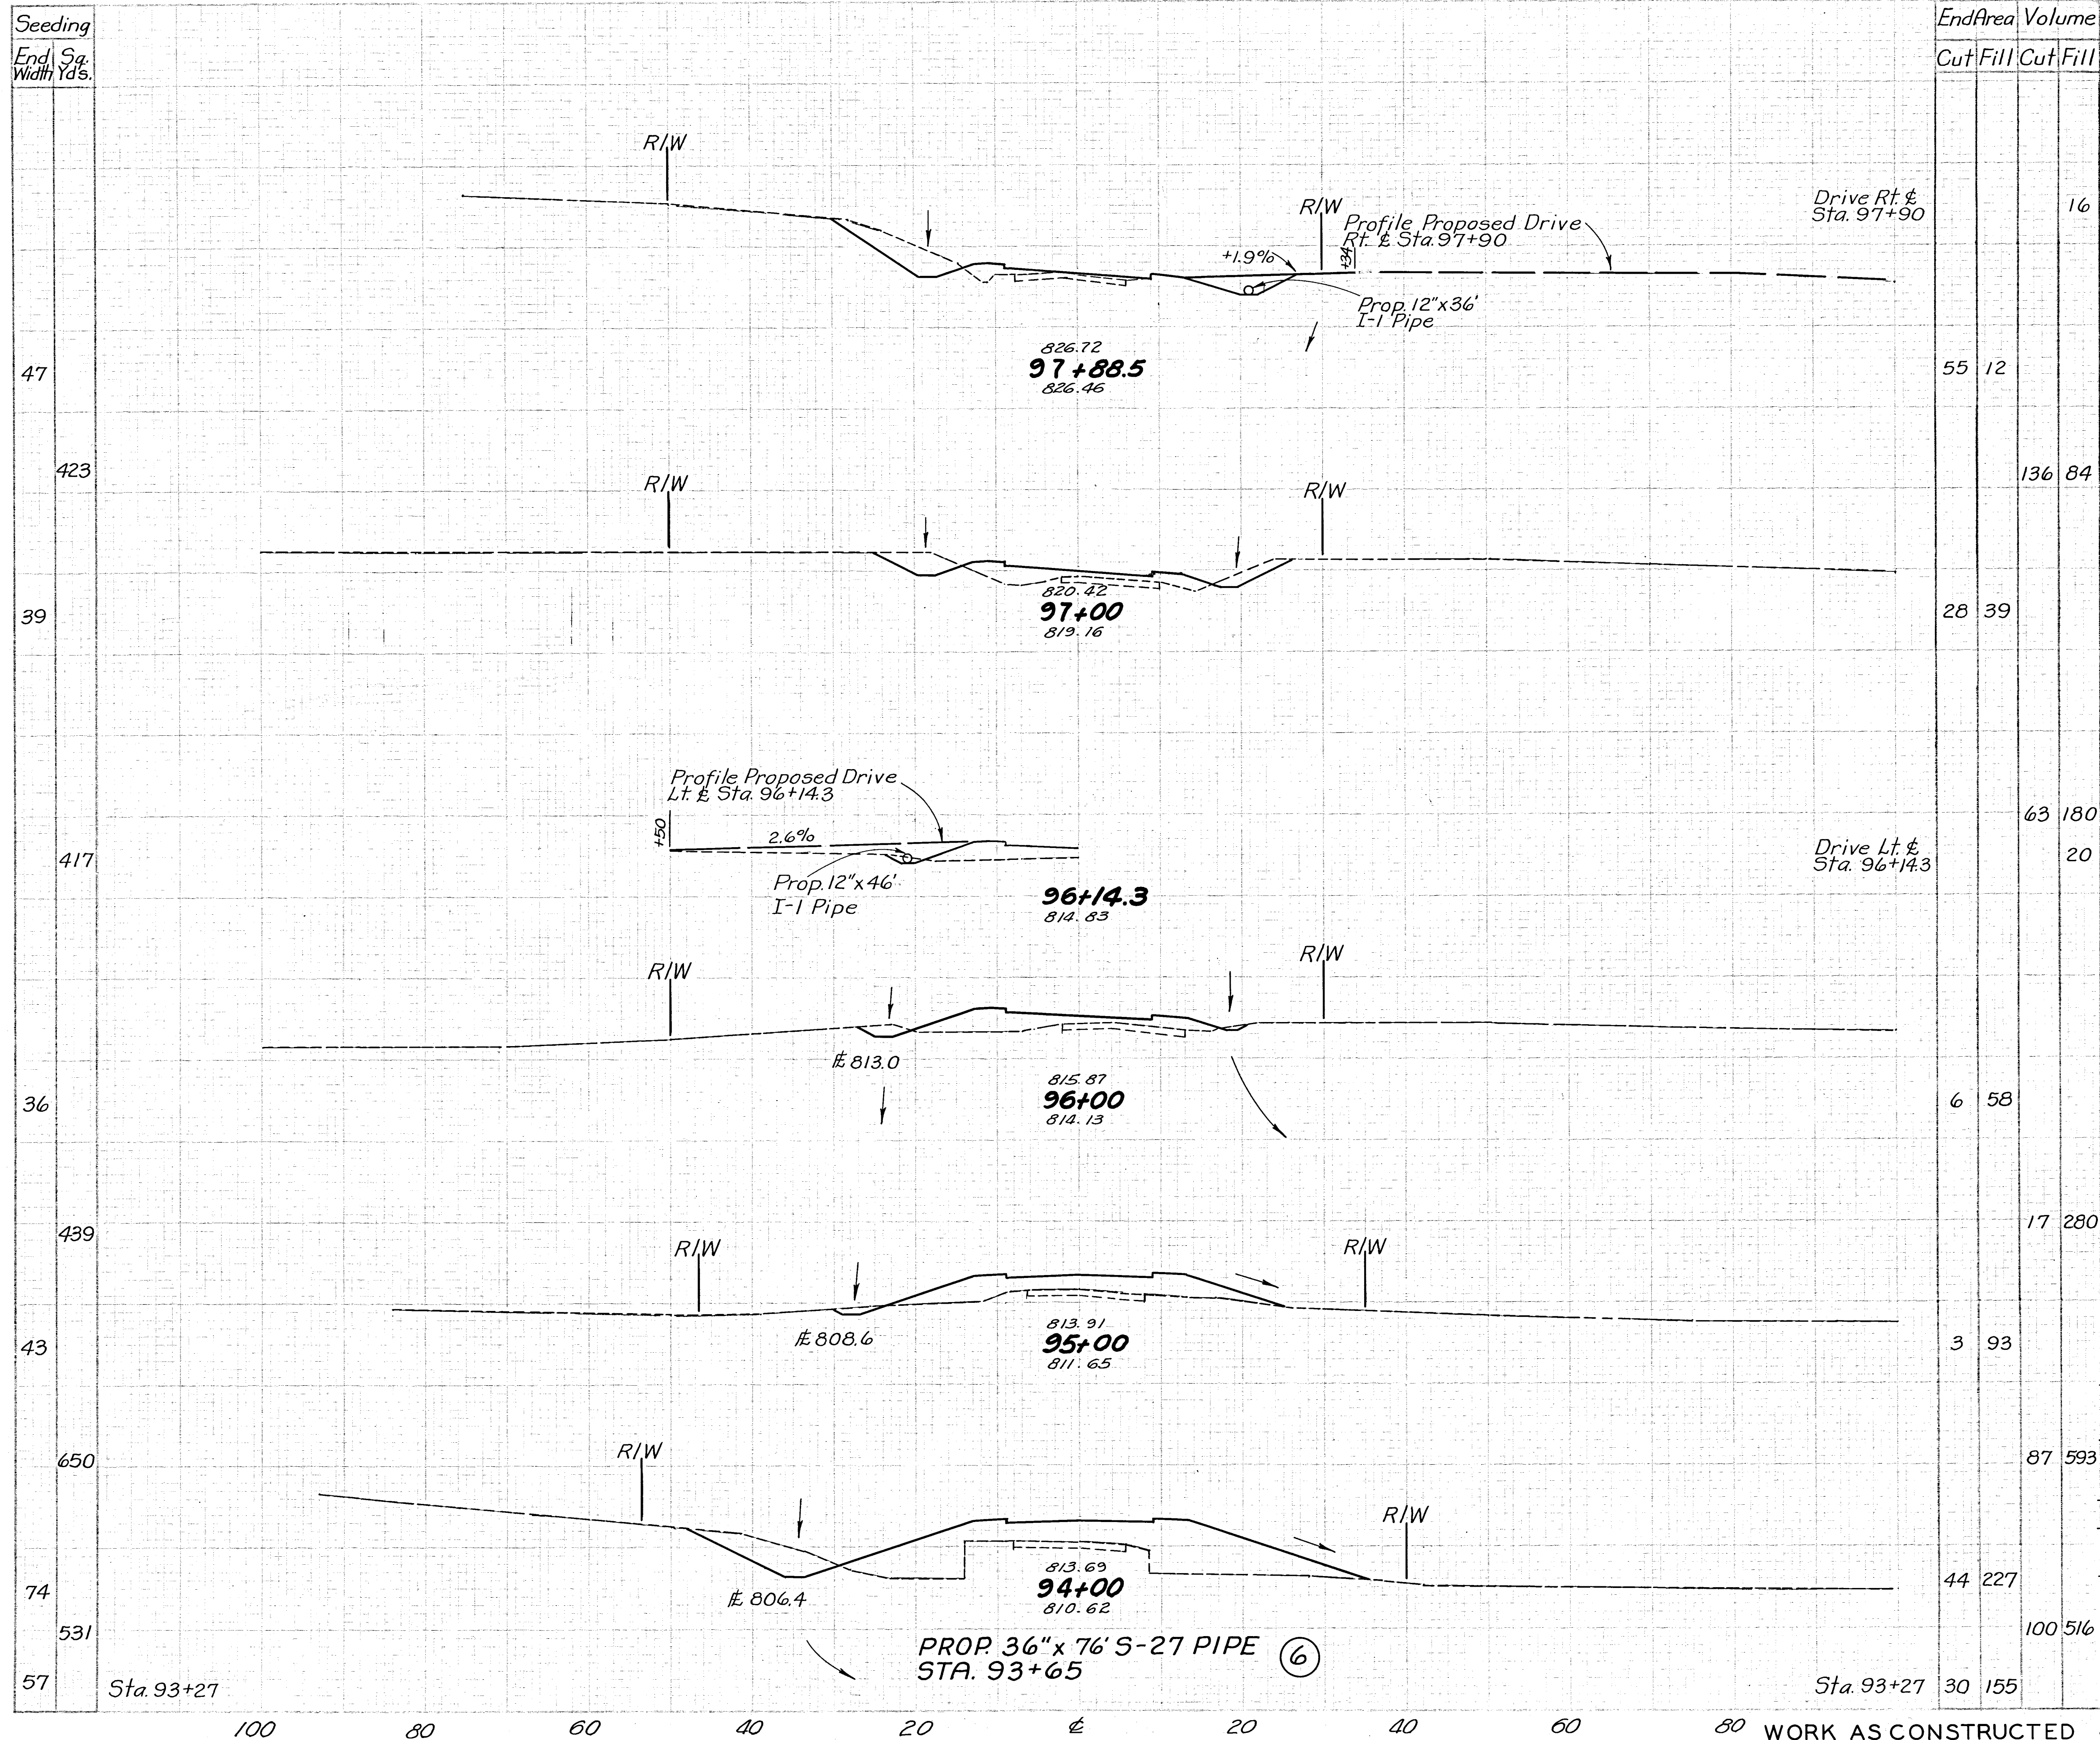

**MUSKINGUM COUNTY
COUNTY ROAD NO. 8**

30
83

REVISION	DATE	DESCRIPTION	BY
	3/23/62	AS CONSTRUCTED	H.E.K.
U. S. ARMY ENGINEER DISTRICT HUNTINGTON CORPS OF ENGINEERS HUNTINGTON, W. VA.			
DRAWN BY: WIC		LICKING RIVER DILLON RESERVOIR PROJECT	
CHECKED BY: JHL		RELOCATION OF MUSKINGUM COUNTY ROAD NO. 8	
SUBMITTED BY: Elmer S. Barrett Associates		MC-8-4 & MT- 408-1 MC-8-1 & MC- 408-1	
RECOMMENDED: [Signature]		APPROVED: Steven Malenich	DATE: NOVEMBER 1959
CHIEF ENG. DIV.		COL. C. E. DISTRICT ENGINEER	
ELMER S. BARRETT ASSOCIATES CONSULTING ENGINEERS CHILLICOTHE, OHIO		SCALE: 1"=10' DRAWING NUMBER 027f-UD 14- 68/30 SHEET 30 OF 83	