


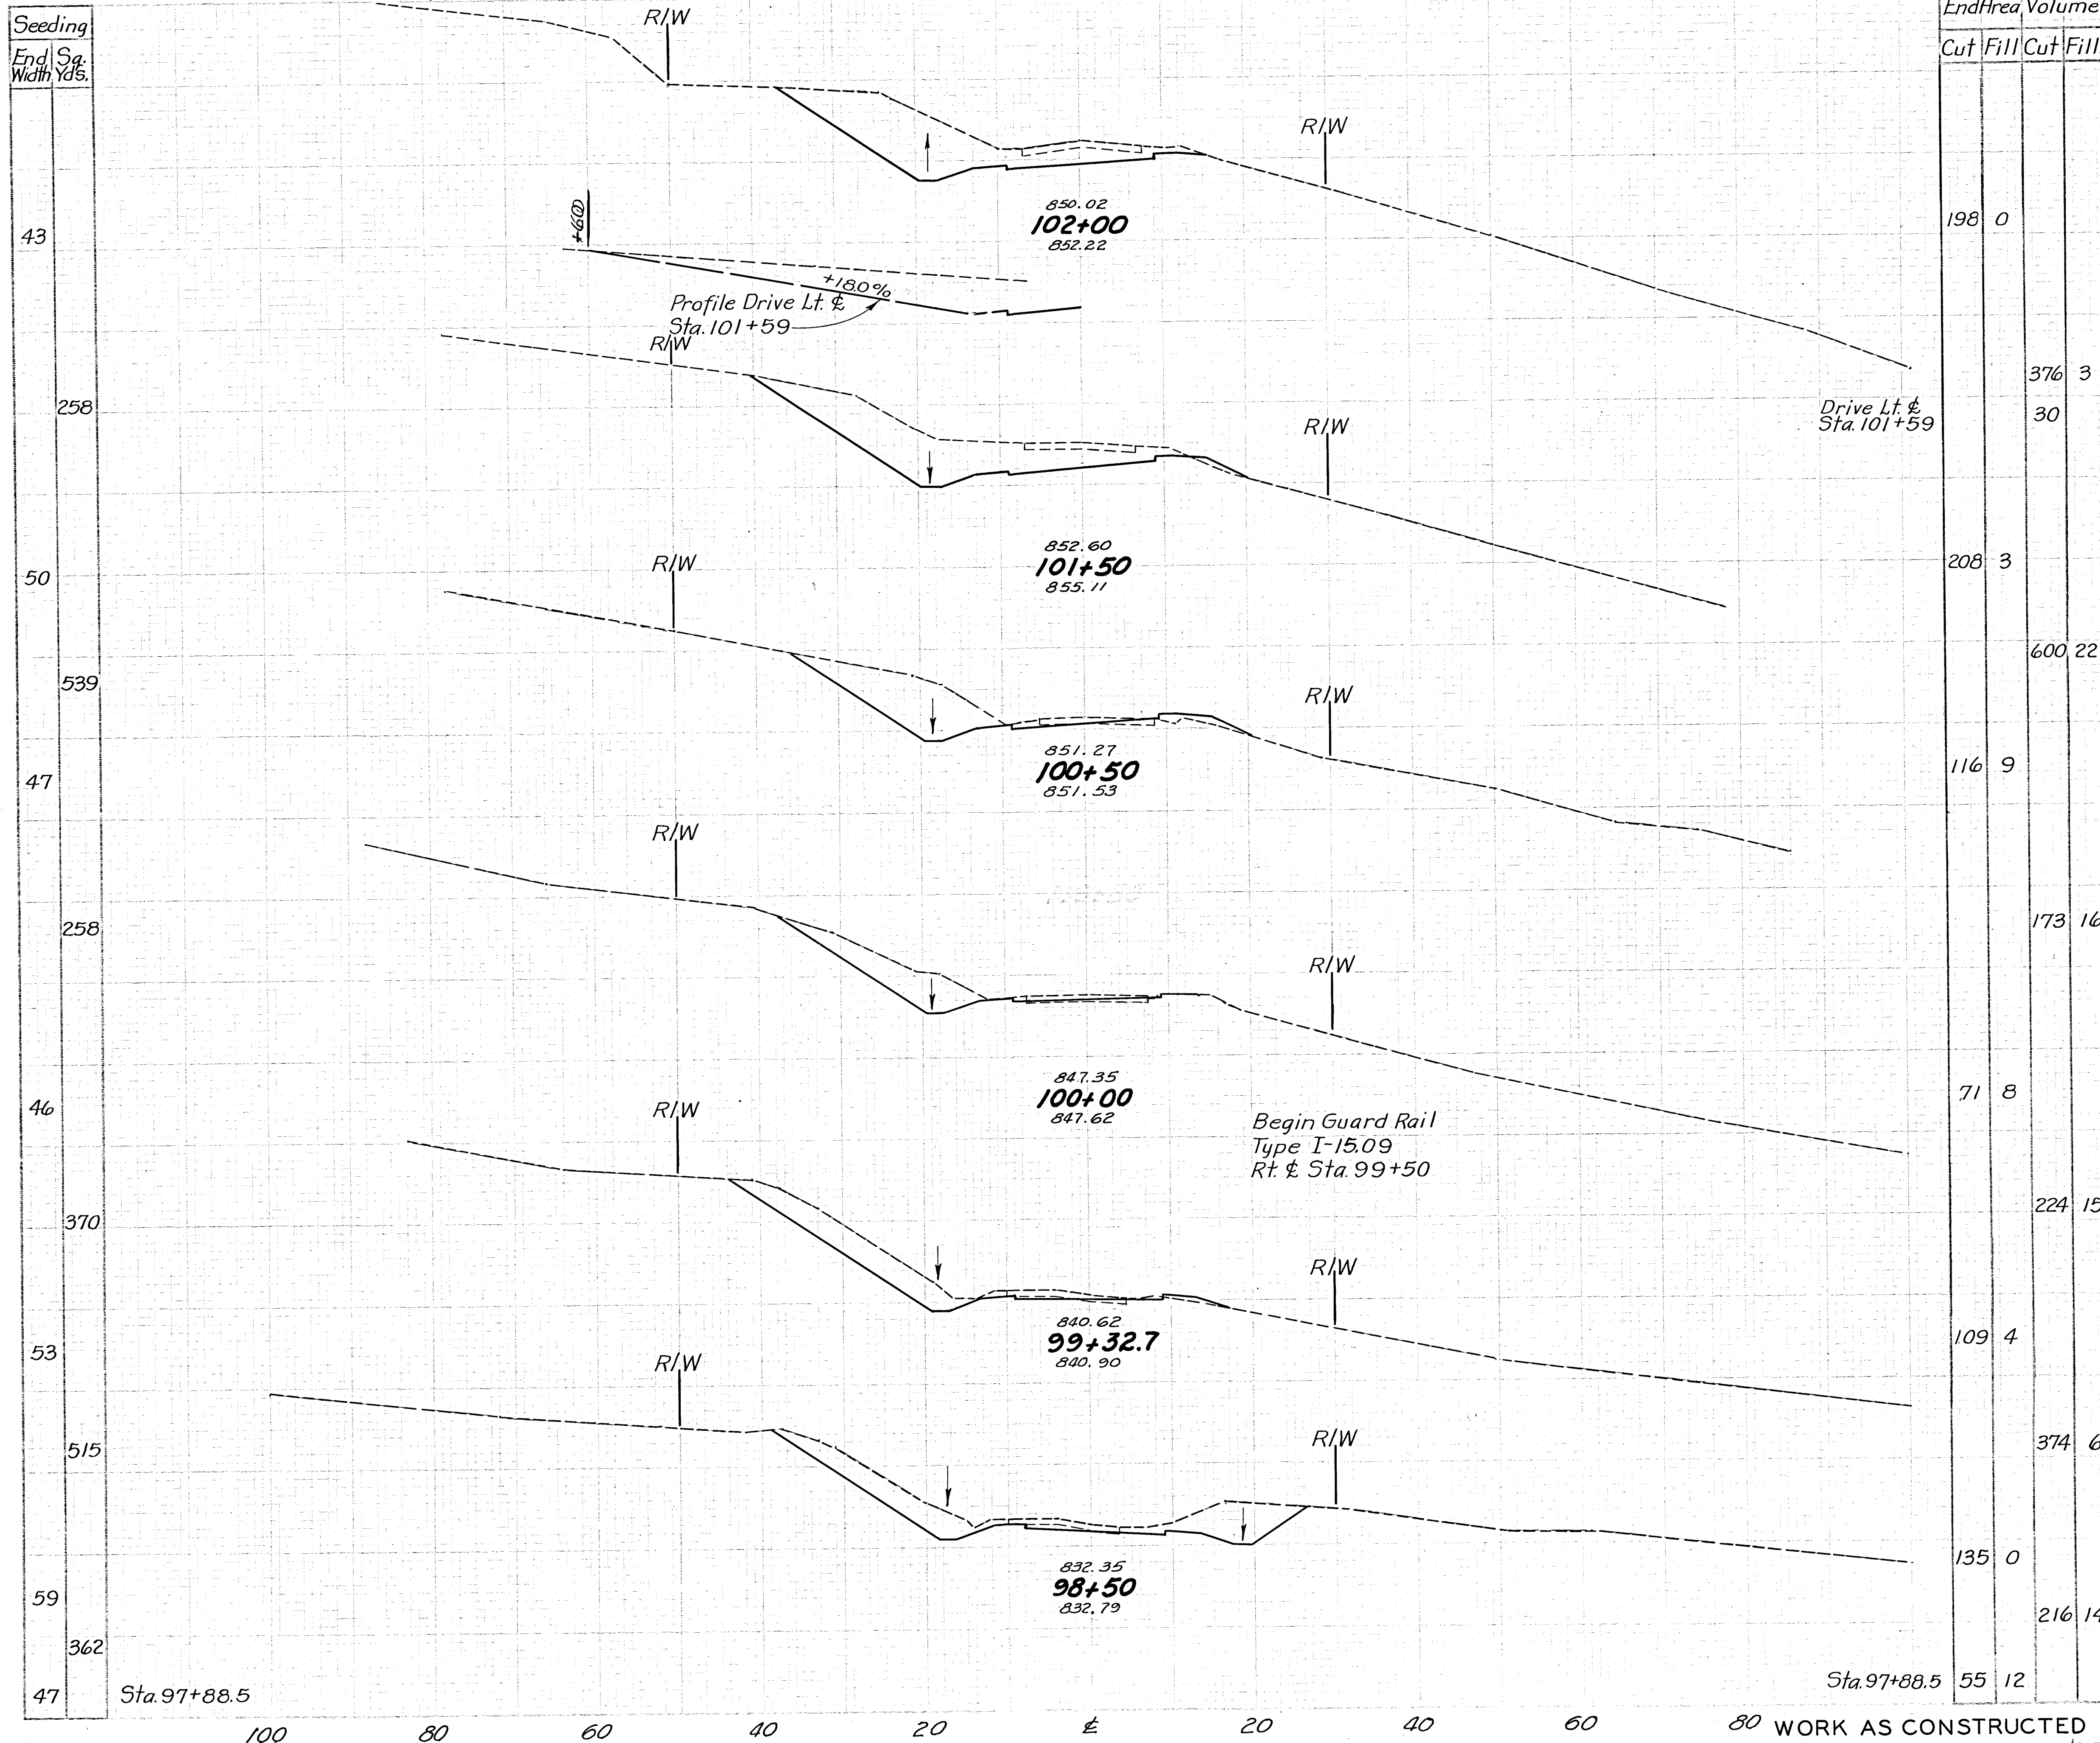

End Area		Volume	
Cut	Fill	Cut	Fill
198	0		
	376	3	
	30		
208	3		
	600	22	
	116	9	
	173	16	
	71	8	
	224	15	
	109	4	
	374	6	
	135	0	
	216	14	
55	12		

REVISION	3/23/62	AS CONSTRUCTED	H.F.K.
U. S. ARMY ENGINEER DISTRICT, HUNTINGTON CORPS OF ENGINEERS HUNTINGTON, W. VA.			
DRAWN BY: WIC		LICKING RIVER DILLON RESERVOIR PROJECT	
TRACED BY:		RELOCATION OF MUSKINGUM COUNTY ROAD NO. 8	
CHECKED BY:		MC-8-4 & MT-408-1	
SUBMITTED BY:		MC-8-1 & MC-408-1	
ELMER S. BARRETT ASSOCIATES		DATE: NOVEMBER 1959	
RECOMMENDED:		APPROVED: Steven Malench	
CHIEF ENGR. DIV.		COL. C. E. DISTRICT ENGINEER	
ELMER S. BARRETT ASSOCIATES CONSULTING ENGINEERS CHILLICOTHE, OHIO		SCALE: 1"=10' DRAWING NUMBER 027f-UD 14-68/31 SHEET 31 of 83	

STA. 98+50 To STA. 102+00