


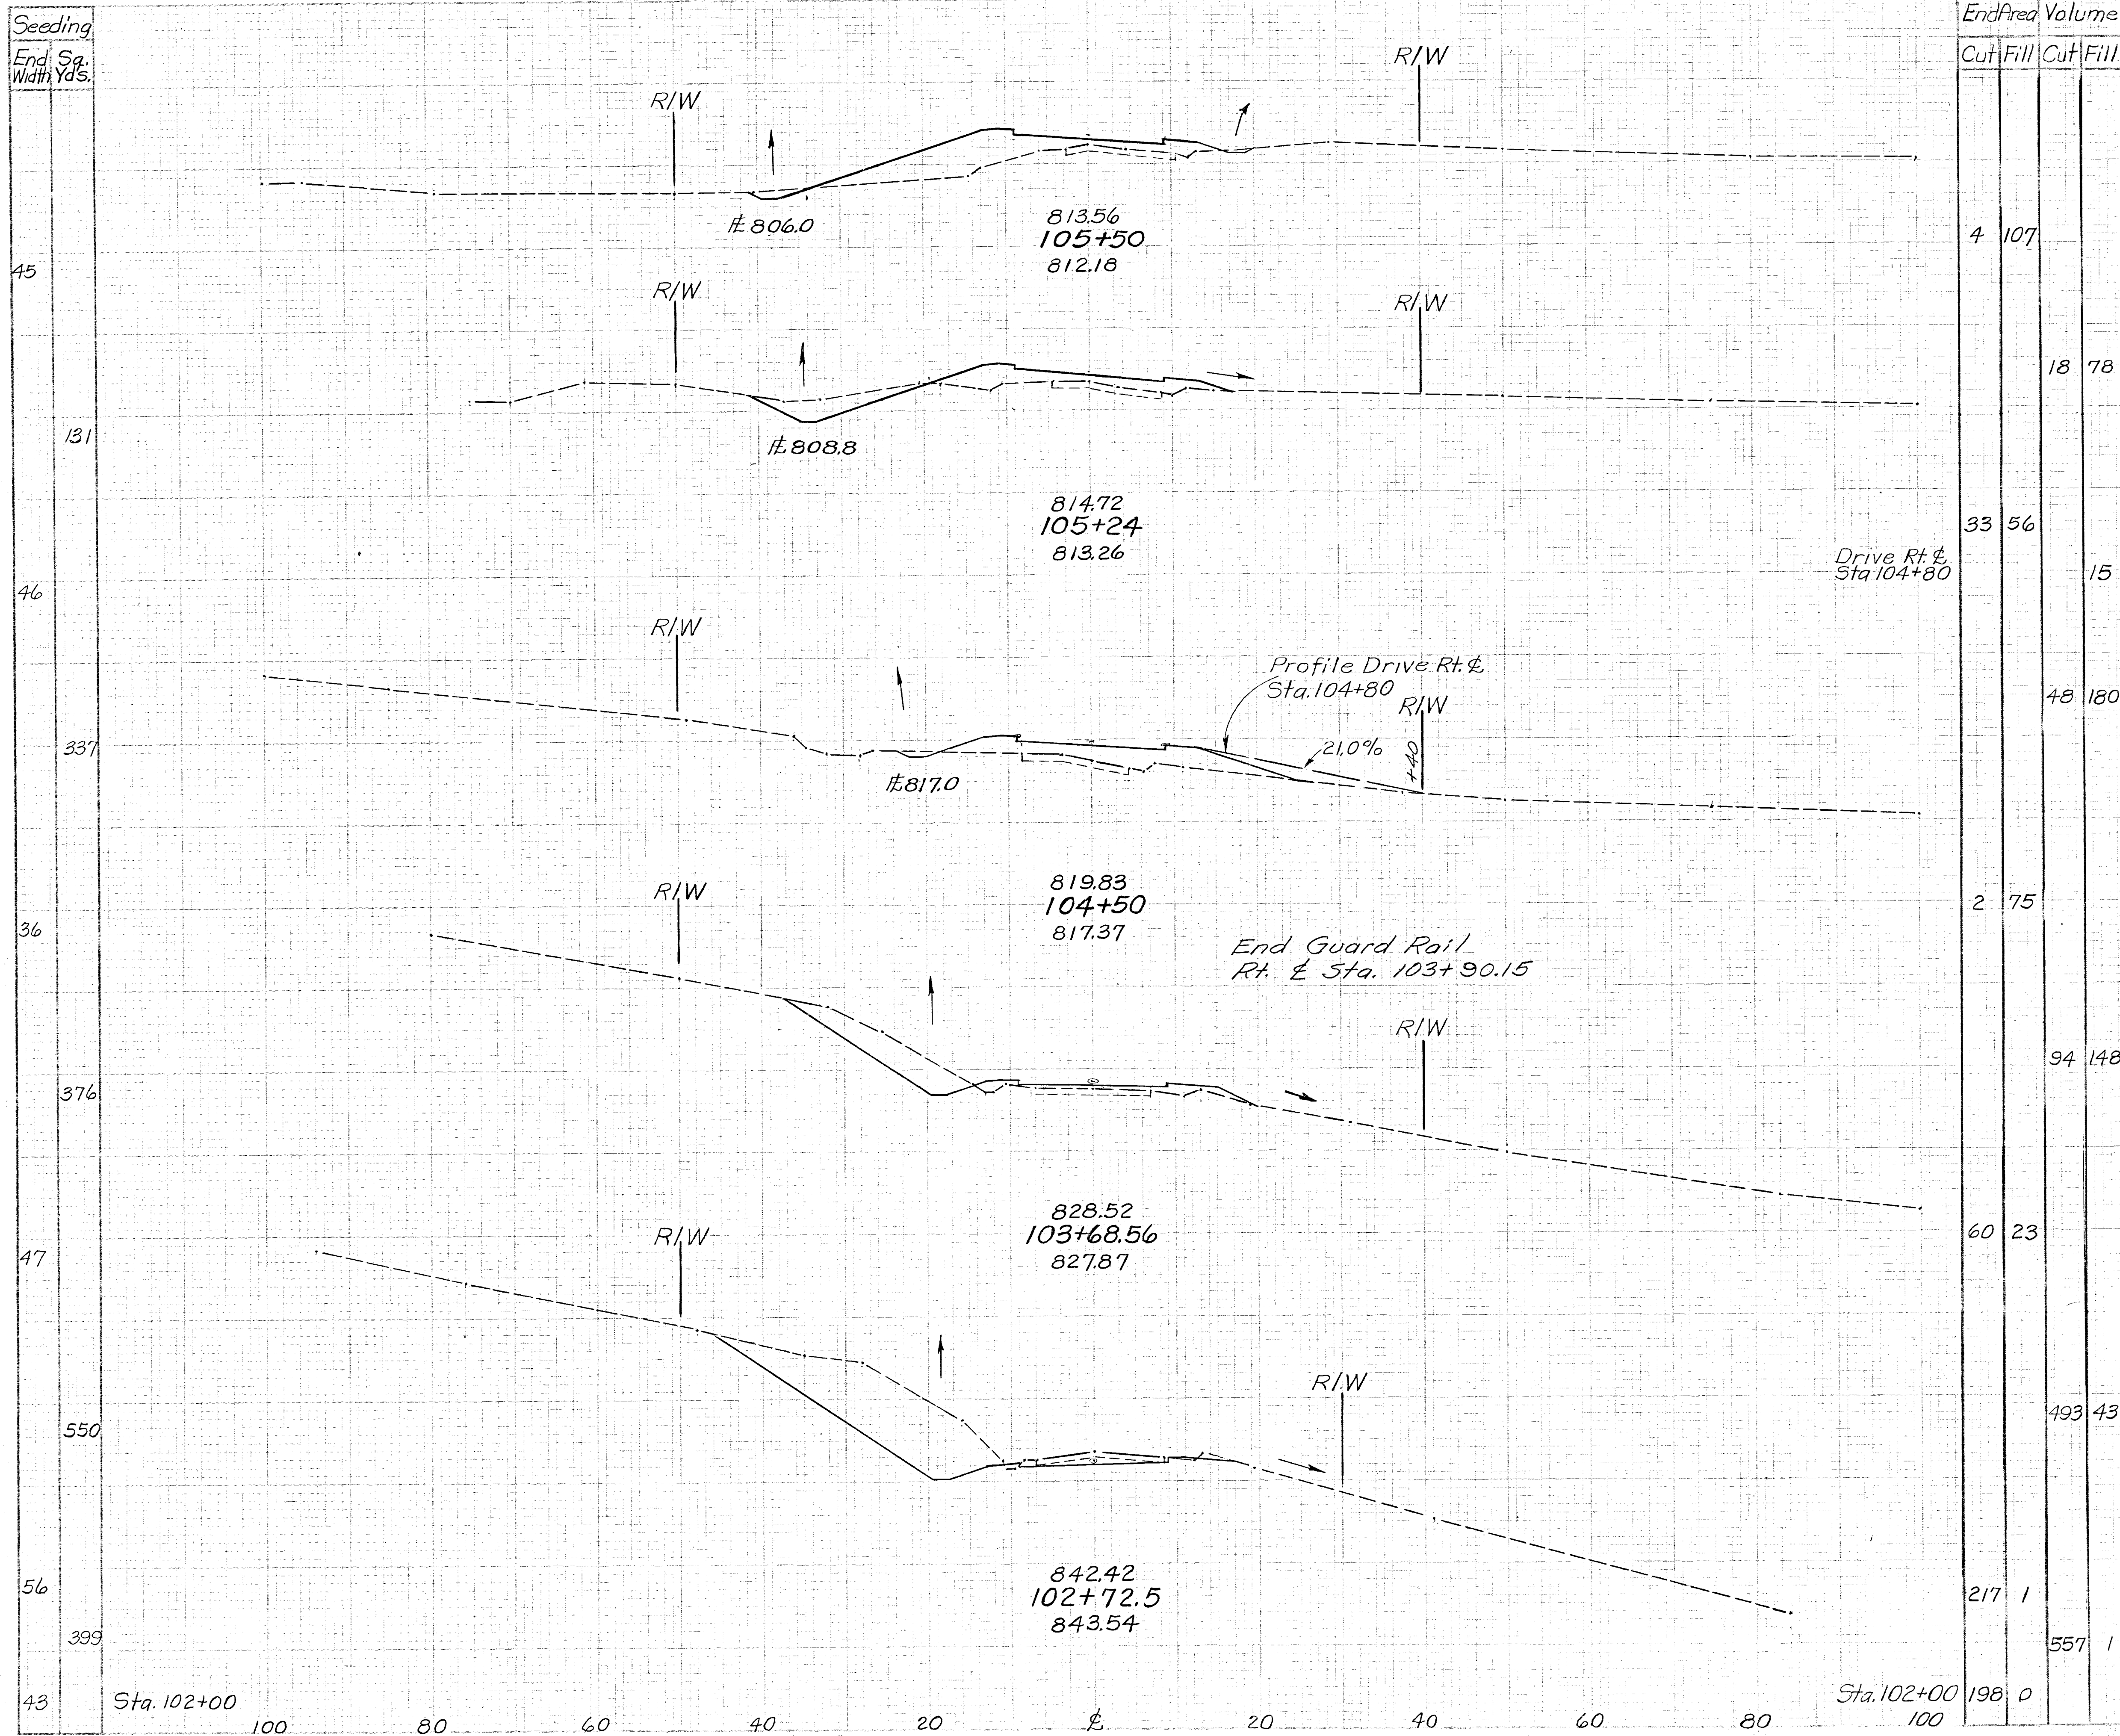

| End Area | Volume |        |
|----------|--------|--------|
|          | Cut    | Fill   |
| 4        | 107    |        |
|          |        | 18 78  |
| 33       | 56     |        |
|          |        | 15     |
| 48       | 180    |        |
| 2        | 75     |        |
|          |        | 94 148 |
| 60       | 23     |        |
|          |        | 493 43 |
| 217      | 1      |        |
|          |        | 557 1  |
| 198      | 0      |        |

|                                                                                      |         |                                                                   |        |
|--------------------------------------------------------------------------------------|---------|-------------------------------------------------------------------|--------|
| REVISION                                                                             | DATE    | DESCRIPTION                                                       | BY     |
|                                                                                      | 3/23/62 | AS CONSTRUCTED                                                    | H.F.K. |
| U. S. ARMY ENGINEER DISTRICT, HUNTINGTON<br>CORPS OF ENGINEERS<br>HUNTINGTON, W. VA. |         |                                                                   |        |
| DRAWN BY: WIC                                                                        |         | LICKING RIVER<br>DILLON RESERVOIR PROJECT                         |        |
| CHECKED BY: F.H.B.                                                                   |         | RELOCATION OF MUSKINGUM COUNTY ROAD NO. 8                         |        |
| SUBMITTED BY: Elmer S. Barrett Associates                                            |         | MC-8-4 & MT-408-1<br>MC-8-1 & MC-408-1                            |        |
| RECOMMENDED: James J. Barrett                                                        |         | APPROVED: Steven Malovich<br>COL. C. E. DISTRICT ENGINEER         |        |
| DATE: NOVEMBER 1959                                                                  |         | SCALE: 1" = 10'                                                   |        |
| ELMER S. BARRETT ASSOCIATES<br>CONSULTING ENGINEERS<br>CHILLICOTHE, OHIO             |         | SPEC. NO.<br>DRAWING NUMBER<br>027f-UD 14-68/32<br>SHEET 32 OF 83 |        |

STA. 102+72.50 TO STA. 105+50