


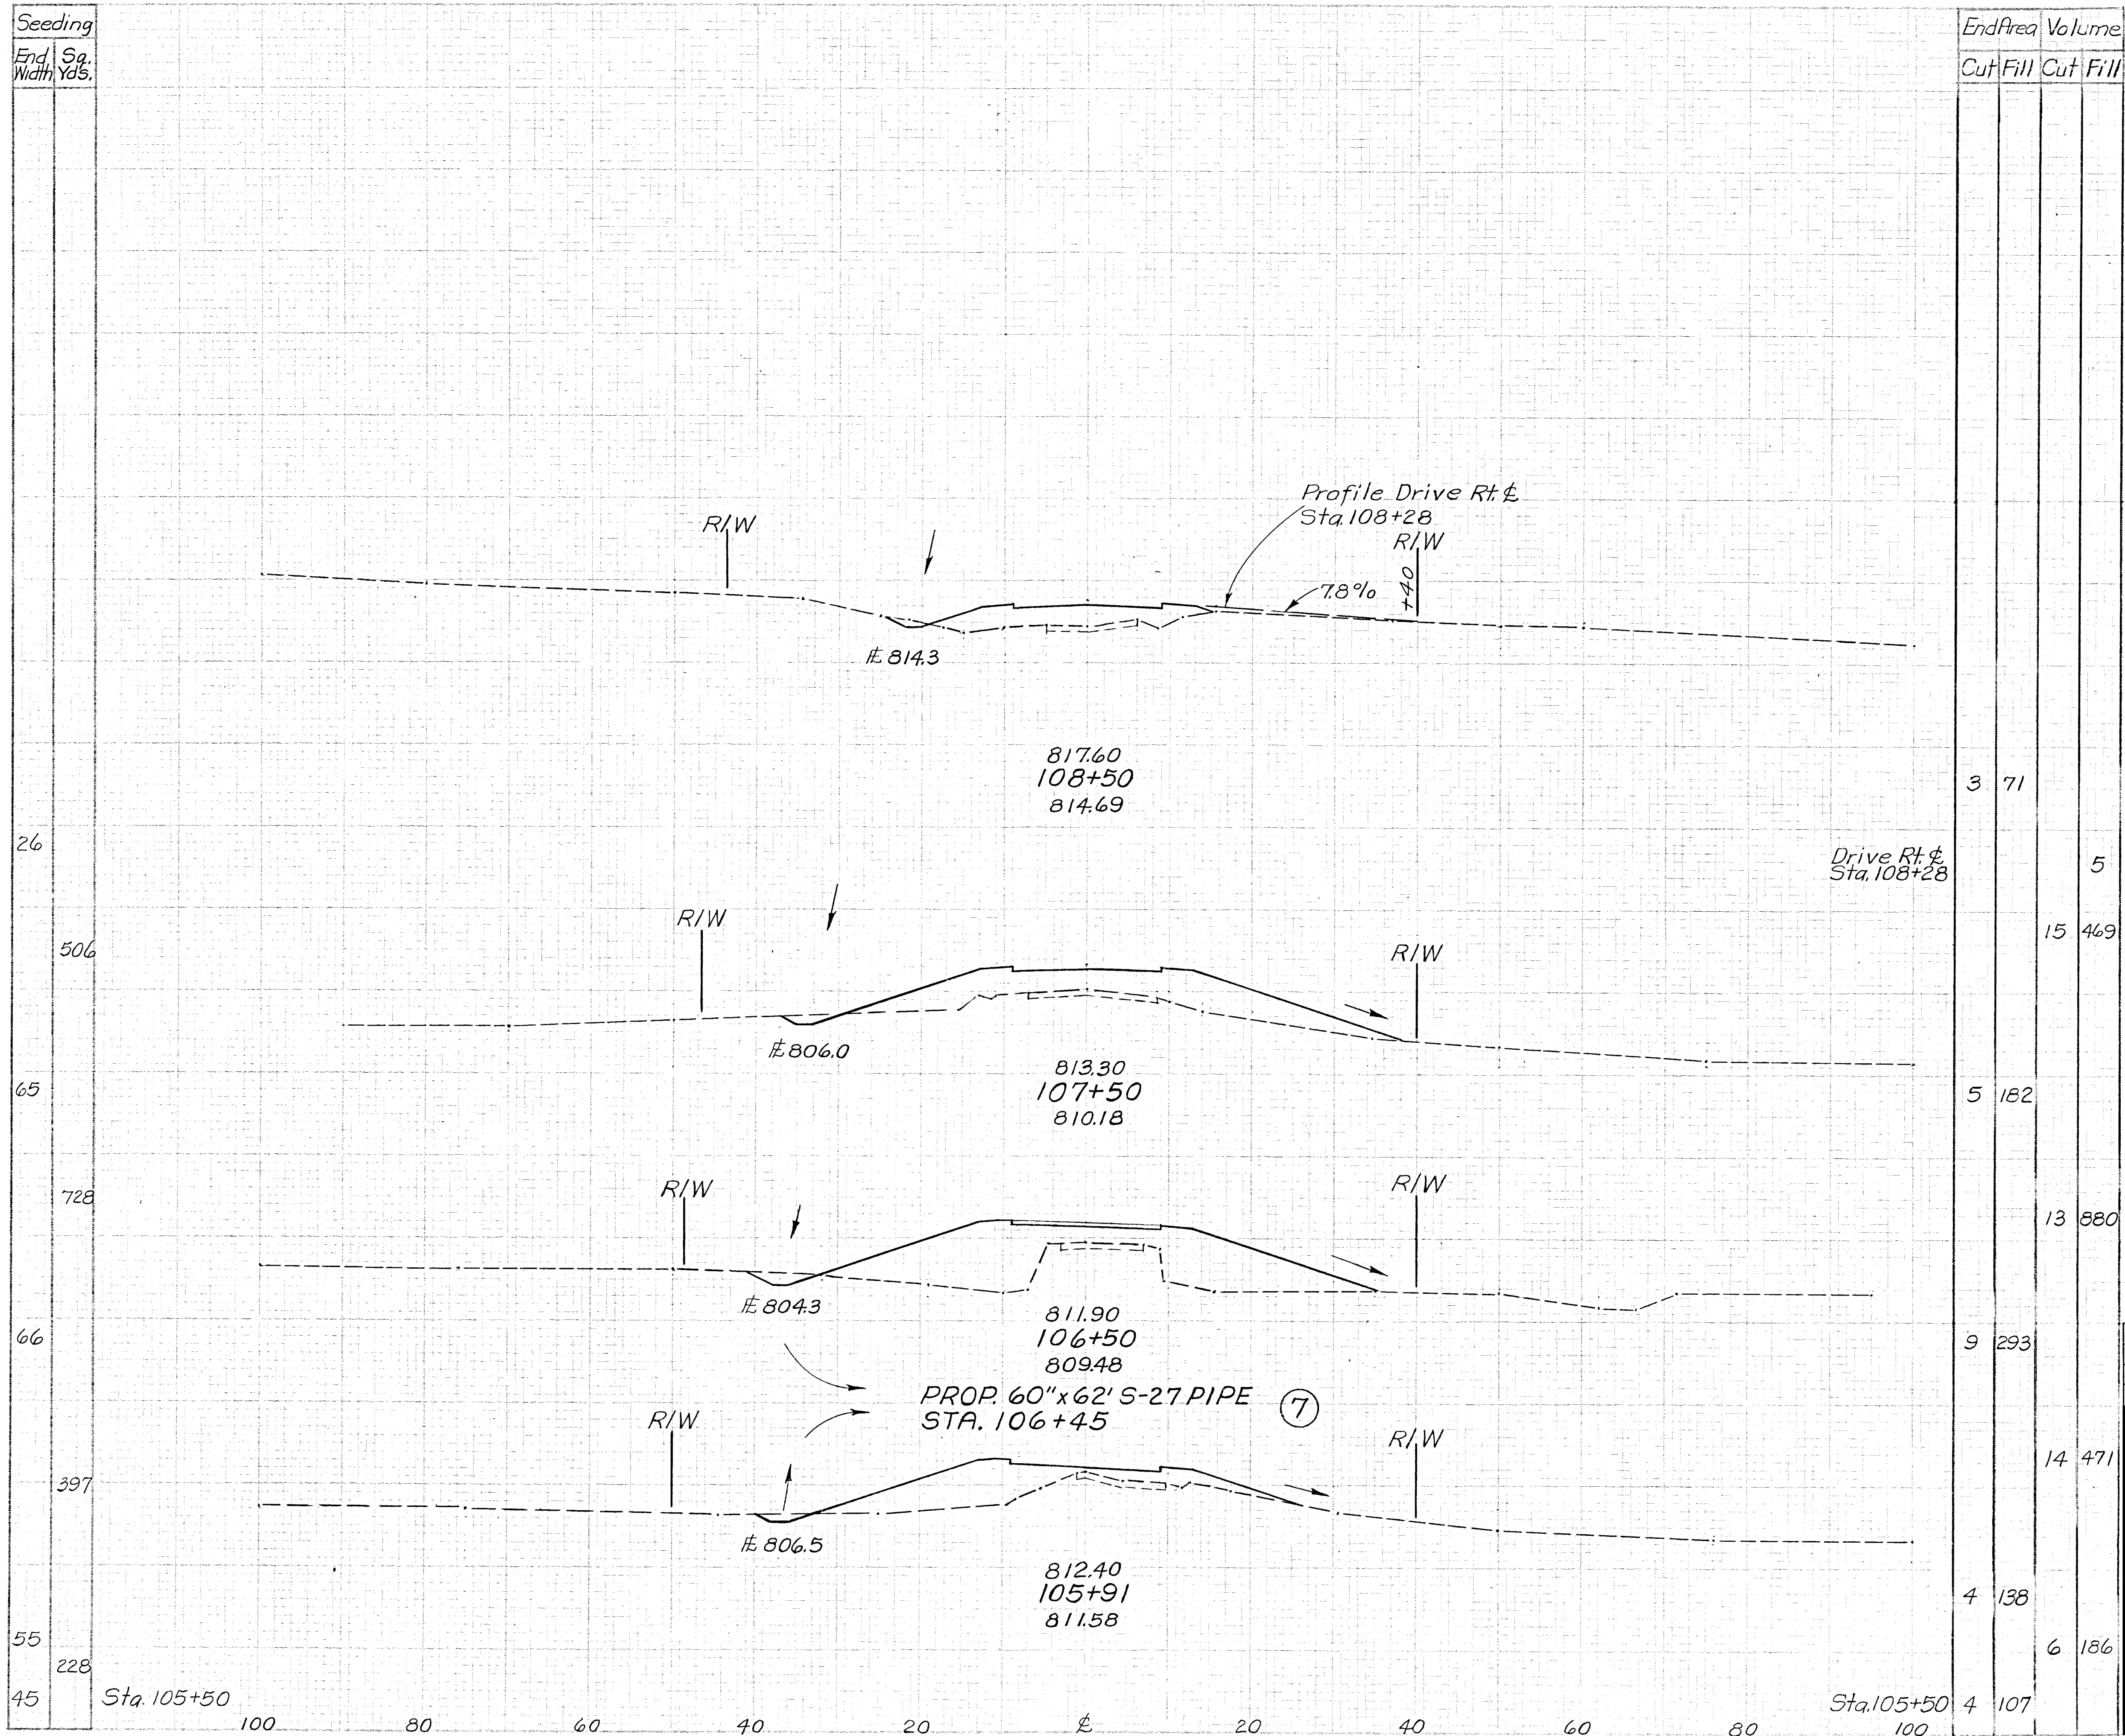

MUSKINGUM COUNTY
COUNTY ROAD NO. 8

33
83

3/23/62		AS CONSTRUCTED		H.F.K.
REVISION	DATE	DESCRIPTION		BY
U. S. ARMY ENGINEER DISTRICT, HUNTINGTON CORPS OF ENGINEERS HUNTINGTON, W. VA.				
DRAWN BY: W/C		LICKING RIVER DILLON RESERVOIR PROJECT		
CHECKED BY: J.H.B.		RELOCATION OF MUSKINGUM COUNTY ROAD NO. 8		
SUBMITTED BY: Elmer S. Barrett		MC-8-4 8MT-408-1 MC-8-1 8MC-408-1		
RECOMMENDED BY: J. S. Barrett		APPROVED: Steven Malevel		
CHIEF ENG. DIV.		DATE: NOVEMBER 1959		
ELMER S. BARRETT ASSOCIATES CONSULTING ENGINEERS CHILLICOTHE, OHIO		SCALE: 1"=10' DRAWING NUMBER 0271-UD 14-68/33 SHEET 33 OF 83		