


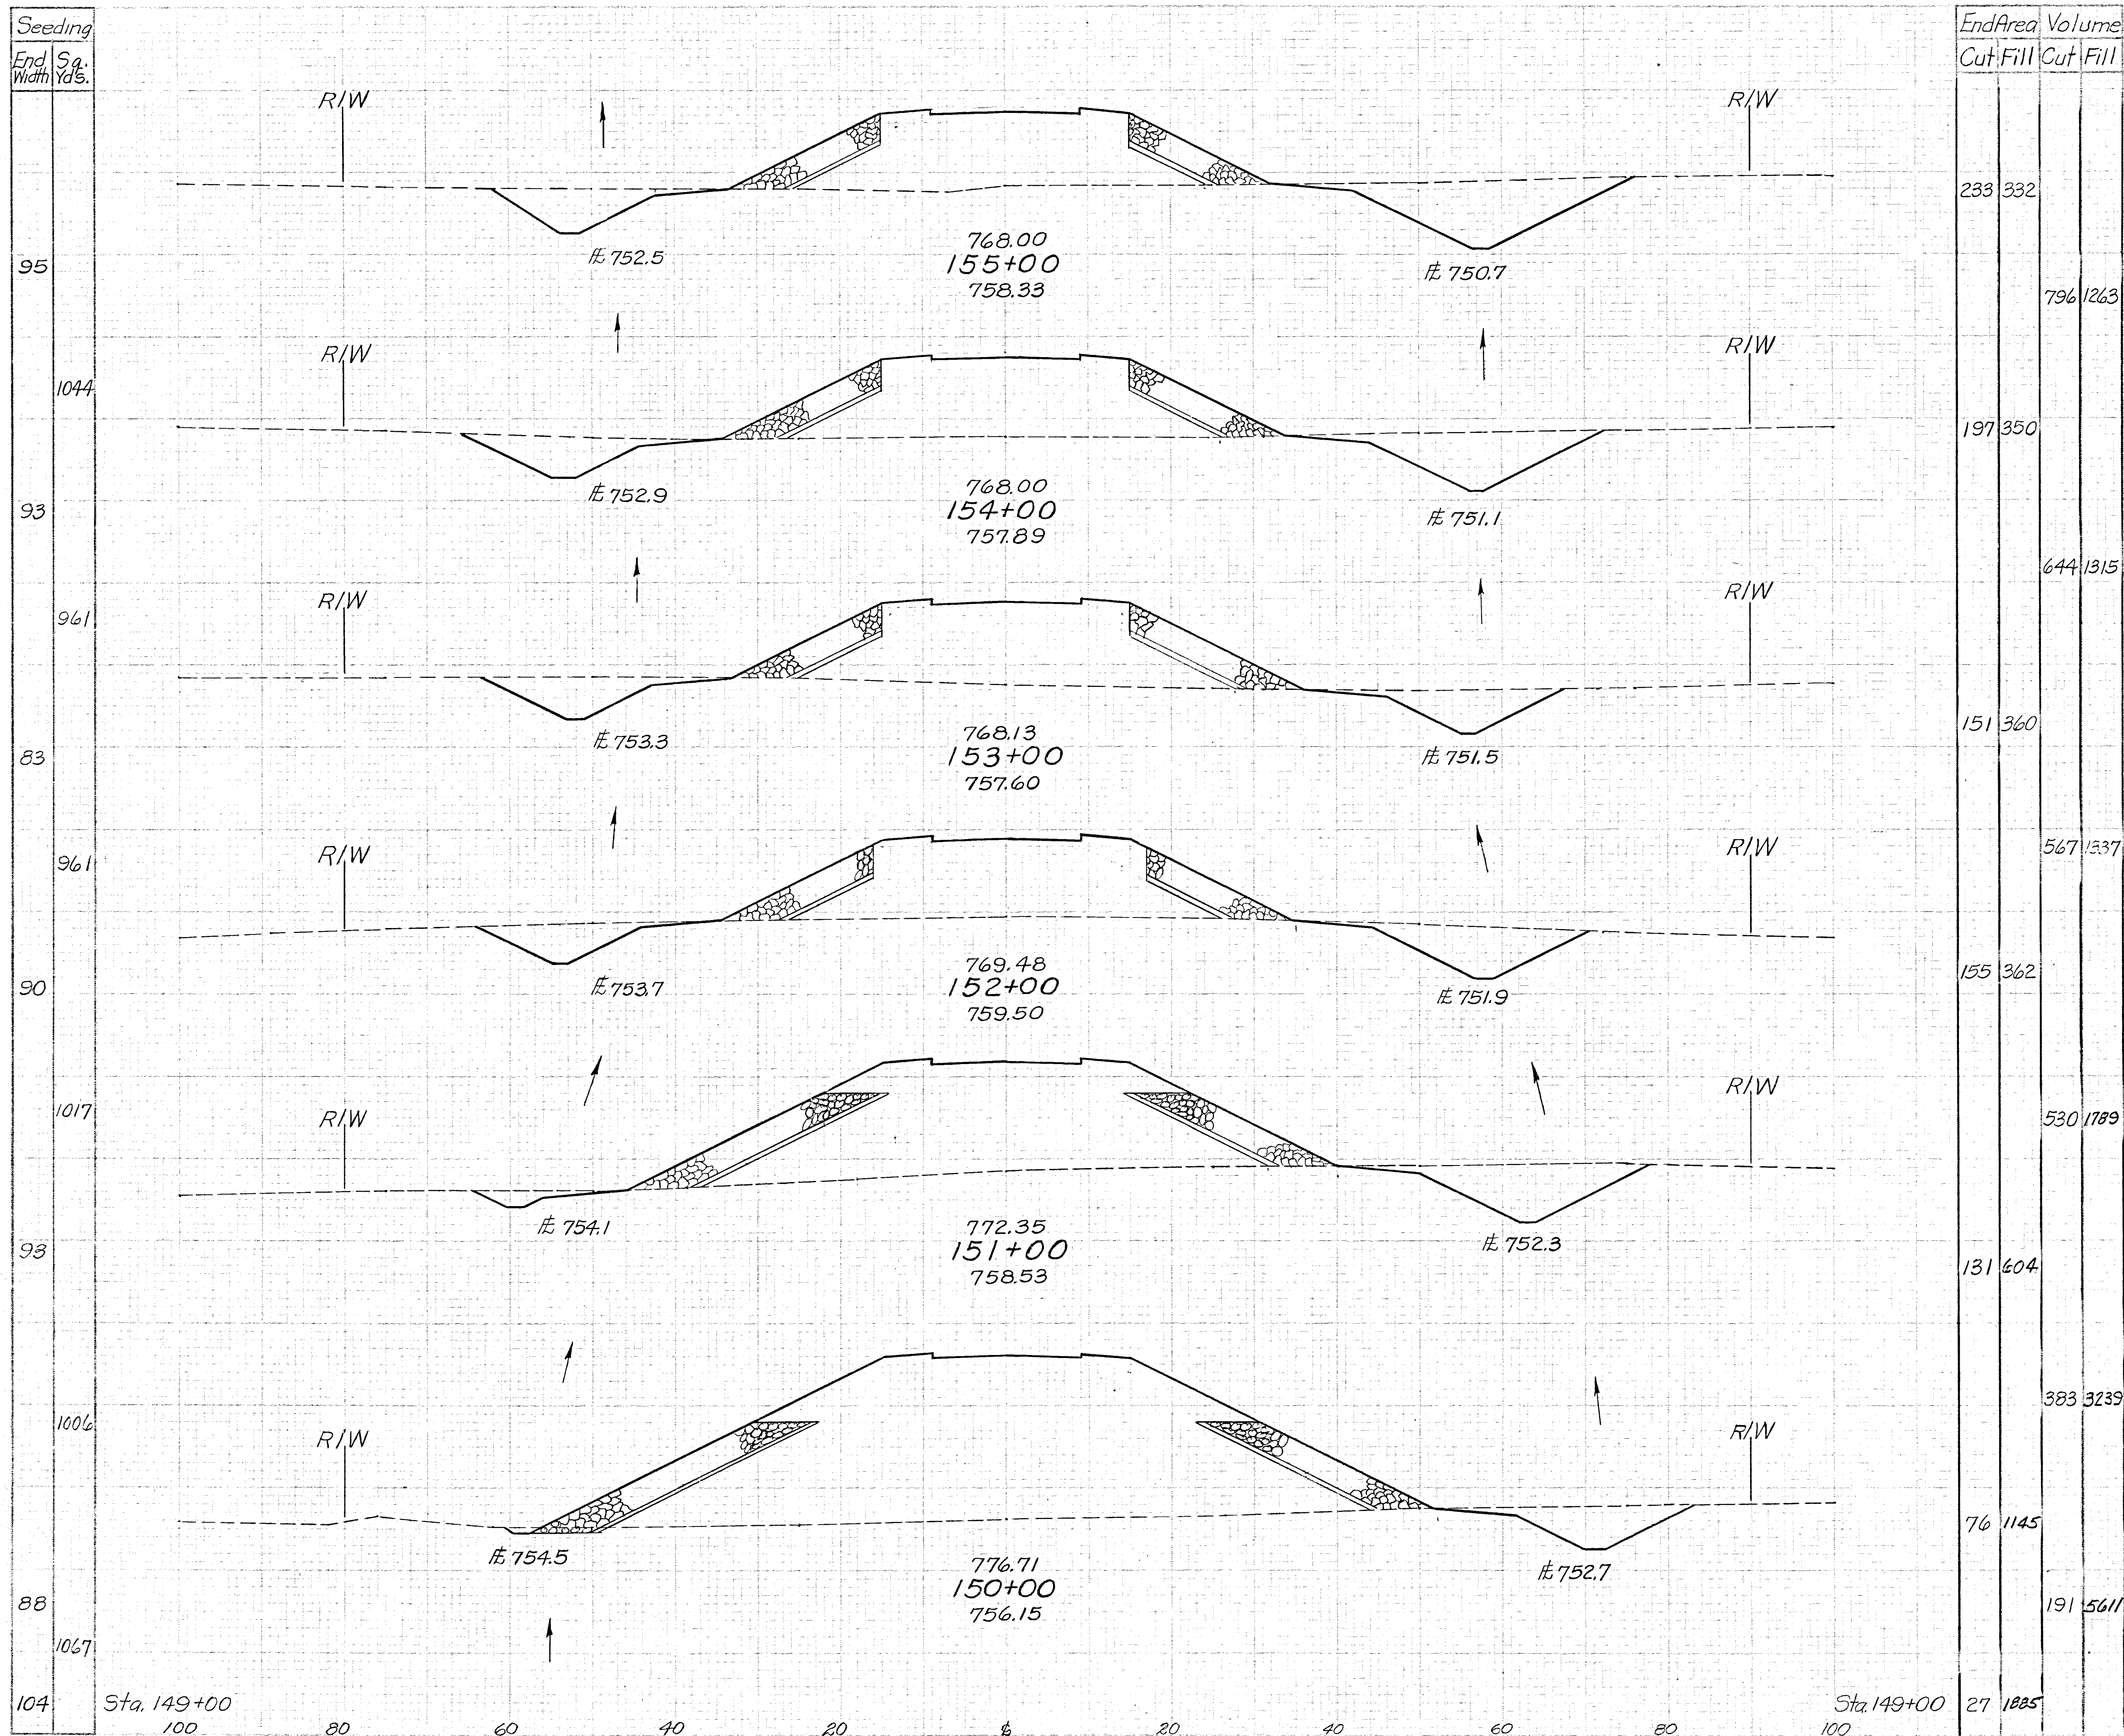

MUSKINGUM COUNTY COUNTY ROAD NO. 8

End Area	Volume	End Area	Volume
95	233 332	98	12
1044	197 350	380	48
93	644 1315	107	14
961	151 360	402	52
83	567 1337	387	48
961	155 362	99	12
90	530 1789	443	72
1017	131 604	Sta. 151+00 140	27
93	383 3239	563	100
1006	76 1145	Sta. 150+00 164	27
88	191 5611	617	102
1067		Sta. 149+00 169	28

3/23/62		AS CONSTRUCTED	H.F. K.
REVISION	DATE	DESCRIPTION	BY
U. S. ARMY ENGINEER DISTRICT, HUNTINGTON CORPS OF ENGINEERS HUNTINGTON, W. VA.			
DRAWN BY: EER		LICKING RIVER DILLON RESERVOIR PROJECT	
CHECKED BY: JHS		RELOCATION OF MUSKINGUM COUNTY ROAD NO. 8	
SUBMITTED BY: Elmer S. Barrett Associates		MC-8-4 & MT-408-1	
RECOMMENDED BY: Elmer S. Barrett Associates		MC-8-1 & MC-408-1	
APPROVED: Steven Malenchuk		DATE: NOVEMBER 1959	
ELMER S. BARRETT ASSOCIATES CONSULTING ENGINEERS CHILLICOTHE, OHIO		SCALE: 1" = 10' DRAWING NUMBER 0 27f-UD 14- 68/40 SHEET 40 OF 83	

WORK AS CONSTRUCTED **STA. 150+00 To STA. 155+00**