


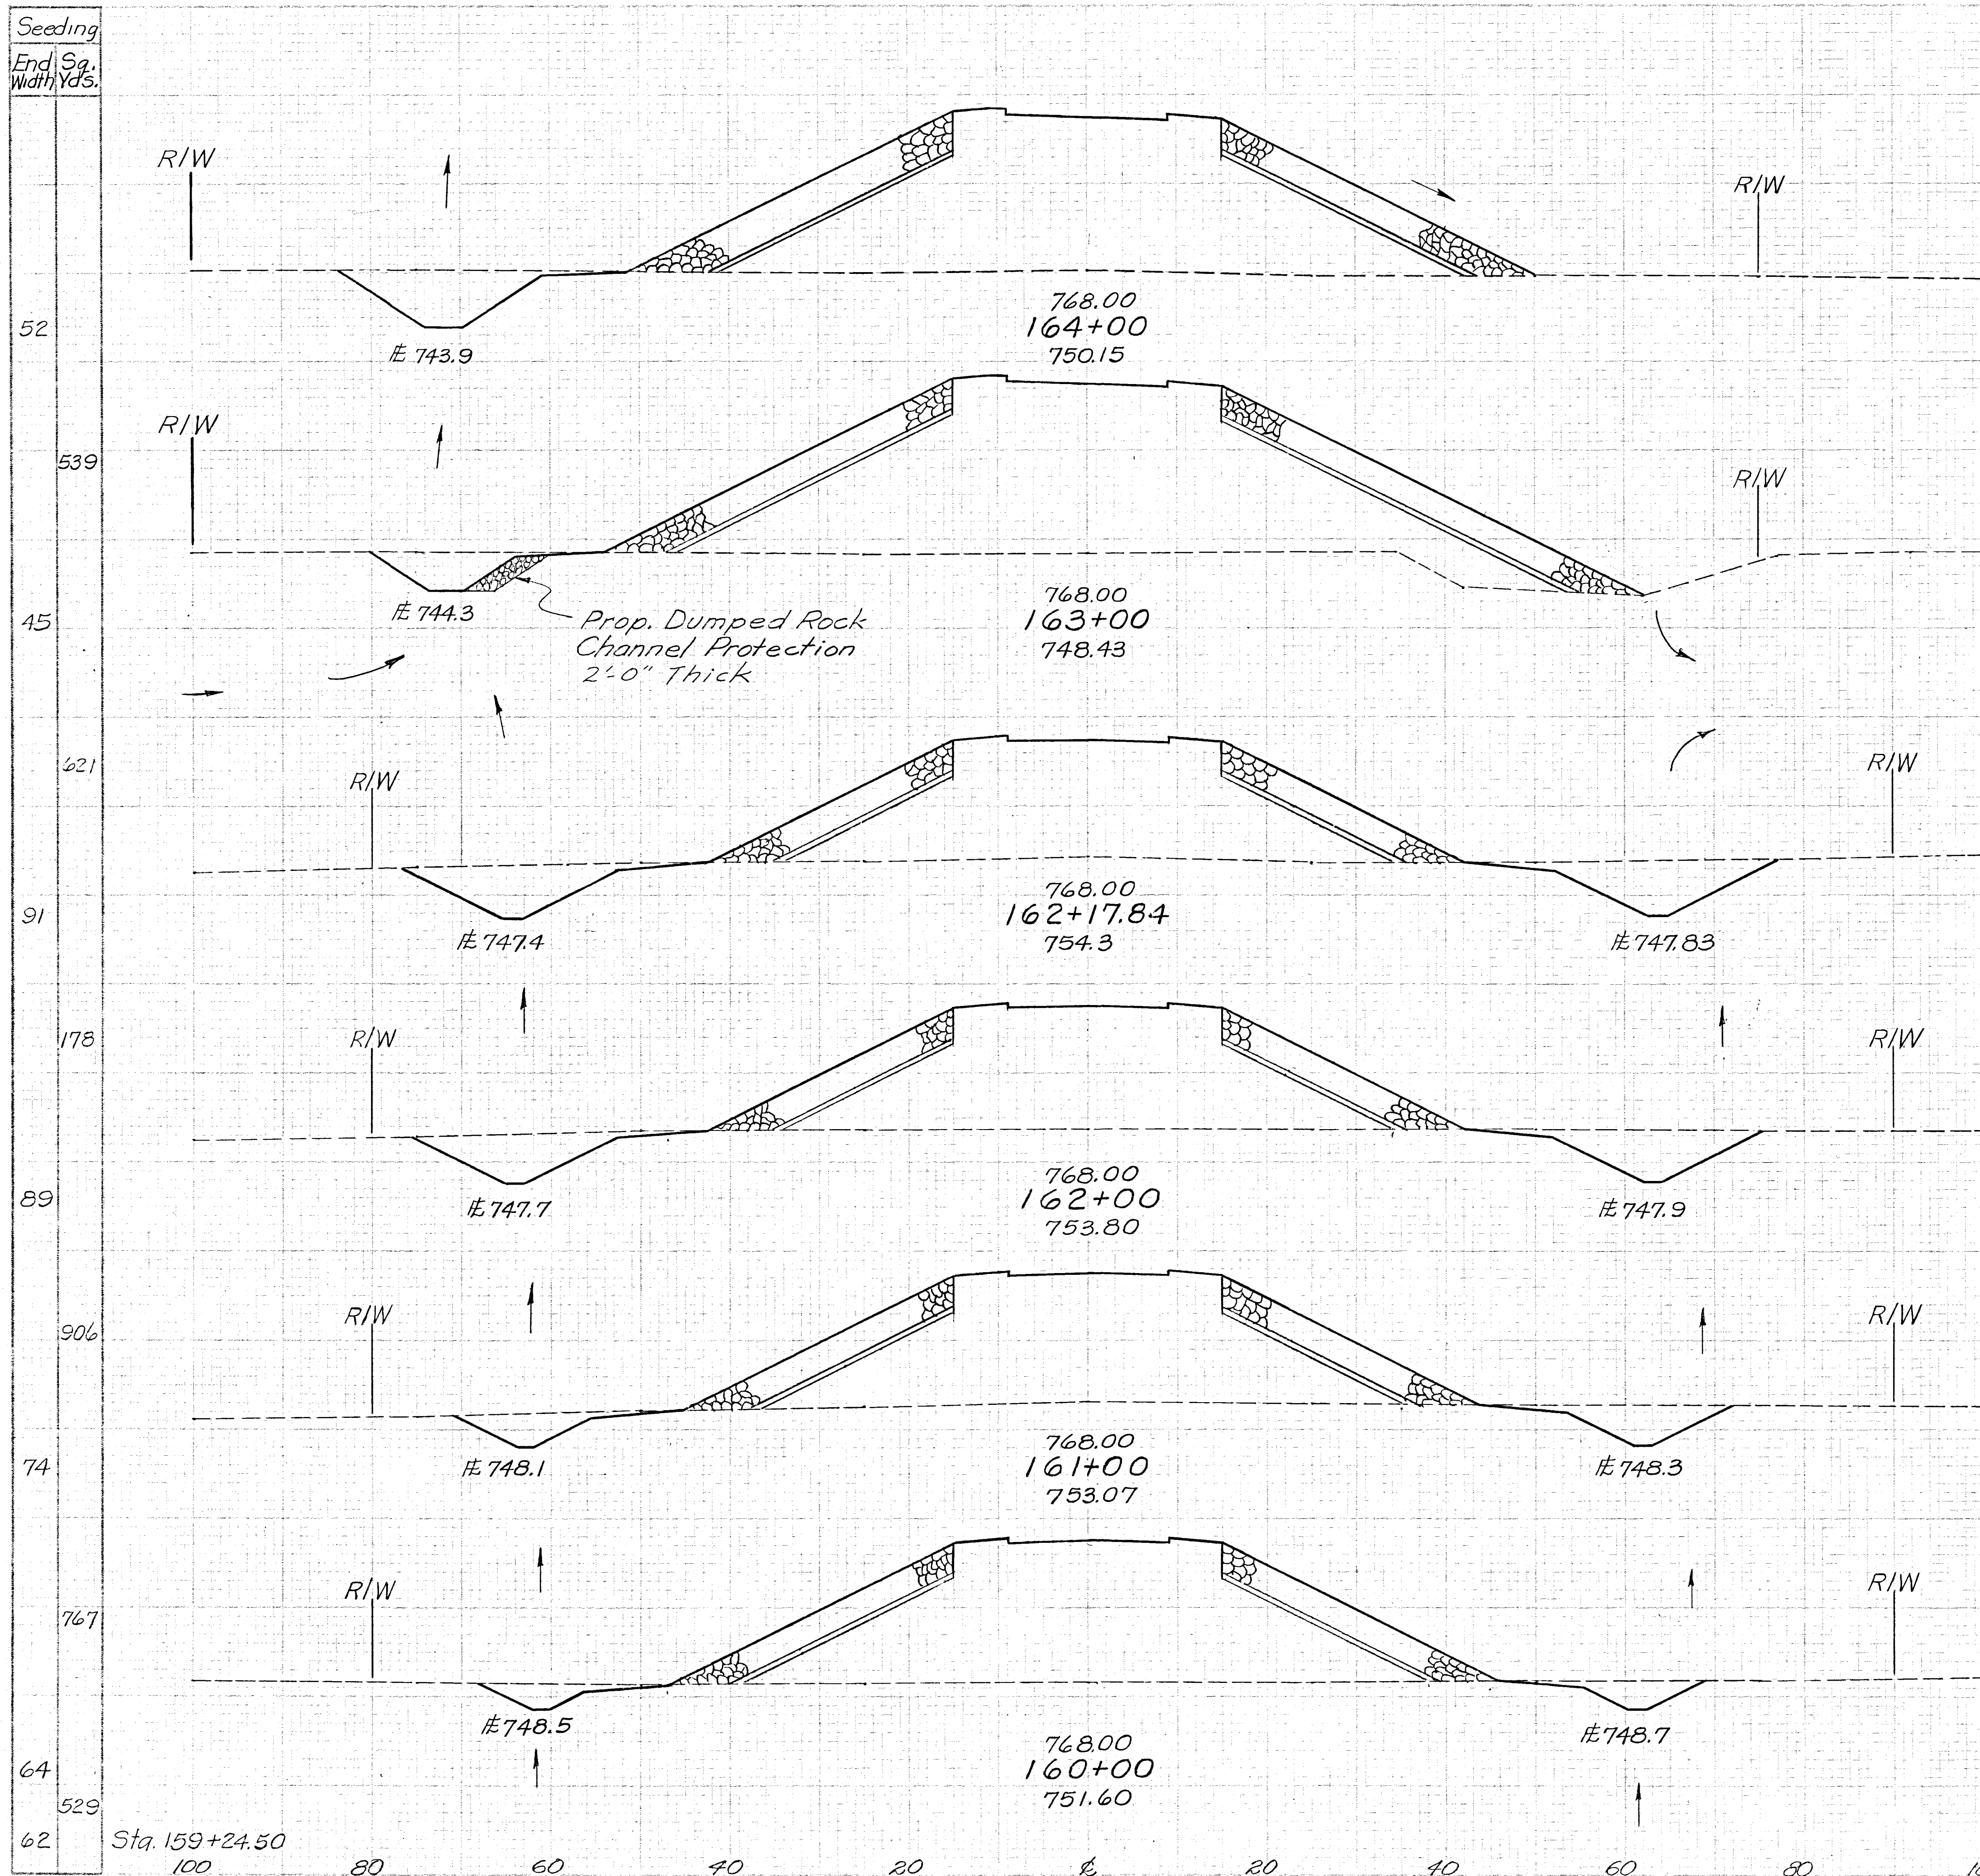

End Area	Volume
Cut	Fill
100.880	
276.3639	
49.1085	
367.2509	
192.564	
119.383	
167.594	
489.2304	
97.650	
289.2544	
59.724	
165.1960	
59.678	

**MUSKINGUM COUNTY
COUNTY ROAD NO. 8**

ROCK	I-22
End Area	Volume
End Area	Volume
Sta. 164+00	216 31
894	131
Sta. 163+00	267 40
653	94
Sta. 162+17.84	162 22
107	15
Sta. 162+00	162 22
628	83
Sta. 161+00	177 23
678	93
Sta. 160+00	189 27
516	74
Sta. 159+24.50	180 26

REVISION	DATE	DESCRIPTION	BY
	3/23/62	AS CONSTRUCTED	H.F.K.
U. S. ARMY ENGINEER DISTRICT, HUNTINGTON CORPS OF ENGINEERS HUNTINGTON, W. VA.			
DRAWN BY: EER		LICKING RIVER DILLON RESERVOIR PROJECT	
CHECKED BY: F.H.S.		RELOCATION OF MUSKINGUM COUNTY ROAD NO. 8	
SUBMITTED BY: Elmer S. Barrett Associates		MC-8-4 & MT-408-1	
RECOMMENDED:		MC-8-1 & MC-408-1	
APPROVED: Steven Malerich		DATE: NOVEMBER 1959	
CHIEF ENG. DIV.		COL. C.E. DISTRICT ENGINEER	
ELMER S. BARRETT ASSOCIATES CONSULTING ENGINEERS CHILLICOTHE, OHIO		SCALE: 1"=10' DRAWING NUMBER 0 2 7 f-UD 14-68/42 SHEET 42 OF 83	

STA. 160+00 To STA. 164+00