


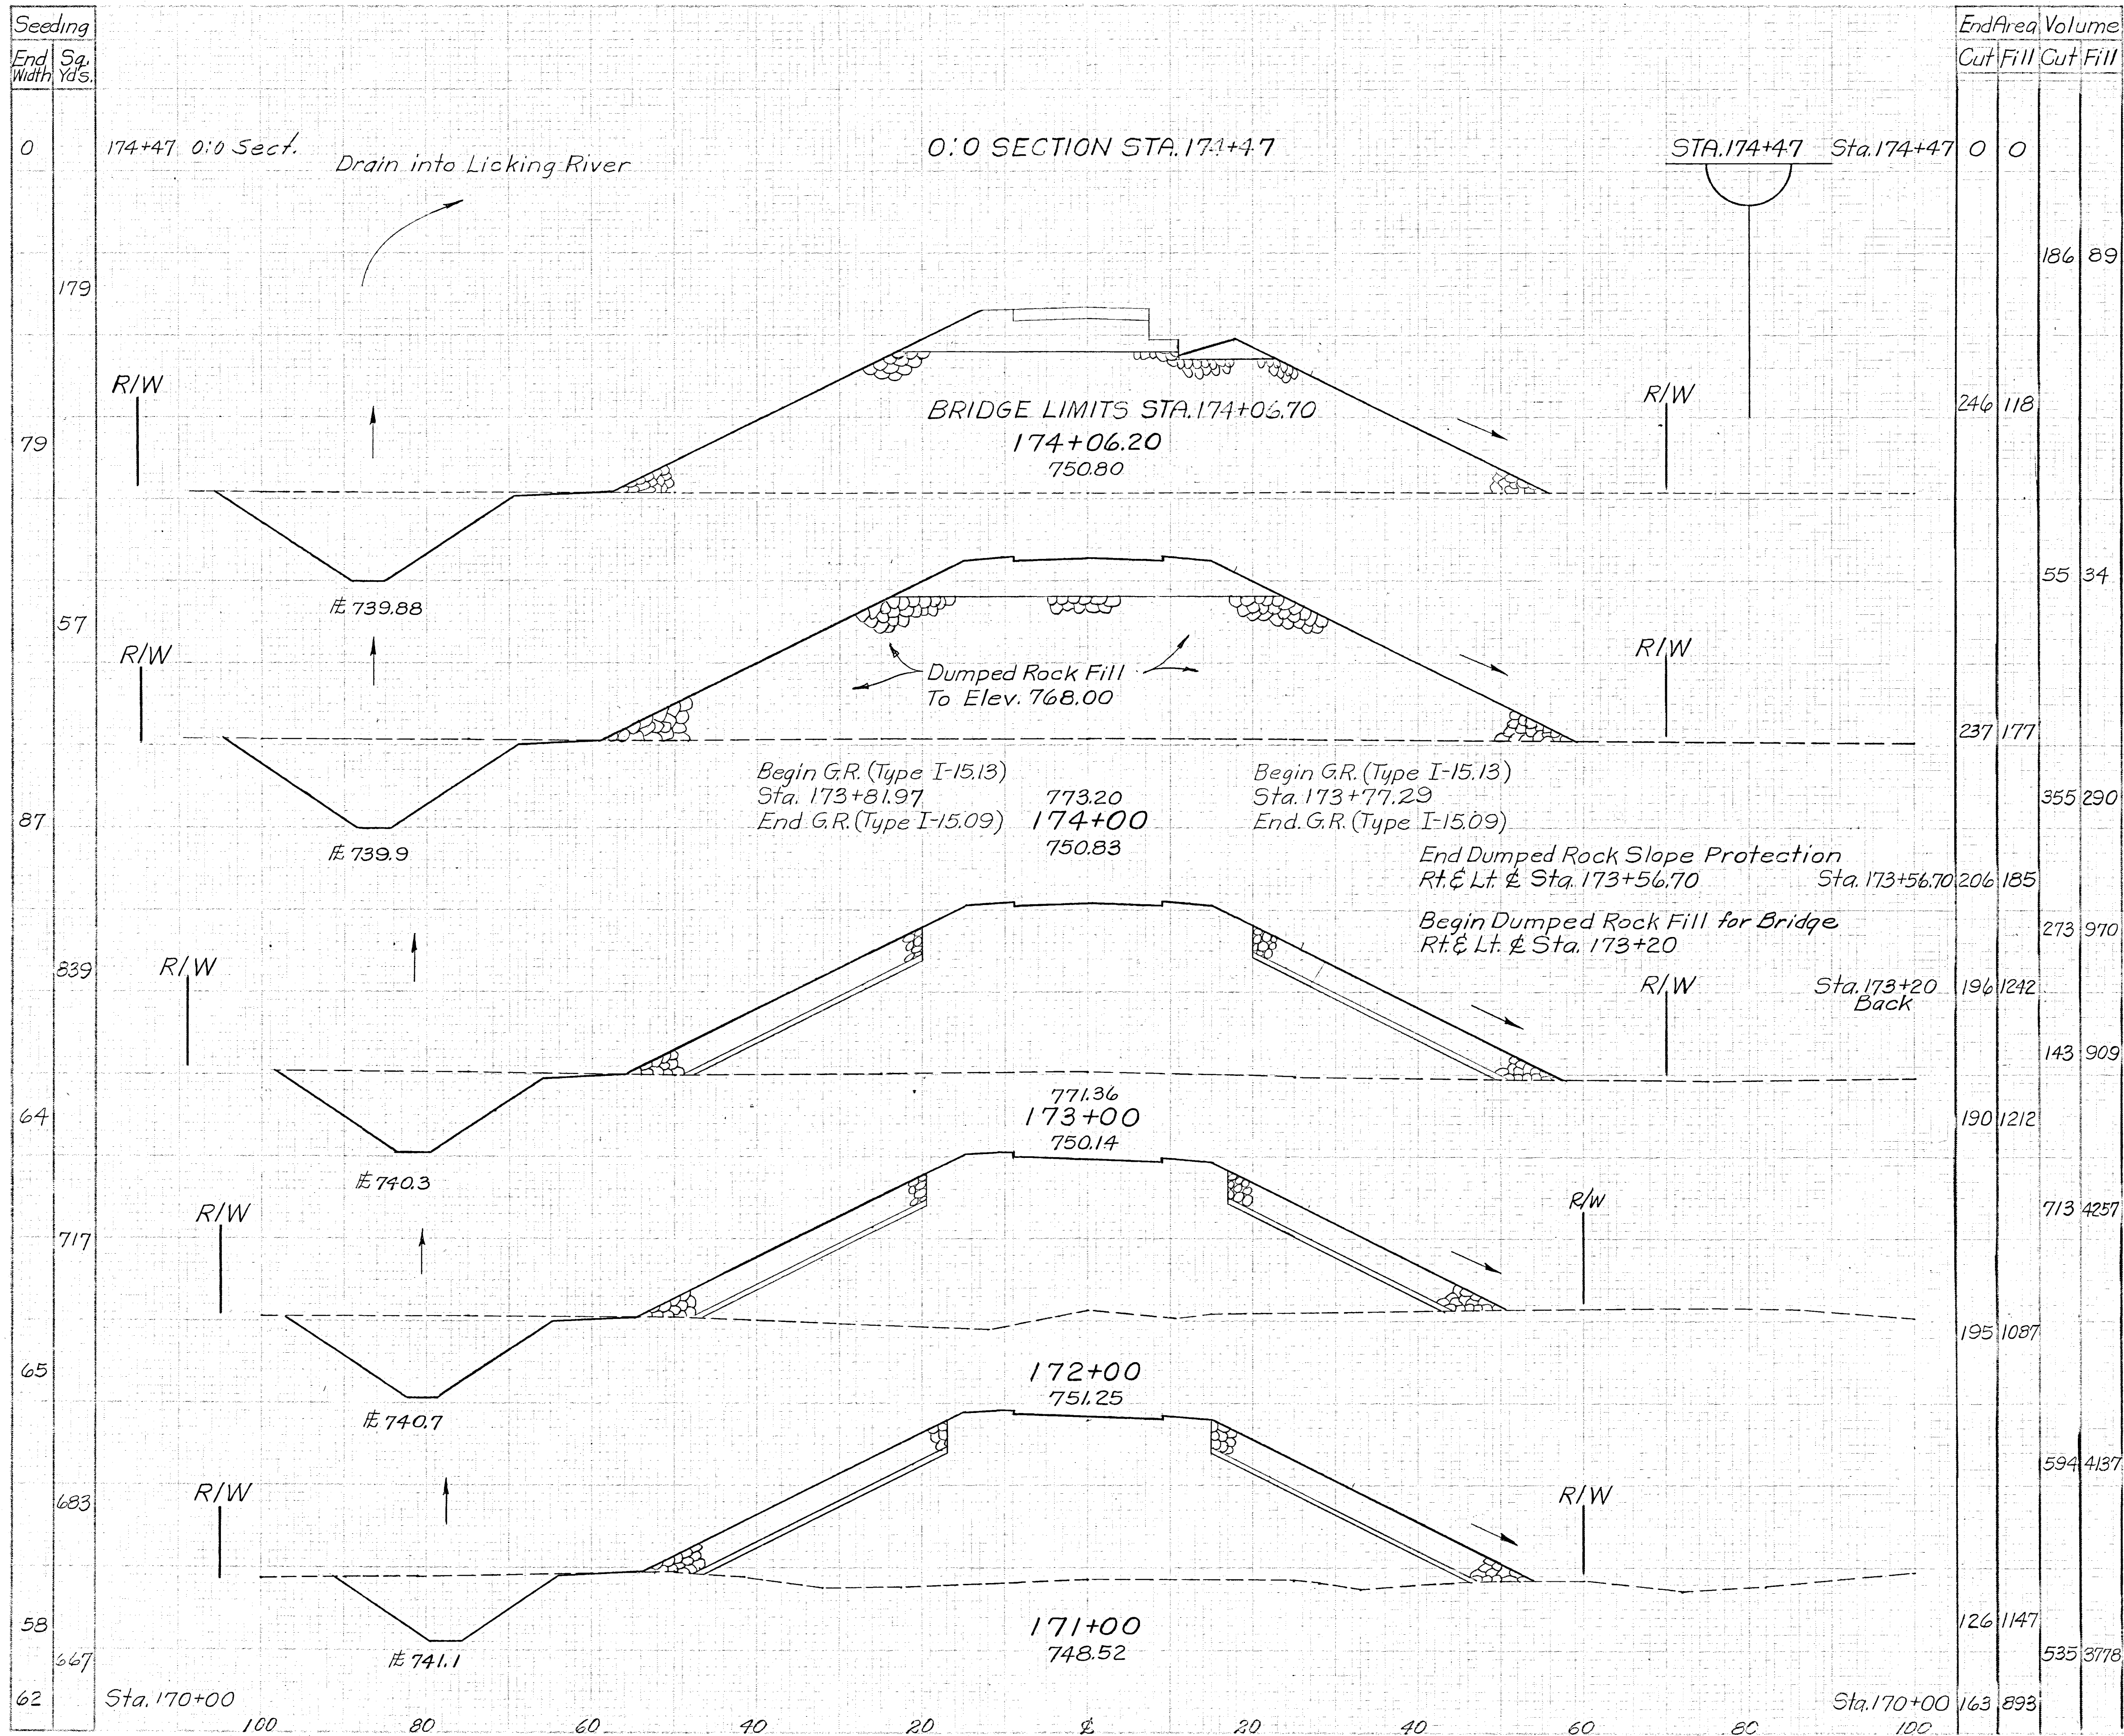

End Area		Volume	
Cut	Fill	Cut	Fill
0	0	186	89
246	118	55	34
237	177	355	290
206	185	273	970
196	1242	143	909
190	1212	713	4257
195	1087	594	4137
126	1147	535	3778
163	893		

44
83

MUSKINGUM COUNTY
COUNTY ROAD NO. 8

ROCK		I-22	
End Area	Volume	End Area	Volume
Sta. 174+47	0	0	0
Sta. 174+06.70	1008	0	0
Sta. 174+00	1425	2285	0
Sta. 173+56.70	1425	0	0
Sta. 173+20	223	1120	33
Sta. 173+00	223	165	24
Sta. 172+00	210	802	119
Sta. 171+00	235	824	122
Sta. 170+00	210	824	122

3/23/62	AS CONSTRUCTED	H.F.K.
REVISION	DATE	DESCRIPTION
U. S. ARMY ENGINEER DISTRICT, HUNTINGTON CORPS OF ENGINEERS HUNTINGTON, W. VA.		
DRAWN BY: EER		
CHECKED BY: FHS		
SUBMITTED BY: Elmer S. Barrett		
RECOMMENDED BY: James J. Barrett		
APPROVED BY: Steven Malenich		
DATE: NOVEMBER 1959		
ELMER S. BARRETT ASSOCIATES CONSULTING ENGINEERS CHILLICOTHE, OHIO		
SCALE: 1"=10'		
DRAWING NUMBER: 027f-UD 14-68/44		
SHEET 44 OF 83		

STA. 171+00 To STA. 174+06.20