


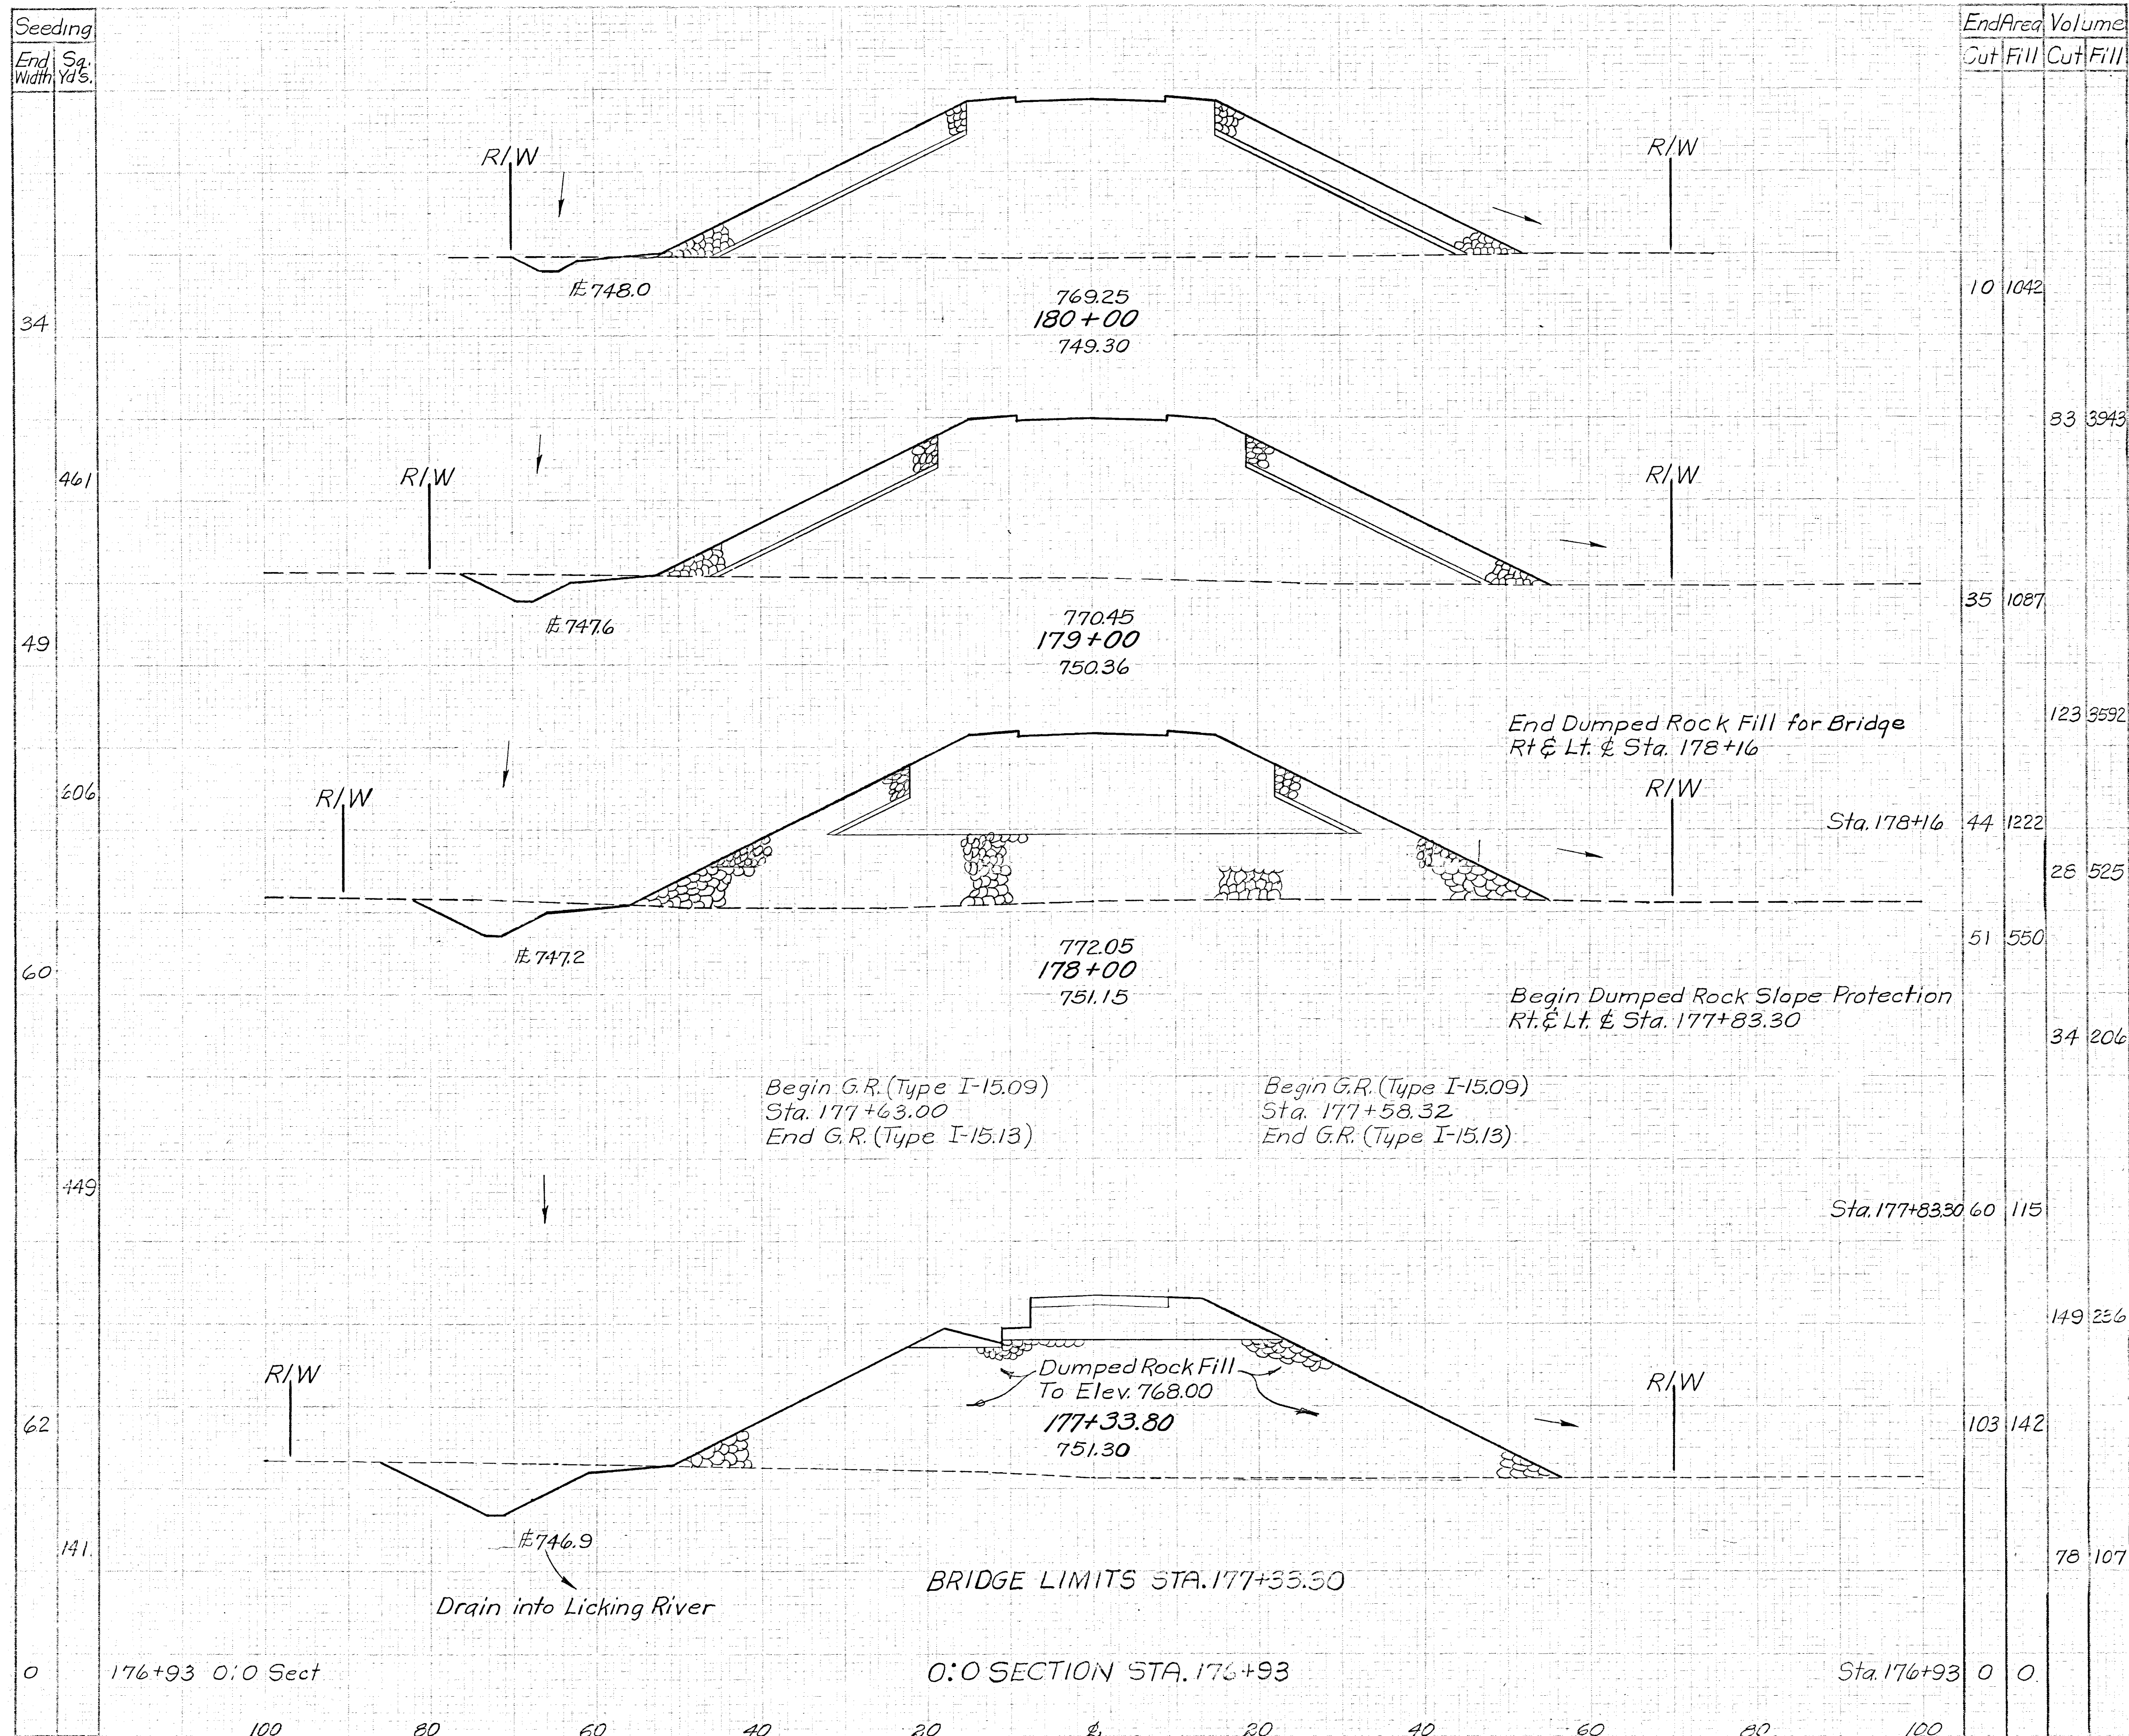

MUSKINGUM COUNTY COUNTY ROAD NO. 8

ROCK		I-22	
End Area	Volume	End Area	Volume
Sta. 180+00	230	34	
	824	122	
Sta. 179+00	215	32	
	655	97	
Sta. 178+16	206	30	
	319	12	
Sta. 178+00	872	11	
	647	3	
Sta. 177+83.30	1219	0	
	2235	0	
Sta. 177+33.80	1219	0	
	921	0	
Sta. 176+93	0	0	

EARTHWORK

From Sta. 176+93 to Sta. 210+44
Excavation 73,923 Cu.Yds.
Embankment 35,158 Cu.Yds.

From Sta. 176+93 to Sta. 186+50
Dumped Rock Fill 9082 Cu.Yds.
(For Slope Protection)
I-22 Subbase 724 Cu.Yds.

3/23/62	AS CONSTRUCTED	H.F.K.
REVISION	DATE	DESCRIPTION
U. S. ARMY ENGINEER DISTRICT, HUNTINGTON CORPS OF ENGINEERS HUNTINGTON, W. VA.		
DRAWN BY: EER		
TRACED BY:		
CHECKED BY: FHS		
SUBMITTED BY: Elmer S. Barrett Associates		
RECOMMENDED BY: Elmer S. Barrett Associates		
APPROVED: Steven Malenich COL. C. E., DISTRICT ENGINEER		
DATE: NOVEMBER 1959		
ELMER S. BARRETT ASSOCIATES CONSULTING ENGINEERS CHILLICOTHE, OHIO		
SCALE: 1"=10'		
DRAWING NUMBER 0 27f-UD14-68/45		
SHEET 45 OF 83		