


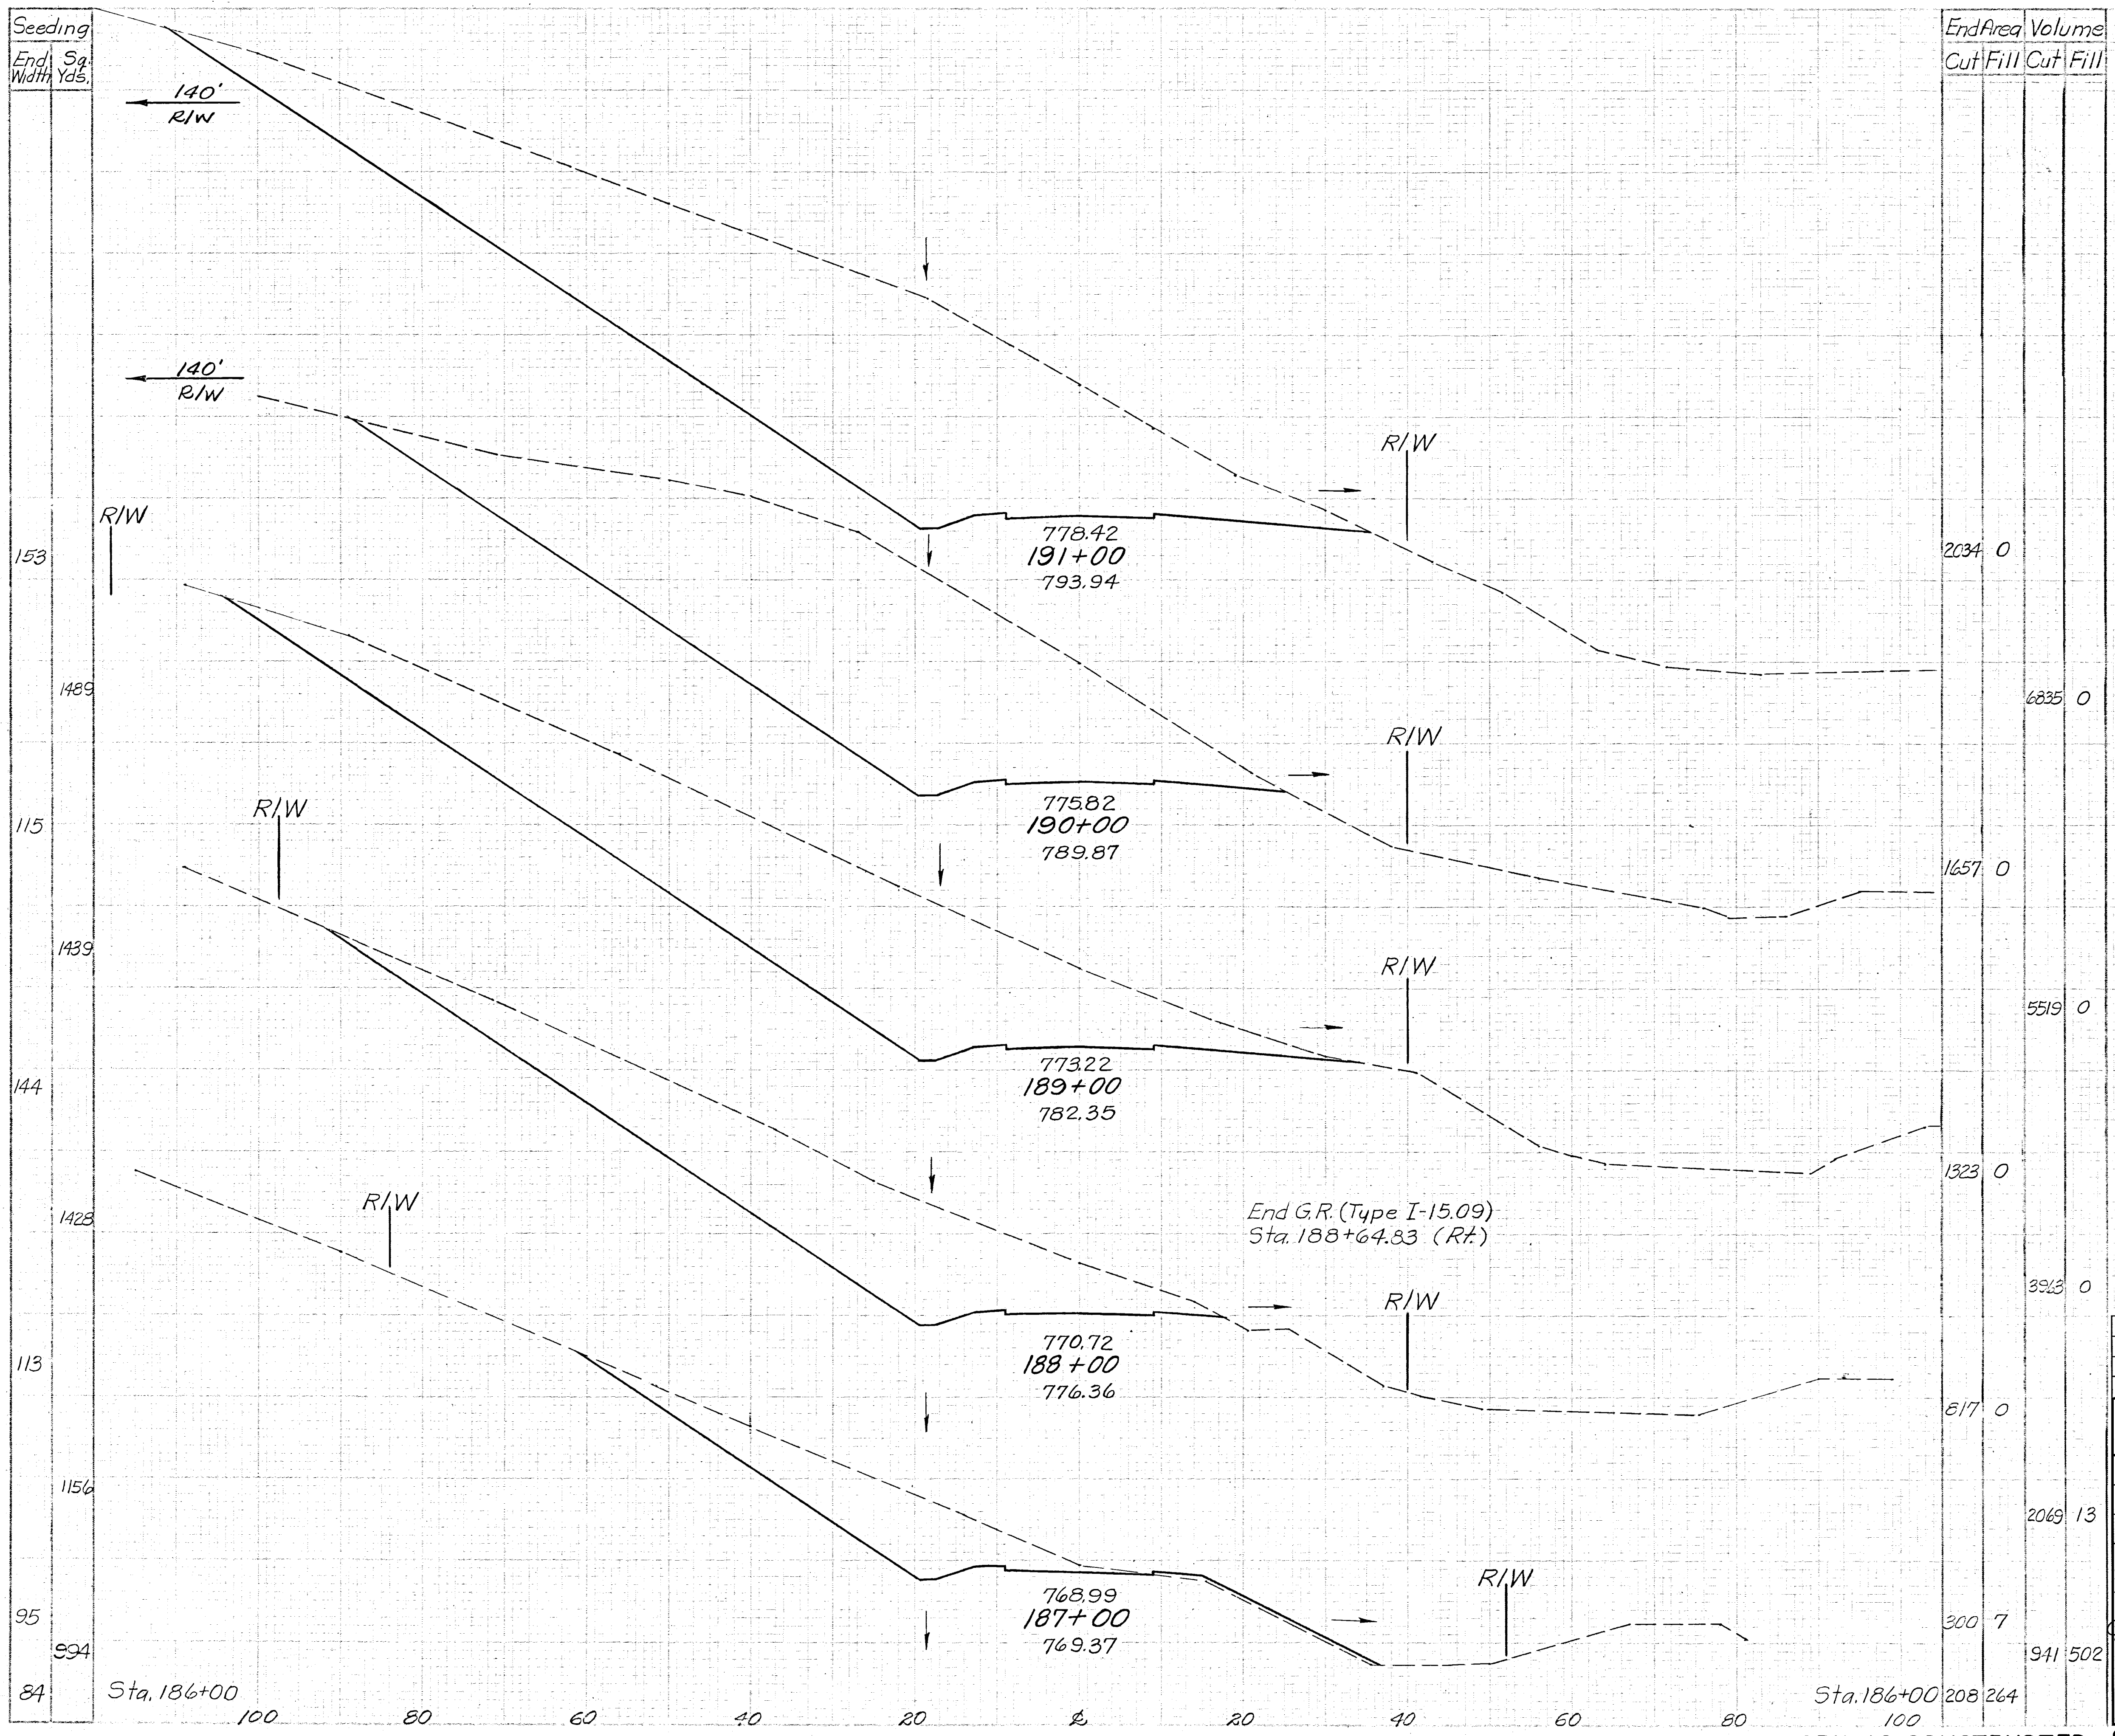

REVISION		DATE	DESCRIPTION	BY
		3/23/62	AS CONSTRUCTED	H.F.K.
U. S. ARMY ENGINEER DISTRICT, HUNTINGTON CORPS OF ENGINEERS HUNTINGTON, W. VA.				
DRAWN BY:		EER		
CHECKED BY:		FHB		
SUBMITTED BY:		Elmer S. Barrett		
RECOMMENDED BY:		Elmer S. Barrett Associates		
APPROVED:		Steven Malenchuk		
DATE:		NOVEMBER 1959		
ELMER S. BARRETT ASSOCIATES CONSULTING ENGINEERS CHILLICOTHE, OHIO		SCALE: 1" = 10' DRAWING NUMBER 0 27f-UD 14-68/47 SHEET 47 OF 83		

WORK AS CONSTRUCTED STA. 187+00 TO STA. 191+00