


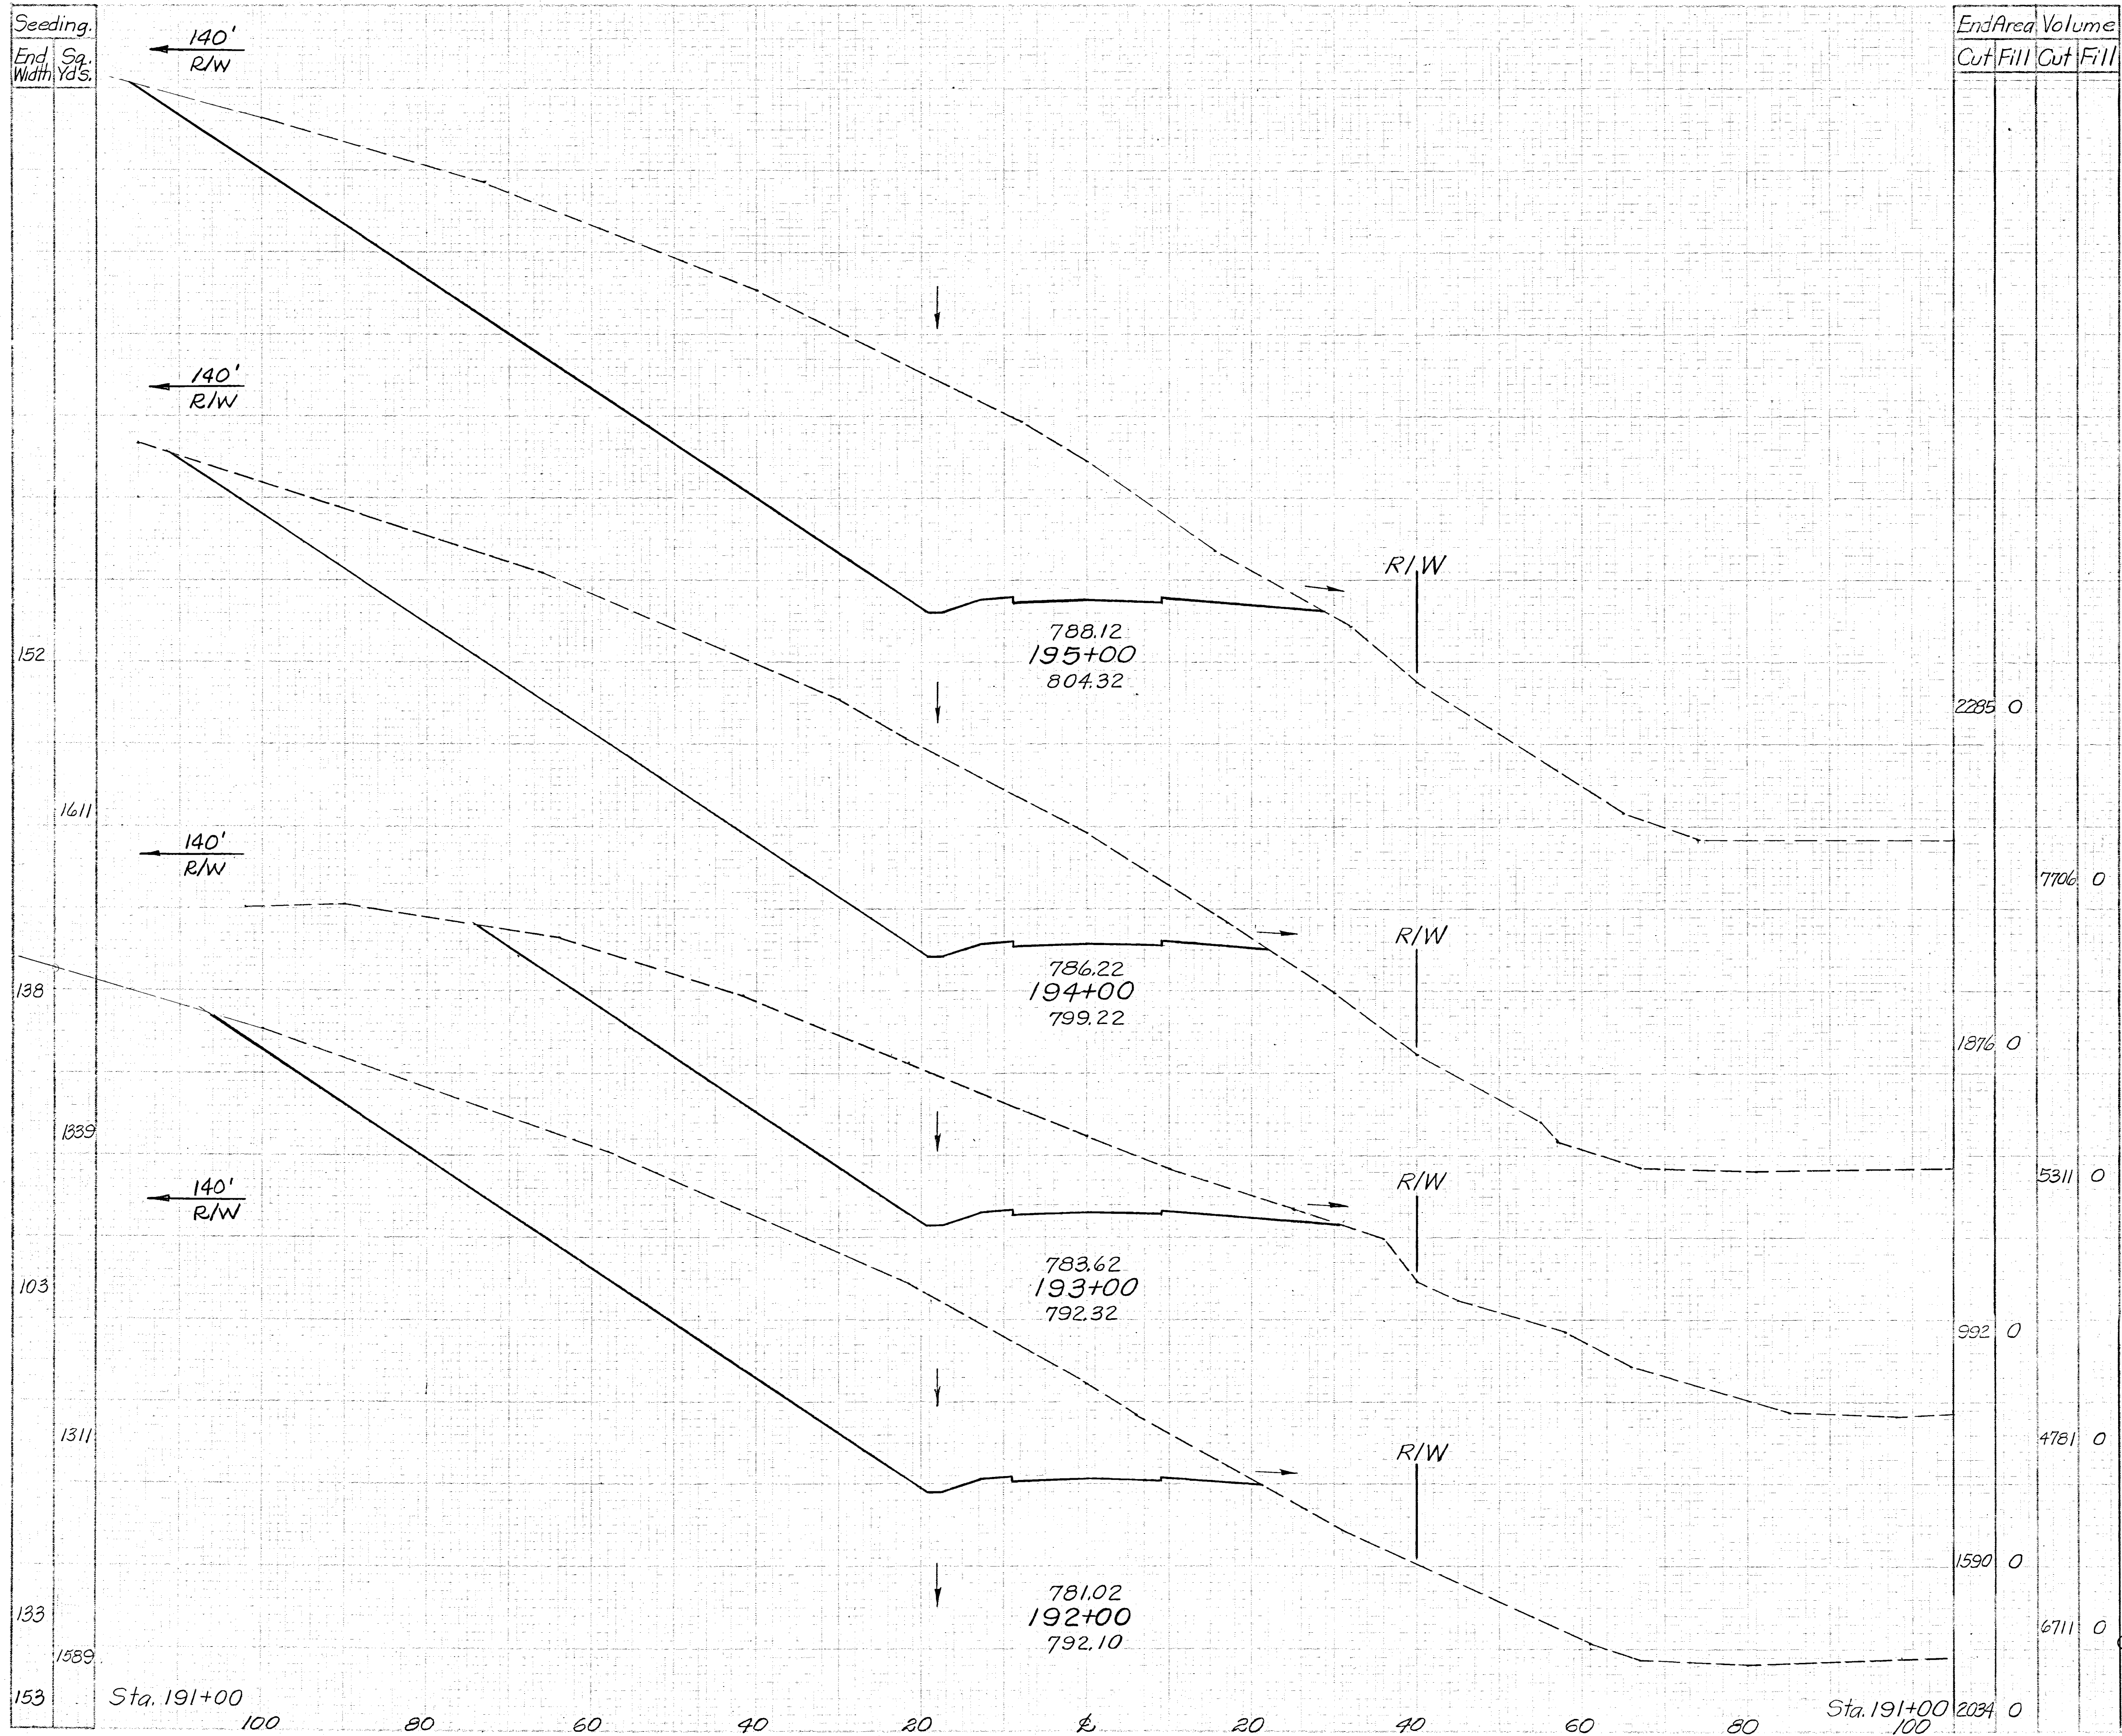

**MUSKINGUM COUNTY
COUNTY ROAD NO. 8**

48
83

REVISION		DATE	DESCRIPTION	BY
		3/23/62	AS CONSTRUCTED	H.F.K.
U. S. ARMY ENGINEER DISTRICT, HUNTINGTON CORPS OF ENGINEERS HUNTINGTON, W. VA.				
DRAWN BY: EER		LICKING RIVER DILLON RESERVOIR PROJECT		
CHECKED BY: FHS		RELOCATION OF MUSKINGUM COUNTY ROAD NO. 8		
SUBMITTED BY: Elmer S. Barrett		MC-8-4 & MT-408-1 MC-8-1 & MC-408-1		
RECOMMENDED BY: Elmer S. Barrett Associates		APPROVED: Steven M. Murch COL. C.E. DISTRICT ENGINEER		
DATE: NOVEMBER 1959		SCALE: 1"=10'		
ELMER S. BARRETT ASSOCIATES CONSULTING ENGINEERS CHILLICOTHE, OHIO		DRAWING NUMBER 027f-UD14-68/48 SHEET 48 OF 83		

STA. 192+00 TO STA. 195+00