


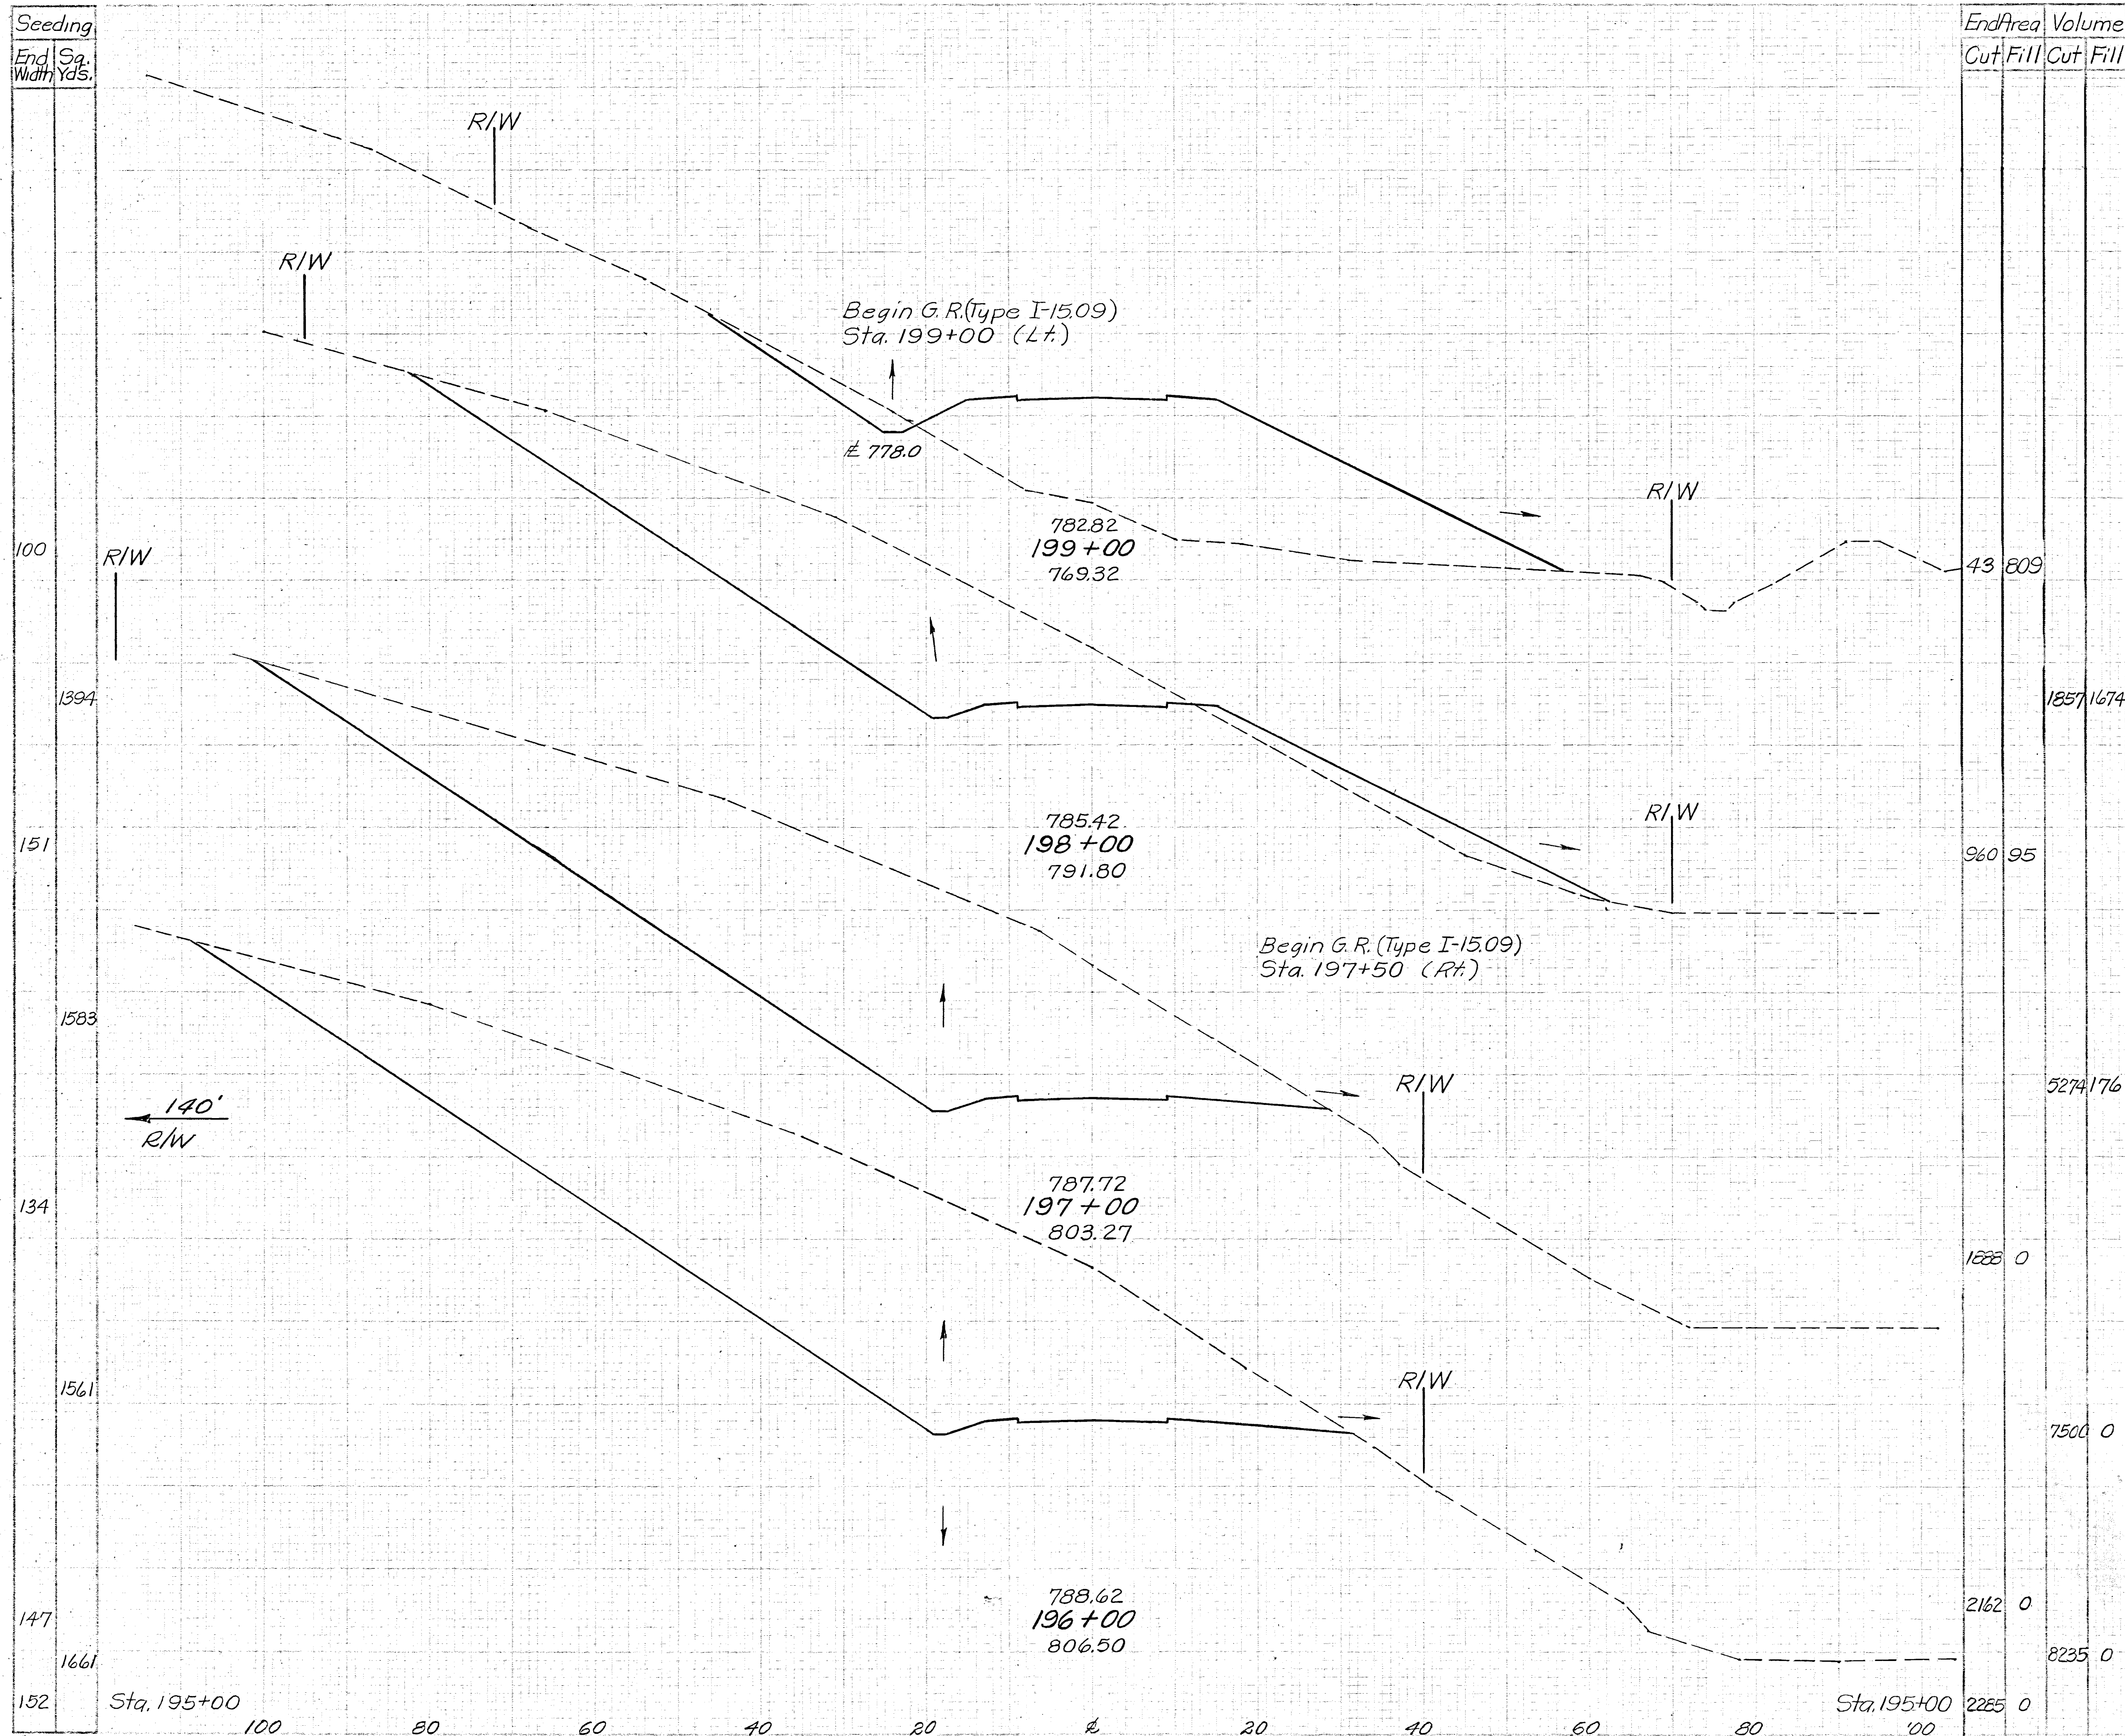

End Area		Volume	
Cut	Fill	Cut	Fill
43	809	1857	1674
960	95	5274	176
1228	0	7500	0
2162	0	8235	0
2255	00		

MUSKINGUM COUNTY COUNTY ROAD NO. 8

49
83

REVISION	DATE	DESCRIPTION	BY
	3/23/62	AS CONSTRUCTED	H.F.K.
U. S. ARMY ENGINEER DISTRICT, HUNTINGTON CORPS OF ENGINEERS HUNTINGTON, W. VA.			
DRAWN BY: EER		LICKING RIVER DILLON RESERVOIR PROJECT	
CHECKED BY: FHL		RELOCATION OF MUSKINGUM COUNTY ROAD NO. 8	
SUBMITTED BY: Elmer S. Barrett		MC- 8-4 & MT- 408-1	
ELMER S. BARRETT ASSOCIATES		MC- 8-1 & MC- 408-1	
RECOMMENDED:		APPROVED: Steven Malench	DATE: NOVEMBER 1959
CHIEF ENG. DIV.		COL. C.E. DISTRICT ENGINEER	
ELMER S. BARRETT ASSOCIATES CONSULTING ENGINEERS CHILLICOTHE, OHIO		SCALE: 1"=10'	SPEC. NO.
		DRAWING NUMBER 0 271-UD 14-68/49	
		SHEET 49 OF 83	

WORK AS CONSTRUCTED STA. 196+00 TO STA. 199+00