


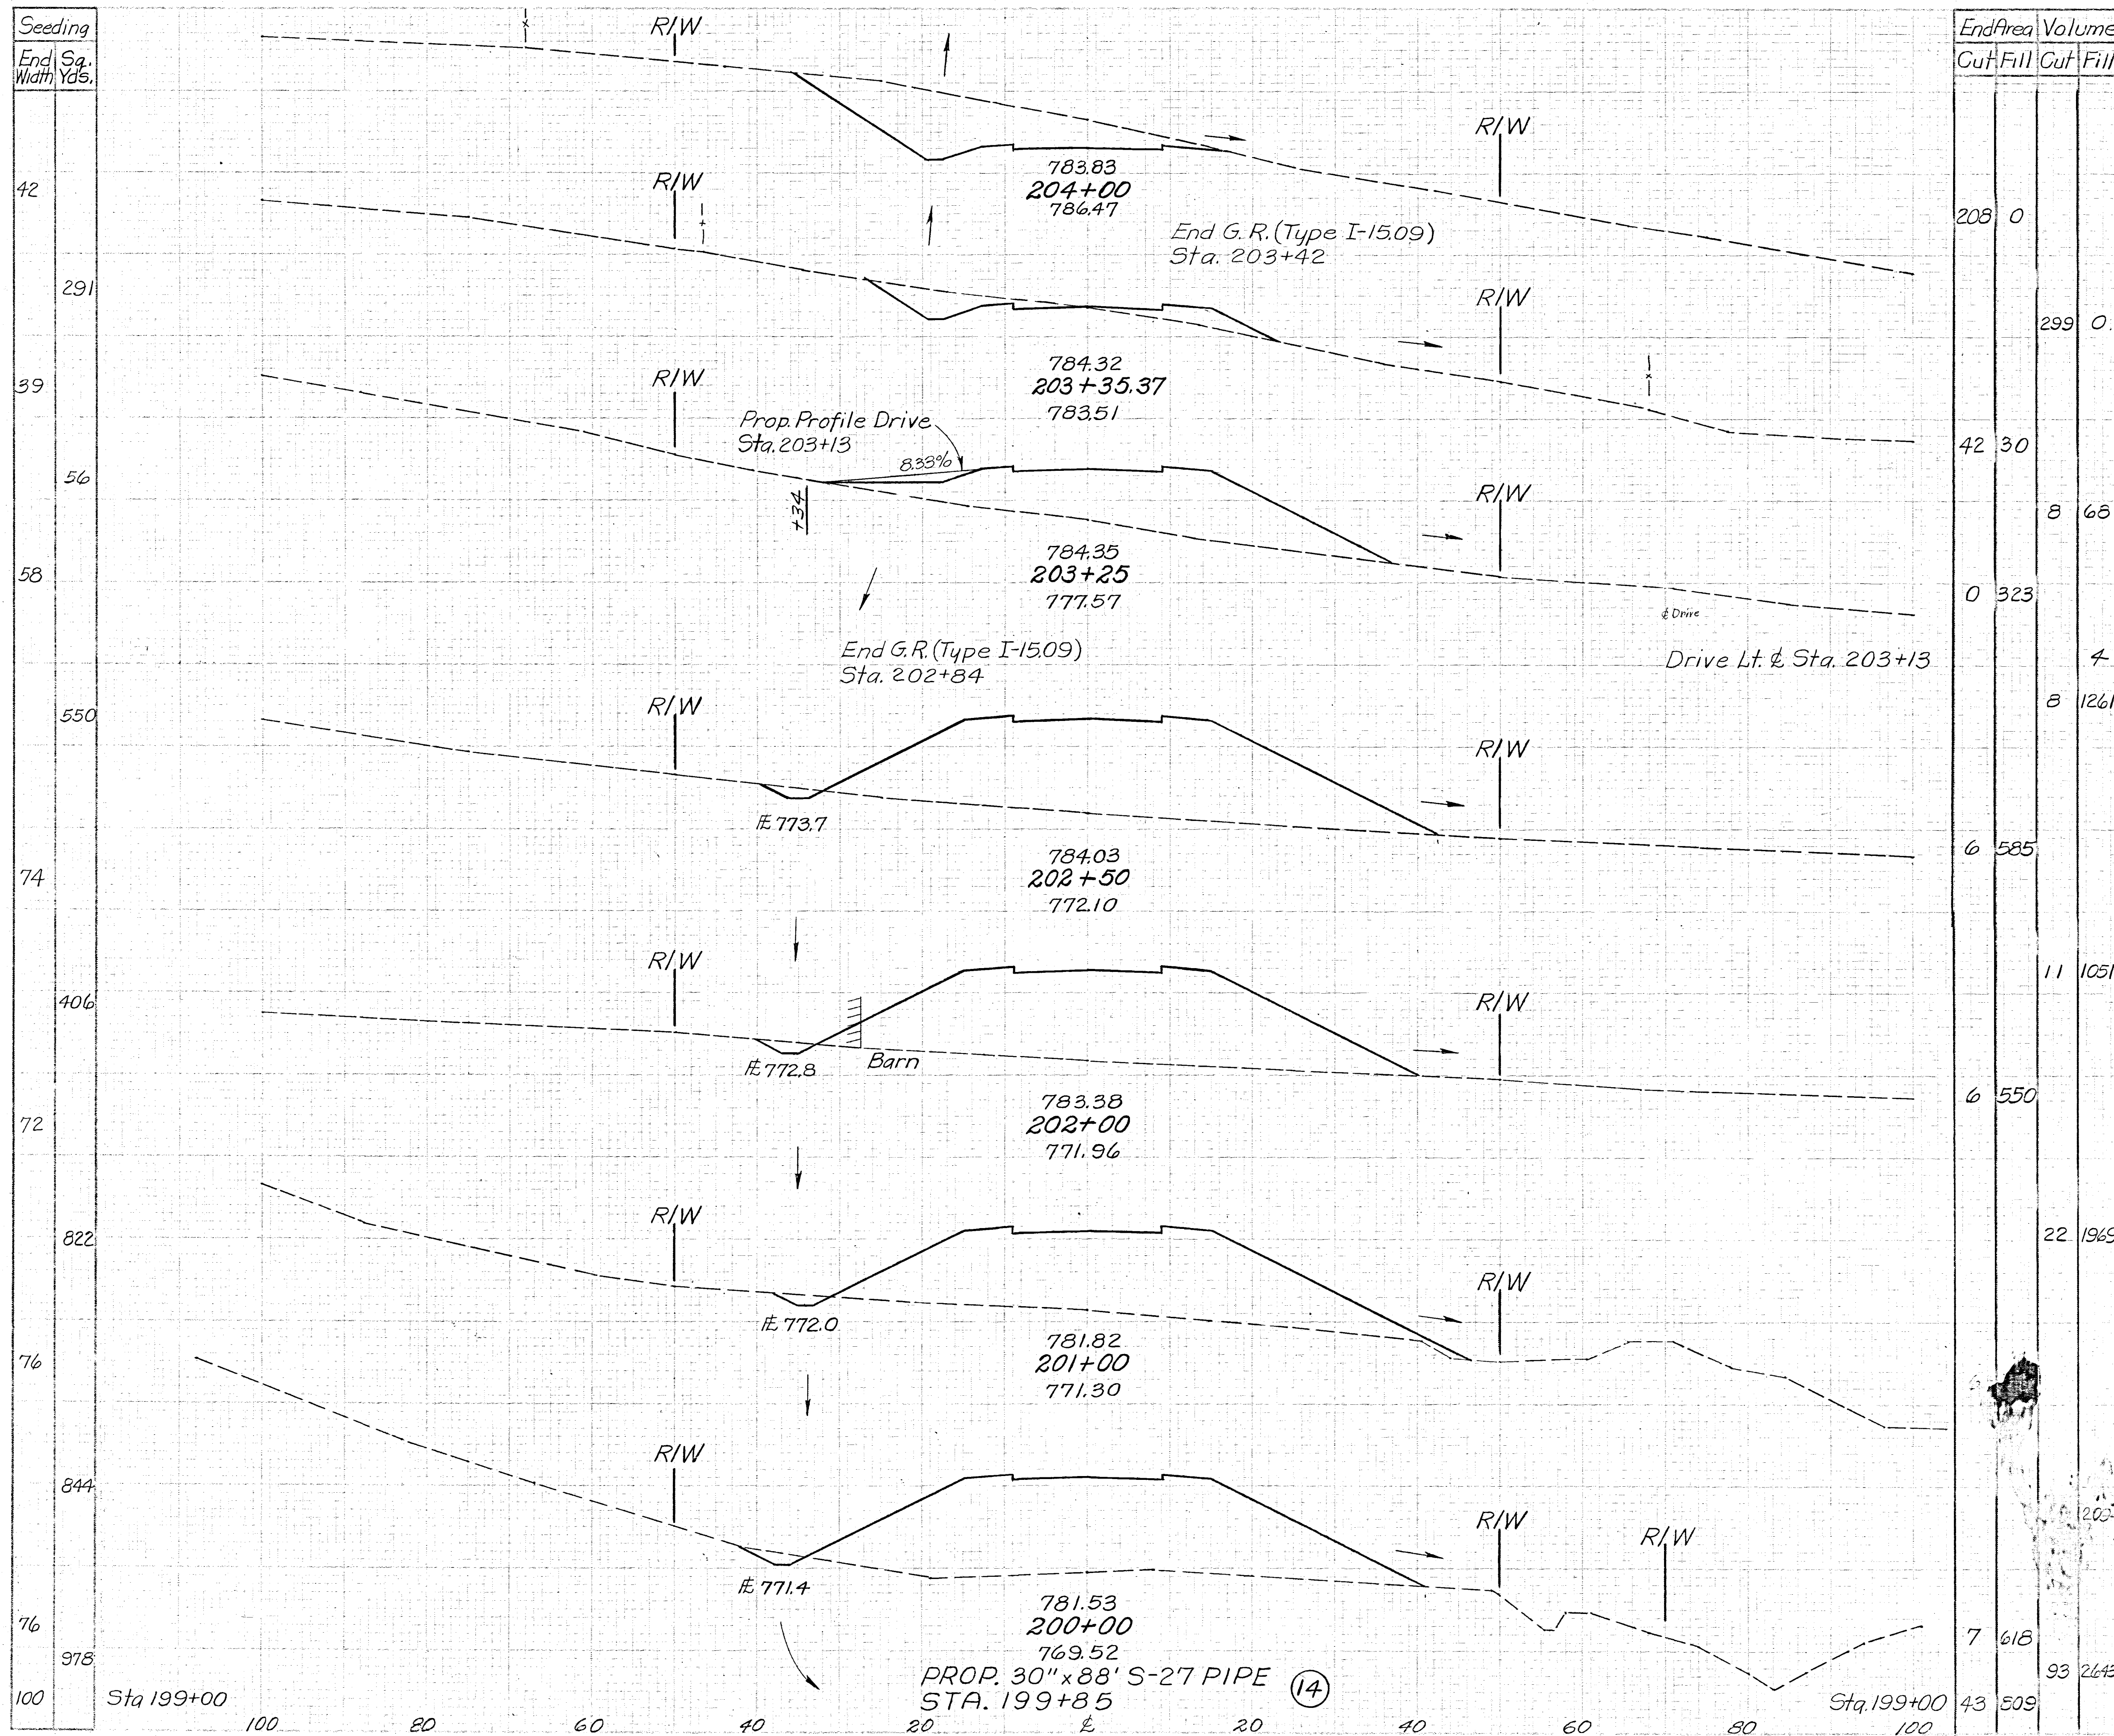

End Area	Volume
Cut	Fill
208	0
299	0
42	30
8	66
0	323
8	1261
6	585
11	1051
6	550
22	1969
7	618
43	509
93	2643

MUSKINGUM COUNTY COUNTY ROAD NO. 8

REVISION	DATE	DESCRIPTION	BY
	3/23/62	AS CONSTRUCTED	H.F. K.
U. S. ARMY ENGINEER DISTRICT, HUNTINGTON CORPS OF ENGINEERS HUNTINGTON, W. VA.			
DRAWN BY: EER		LICKING RIVER DILLON RESERVOIR PROJECT	
CHECKED BY: FHL		RELOCATION OF MUSKINGUM COUNTY ROAD NO. 8	
SUBMITTED BY: Elmer S. Barrett Associates		MC- 8- 4 & MT- 408-1	
RECOMMENDED BY: Elmer S. Barrett Associates		MC- 8- 1 & MC- 408-1	
APPROVED BY: Steven Malenich		DATE: NOVEMBER 1959	
ELMER S. BARRETT ASSOCIATES CONSULTING ENGINEERS CHILLICOTHE, OHIO		SCALE: 1"=10' DRAWING NUMBER 027f-UD 14-68/50 SHEET 50 OF 83	

STA. 200+00 To STA. 204+00